


NOT FOR CONSTRUCTION

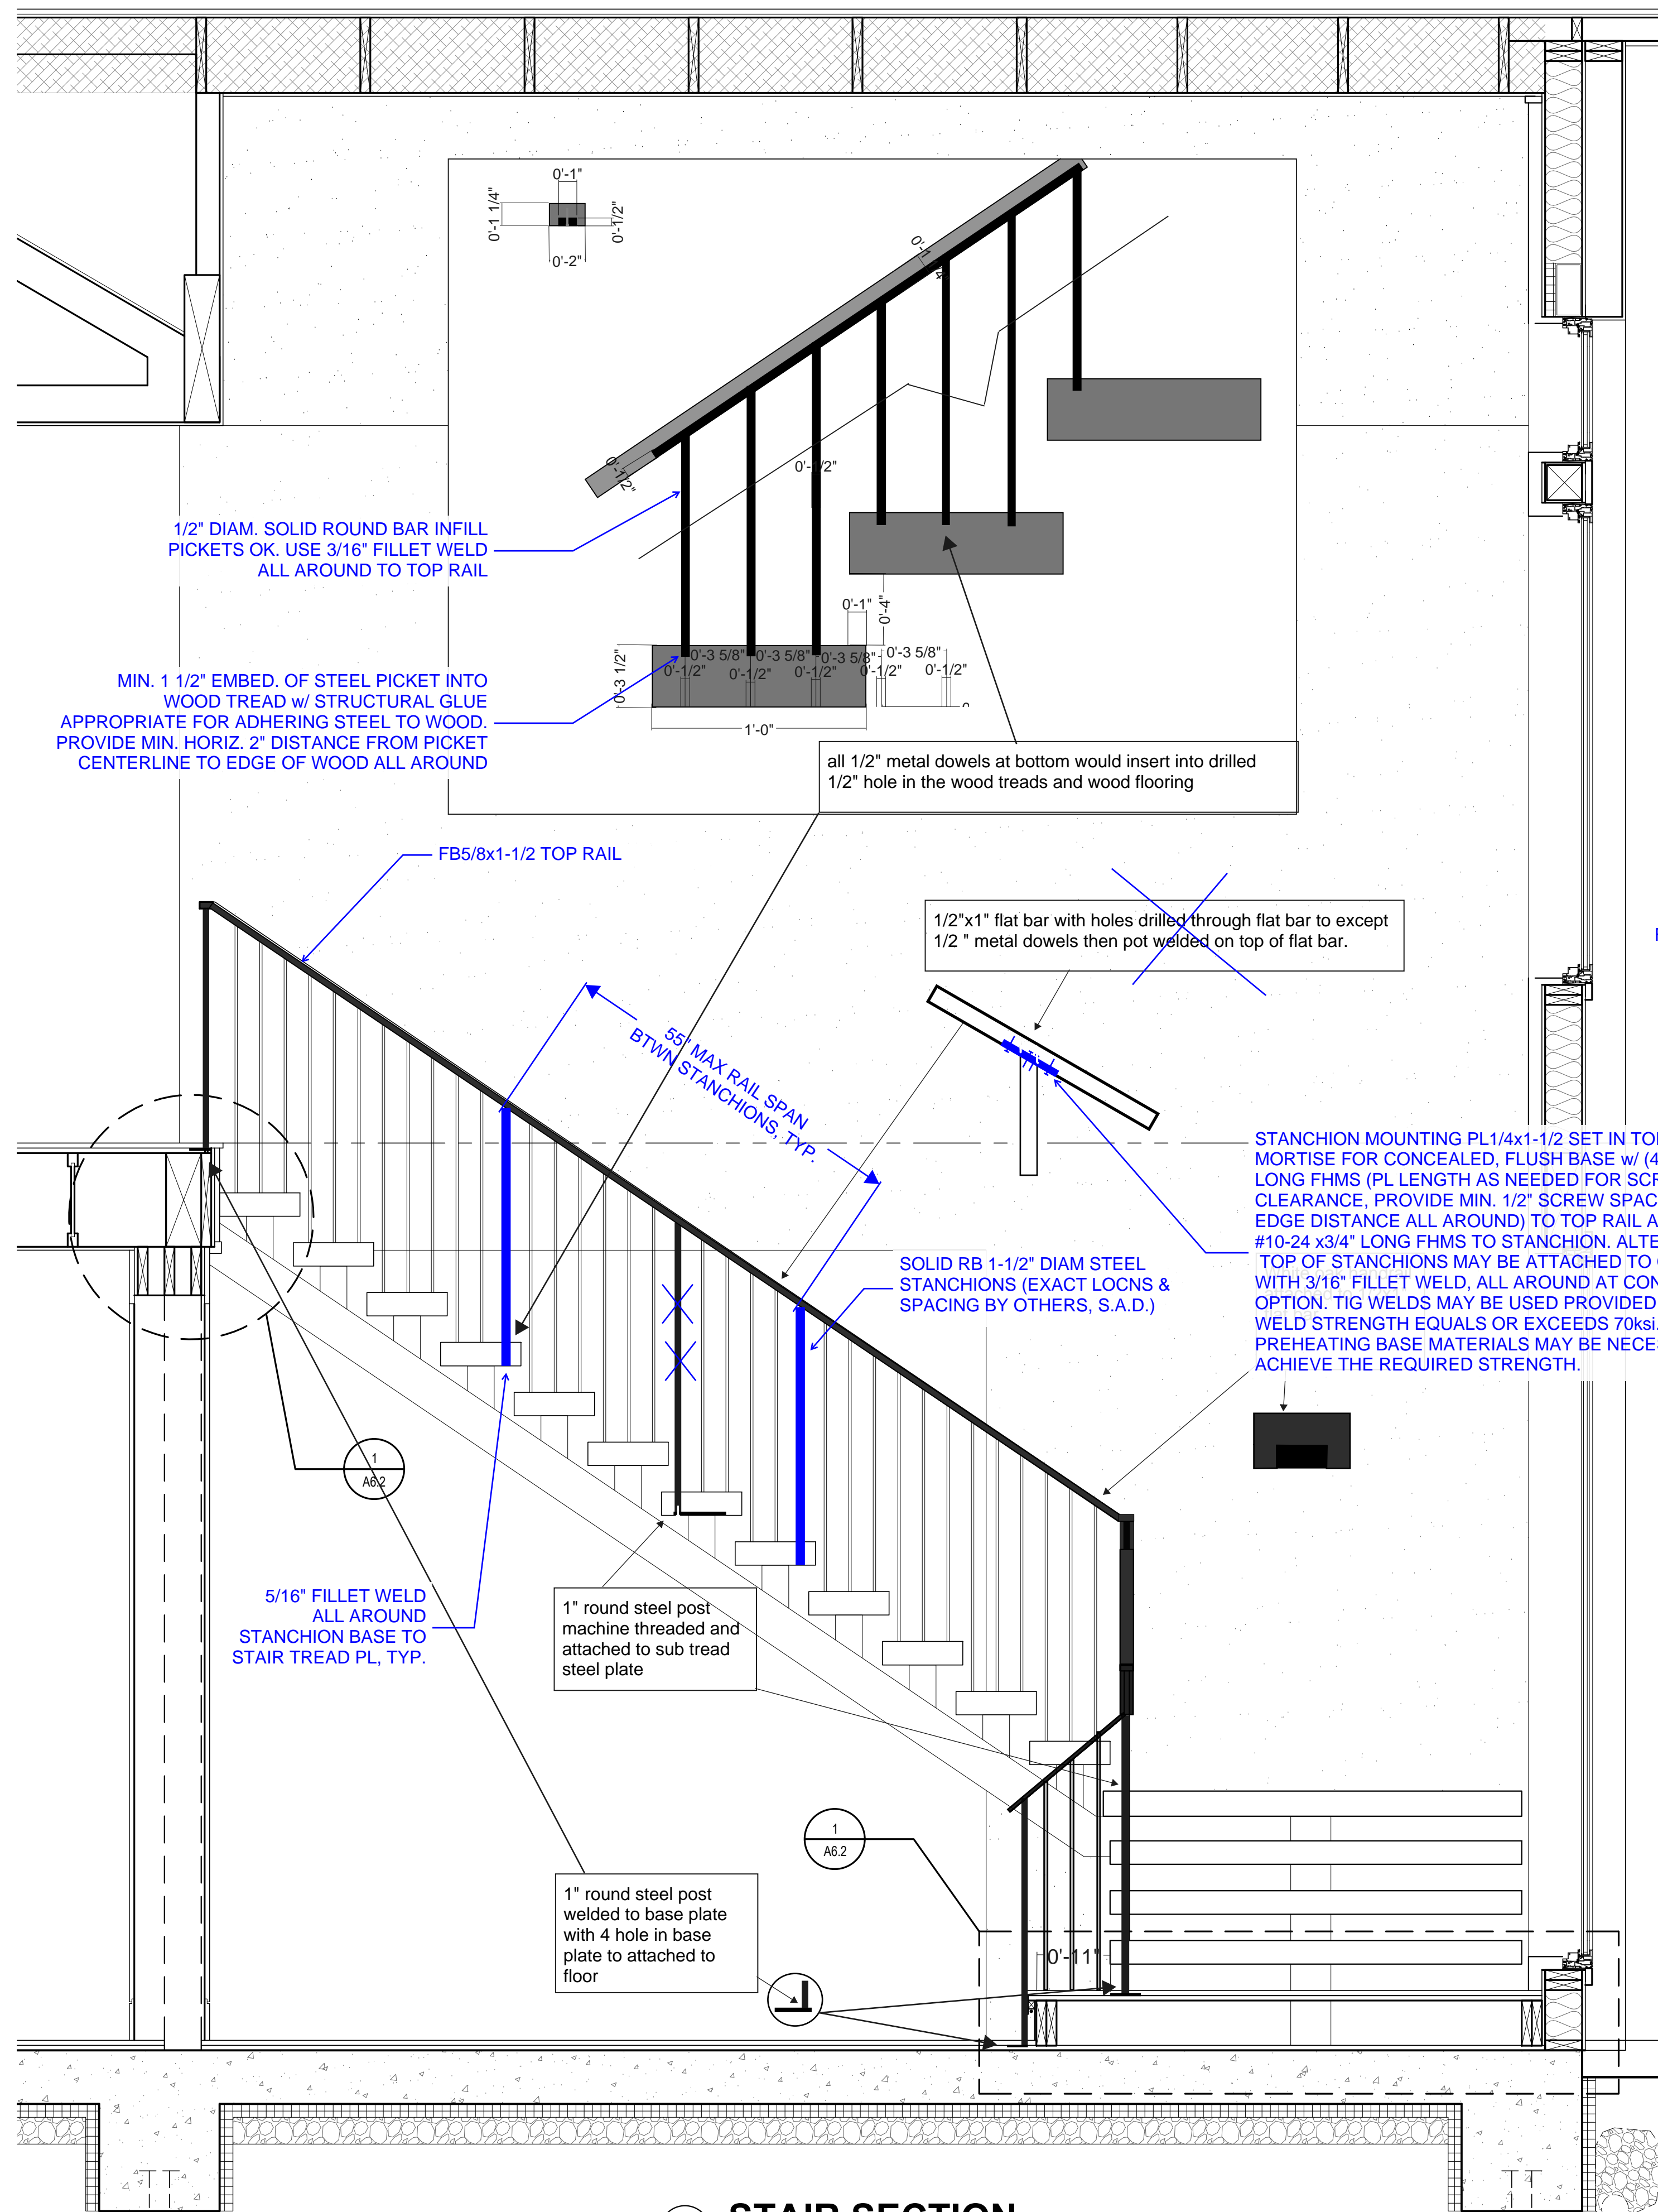


1 STAIR SECTION SCALE: 3/4" = 1'-0"

(SECOND FLR) T.O. PLATE EL = 47.26'

(SECOND FLR) T.O. FINISH FLOOR EL = 38.29'


(MAIN FLR) T.O. PLATE EL = 37.0'

(MAIN FLR) T.O. FINISH FLOOR EL = 27.125'

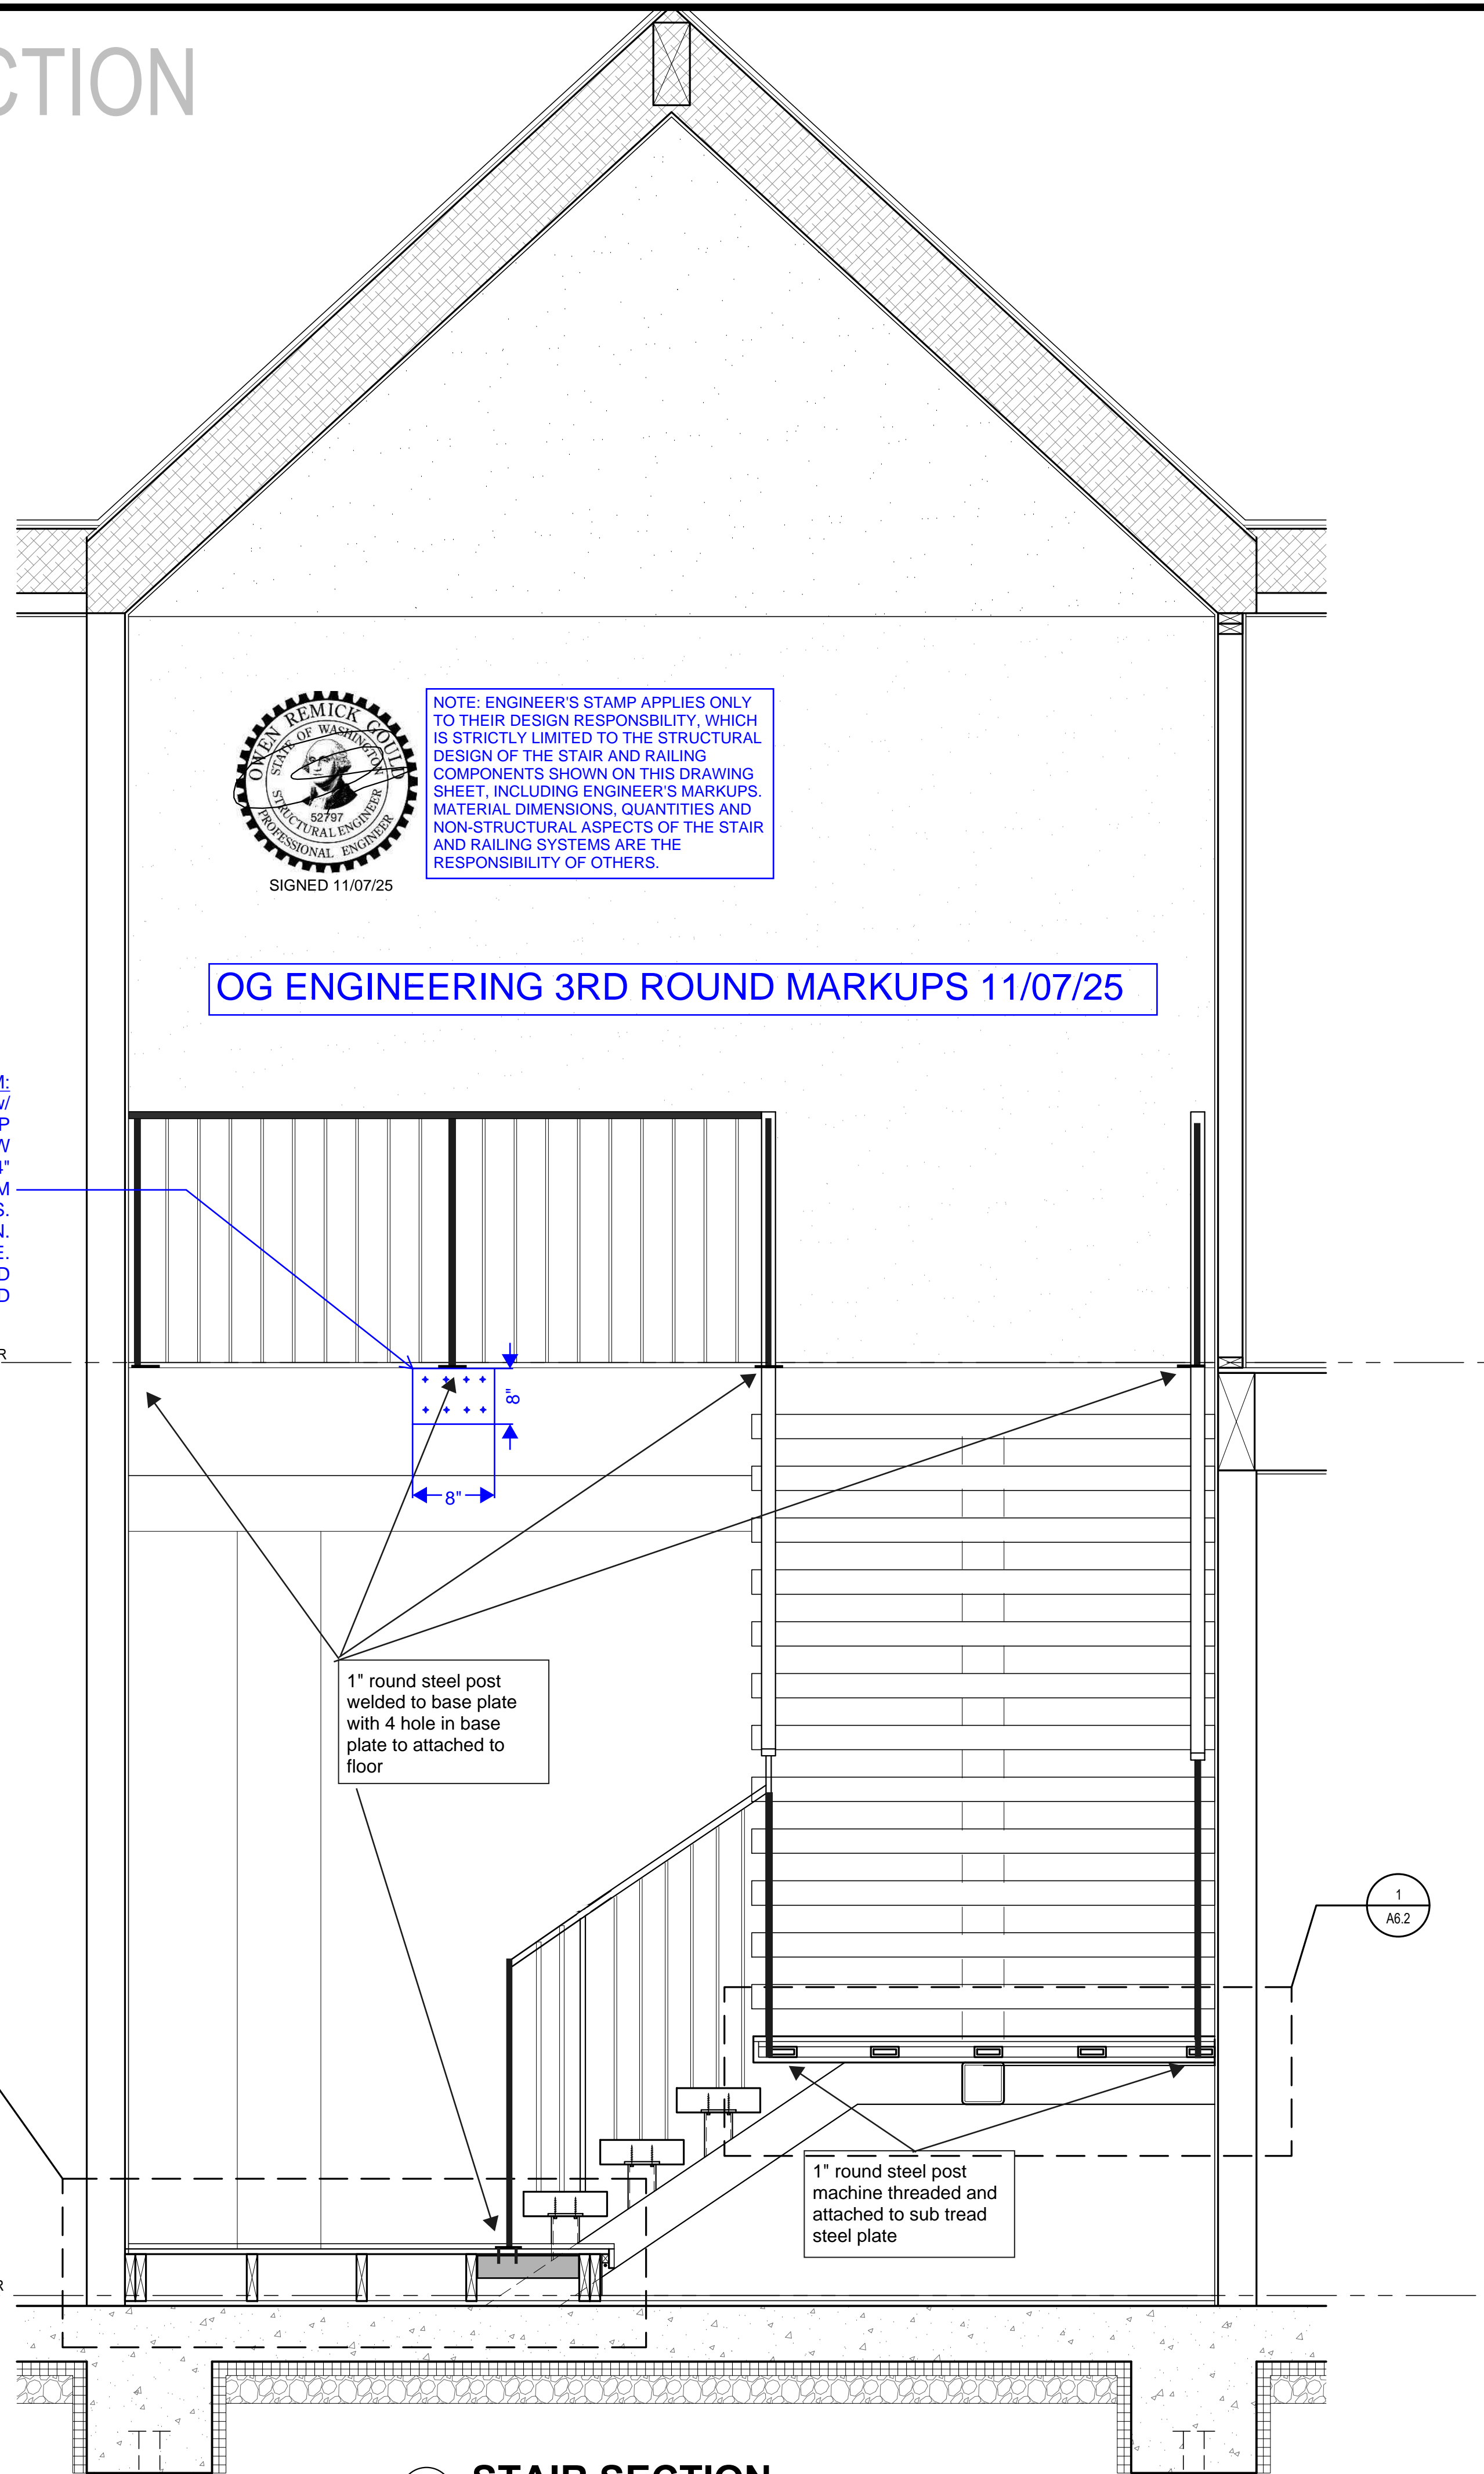

2 STAIR SECTION SCALE: 3/4" = 1'-0"

SCALE: IF SHEET IS LESS THAN 24" X 36", IT IS A REDUCED PRINT, REDUCE SCALE ACCORDINGLY  
CONSTRUCTION SET 12/18/24

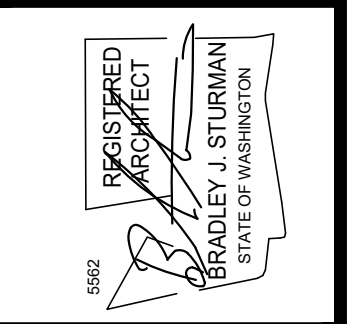

www.sturmanarchitects.com  
All Rights Reserved  
© 2024

STAIR SECTIONS

REVISIONS:

2024-5-13	Corrections #1
2024-6-18	Corrections #2
2024-11-27	Construction Set

DRAWN BY: KE


CHECKED BY: BUS

SHEET

A6.1

PLOT DATE: 12/18/2024


NOT FOR CONSTRUCTION

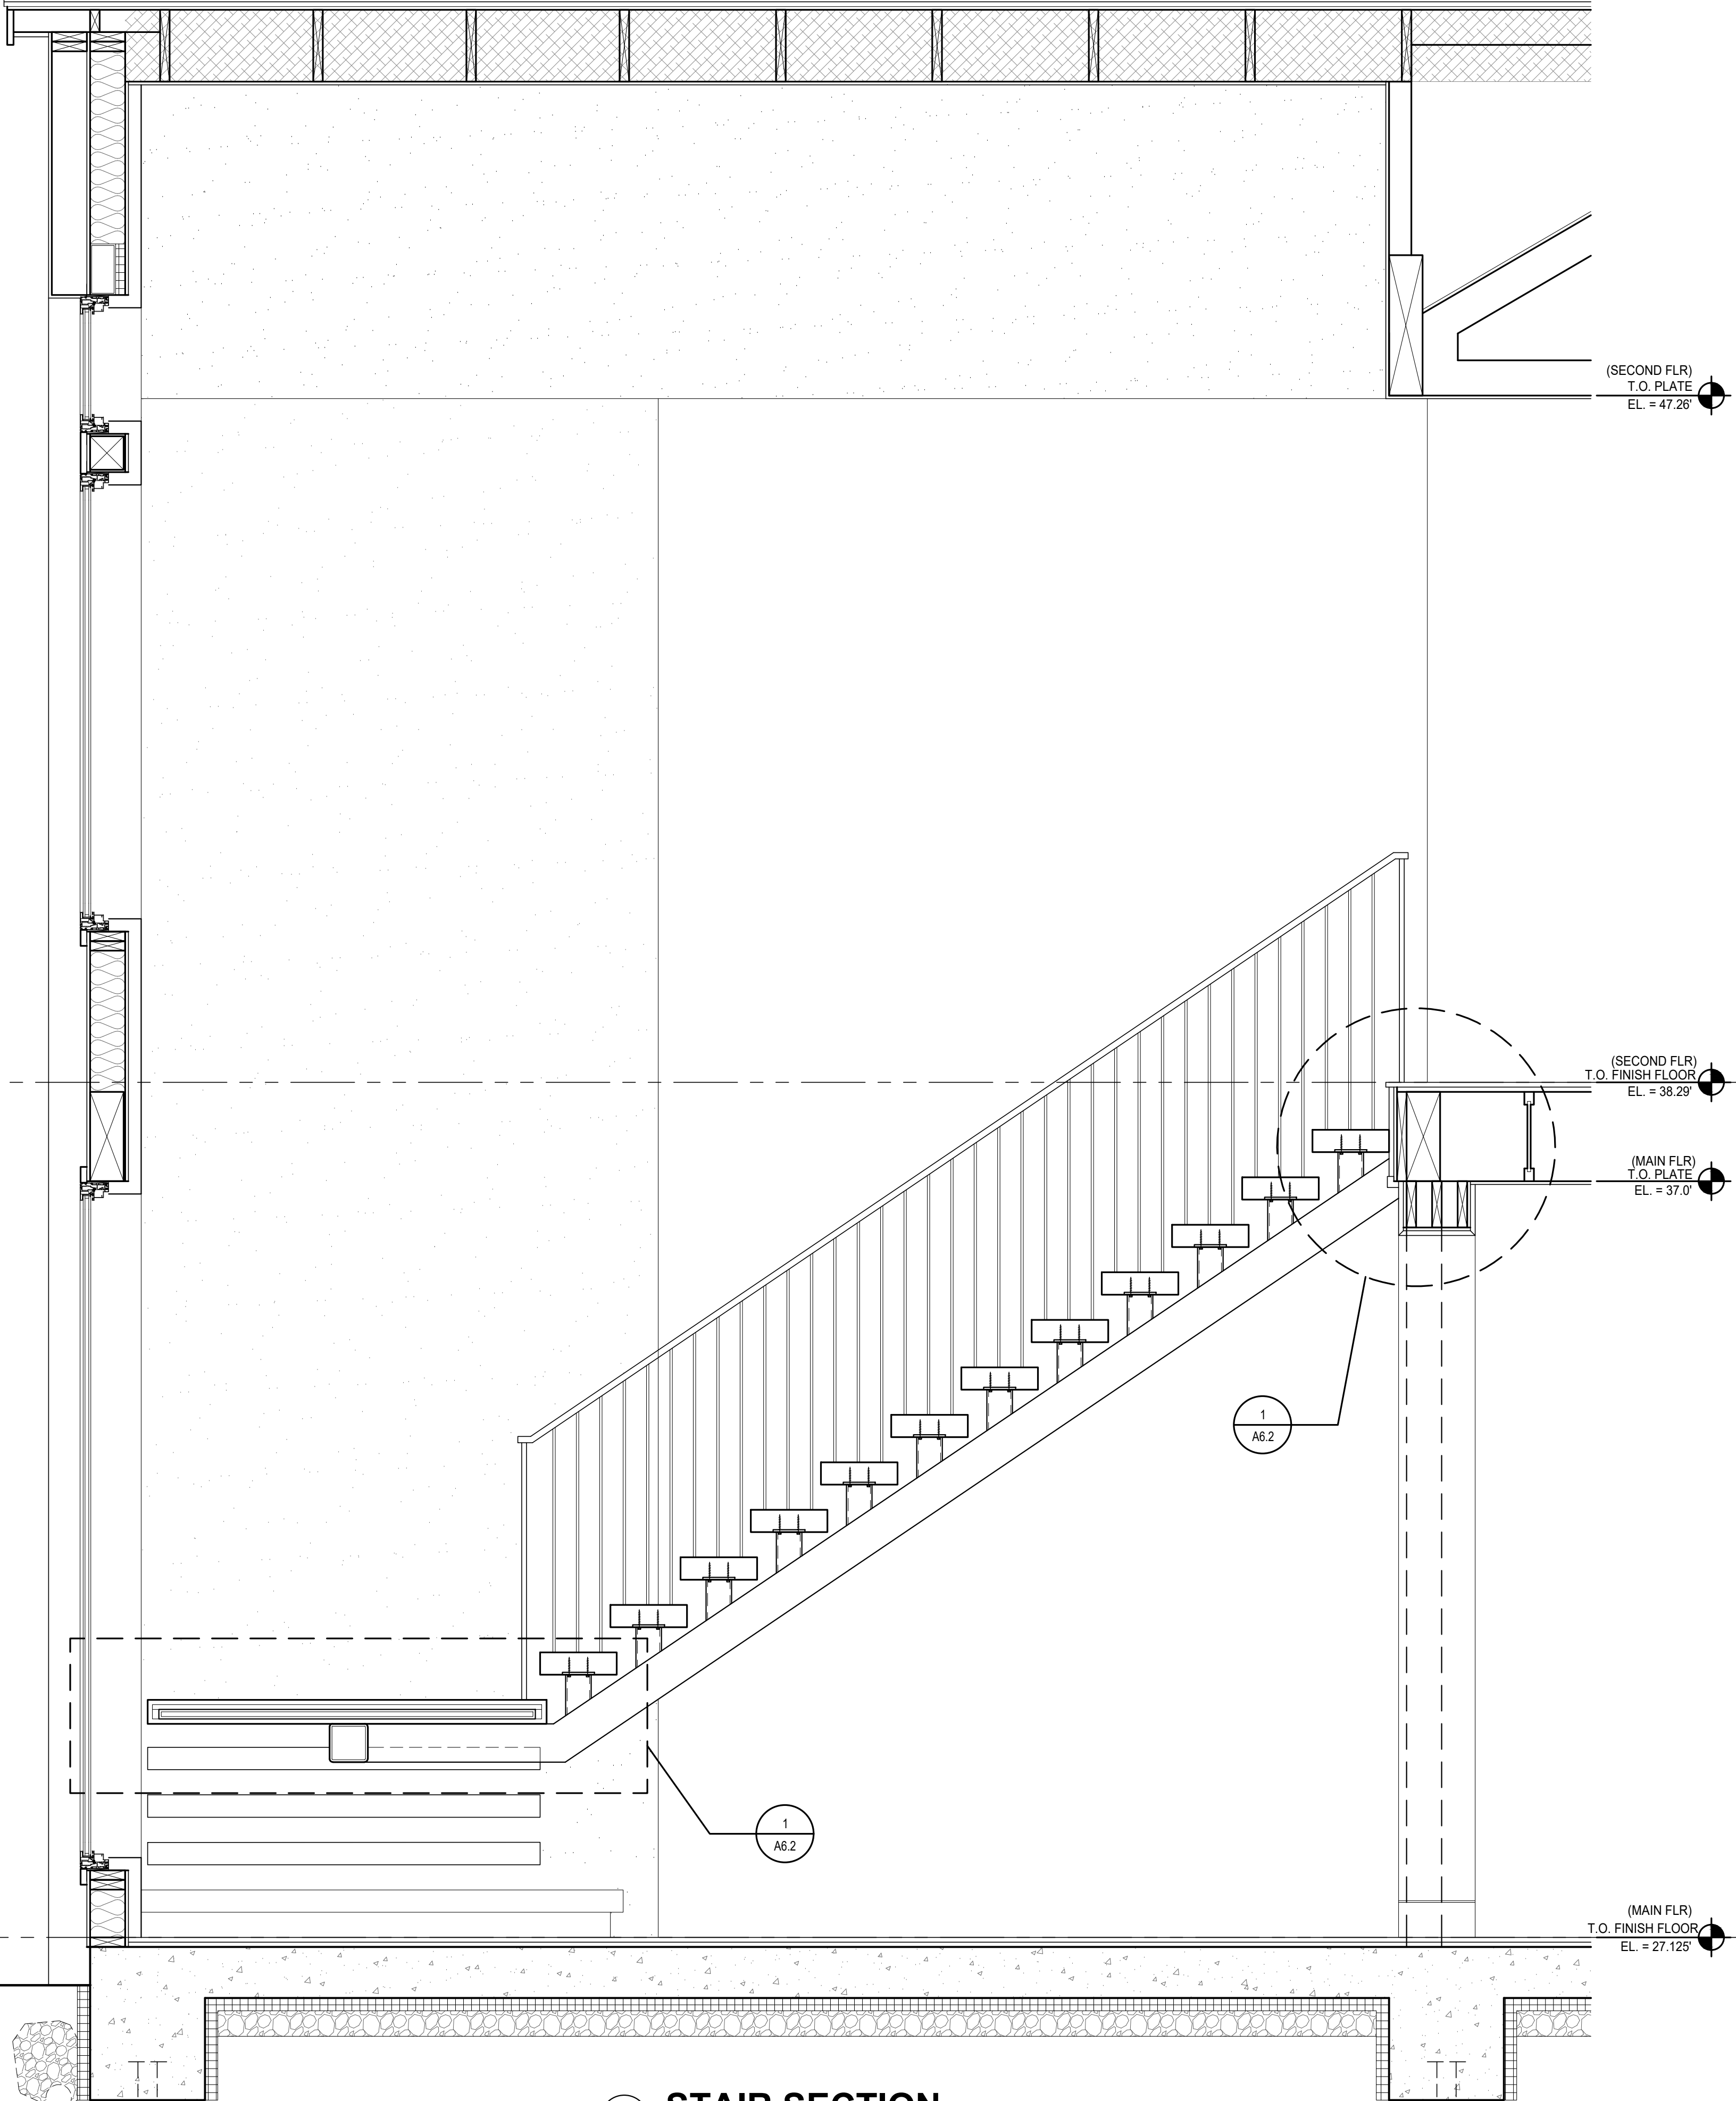

3 STAIR SECTION  
SCALE: 3/4" = 1'-0"



4 WALL ELEVATION  
SCALE: 3/4" = 1'-0"

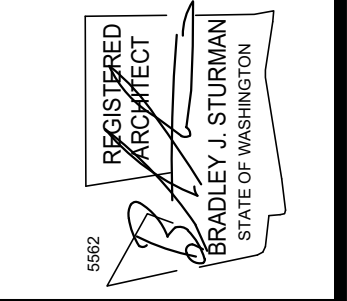

REVISIONS:

2024-5-13	Corrections #1
2024-6-18	Corrections #2
2024-11-27	Construction Set

DRAWN BY: KE  
 CHECKED BY: BUS

SHEET  
**A6.2**