



SIGNAGE OVERVIEW - NOT TO SCALE



ST-E01

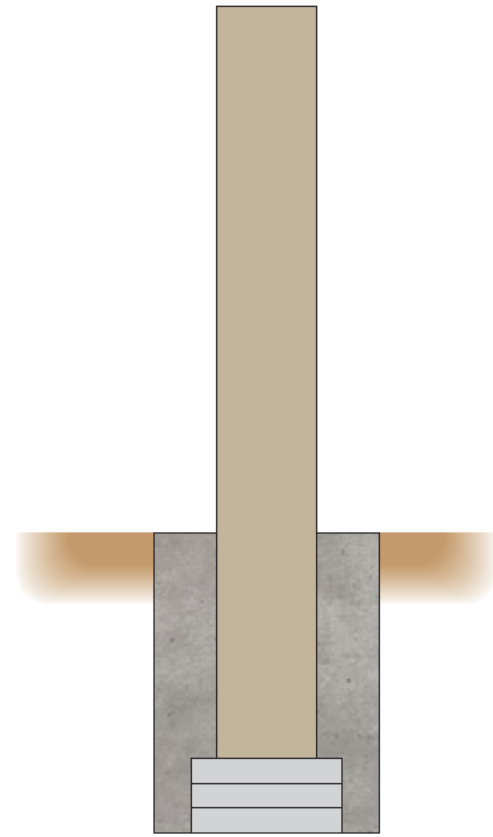

 ST-E02




COLORS/FINISHES



Match Brand Color
SW 7011, Natural Choice



 Match Brand Color
PMS 648C



Match Brand Color
PMS 202C



Match Exterior Wall
??

NOTES/OTHER

File Name: Vineyard_Park_Mercer_S08160_ProductionPack

RELEASE FOR PRODUCTION

PROJECT MANAGER:

CLIENT APPROVAL

APPROVED AS-IS

APPROVED with Changes

REVISE and RESUBMIT

DATE: 12/17/2024

Please carefully review all contents contained herein. Your signature indicates approval of all stakeholders for materials, design, colors, spelling, sizes, and fabrication and installation methods including responsibility for errors and omissions. The client will hold Northwest Sign & Design harmless and will be responsible for compensation for changes or corrections made after approval. No work will be started without signed approval or an appropriate waiver from the client.

© 2023 NW Sign & Design, all rights reserved. These drawings are the property solely of NW Sign & Design and are not to be used or reproduced in any manner without prior written permission. Penalties of \$5,000 will be charged for each page of this drawing set and/or each instance of product designs that are displayed and/or produced with unlawfully used artwork.

SIGN: *Kevin Carl*

SO#: 8160

PROJECT OVERVIEW

PAGE 1 of 5

PROJECT:
Magnet D&D - Vineyard Park Mercer Is.

CLIENT:
Magnet D & D

CONTACT:
Kevin Carl

INSTALL ADDRESS:
2959 76th Ave SE
Mercer Island, WA 98040

PROJECT MANAGER:
Shawn Hamilton

SALES:
Shawn Hamilton

DESIGNER:
N/A

PRODUCTION DESIGNER:
Michael Wells

DATE: 12/09/24

REVISIONS

MW Production	12/09/24
MW R1	02/03/24

FINAL FOR PRODUCTION



NORTHWEST

SIGN & DESIGN

17201 Beaton Rd. SE
Monroe, WA 98272
www.NWSigns.com
(425) 844-6415

Contractors Lic#NWWHOS'g29Mg



**ST-E01
MONUMENT SIGN
INSTALLATION**

Qty. 1




Existing Signage



Proposed Final Design

- 1** - Installation of existing sign into new concrete footing, leaving 42" of existing sign exposed above grade. Use concrete pavers to achieve specified position

Note: Assumes plants are removed and ground is leveled prior to NWS arrival. Assumes just in time delivery to site, by others. Boulders supplied and installed by others

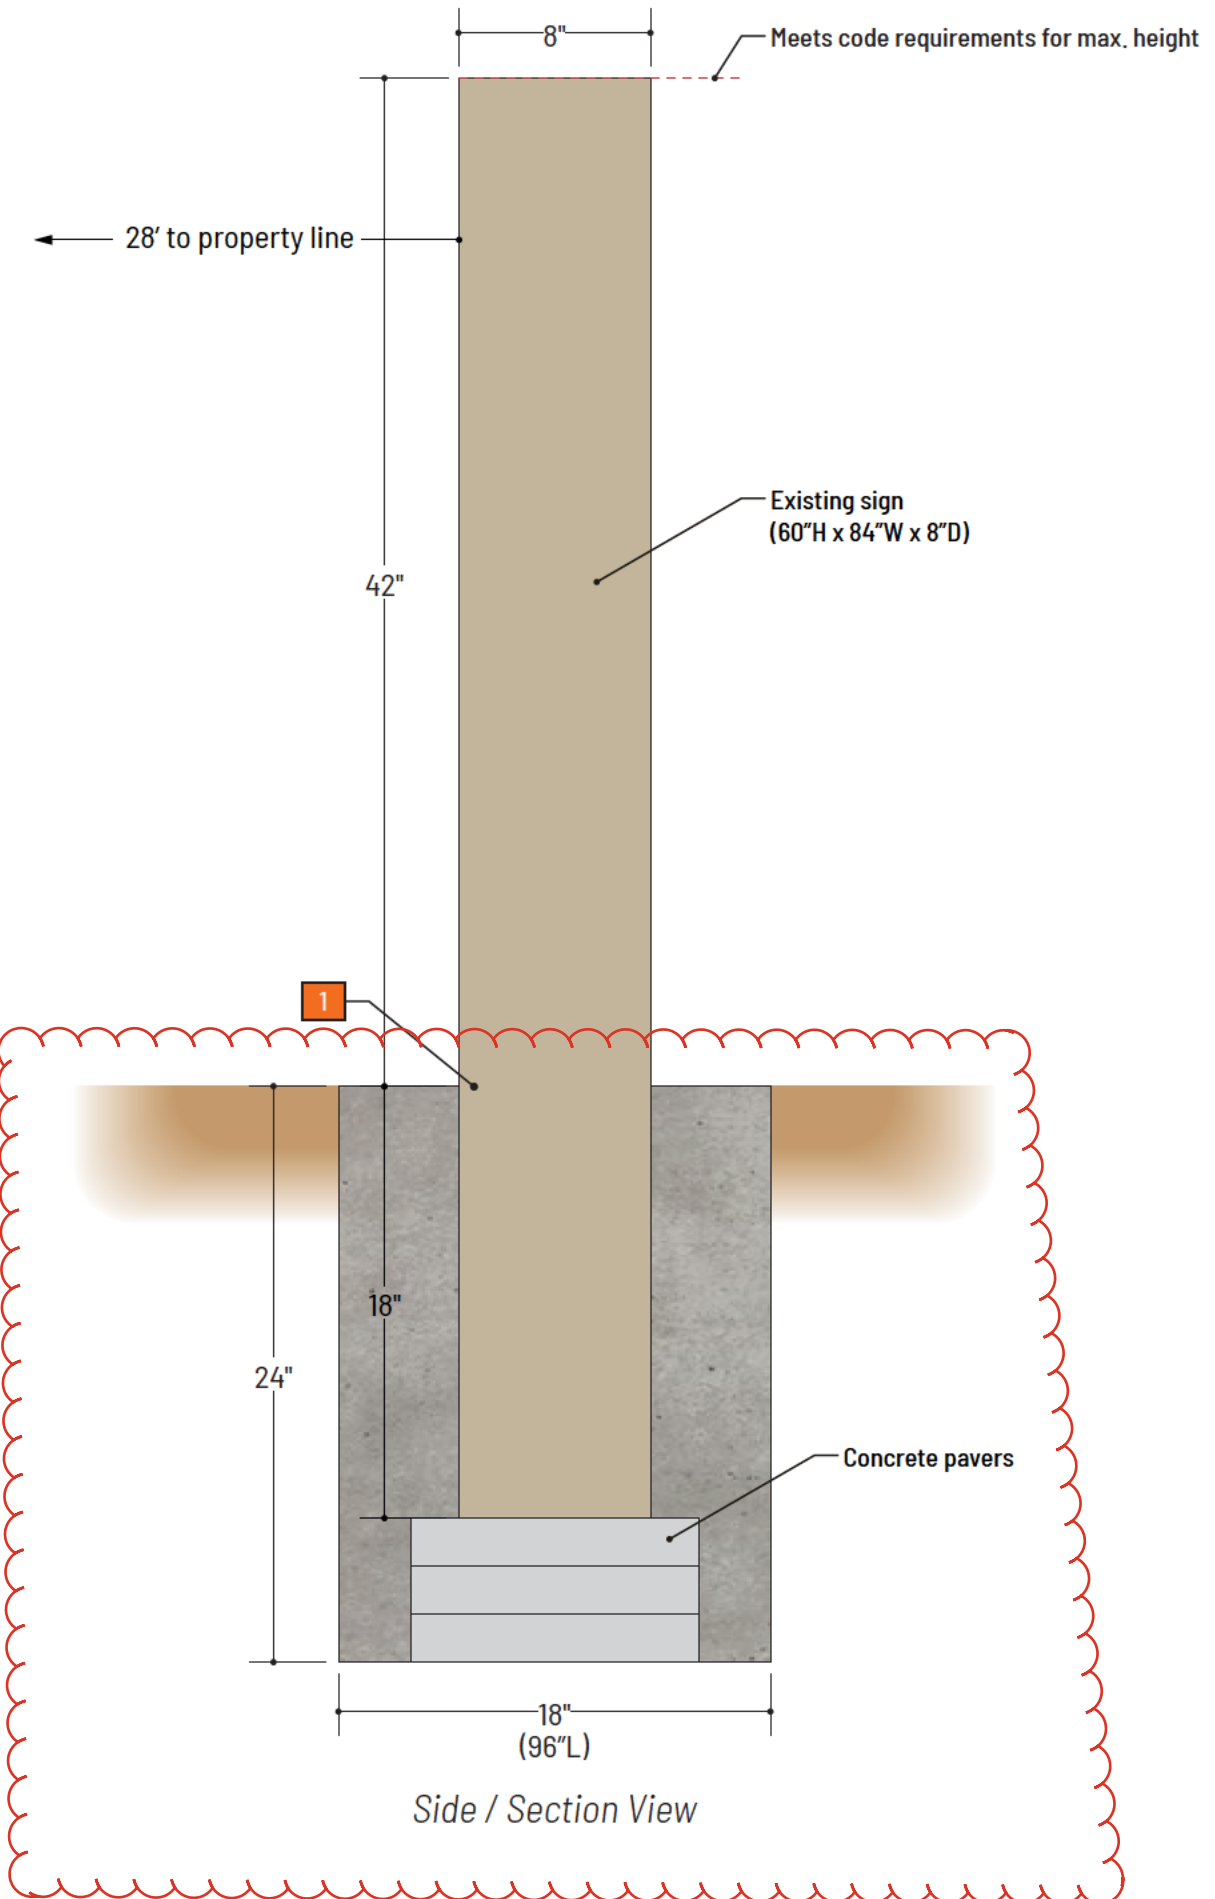

SCALE: 1" = 1'

ST-E02 WALL LOGO SIGN Qty. 1

COLOR SUMMARY

PAINT


A  MP TO MATCH PMS 648C SATIN FINISH

B  MP TO MATCH EXT. WALL (??) SATIN FINISH

- 1 - 1/8" aluminum face, routed and painted **A**. 1 1/2" x 1 3/4" aluminum angle tack welded to reverse side for wall mounting, painted **B** to match wall color
- 2 - 1/4" clear polycarbonate backer, lowered at top and notched in lower corners to accomodate recessed angle, mounted to aluminum face with studs and VHB
- 3 - Layered assembly installs to wall using aluminum angle cleats. Cleats will install to wall using 3/8" x 3 1/2" long (min.) non-corrodible lag bolts (min. qty. x2 at top / min. qty. x2 at bottom). Sign face will secure to wall cleats using non-corrodible #10 cap head screws thru top/bottom returns. Min. qty. x4 at top and min. qty. x4 at bottom




Proposed Install Location - Details Pending Survey

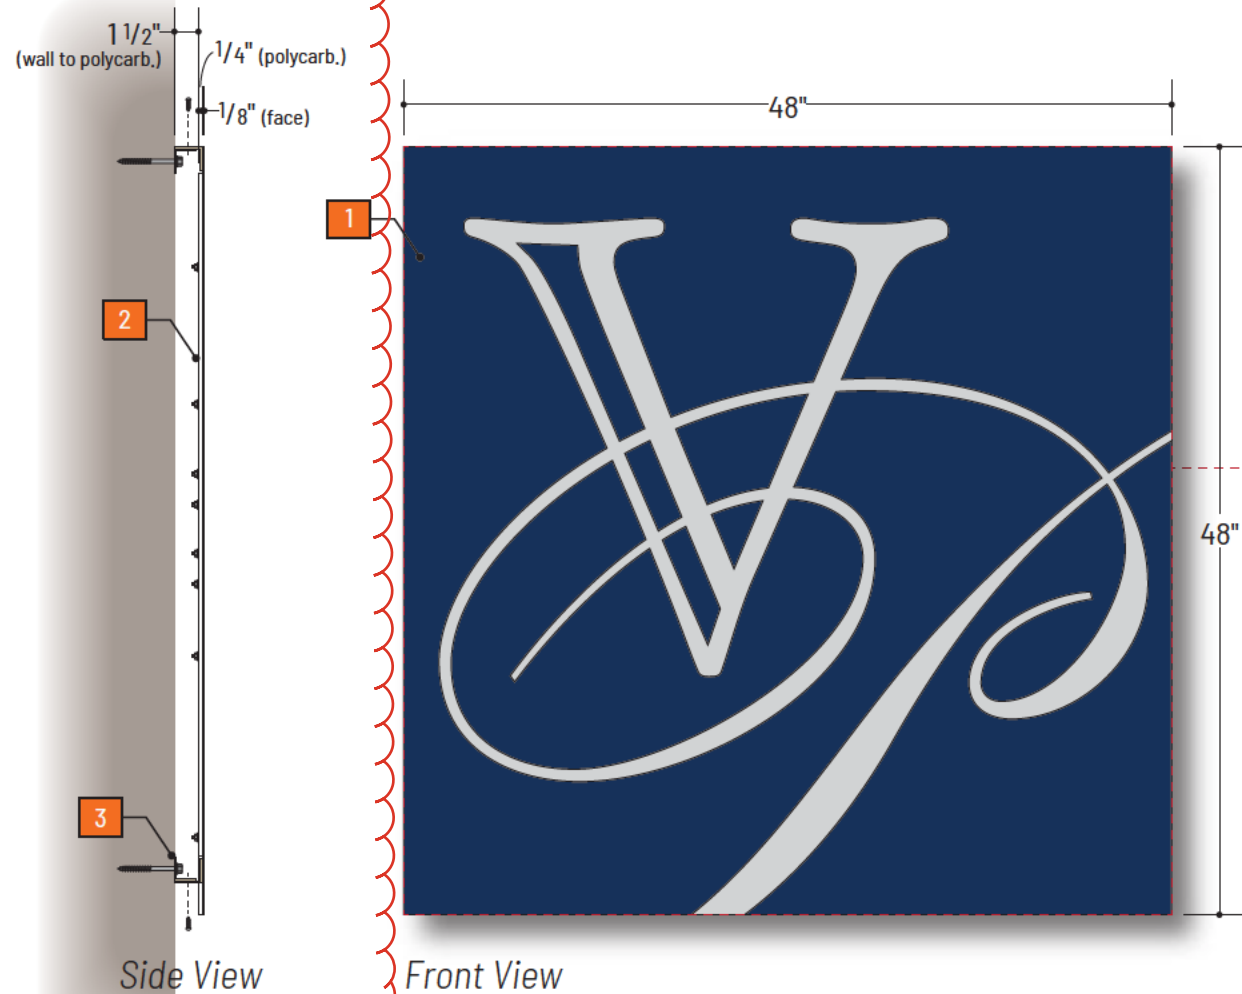

Side View

Front View

Sign Area: 16 sq/ft

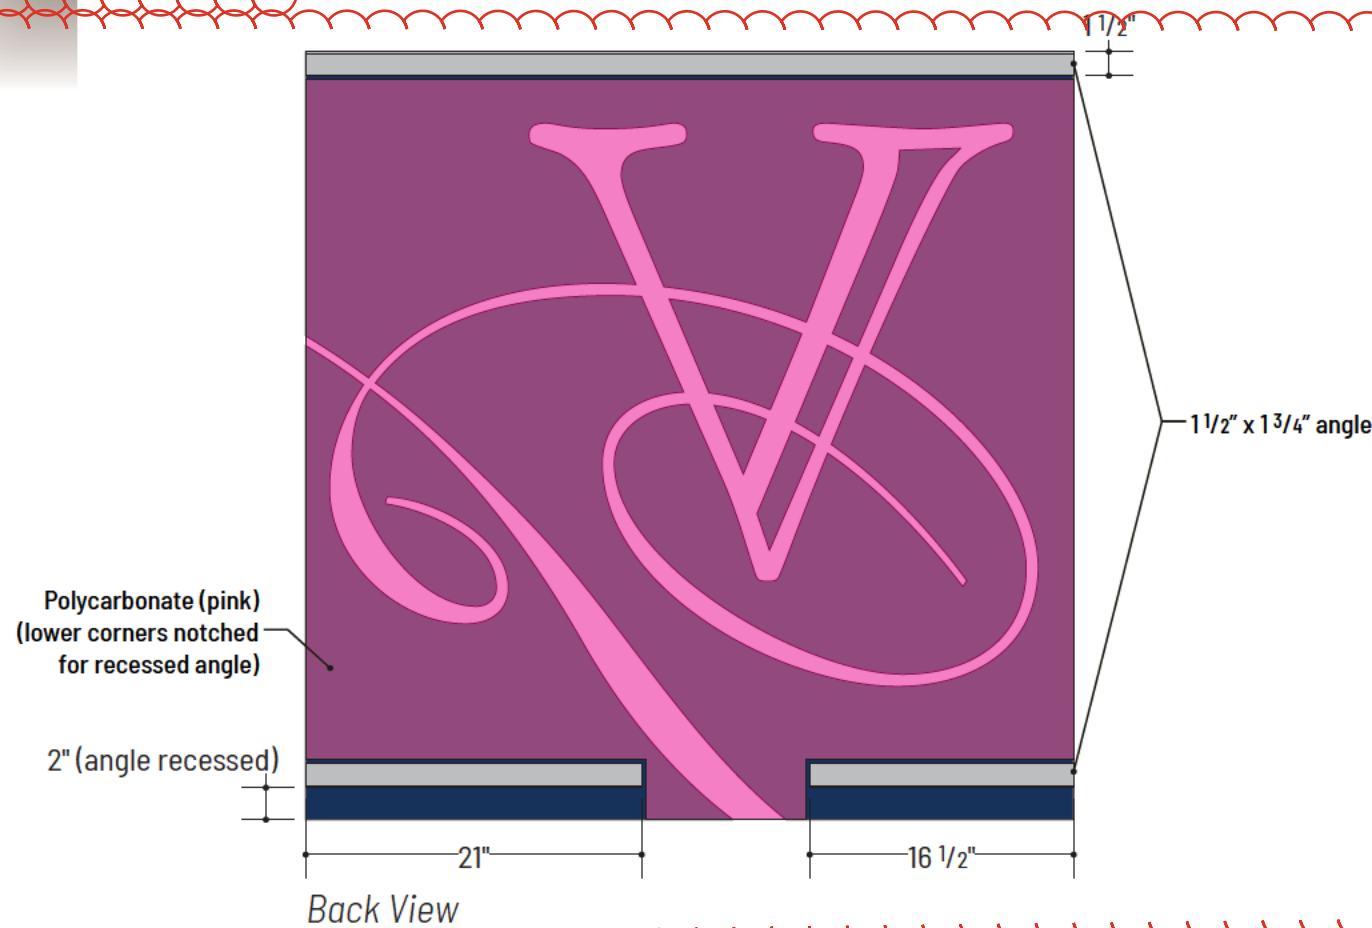

Back View




SO#: 8160

SITE PLAN


PAGE 5 of 5

VINEYARD PARK - MERCER ISLAND


ADDRESS:
2959 76th Ave SE
Mercer Island, WA 98040
PARCEL:
5315100905
ZONING:

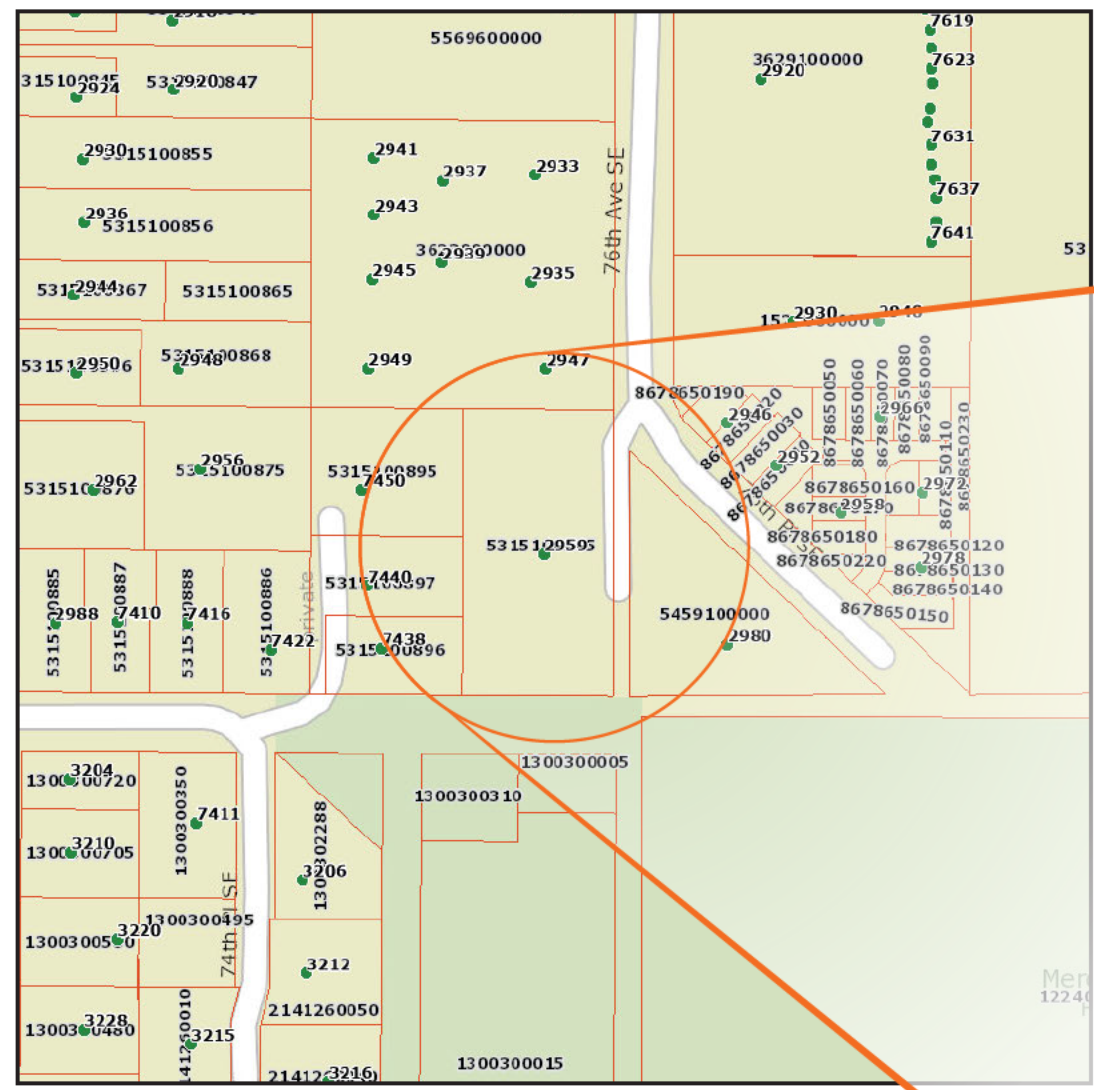

**R.O.W. Frontage:
157'**

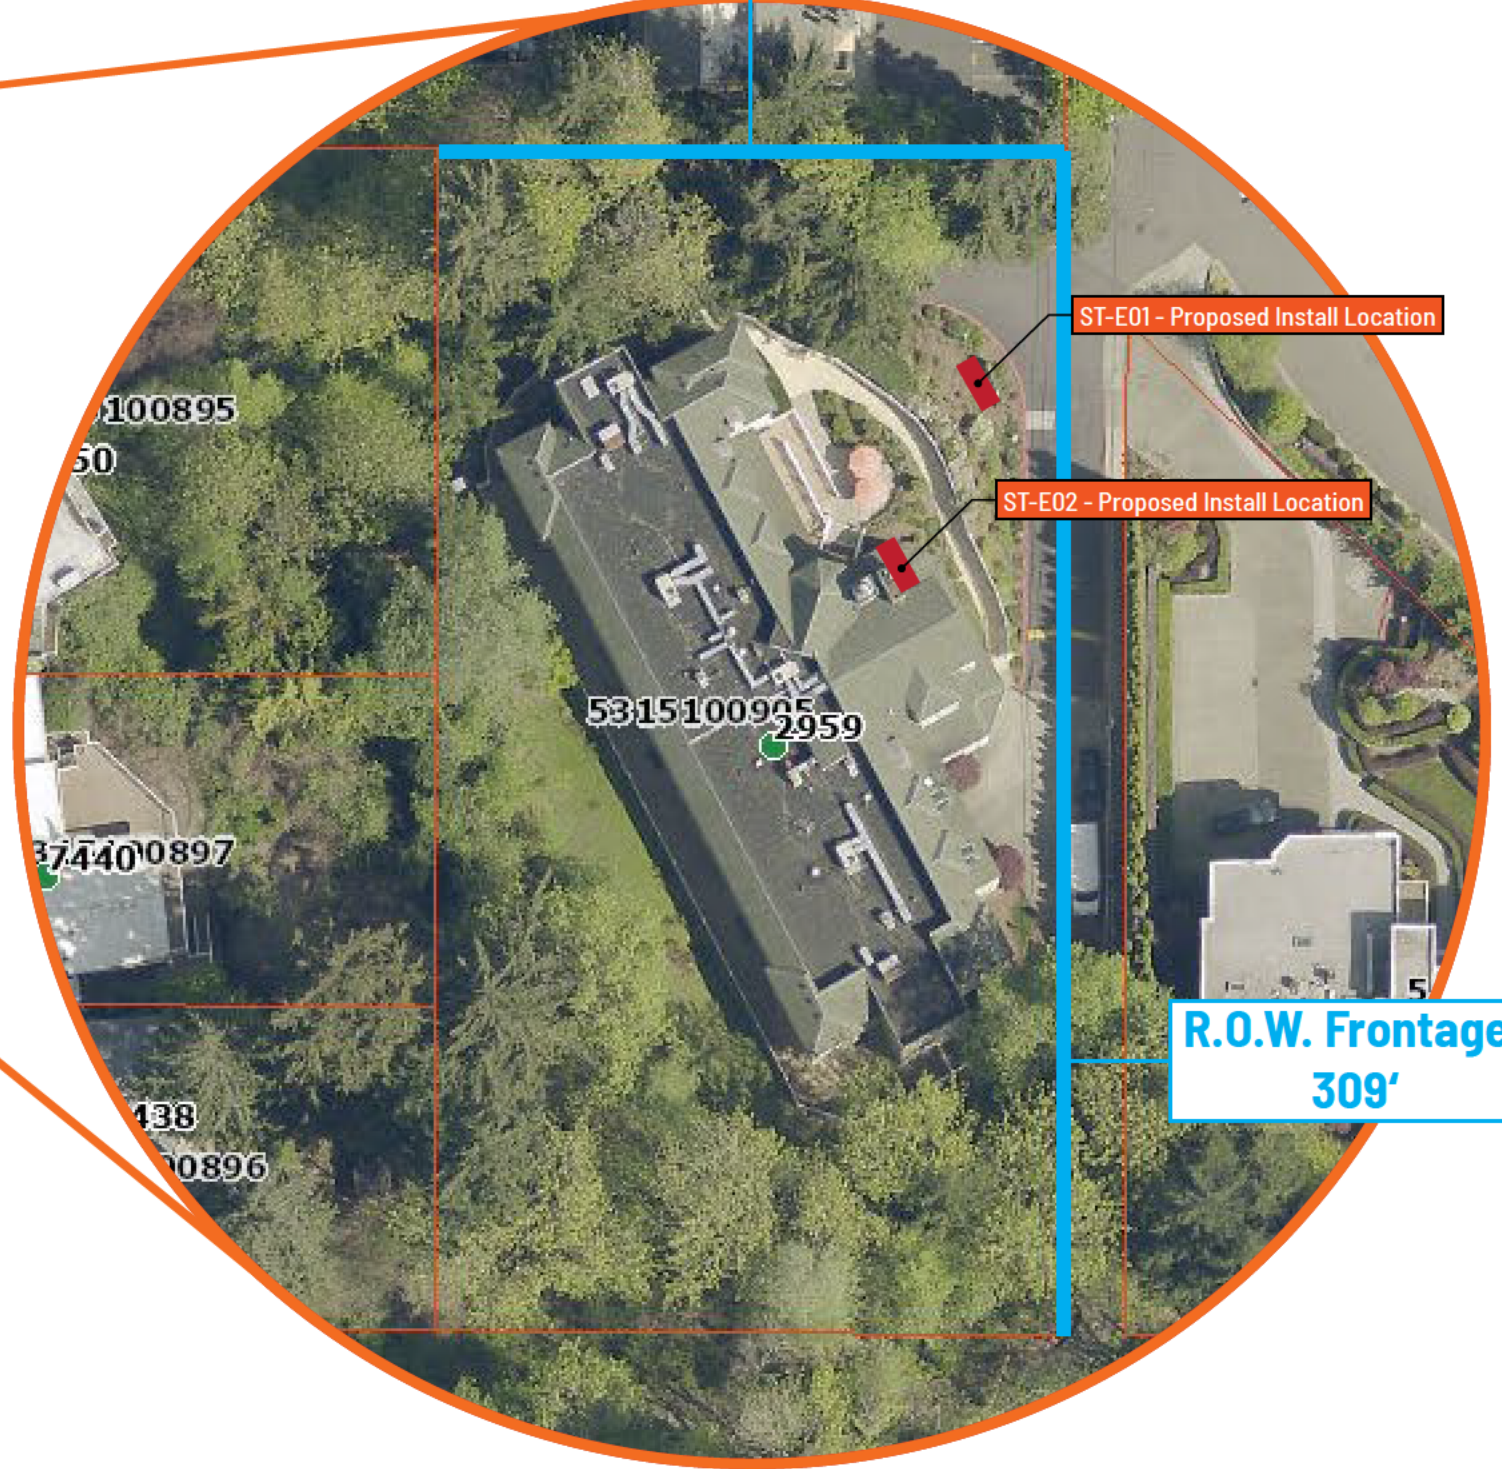

**R.O.W. Frontage:
309'**

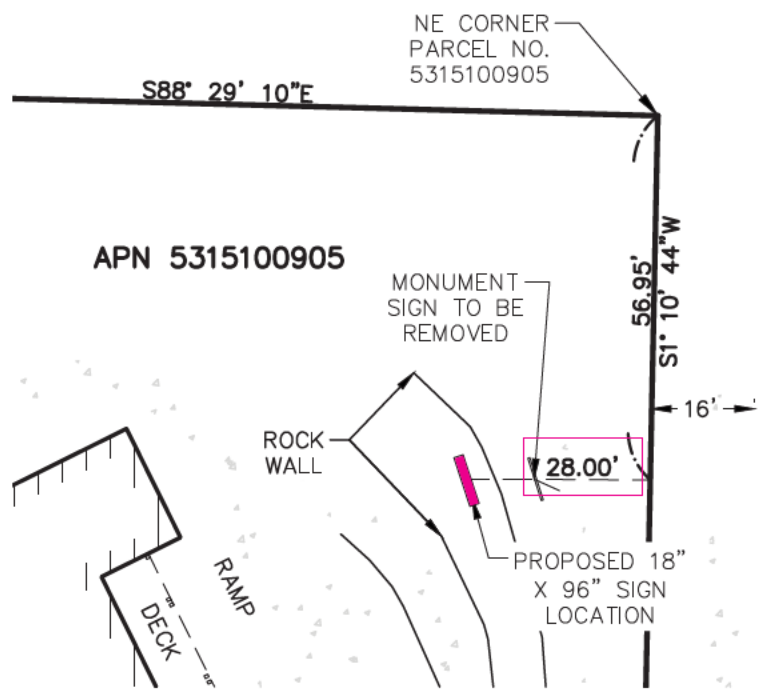

ST-E02 Placement - Property Line - No Scale