


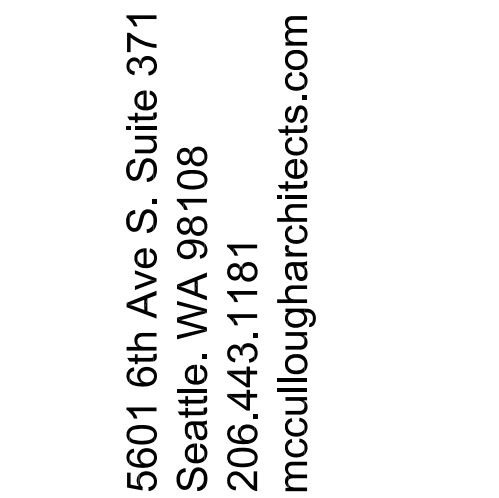

McCULLOUGH
ARCHITECTS

REVISION

Reviewed
Kolke Consulting Group, Inc.
C. Kolke
04/15/2023

ED
DE
NCE

Comment	
Revised plans for distribution	
Revised floor elevation	
Client Rev Structural Backcheck 03	
Client Rev Structural Backcheck 04	
Client Site Plan Revision	
Client Site & Plan Rev - Backcheck 01	
Client Site & Plan Rev - Backcheck 02	
Client Site & Plan Rev - Backcheck 03	
Client Site & Plan Rev - Backcheck 04	
Permit Plan Revision \$	
Permit Plan Revision C	

Revisions
2022.10.04
2023.01.18
2023.01.25
2023.02.03
2023.02.16
2023.02.20
2023.02.24
2023.03.02
2023.03.06
2023.03.16
2023.04.14

2021.10.13
21-041
DJR
APM

Date:
Job No:
Project No:
Drawn:
Approved:

STATE OF WASHINGTON

NCE

IDENT 3040

KONERU RES
6610 E Mercer Way
Mercer Island, WA 98040


PERMIT SET

Arch Site Plan

A1

A1

A2

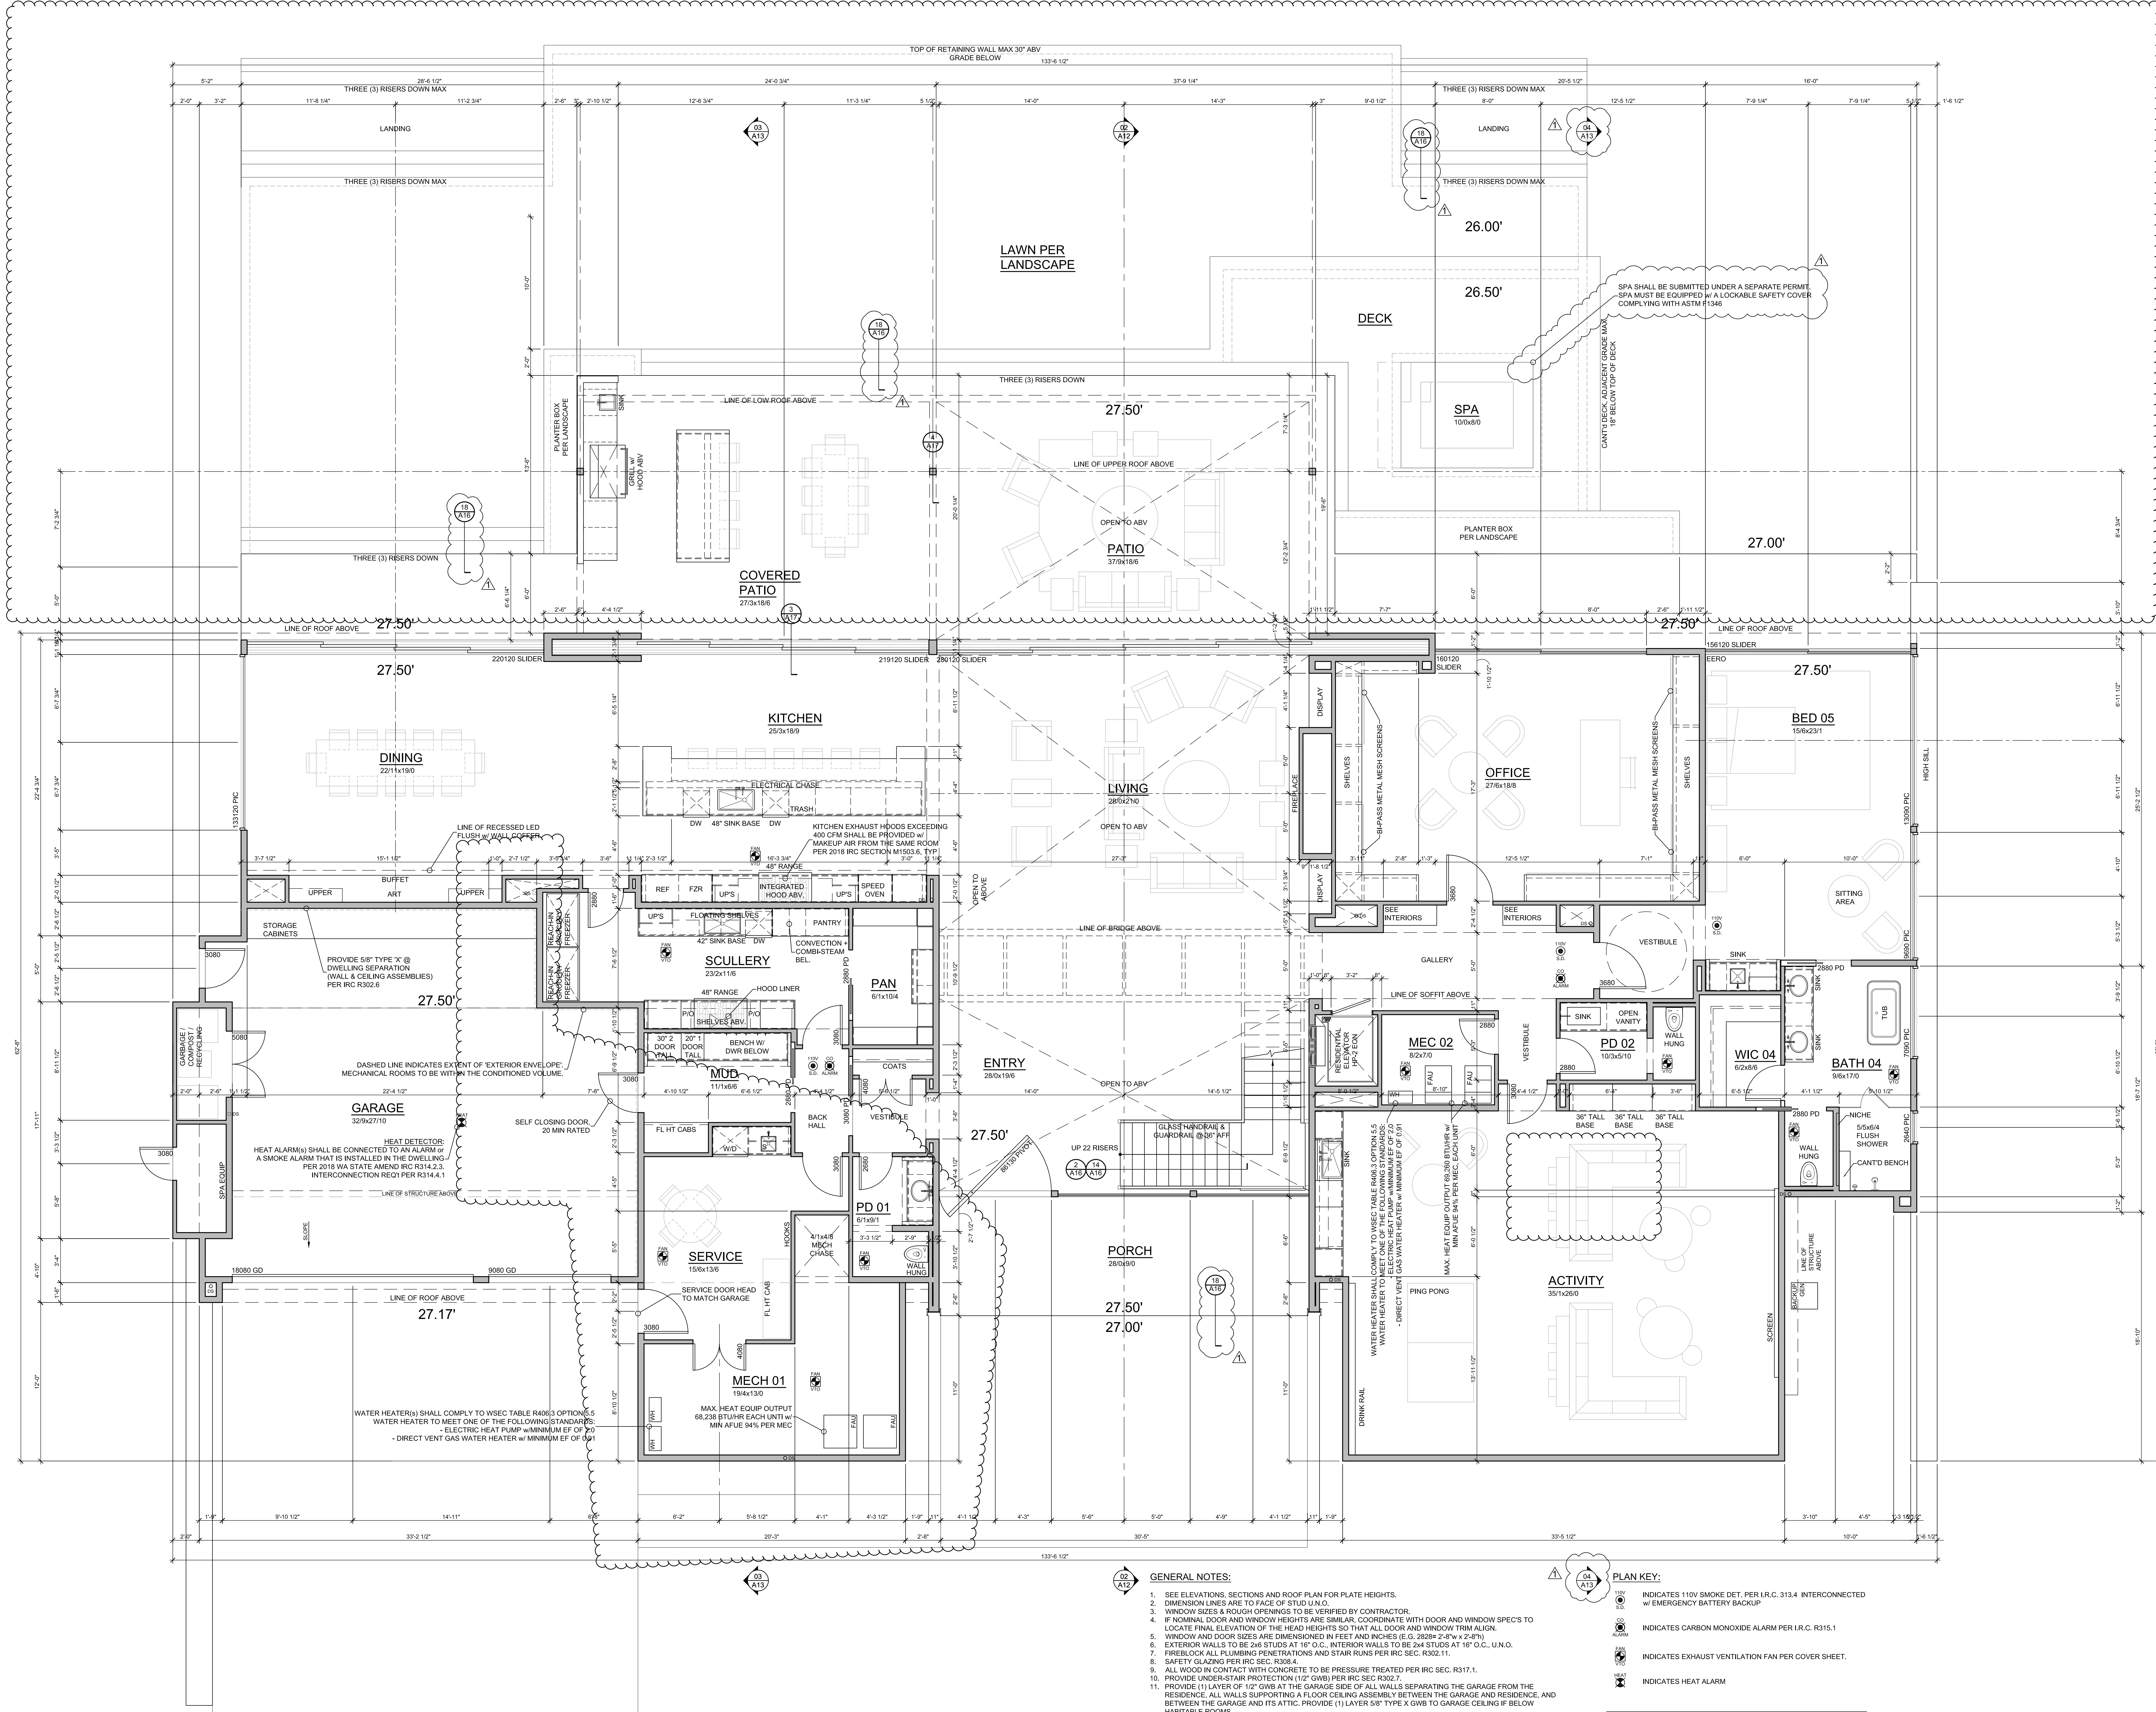

Seattle, WA 98108
206.443.1181
mccullougharchitects.com

REVISION

Reviewed
Koke Consulting Group, Inc.
C. Koke
04/19/2023

REVIEWED FOR CODE COMPLIANCE

REVISION 1

Comment

Revised plans for distribution

2021.10.13

21-041

Date:

Job No:

Project No:

Drawn:

Approved:

2023.03.16

2023.04.14

2023.03.16

2023.04.14
































KONERU RESIDENCE

6610 E Mercer Way
Mercer Island, WA 98040

PERMIT SET

Main Floor Plan

A5

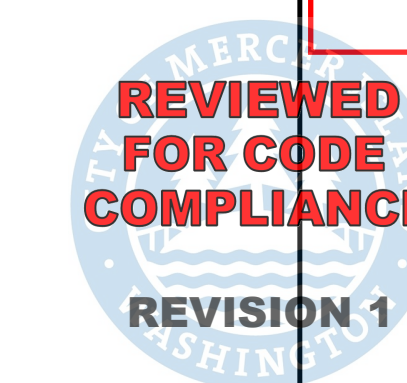


A9


7806 REGISTERED SUBJECT
PHILIP MICHAEL MCGOUGH
STATE OF WASHINGTON

McCULLOUGH
ARCHITECTS


UNPUBLISHED WORK 2016 © McCullough Architects

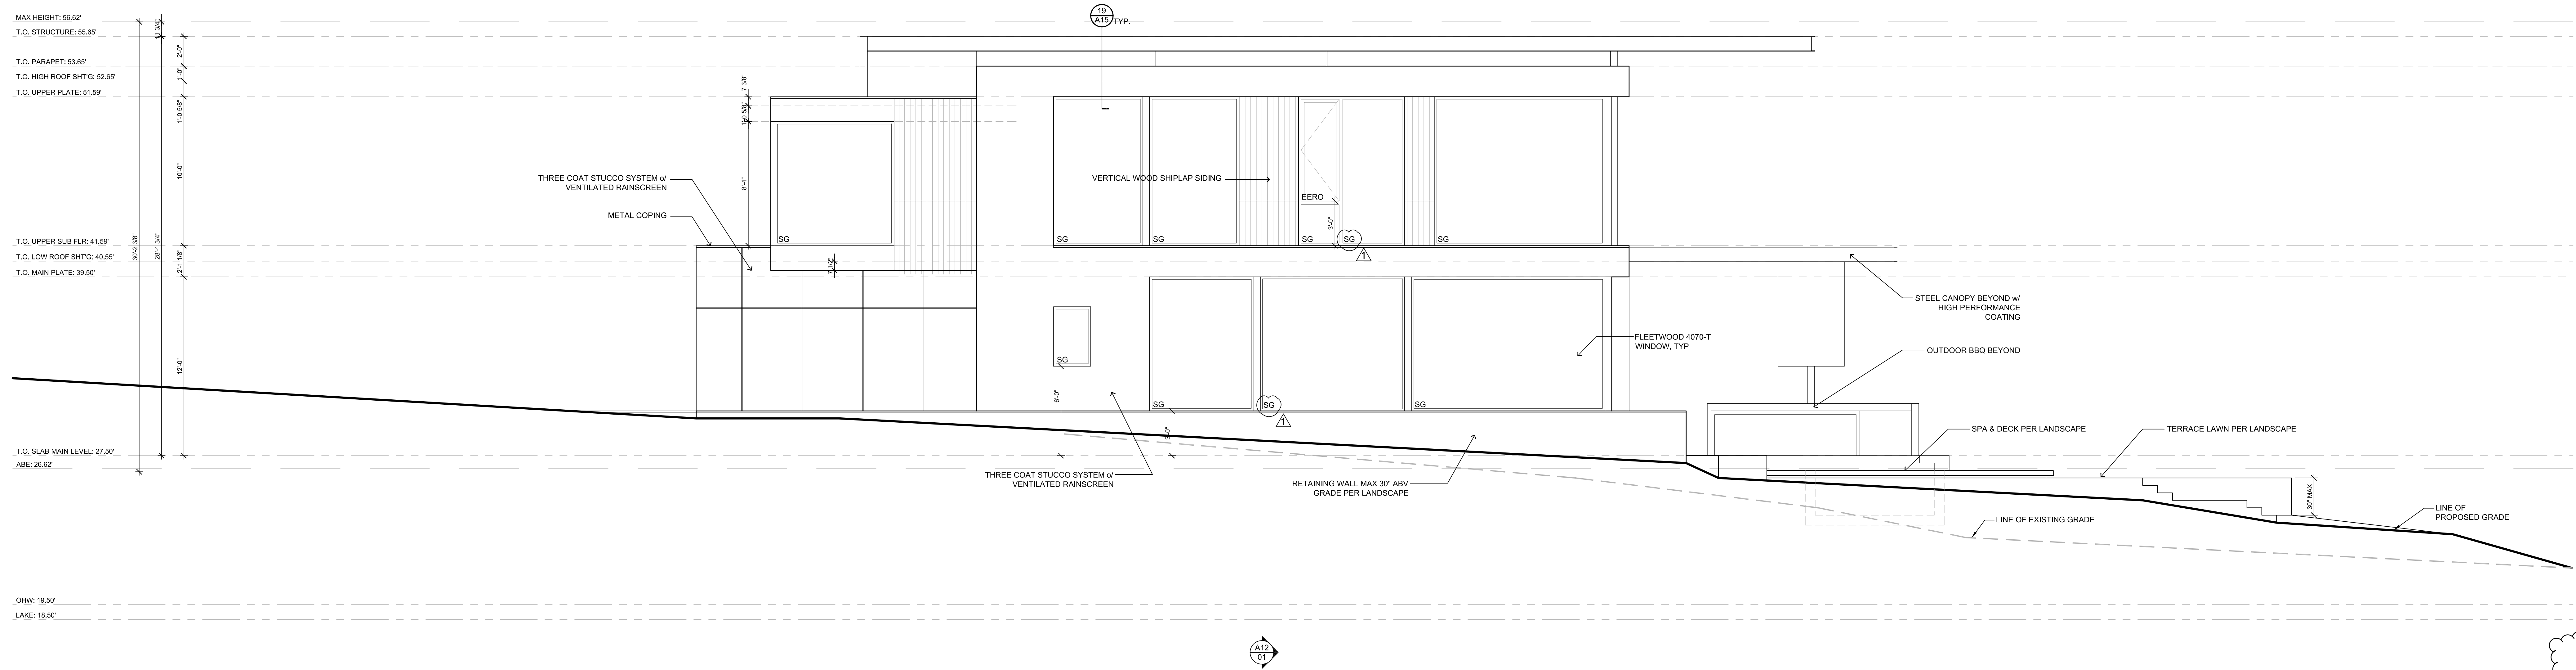


SCALE: 1/4" = 1'-0"

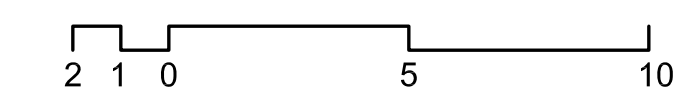


SCALE: 1/4" = 1'-0"

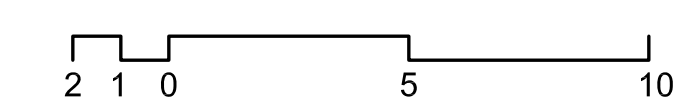

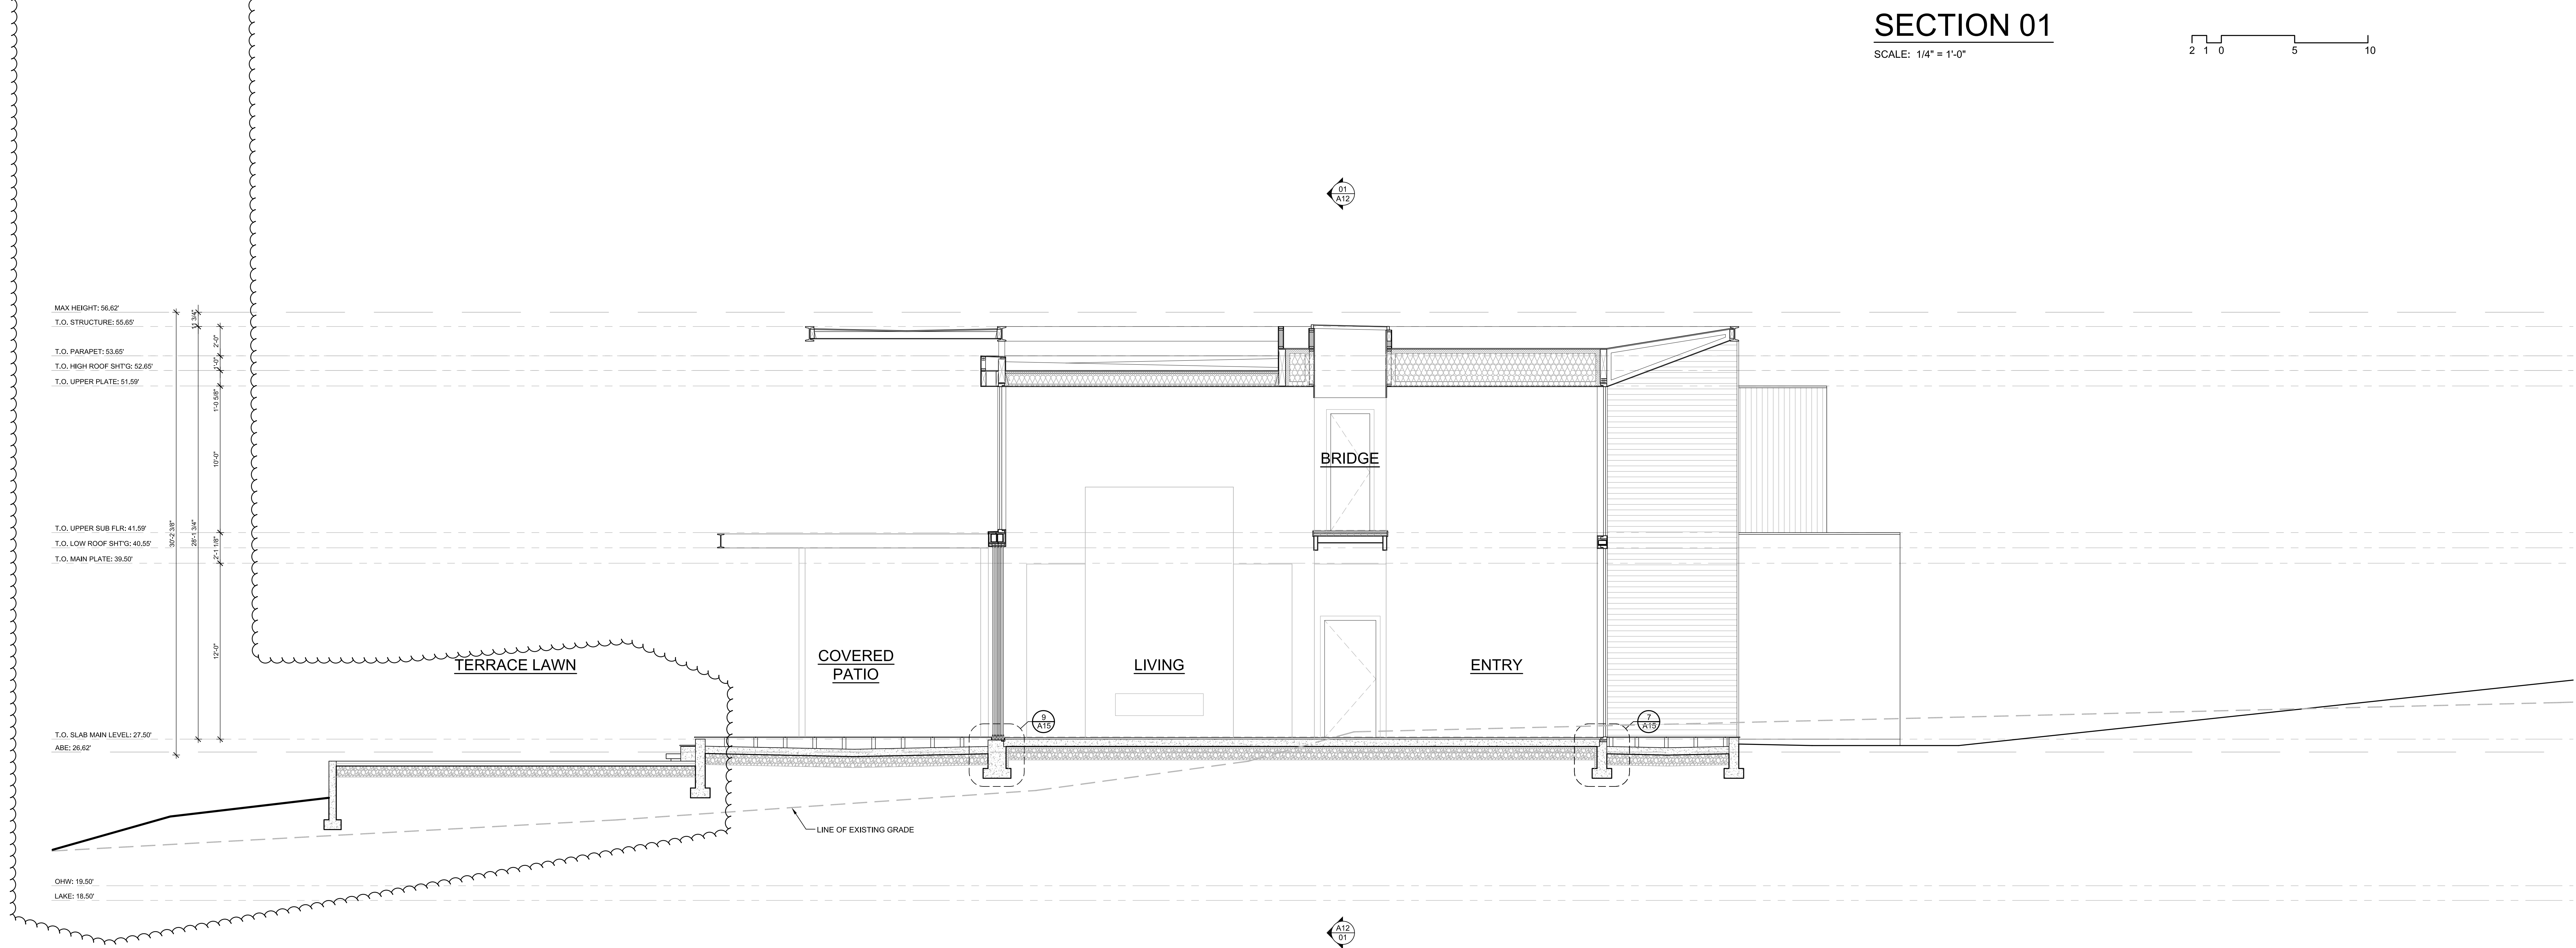


A12


UNPUBLISHED WORK 2016 © McCullough Architects

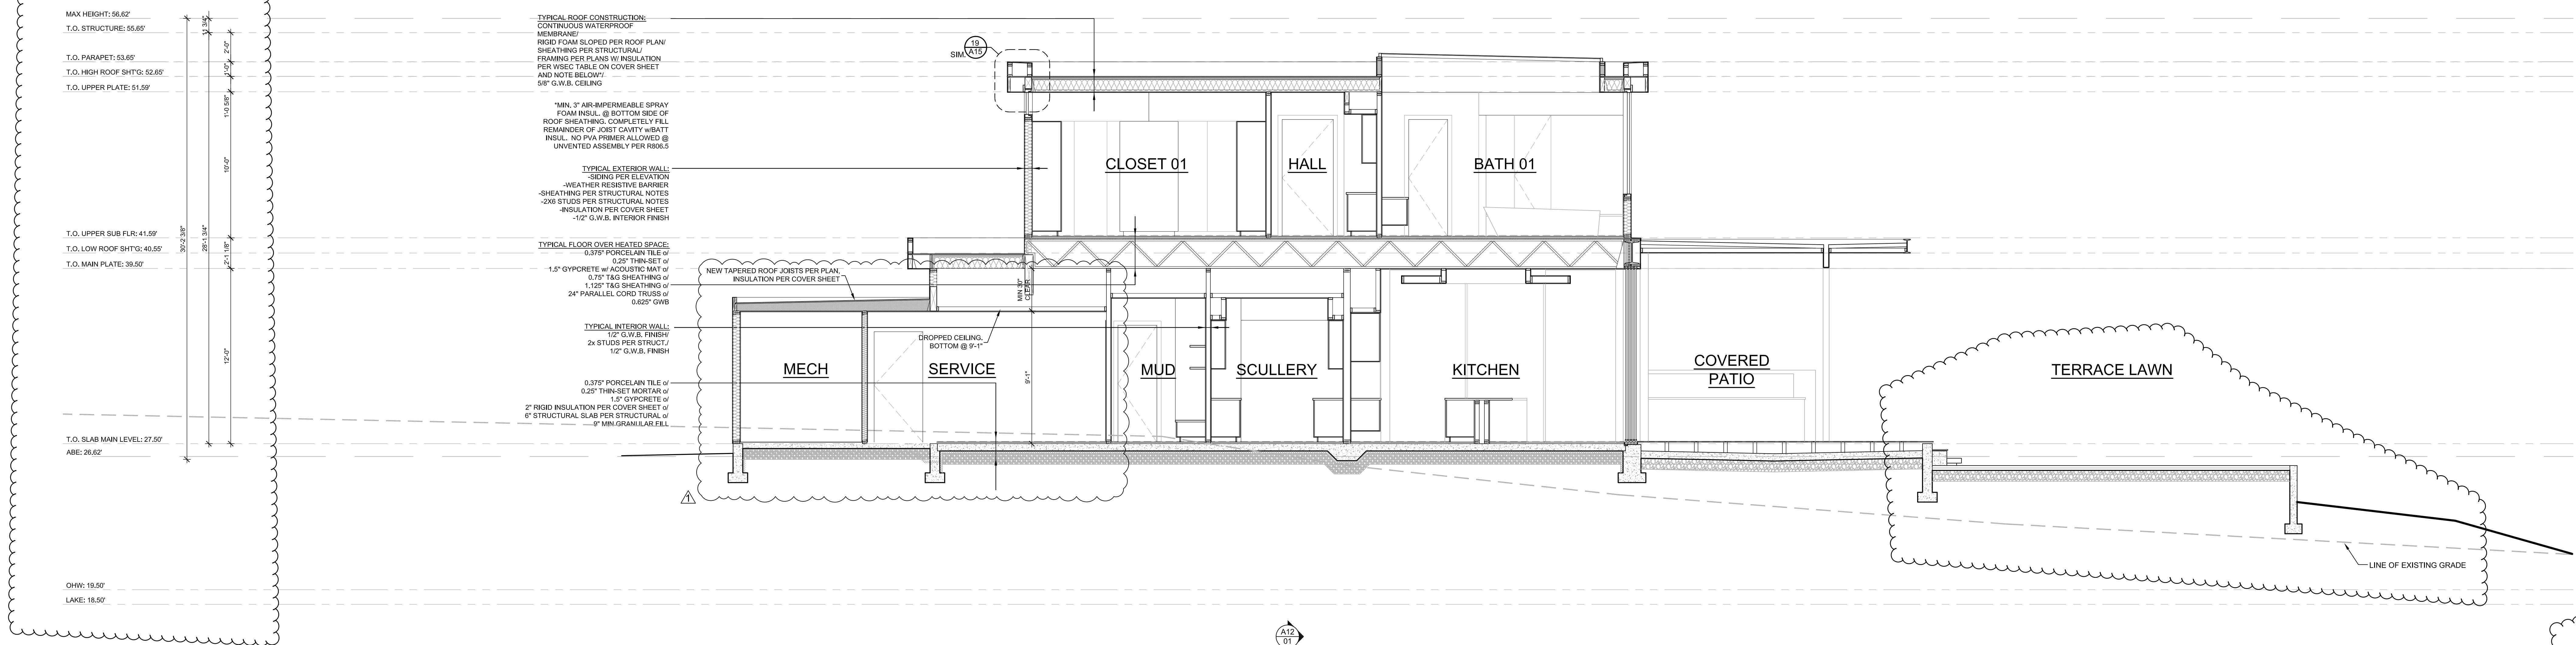


SCALE: 3/4" = 1'-0"

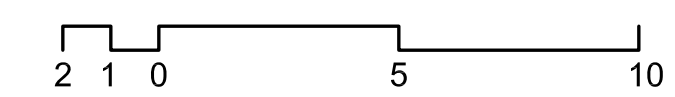

SCALE: 1/4" = 1'-0"

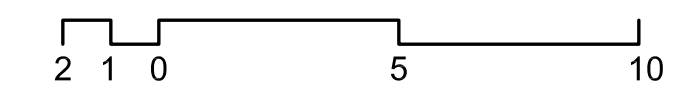



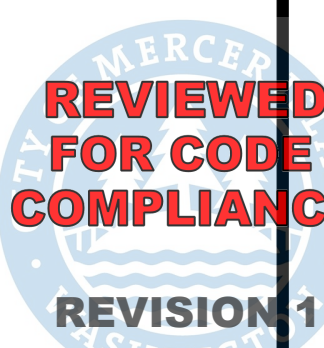

GENERAL STRUCTURAL NOTES

THE FOLLOWING APPLY UNLESS SHOWN OTHERWISE ON THE DRAWINGS

CRITERIA

- ALL MATERIALS, WORKMANSHIP, DESIGN, AND CONSTRUCTION SHALL CONFORM TO THE DRAWINGS, SPECIFICATIONS, AND THE INTERNATIONAL BUILDING CODE (IBC) 2018 EDITION.
- DESIGN LOADING CRITERIA
FLOOR LIVE LOAD (RESIDENTIAL) 40 PSF
FLOOR LIVE LOAD (RESIDENTIAL DECKS AND BALCONIES) 25 PSF
SNOW 25 PSF
RAIN ON SNOW SURCHARGE 5 PSF
SOLAR PANEL WIND METHOD - DIRECTIONAL PROCEEDURE
Kz=1.0, GcPd=0.18, 110 MPH (RISK CATEGORY II), EXPOSURE "C"
ANALYSIS PROCEDURE: EQUIVALENT LATERAL FORCE PROCEDURE
LATERAL SYSTEM: LIGHT FRAMED SHEAR WALLS
SDC D, SITE CLASS E, I=1.0, Ss=1.45, Si=0.50
SDs=1.059, Sd1=0.567, Cs=0.163, R=6.5
SEISMIC DESIGN BASE SHEAR Vxx=68.0 KIPS(ULTIMATE)
- EARTHQUAKE

- STRUCTURAL DRAWINGS SHALL BE USED IN CONJUNCTION WITH STRUCTURAL DRAWINGS FOR BIDDING AND CONSTRUCTION. CONTRACTOR SHALL VERIFY DIMENSIONS AND CONDITIONS FOR COMPATIBILITY AND SHALL NOTIFY ARCHITECT OF ANY DISCREPANCIES PRIOR TO CONSTRUCTION.
- PRIMARY STRUCTURAL ELEMENTS NOT DIMENSIONED ON THE STRUCTURAL PLANS AND DETAILS SHALL BE LOCATED BY THE ARCHITECT'S PLANS. DIMENSIONAL CONTROL IS DEFINED BY THE ARCHITECTURAL WALL SECTIONS, BUILDING SECTIONS, AND PLANS. DETAILING AND SHOP DRAWING PRODUCTION FOR STRUCTURAL ELEMENTS WILL REQUIRE DIMENSIONAL INFORMATION CONTAINED IN BOTH ARCHITECTURAL AND STRUCTURAL DRAWINGS.

- CONTRACTOR SHALL PROVIDE TEMPORARY BRACING FOR THE STRUCTURE AND STRUCTURAL COMPONENTS UNTIL ALL FINAL CONNECTIONS HAVE BEEN COMPLETED IN ACCORDANCE WITH THE PLANS. CONFORM TO ASCE 37-14 "DESIGN LOADS ON STRUCTURES DURING CONSTRUCTION".

- CONTRACTOR SHALL BE RESPONSIBLE FOR ALL SAFETY PRECAUTIONS AND THE METHODS, TECHNIQUES, SEQUENCES OR PROCEDURES REQUIRED TO PERFORM THE CONTRACTOR'S WORK. THE STRUCTURAL ENGINEER HAS NO OVERALL SUPERVISORY AUTHORITY OR ACTUAL AND/OR DIRECT RESPONSIBILITY FOR THE SPECIFIC WORKING CONDITIONS AT THE SITE AND/OR FOR ANY HAZARDS RESULTING FROM THE ACTIONS OF ANY TRADE CONTRACTOR. THE STRUCTURAL ENGINEER HAS NO DUTY TO INSPECT, SUPERVISE, NOTE, CORRECT, OR REPORT ANY HEALTH OR SAFETY DEFICIENCIES TO THE OWNER, CONTRACTORS, OR OTHER ENTITIES OR PERSONS AT THE PROJECT SITE.

- CONTRACTOR-INITIATED CHANGES SHALL BE SUBMITTED IN WRITING TO THE ARCHITECT AND STRUCTURAL ENGINEER FOR APPROVAL PRIOR TO FABRICATION OR CONSTRUCTION. CHANGES SHOWN ON SHOP DRAWINGS ONLY WILL NOT SATISFY THIS REQUIREMENT.

- DRAWINGS INDICATE GENERAL AND TYPICAL DETAILS OF CONSTRUCTION, WHERE CONDITIONS ARE NOT SPECIFICALLY INDICATED BUT ARE OF SIMILAR CHARACTER TO DETAILS SHOWN. SIMILAR DETAILS OF CONSTRUCTION SHALL BE USED. SUBJECT TO REVIEW AND APPROVAL BY THE ARCHITECT AND THE STRUCTURAL ENGINEER.

- ALL STRUCTURAL SYSTEMS WHICH ARE TO BE COMPOSED OF COMPONENTS TO BE FIELD ERRECTED SHALL BE SUPERVISED BY THE SUPPLIER DURING MANUFACTURING, DELIVERY, HANDLING, STORAGE, AND ERECTION IN ACCORDANCE WITH INSTRUCTIONS PREPARED BY THE SUPPLIER. MANUFACTURERS INSTALLATION INSTRUCTIONS SHALL BE AVAILABLE ON THE JOB SITE AT THE TIME OF INSPECTION FOR THE INSPECTORS USE AND REFERENCE.

- SHOP DRAWINGS FOR THE FOLLOWING ITEMS SHALL BE SUBMITTED TO THE ARCHITECT AND STRUCTURAL ENGINEER FOR REVIEW PRIOR TO FABRICATION OF THESE ITEMS.

- REINFORCING STEEL
STRUCTURAL STEEL
METAL DECKING
GLUED LAMINATED MEMBERS
MANUFACTURED LUMBER (PSL'S, LSL'S, LVL'S)
PLYWOOD WEB JOISTS
CONNECTOR PLATE WOOD FLOOR TRUSSES
CONNECTOR PLATE WOOD ROOF TRUSSES
PREFABRICATED STAIR SYSTEM

APPROVED SETS OF SHOP DRAWINGS SHALL ALSO BE SUBMITTED TO THE BUILDING DEPARTMENT AS REQUIRED BY THE JURISDICTION. IF THERE IS A DOUBT WHETHER OR NOT A POST-PERMIT SUBMITTAL IS NECESSARY OR WILL BE ACCEPTED, CONSULT THE BUILDING CODE REVIEWER FOR THE ORIGINAL PERMIT. NO DRAWING SHOULD BE SUBMITTED TO THE BUILDING OFFICIAL THAT STILL BEARS THE DISPOSITION OF "REVISE AND RESUBMIT" OR SIMILAR LANGUAGE.

- SHOP DRAWING REVIEW OF DIMENSIONS AND QUANTITIES ARE NOT REVIEWED BY THE ENGINEER OF RECORD, THEREFORE MUST BE VERIFIED BY THE CONTRACTOR. CONTRACTOR SHALL REVIEW AND STAMP DRAWINGS PRIOR TO REVIEW BY THE ENGINEER. THE CONTRACT DOCUMENTS ARE DISCOVERED EITHER PRIOR TO OR AFTER SHOP DRAWING SUBMITTALS ARE PROCESSED BY THE ENGINEER. THE DESIGN DRAWINGS AND SPECIFICATIONS SHALL CONTROL AND SHALL BE FOLLOWED.

SHOP DRAWING SUBMITTALS PROCESSED BY THE ENGINEER ARE NOT CHANGE ORDERS. THE PURPOSE OF SHOP DRAWING SUBMITTALS BY THE CONTRACTOR IS TO DEMONSTRATE TO THE ENGINEER THAT THE CONTRACTOR UNDERSTANDS THE DESIGN CONCEPT, BY INDICATING WHICH MATERIAL IS INTENDED TO BE FURNISHED AND INSTALLED AND BY DETAILING THE INTENDED FABRICATION AND INSTALLATION METHODS. IF DEVIATIONS, DISCREPANCIES, OR CONFLICTS BETWEEN SHOP DRAWING SUBMITTALS AND THE CONTRACT DOCUMENTS ARE DISCOVERED EITHER PRIOR TO OR AFTER SHOP DRAWING SUBMITTALS ARE PROCESSED BY THE ENGINEER, THE DESIGN DRAWINGS AND SPECIFICATIONS SHALL CONTROL AND SHALL BE FOLLOWED.

- SHOP DRAWINGS OF DESIGN BUILD COMPONENTS INCLUDING AWNINGS, BALCONIES, BASE ISOLATORS, CANOPES, CURTAIN WALL SYSTEMS, ELEVATORS, EXTERIOR CLADDING, FALL PROTECTION ANCHORS, HOLD-DOWN SYSTEMS (MULTI-STORY), SKYLIGHT FRAMES, STAIR SYSTEMS, STEEL STUD FRAMING, STORAGE RACKS (GREATER THAN 6 FEET IN HEIGHT), AND SUNROOMS SHALL BE STAMPED AND SIGNED BY A STRUCTURAL ENGINEER REGISTERED IN THE STATE OF WASHINGTON AND SHALL BE APPROVED BY THE COMPONENT DESIGNER PRIOR TO REVIEW BY THE ARCHITECT OR ENGINEER OF RECORD FOR GENERAL CONFORMANCE WITH THE DESIGN OF THE BUILDING. THE COMPONENT DESIGNER IS RESPONSIBLE FOR CODE CONFORMANCE AND ALL NECESSARY CONNECTIONS NOT SPECIFICALLY CALLED OUT ON ARCHITECTURAL OR STRUCTURAL DRAWINGS. SHOP DRAWINGS SHALL INDICATE MAGNITUDE AND DIRECTION OF ALL LOADS IMPOSED ON BASIC STRUCTURE. DESIGN CALCULATIONS SHALL BE MADE AVAILABLE UPON WRITTEN REQUEST.

QUALITY ASSURANCE

- SPECIAL INSPECTION SHALL BE PROVIDED IN ACCORDANCE WITH THE PROJECT SPECIFICATIONS AND SECTIONS 110, 1704 AND 1705 OF THE IBC BY A QUALIFIED TESTING AGENCY DESIGNATED BY THE ARCHITECT, AND RETAINED BY THE BUILDING OWNER. THE ARCHITECT, STRUCTURAL ENGINEER, AND BUILDING DEPARTMENT SHALL BE FURNISHED WITH COPIES OF ALL INSPECTION AND TEST RESULTS. SPECIAL INSPECTION OF THE FOLLOWING TYPES OF CONSTRUCTION SHALL BE PERFORMED.

- SOL CONDITIONS, FILL PLACEMENT, AND DENSITY PER SOLS REPORT
PILE OR PIER FOUNDATIONS PER SOLS REPORT
EPOXY GROUTED INSTALLATIONS PER MANUFACTURER
STRUCTURAL STEEL FABRICATION AND ERECTION PER AISC 340
METAL DECK INSTALLATION (INCLUDING FIELD WELDING) PER SDI GA/QC

- STRUCTURAL OBSERVATION SHALL BE PERFORMED IN ACCORDANCE WITH SECTION 1704.6 OF THE IBC FOR THE FOLLOWING BUILDING ELEMENTS:

- CONCRETE CONSTRUCTION
STRUCTURAL STEEL CONSTRUCTION
SHEARWALLS
HOLD-DOWNS

THE CONTRACTOR SHALL PROVIDE THE ENGINEER OF RECORD ADEQUATE NOTICE TO SCHEDULE APPROPRIATE SITE VISITS FOR STRUCTURAL OBSERVATION.

STRUCTURAL OBSERVATION MEANS THE VISUAL OBSERVATION OF THE STRUCTURAL SYSTEM, FOR GENERAL CONFORMANCE TO THE APPROVED PLANS AND SPECIFICATIONS, AT SIGNIFICANT CONSTRUCTION STAGES AND AT COMPLETION OF THE STRUCTURAL SYSTEM. STRUCTURAL OBSERVATION DOES NOT INCLUDE OR WAIVE THE RESPONSIBILITY FOR THE INSPECTIONS REQUIRED IN SECTION 110 OR SPECIAL INSPECTIONS IN SECTION 1705 OR OTHER SECTIONS OF THE IBC.

THE OWNER SHALL EMPLOY THE STRUCTURAL ENGINEER OR ARCHITECT RESPONSIBLE FOR THE STRUCTURAL DESIGN, TO PERFORM STRUCTURAL OBSERVATION. OBSERVED DEFICIENCIES SHALL BE REPORTED IN WRITING TO THE OWNER'S REPRESENTATIVE. SPECIAL INSPECTION, CONTRACTOR, AND AS BUILDING OFFICIAL, THE STRUCTURAL ENGINEER SHALL SIGNIFY THE BUILDING OFFICIAL A WRITTEN STATEMENT THAT THE SITE VISITS HAVE BEEN MADE AND IDENTIFY ANY REPORTED DEFICIENCIES WHICH, TO THE BEST OF THE STRUCTURAL OBSERVER'S KNOWLEDGE, HAVE NOT BEEN RESOLVED.

GEOTECHNICAL

- SUBGRADE PREPARATION INCLUDING DRAINAGE, EXCAVATION, COMPACTION, AND FILLING REQUIREMENTS SHALL CONFORM STRICTLY WITH RECOMMENDATIONS GIVEN IN THE SOLS REPORT OR AS DIRECTED BY THE SOILS ENGINEER. FOOTINGS SHALL BEAR ON SOLID UNDISTURBED EARTH AT LEAST 18" BELOW LOWEST ADJACENT FINISHED GRADE. FOOTING DEPTHS/ELEVATIONS SHOWN ON PLANS (OR IN DETAILS) ARE MINIMUM AND FOR GUIDANCE ONLY; THE ACTUAL ELEVATIONS OF FOOTINGS MUST BE ESTABLISHED BY THE CONTRACTOR IN THE FIELD WORKING WITH THE TESTING LAB AND SOILS ENGINEER. BACKFILL BEHIND ALL RETAINING WALLS WITH FREE DRAINING GRANULAR FILL AND PROVIDE FOR SUBSURFACE DRAINAGE AS NOTED IN THE SOLS REPORT.

- LATERAL EARTH PRESSURE (RESTRAINED/UNRESTRAINED) SEE SOLS REPORT / 45 PCF
TRAFFIC SURCHARGE 90 PSF
SEISMIC SURCHARGE 300 PCF
PASSIVE PRESSURE 10 TONS
4" DIAMETER STANDARD WEIGHT PIPE PILE CAPACITY 10 TONS
6" DIAMETER EXTRA-STRONG PIPE PILE CAPACITY 15 TONS

SOLS REPORT REFERENCE: GEOTECHNICAL ENGINEERING STUDY AND CRITICAL AREA STUDY OF PROPOSED PROPERTY REDEVELOPMENT LOCATED AT 6610 EAST MERKER WAY, MERCER ISLAND, WASHINGTON, 98040. PREPARED BY GEOTECH CONSULTANTS, INC. REPORT NUMBER JN2151, DATED JUNE 8, 2021.

- DIAMETER STANDARD WEIGHT AND 6" DIAMETER EXTRA-STRONG PIPE PILES SHALL BE DRIVEN TO REFUSAL AS DEFINED BY THE SOILS ENGINEER. PIPE PILES SHALL BE INSTALLED IN STRICT CONFORMANCE TO SOILS ENGINEER'S REQUIREMENTS. TESTING OF PILES SHALL BE IN ACCORDANCE WITH SOILS ENGINEER'S REQUIREMENTS AND AT A MINIMUM AS TESTED IN ACCORDANCE TO ASTM STANDARD D1145-91 FOR A MINIMUM OF 1 (PILE OR 3% OF 3", 4" AND 6" DIAMETER PILES UP TO 5 (PILES OF EACH SIZE MAXIMUM: USE OF THE QUICK LOAD TEST METHOD IN THE STANDARD IS THE MINIMUM REQUIRED. STEEL PIPE SHALL CONFORM TO ASTM A513, GRADE A OR B, FY = 35 KSI. PILES SHALL BE DRIVEN IN NOMINAL SECTIONS, AND CONNECTED WITH COMPRESSION FITTED SLEEVE COUPLERS. PIPE JOINTS SHOULD NOT BE WELDED TOGETHER. PILES SHALL BE PLACED WITHIN 3" OF SPECIFIED LOCATION. THE CONTRACTOR SHALL DETERMINE THE LOCATION OF ALL ADJACENT UNDERGROUND UTILITIES PRIOR TO DRIVING PILES.

- SPECIAL INSPECTION OF PILES SHALL BE REQUIRED FOR INSTALLATION AND TESTING.

CONCRETE

- CONCRETE SHALL BE MIXED, PROPORTIONED, CONVEYED AND PLACED IN ACCORDANCE WITH ACI 318 AND ACI 301, INCLUDING TESTING PROCEDURES. CONCRETE SHALL ATTAIN A 28-DAY STRENGTH OF FC = 3000 PSI. CUMPS OF CONCRETE SHALL NOT EXCEED 6". STRUCTURAL DESIGN IS BASED ON A CONCRETE STRENGTH OF FC = 2500 PSI. THEREFORE NO CONCRETE STRENGTH TESTING REQUIRED. CONCRETE EXPOSURE CATEGORIES ARE F1, S0, W0, AND C1.

ALL CONCRETE WITH SURFACES EXPOSED TO STANDING WATER SHALL BE AIR ENTRAINED WITH AN AIR-ENTRAINING AGENT CONFORMING TO ASTM C260. TOTAL AIR CONTENT FOR FROST-RESISTANT CONCRETE SHALL BE IN ACCORDANCE WITH ACI 318-14, TABLE 19.3.3.1.

- REINFORCING STEEL SHALL CONFORM TO ASTM A615, GRADE 60, FY = 60 KSI. EXCEPTIONS: ANY BARS SPECIFICALLY SO NOTED ON THE DRAWINGS SHALL BE GRADE 40, FY = 40 KSI. WELDED WIRE FABRIC SHALL CONFORM TO ASTM A1064. SPIRAL REINFORCEMENT SHALL BE DEFORMED WIRE CONFORMING TO ASTM A615, GRADE 60, FY = 40 KSI.

- DETAILING OF REINFORCING STEEL (INCLUDING HOOPS AND BENDS) SHALL BE IN ACCORDANCE WITH ACI 318-14 AND 318-14. LAP ALL CONTINUOUS REINFORCEMENT BARS AT ALL WALL AND FOOTING INTERSECTIONS. LAP CORNER BARS #5 AND SMALLER 48 BAR DIAMETERS OR 2" MINIMUM. LAPS OF LARGER BARS SHALL BE MADE IN ACCORDANCE WITH ACI 318-14, CLASS B. LAP ADJACENT MATS OF WELDED WIRE FABRIC A MINIMUM OF 8" AT SIDES AND ENDS.

NO BARS PARTIALLY EMBEDDED IN HARDENED CONCRETE SHALL BE FIELD BENT UNLESS SPECIFICALLY SO DETAILED OR APPROVED BY THE STRUCTURAL ENGINEER.

- CONCRETE PROTECTION (COVER) FOR REINFORCING STEEL SHALL BE AS FOLLOWS:

- FOOTINGS AND OTHER UNFORMED SURFACES CAST AGAINST AND PERMANENTLY EXPOSED TO EARTH 3"
FORMED SURFACES EXPOSED TO EARTH OR WEATHER (R#6 BARS OR LARGER) 2"
FORMED SURFACES EXPOSED TO EARTH OR WEATHER (R#5 BARS OR SMALLER) 1-1/2"
COLUMN TIES OR SPIRALS AND BEAM STIRRUPS 1-1/2"
SLABS AND WALLS (NT FACE) GREATER OF BAR DIAMETER PLUS 1/8" OR 3/4"

ANCHORAGE

- EPOXY-GROUTED ITEMS (THREADED RODS OR REINFORCING BARS) SPECIFIED ON THE DRAWINGS SHALL BE INSTALLED USING "SET-XP" EPOXY ADHESIVE AS MANUFACTURED BY THE SIMPSON STRONG TIE COMPANY. INSTALL IN STRICT ACCORDANCE WITH ICC-ES REPORT ESR-2713 AND ICC-ES REPORT ESR-265. SUBSTITUTIONS PROPOSED BY THE CONTRACTOR SHALL BE SUBMITTED FOR REVIEW WITH CURRENT ICC REPORTS INDICATING EQUIVALENT OR GREATER LOAD CAPACITIES. SPECIAL INSPECTION OF INSTALLATION IS REQUIRED. RODS SHALL BE ASTM A36, UNO.

- HEAVY DUTY THREADED CONCRETE ANCHORS SPECIFIED ON THE DRAWINGS SHALL BE "TIEEN HD SCREW ANCHOR" AS MANUFACTURED BY THE SIMPSON STRONG TIE COMPANY. INSTALL IN STRICT ACCORDANCE WITH ICC-ES REPORT ESR-2713 AND ICC-ES REPORT ESR-2508 AND IAPMO-UES REPORT ESR-245. SUBSTITUTIONS PROPOSED BY THE CONTRACTOR SHALL BE SUBMITTED FOR REVIEW WITH CURRENT ICC REPORTS INDICATING EQUIVALENT OR GREATER LOAD CAPACITIES. SPECIAL INSPECTION OF INSTALLATION IS REQUIRED.

- EXPANSION BOLTS INTO CONCRETE AND CONCRETE MASONRY UNITS SHALL BE "STRONG-BOLT Z" ANCHORS AS MANUFACTURED BY THE SIMPSON STRONG TIE COMPANY. INSTALL IN STRICT CONFORMANCE TO ICC-ES REPORT ESR-3037 AND IAPMO-UES REPORT ESR-240, INCLUDING MINIMUM EMBEDMENT AND EDGE DISTANCE REQUIREMENTS. SUBSTITUTIONS PROPOSED BY THE CONTRACTOR SHALL BE SUBMITTED FOR REVIEW WITH CURRENT ICC REPORTS INDICATING EQUIVALENT OR GREATER LOAD CAPACITIES. BOLTS INTO CONCRETE MASONRY OR BRICK MASONRY UNITS SHALL BE FULLY GROUTED CLOS. SPECIAL INSPECTION OF INSTALLATION IS REQUIRED.

WOOD

- 2x LUMBER SHALL BE KILN DRIED OR MC-19, AND ALL LUMBER SHALL BE GRADED AND MARKED IN ACCORDANCE WITH THE IBC. THE CONTRACTOR SHALL FURNISH TO THE BUILDING DEPARTMENT, FURNISH TO THE FOLLOWING MINIMUM STANDARDS:

- JOISTS AND BEAMS (2x, 3x, 4x MEMBERS) DOUGLAS FIR-LARCH NO 2
MINIMUM BASE VALUE, Fb = 900 PSI
BEAMS (6x AND LARGER) DOUGLAS FIR-LARCH NO 2
MINIMUM BASE VALUE, Fb = 875 PSI
POSTS (4x MEMBERS) DOUGLAS FIR-LARCH NO 2
MINIMUM BASE VALUE, Fc = 1350 PSI
(6x AND LARGER) DOUGLAS FIR-LARCH NO 2
MINIMUM BASE VALUE, Fc = 600 PSI
STUDS, PLATES AND MISC FRAMING DOUGLAS FIR-LARCH NO 2

- GLUED LAMINATED MEMBERS SHALL BE FABRICATED IN CONFORMANCE WITH ASTM AND ANSI/AITC STANDARDS. EACH MEMBER SHALL BEAR AN AITC OR APA-EWS IDENTIFICATION MARK AND SHALL BE ACCOMPANIED BY AN AITC OR APA-EWS CERTIFICATE OF CONFORMANCE. ALL SIMPLE SPAN GLULAM BEAMS SHALL BE DOUGLAS FIR COMBINATION 24F-V8, Fb = 2400 PSI, Fv = 245 PSI, E = 1800 KSI, UNO. ALL CANTILEVER GLULAM BEAMS SHALL BE DOUGLAS FIR COMBINATION 24F-V8, Fb = 2400 PSI, Fv = 245 PSI, E = 1800 KSI, UNO. GLUED LAMINATED COLUMNS SHALL BE DOUGLAS FIR COMBINATION 3, L2D GRADE, Fc = 2300 PSI, Fb = 2000 PSI, E = 1900 KSI.

- MANUFACTURED LUMBER: PSL, LVL AND LSL SHALL BE MANUFACTURED UNDER A PROCESS APPROVED BY THE NATIONAL RESEARCH BOARD. EACH PIECE SHALL BEAR A STAMP OR STAMPS NOTING THE NAME AND PLANT NUMBER OF THE MANUFACTURER, THE GRADE, THE NATIONAL RESEARCH BOARD NUMBER, AND THE QUALITY CONTROL AGENCY. ALL PSL, LVL, AND LSL LUMBER SHALL BE MANUFACTURED IN ACCORDANCE WITH ICC-ES REPORT ESR-1387 USING DOUGLAS FIR VENEER GLUED WITH A WATERPROOF ADHESIVE MEETING THE REQUIREMENTS OF ASTM D2659 WITH ALL GRAIN PARALLEL WITH THE LENGTH OF THE MEMBER. THE MEMBERS SHALL HAVE THE FOLLOWING MINIMUM PROPERTIES:

- PSL (2.0E) Fb = 2900 PSI E = 2000 KSI Fv = 290 PSI
LVL (2.0E) Fb = 2400 PSI E = 2000 KSI Fv = 285 PSI
LSL (1.55E) Fb = 2325 PSI E = 1550 KSI Fv = 310 PSI
PSL COLUMN (1.8E) Fc = 2800 PSI E = 1800 KSI Fv = 190 PSI

DESIGN SHOWN ON PLANS IS BASED ON LUMBER MANUFACTURED BY THE TRUS-JOIST CORPORATION. ALTERNATE MANUFACTURERS MAY BE USED SUBJECT TO REVIEW AND APPROVAL BY THE ARCHITECT AND STRUCTURAL ENGINEER. ALTERNATE JOIST HANGERS AND OTHER HARDWARE MAY BE SUBSTITUTED FOR ITEMS SHOWN PROVIDED THEY HAVE CURRENT ICC APPROVAL FOR EQUAL OR GREATER LOAD CAPACITY. ALL JOIST HANGERS AND OTHER HARDWARE SHALL BE COMPATIBLE IN SIZE WITH MEMBERS PROVIDED.

MANUFACTURED LUMBER PRODUCTS SHALL BE INSTALLED WITH A MOISTURE CONTENT OF 12% OR LESS. THE CONTRACTOR SHALL MAKE PROVISIONS DURING CONSTRUCTION TO PREVENT THE MOISTURE CONTENT OF INSTALLED BEAMS FROM EXCEEDING 12%. EXCESSIVE DEFLECTIONS MAY OCCUR IF MOISTURE CONTENT EXCEEDS THIS VALUE.

- PREFABRICATED PLYWOOD WEB JOIST DESIGN SHOWN ON PLANS IS BASED ON JOISTS MANUFACTURED BY THE TRUS-JOIST CORPORATION. ALTERNATE PLYWOOD WEB JOIST MANUFACTURERS MAY BE USED SUBJECT TO REVIEW AND APPROVAL BY THE ARCHITECT AND STRUCTURAL ENGINEER. ALTERNATE JOIST HANGERS AND OTHER HARDWARE MAY BE SUBSTITUTED FOR ITEMS SHOWN PROVIDED THEY HAVE CURRENT ICC APPROVAL FOR EQUAL OR GREATER LOAD CAPACITY. ALL JOIST HANGERS AND OTHER HARDWARE SHALL BE COMPATIBLE IN SIZE WITH PLYWOOD WEB JOIST PROVIDED.

- PLYWOOD SHEATHING SHALL BE GRADE CD, EXTERIOR GLUE OR STRUCTURAL II, EXTERIOR GLUE IN CONFORMANCE WITH ICC PS-1 OR PS-2, ORIENTED STRAND BOARD OF EQUIVALENT THICKNESS, EXPOSURE RATING AND PANEL INDEX MAY BE USED IN LIEU OF PLYWOOD.

WALL SHEATHING SHALL BE 7/16" or 1/2" (NOMINAL) WITH SPAN RATING 24/0

FLOOR SHEATHING SHALL BE 3/4" T&G (NOMINAL) WITH SPAN RATING 48/24

WATERPROOF DECK SHEATHING SHALL BE 3/4" T&G (NOMINAL) WITH SPAN RATING 48/24

FLAT ROOF SHEATHING SHALL BE 3/4" T&G (NOMINAL) WITH SPAN RATING 48/24

ROOF SHEATHING SHALL BE 1/2" or 7/16" (NOMINAL) WITH SPAN RATING 32/16 FOR ROOFS WITH A PITCH GREATER THAN 2:12

REFER TO WOOD FRAMING NOTES BELOW FOR TYPICAL NAILING REQUIREMENTS.

- WOOD IN DIRECT CONTACT WITH CONCRETE OR MASONRY SHALL BE PRESURE-TREATED WITH AN APPROVED PRESERVATIVE OR (2) LAYERS OF ASPHALT IMPREGNATED BUILDING PAPER SHALL BE PROVIDED BETWEEN UNTREATED WOOD AND CONCRETE OR MASONRY.

- PRESSURE-TREATED WOOD (INCLUDES PRESERVATIVE AND FIRE TREATED) SHALL BE TREATED PER AWPA STANDARDS. PRESSURE TREATED WOOD FOR ABOVE GROUND USE SHALL BE TREATED TO RETENTION OF 0.25 PCF. WOOD IN CONTINUOUS CONTACT WITH FRESH WATER OR SOIL SHALL BE TREATED TO A RETENTION OF 0.40 PCF. SODIUM BORATE (SBX) TREATED WOOD SHALL NOT BE USED WHERE EXPOSED TO WEATHER. FASTENERS AND TIMBER CONNECTORS WITHOUT AMMONIA IN DIRECT CONTACT WITH ACQ-A TO A RETENTION LEVEL OF 0.40 PCF). CBA-A (UP TO A RETENTION LEVEL OF 0.41 PCF) (UP TO A RETENTION LEVEL OF 0.21 PCF). SHALL BE G185 OR A185 HOT DIPPED OR CONTINUOUS HOT-GALVANIZED PER ASTM A653. FASTENERS AND TIMBER CONNECTORS WITH AMMONIA IN DIRECT CONTACT WITH ACQ-A COVER A RETENTION LEVEL OF 0.40 PCF). CBA-A COVER A RETENTION LEVEL OF 0.41 PCF). CBA-B (WITH A RETENTION LEVEL OF 0.21 PCF), OR WITH ACQ-A TREATED WOOD SHALL BE TYPE 304 OR 316 STAINLESS STEEL.

- CONNECTORS CALLED OUT BY LETTERS AND NUMBERS SHALL BE "STRONG-TIE" BY SIMPSON COMPANY, AS SPECIFIED IN THEIR CATALOG NUMBER C-C-2019. EQUIVALENT FASTENERS BY OTHER MANUFACTURERS MAY BE SUBSTITUTED, PROVIDED THEY HAVE CURRENT ICC APPROVAL FOR EQUAL OR GREATER LOAD CAPACITIES. PROVIDE NUMBER AND SIZE OF FASTENERS AS SPECIFIED BY MANUFACTURER. CONNECTORS SHALL BE INSTALLED IN ACCORDANCE WITH THE MANUFACTURER'S RECOMMENDATIONS.

- 2x JOISTS SHALL BE CONNECTED TO FLUSH BEAMS WITH "LUS" SERIES JOIST HANGERS. ALL TJ JOISTS SHALL BE CONNECTED TO FLUSH BEAMS WITH "LUS" SERIES JOIST HANGERS. ALL DOUBLE-JOISTS BEAMS SHALL BE CONNECTED TO FLUSH BEAMS WITH "MIU" SERIES JOIST HANGERS.

WHERE CONNECTOR STRAPS CONTO (2) MEMBERS, PLACE ONE-HALF OF THE NAILS OR BOLTS IN EACH MEMBER.

ALL SHIMS SHALL BE SEASONED AND DRIED AND THE SAME GRADE (MINIMUM) AS MEMBERS CONNECTED.

WOOD FASTENERS

- ALL NAILS SPECIFIED ON DRAWINGS ARE BASED ON THE FOLLOWING SPECIFICATIONS:

SIZE	TYPE	LENGTH	DIAMETER
8d	COMMON	2-1/2"	0.131"
10d	GUN	3"	0.131"
12d	GUN	3-1/4"	0.131"
16d	GUN	3-1/2"	0.135"

IF CONTRACTOR PROPOSES THE USE OF ALTERNATE NAILS, THEY SHALL SUBMIT NAIL SPECIFICATIONS TO THE STRUCTURAL ENGINEER (PRIOR TO CONSTRUCTION) FOR REVIEW AND APPROVAL.

NAILS - PLYWOOD (APA RATED SHEATHING) FASTENERS TO FRAMING SHALL BE DRIVEN FLUSH TO FACE OF SHEATHING WITH NO COUNTERSINKING PERMITTED.

- ALL BOLTS IN WOOD MEMBERS SHALL CONFORM TO ASTM A307. PROVIDE WASHERS UNDER THE HEADS AND NUTS OF ALL BOLTS AND LAG BOLTS BEARING ON WOOD. INSTALLATION OF LAG SCREWS SHALL CONFORM TO THE NATIONAL DESIGN SPECIFICATION FOR WOOD CONSTRUCTION (2018 EDITION) WITH A LEAD BORE HOLE OF 40-70% OF THE SHANK DIAMETER. LEAD HOLES ARE NOT REQUIRED FOR 3/8" AND SMALLER LAG SCREWS. HOLES SHALL BE A MINIMUM OF 1/32" TO A MAXIMUM OF 1/16" LARGER THAN THE BOLT DIAMETER. BOLTS SHALL NOT BE FORCIBLY DRIVEN. ALIGNED IN MAIN MEMBERS AND ON PLATES/MEMBERS. BOLTS SHALL NOT BE FORCIBLY DRIVEN.

- SDS AND SDSWS SCREWS CALLED OUT ON PLANS ARE TIMBER SCREWS MANUFACTURED BY SIMPSON STRONG-TIE COMPANY. SCREWS SHALL BE INSTALLED IN ACCORDANCE WITH THE MANUFACTURER'S RECOMMENDATIONS. EQUIVALENT SCREWS BY OTHER MANUFACTURERS MAY BE SUBSTITUTED PROVIDED THEY HAVE CURRENT ICC APPROVAL FOR EQUAL OR GREATER LOAD CAPACITIES. LAG SCREWS ARE NOT AN EQUIVALENT SUBSTITUTION.

- WOOD FRAMING NOTES - THE FOLLOWING APPLY UNLESS NOTED OTHERWISE ON THE PLANS:

- ALL WOOD FRAMING DETAILS NOT SHOWN OTHERWISE SHALL BE CONSTRUCTED TO THE MINIMUM STANDARDS OF THE IBC. THE AITC "TIMBER CONSTRUCTION MANUAL", AND THE APA "NATIONAL DESIGN SPECIFICATION FOR WOOD CONSTRUCTION". MINIMUM NAILING, SHALL CONFORM TO TABLE 2304.10.1 OF THE IBC. UNO. COORDINATE THE SIZE AND LOCATION OF ALL OPENINGS WITH ARCHITECTURAL AND MECHANICAL DRAWINGS.

- WALL FRAMING: REFER TO ARCHITECTURAL DRAWINGS FOR THE SIZE OF ALL WALLS. ALL STUDS SHALL BE SPACED AT 16"oc, UNO. (2) STUDS MINIMUM SHALL BE PROVIDED AT THE END OF ALL WALLS AND AT EACH SIDE OF ALL OPENINGS, AND AT BEAM OR HEADER BEARING LOCATIONS. (2) 2x8 HEADERS SHALL BE PROVIDED OVER ALL OPENINGS IN STRUCTURAL WALLS. UNO. NAIL ALL MEMBERS HEADERS WITH (2) ROWS 10d AT 12"oc. SOLID BLOCKING FOR WOOD COLUMNS SHALL BE PROVIDED THROUGH FLOORS TO SUPPORTS BELOW. PROVIDE CONTINUOUS SOLID BLOCKING AT MID-HEIGHT OF ALL STUD WALLS OVER 10'-0" IN HEIGHT.

ALL WALLS SHALL HAVE A SINGLE BOTTOM PLATE AND A DOUBLE TOP PLATE. END NAIL TOP PLATE AND BOTTOM PLATE TO EACH STUD WITH (3) 10d NAILS. FACE NAIL DOUBLE TOP PLATES WITH 10d AT 12"oc AND LAP MINIMUM 4'-0" AT JOINTS AND PROVIDE (12) 10d NAILS AT 6"oc EACH SIDE OF JOINT. AT TOP PLATE INTERSECTIONS PROVIDE (3) 10d FACE NAILS.

- ALL STUD WALLS SHALL HAVE THEIR LOWER WOOD PLATES ATTACHED TO WOOD FRAMING BELOW WITH (2) ROWS OF 12d NAILS AT 16"oc. ATTACH TO CONCRETE BELOW WITH 5/8" DIAMETER ANCHOR BOLTS AT 4'-0"oc EMBEDDED 7" MINIMUM. UNO. THERE SHALL BE A MINIMUM OF (2) BOLTS PER PLATE SECTION WITH (1) BOLT LOCATED MORE THAN 12" IN OR LESS THAN 4'-1/2" FROM EACH END OF THE PLATE SECTION. INDIVIDUAL MEMBERS OF BUILT-UP POSTS SHALL BE NAILED TO EACH OTHER WITH (2) ROWS OF 10d AT 16"oc. UNLESS NOTED OTHERWISE, GYPSUM WALLBOARD SHALL BE FASTENED TO THE INTERIOR SURFACE OF ALL STUDS AND PLATES WITH 8d 1-1/4" TYPE S OR W SCREWS AT 12"oc. UNLESS NOTED OTHERWISE, 7/16" OR 1/2" (NOMINAL) APA RATED SHEATHING (SPAN RATING 24/0) SHALL BE NAILED TO ALL EXTERIOR SURFACES WITH 8d NAILS AT 6"oc AT PANEL EDGES AND TOP AND BOTTOM PLATES (BLOCK UN-SUPPORTED EDGES) AND TO ALL INTERMEDIATE STUDS AND BLOCKING WITH 8d Nails AT 12"oc. ALLOW 1/8" SPACING AT ALL PANEL EDGES AND PANEL ENDS.

- FLOOR AND ROOF FRAMING: PROVIDE DOUBLE JOISTS UNDER ALL PARALLEL PARTITIONS THAT EXTEND OVER MORE THAN HALF THE JOIST LENGTH AND AROUND ALL OPENINGS IN FLOORS OR ROOFS. UNO. PROVIDE SOLID BLOCKING AT ALL BEARING POINTS. TORNAIL TIMBER JOISTS TO SUPPORTS WITH (3) 10d NAILS AND NAIL TJ JOISTS TO SUPPORTS WITH (2) 10d NAILS. ATTACH JOISTS TO BEAMS WITH SIMPSON JOIST HANGERS IN ACCORDANCE WITH NOTES ABOVE. NAIL ALL MULTIPLE JOIST BEAMS TOGETHER WITH (2) ROWS 10d AT 12"oc. TORNAIL FIRST JOIST TO TOP PLATE WITH 10d AT 6"oc. TORNAIL BLOCKING BETWEEN JOISTS TO TOP PLATE WITH (3) 10d NAILS.

- UNLESS NOTED OTHERWISE ON THE PLANS, PLYWOOD ROOF AND FLOOR SHEATHING SHALL BE LAID UP WITH GRAIN PERPENDICULAR TO SUPPORTS WITH END JOINTS STAGGERED, AND NAILED AT 6"oc WITH 8d NAILS TO FRAMED PANEL EDGES, STRIPS AND OVER STUD WALLS AS SHOWN ON PLANS AND AT 12"oc TO INTERMEDIATE SUPPORTS. PROVIDE APPROVED PLYWOOD EDGE CLIPS CENTERED BETWEEN JOISTS/TRUSSES AT UNLOCKED ROOF SHEATHING EDGES. ALL FLOOR SHEATHING EDGES SHALL HAVE APPROVED T&G JOINTS OR SHALL BE SUPPORTED WITH SOLID BLOCKING. ALLOW 1/8" SPACING AT ALL PANEL EDGES AND ENDS OF FLOOR AND ROOF SHEATHING. TORNAIL BLOCKING TO SUPPORTS WITH 10d AT 12"oc. UNO.

- NOTCHES AND HOLES IN WOOD FRAMING:
A. SAWN LUMBER JOISTS AND RAFTERS: NOTCHES AT THE ENDS OF JOISTS SHALL NOT EXCEED 1/4 THE JOIST DEPTH. NOTCHES IN THE TOP OR BOTTOM OF JOISTS SHALL NOT EXCEED 1/6 THE JOIST DEPTH. BE LONGER THAN 1/3 THE JOIST DEPTH, OR BE LOCATED IN THE MIDDLE 1/2 OF THE SPAN. HOLES SHALL NOT BE WITHIN 2" OF THE TOP OR BOTTOM OF THE JOIST AND THE DIAMETER SHALL NOT EXCEED 1/3 THE JOIST DEPTH. SPACING BETWEEN HOLES SHALL BE A MINIMUM OF (2) TIMES THE DIAMETER OF THE LARGEST HOLE OR 2" AND SHALL BE LOCATED A MINIMUM OF 2" FROM ANY NOTCH.

- CUTS, NOTCHES, AND HOLES IN MANUFACTURED LUMBER, PREFABRICATED PLYWOOD WEB JOISTS, AND PREFABRICATED TRUSSES ARE PROHIBITED EXCEPT WHERE NOTED ON STRUCTURAL PLANS OR PERMITTED BY MANUFACTURER'S RECOMMENDATIONS.

- ELECTRICAL, MECHANICAL, PLUMBING, AND DRAINAGE SYSTEMS SHALL BE DESIGNED TO ACCOMMODATE THE DIFFERENTIAL SHRINKAGE OR MOVEMENT OF THE WOOD STRUCTURE (3/8" PER FOOT).

- DEFLECTION OF CANTILEVERS SHALL BE CLOSELY MONITORED BY THE CONTRACTOR DURING CONSTRUCTION. CONTRACTOR TO VERIFY AND ENSURE ALL POST CAPS AND POST BEARING CONDITIONS ARE INSTALLED IN STRICT CONFORMANCE TO THE STRUCTURAL PLANS. CANTILEVERS IN WOOD FRAMING CAN DEFLECT UP TO 1/8" PER FOOT (IE. A CANTILEVER MAY DEFLECT 1/2"). IF DEFLECTION EXCEEDS 1/8" PER FOOT NOTIFY STRUCTURAL ENGINEER IMMEDIATELY. BEFORE FINISHES ARE INSTALLED, FLOORS AT OR ABOVE CANTILEVERS MAY REQUIRE LEVELING COMPOUND AND SOFFITS FURRED TO MAKE THEM LEVEL.

- PREFABRICATED CONNECTOR PLATE WOOD FLOOR TRUSSES SHALL BE DESIGNED BY THE MANUFACTURER IN ACCORDANCE WITH THE "NATIONAL DESIGN STANDARD FOR METAL PLATE-CONNECTED WOOD TRUSS CONSTRUCTION". ANSI(TP) 1 BY THE TRUSS PLATE INSTITUTE FOR THE SPANS AND CONDITIONS SHOWN ON THE PLANS. LOADING SHALL BE AS FOLLOWS:

TOP CHORD LIVE LOAD	40 PSF
TOP CHORD DEAD LOAD	25 PSF
BOTTOM CHORD DEAD LOAD	5 PSF
TOTAL LOAD	70 PSF

REFER TO PLAN FOR ADDITIONAL LOADING. ALL FLOOR TRUSSES SHALL BE DESIGNED FOR A MAXIMUM LIVE LOAD DEFLECTION OF THE SPAN DIVIDED BY 480.

WOOD TRUSSES SHALL UTILIZE APPROVED CONNECTOR PLATES (GANGNAIL OR EQUAL). SUBMIT SHOP DRAWINGS AND DESIGN CALCULATIONS TO THE ARCHITECT AND STRUCTURAL ENGINEER FOR REVIEW PRIOR TO FABRICATION. SUBMITTED DOCUMENTS SHALL BE STAMPED AND SIGNED BY A STRUCTURAL ENGINEER REGISTERED IN THE STATE OF WASHINGTON. PROVIDE FOR SHAPE BEARING POINTS, INTERSECTIONS, ETC. SHOWN ON THE DRAWINGS. PROVIDE ALL TRUSS TO TRUSS AND TRUSS TO GIRDER TRUSS CONNECTION DETAILS AND REQUIRED CONNECTION MATERIALS. PROVIDE FOR ALL TEMPORARY AND PERMANENT TRUSS BRACING AND BRIDGING.

- PREFABRICATED CONNECTOR PLATE WOOD ROOF TRUSSES SHALL BE DESIGNED BY THE MANUFACTURER IN ACCORDANCE WITH THE "NATIONAL DESIGN STANDARD FOR METAL PLATE-CONNECTED WOOD TRUSS CONSTRUCTION". ANSI(TP) 1 BY THE TRUSS PLATE INSTITUTE FOR THE SPANS AND CONDITIONS SHOWN ON THE PLANS. LOADING SHALL BE AS FOLLOWS:

TOP CHORD SNOW LOAD (SEE NOTE BELOW)	30 PSF
TOP CHORD DEAD LOAD (SEE NOTE BELOW)	15 PSF
BOTTOM CHORD DEAD LOAD	5 PSF
TOTAL LOAD	50 PSF

WIND UPLIFT (TOP CHORD)	10 PSF
BOTTOM CHORD LIVE LOAD (BOTTOM CHORD LIVE LOAD DOES NOT ACT CONCURRENTLY WITH THE ROOF LIVE LOAD)	10 PSF





NOTE: SOLAR PANEL WEIGHT INCLUDED IN THE

Copyright © 2019 MALSAM TSANG ENGINEERING CORPORATION - ALL RIGHTS RESERVED

REVISION

Reviewed
Kolk Consulting Group, Inc.
C. Kolk
04/19/2023

**REVIEWED
FOR CODE
COMPLIANCE**
REVISION 1

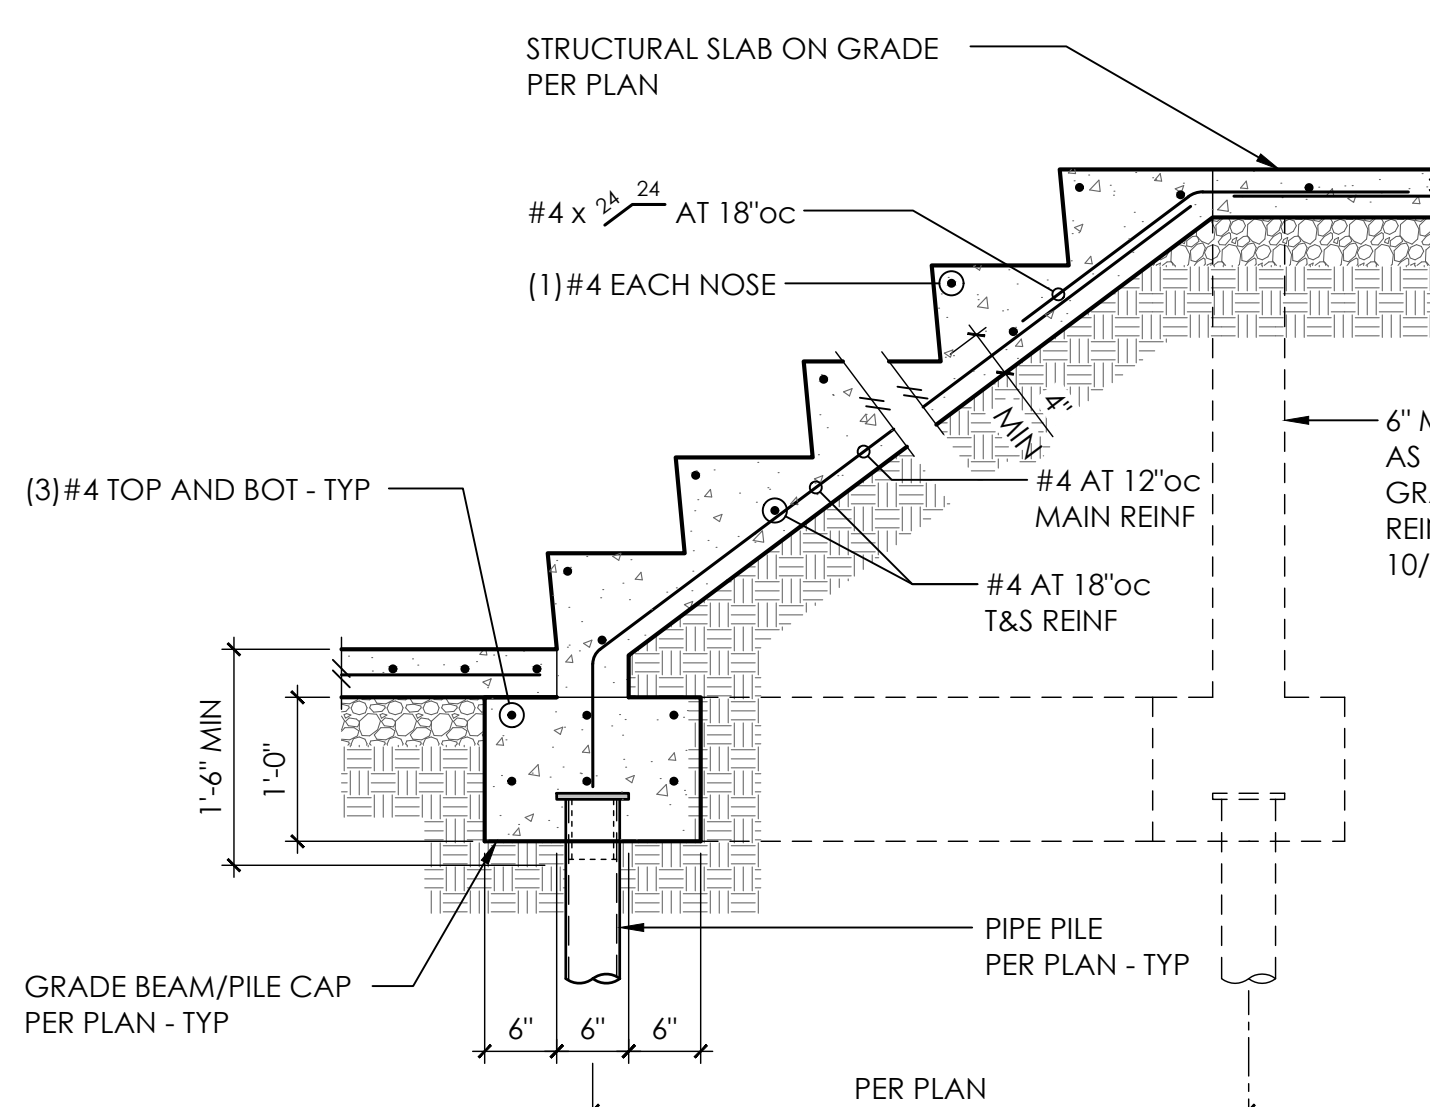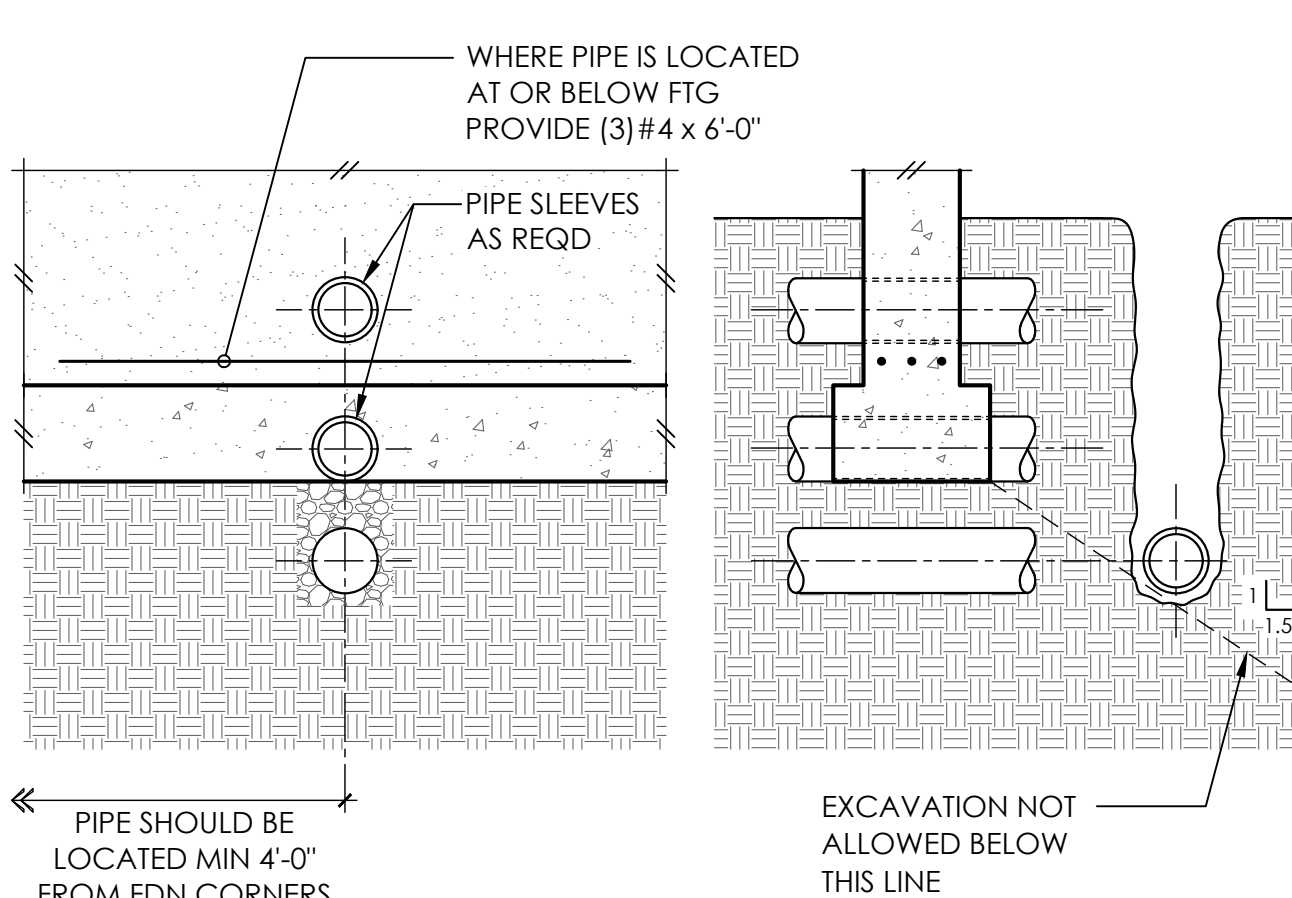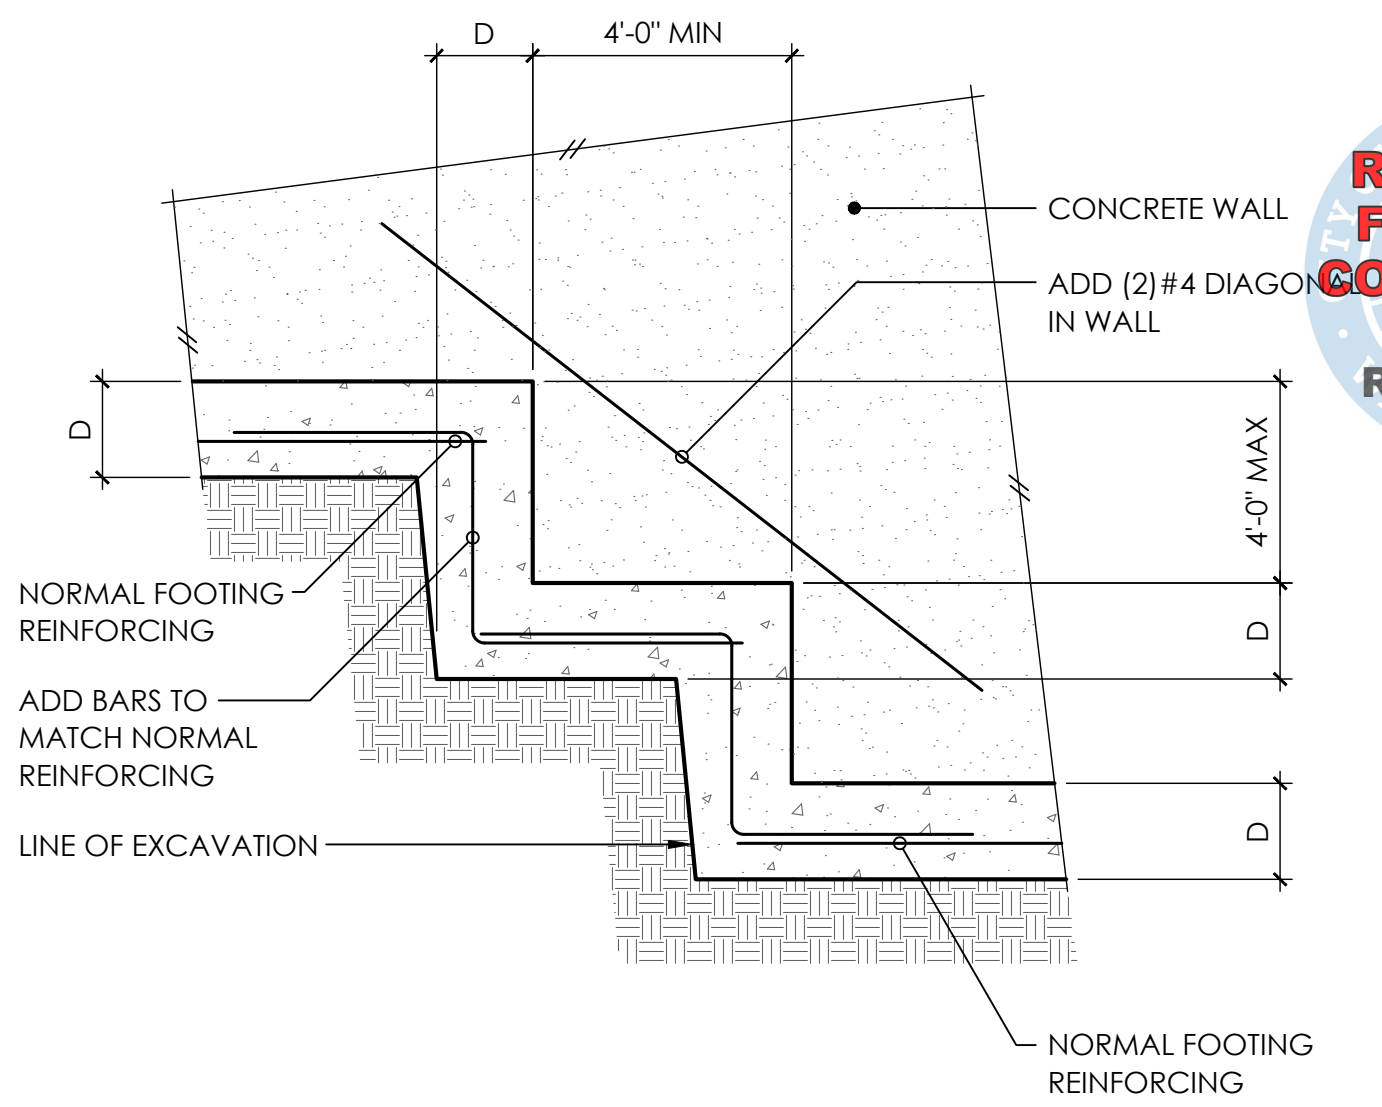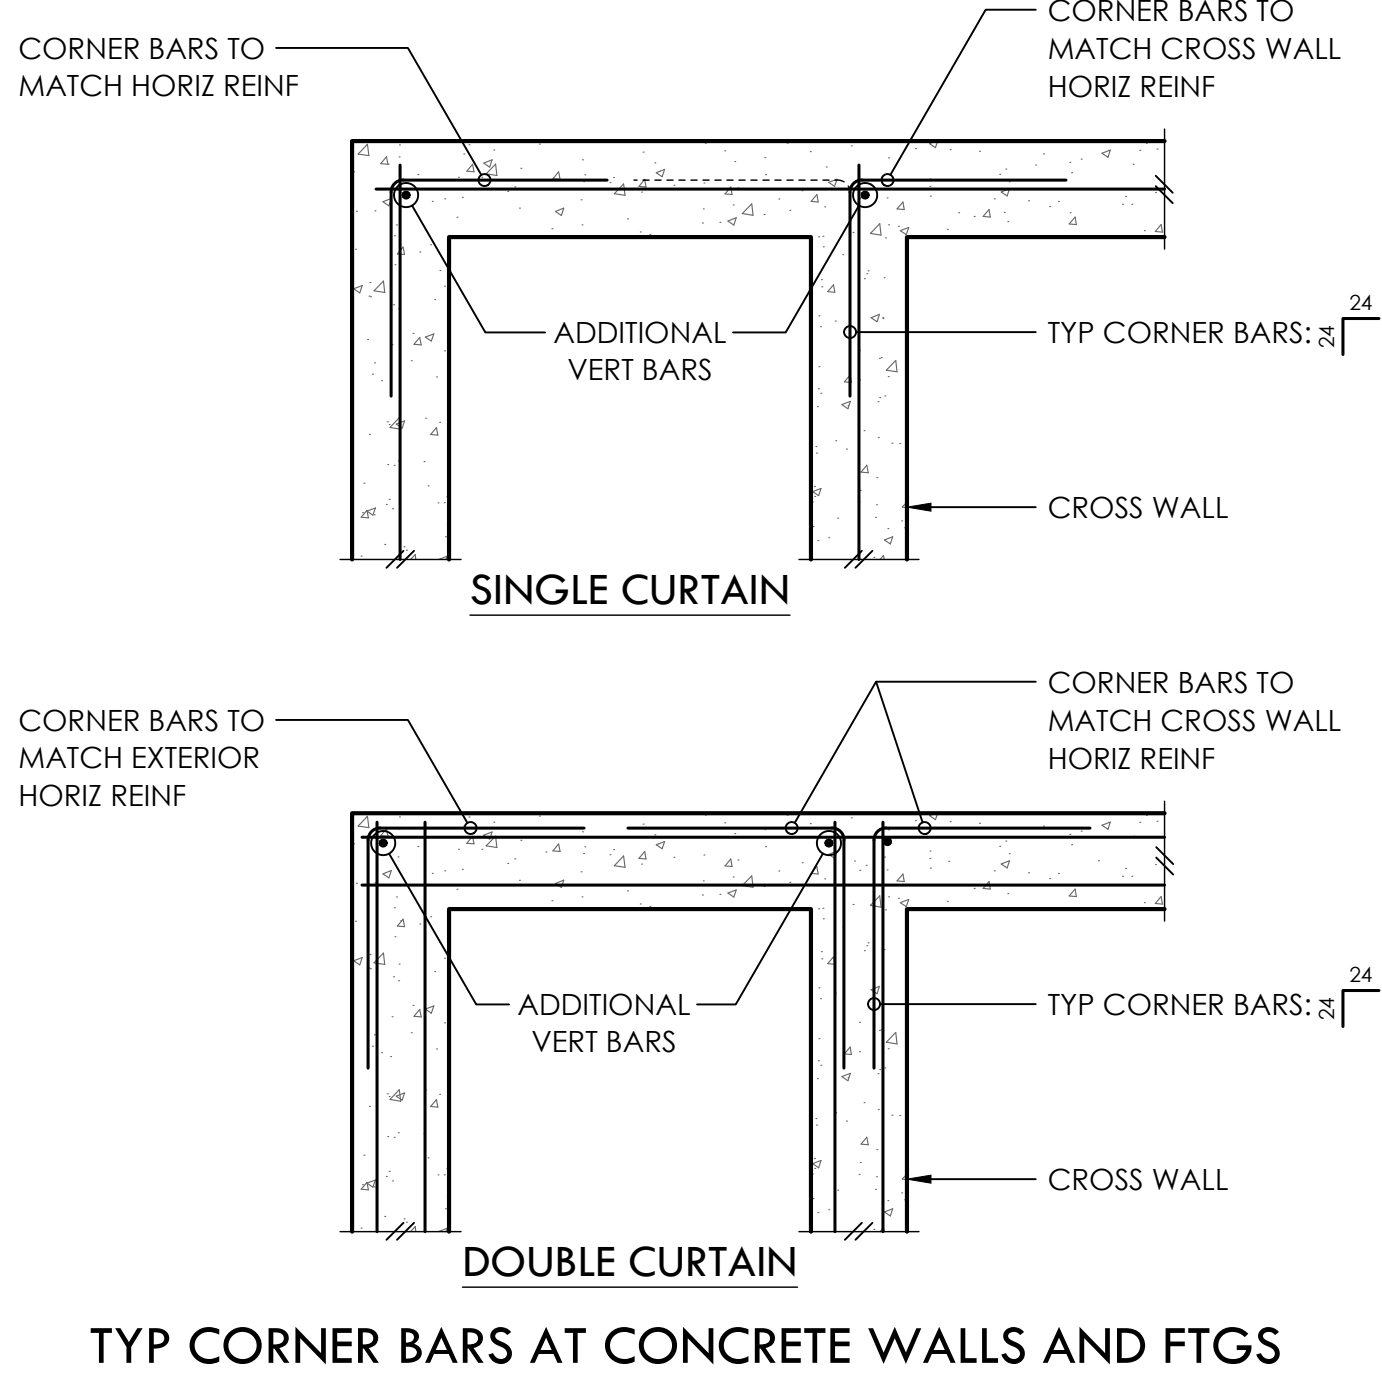

NOTE:
EXACT CONFIGURATION OF STAIR INCLUDING
TREAD AND RISER DIMS PER ARCH DRAWINGS

HDU HOLDOWN SCHEDULE

PLAN MARK	AT STEM WALL	AT FOOTING	HD POST
	AB	EMBED ALL-THREAD WASHER	EMBED 4x WALL 6x WALL
HDU2	5/8"Ø - SSB1 6(L)	12-5/8" 5/8"Ø 1-3/4"SQ x 1/2"	9" (2)2x4 (2)2x6
HDU4	5/8"Ø - SB5/8 x 24	18" 5/8"Ø 1-3/4"SQ x 1/2"	9" (2)2x4 (2)2x6
HDU5	5/8"Ø - SB5/8 x 24	18" 5/8"Ø 1-3/4"SQ x 1/2"	9" (2)2x4 (2)2x6
HDU8	7/8"Ø - SB7/8 x 24	18" 7/8"Ø 2-1/2"SQ x 1/2"	12" 4x6 6x6
HDU11	1"Ø - SB1 x 30	24" 1"Ø 3"SQ x 5/8"	12" 4x8 6x8
HDU14	-	1"Ø 1"Ø 3"SQ x 5/8"	12" 4x12 6x8


LSTHD/STHD HOLDOWN SCHEDULE

PLAN MARK	NAILS	HD POST
LSTHD(RJ)	(20) 16d SINKERS	DBL STUD
STHD10(RJ)	(28) 16d SINKERS	DBL STUD
STHD14(RJ)	(30) 16d SINKERS	DBL STUD


○ ALL HOLDOWN ANCHOR BOLTS THAT NEED TO BE EMBEDDED INTO FOOTING ARE SPECIFICALLY SHOWN ON PLAN
○ A307 ALL-THRD w/ PLATE WASHER PER SCHEDULE AND DOUBLE NUT BOT OR EQUIVALENT SIMPSON PAB
○ MINIMUM SIZE OF POST UNO ON FRAMING PLANS
○ REQUIRES MINIMUM 8" THICK CONCRETE WALL

○ 16d SINKERS = 0.148"Ø x 3-1/4"
○ MINIMUM SIZE OF POST UNO ON FRAMING PLANS



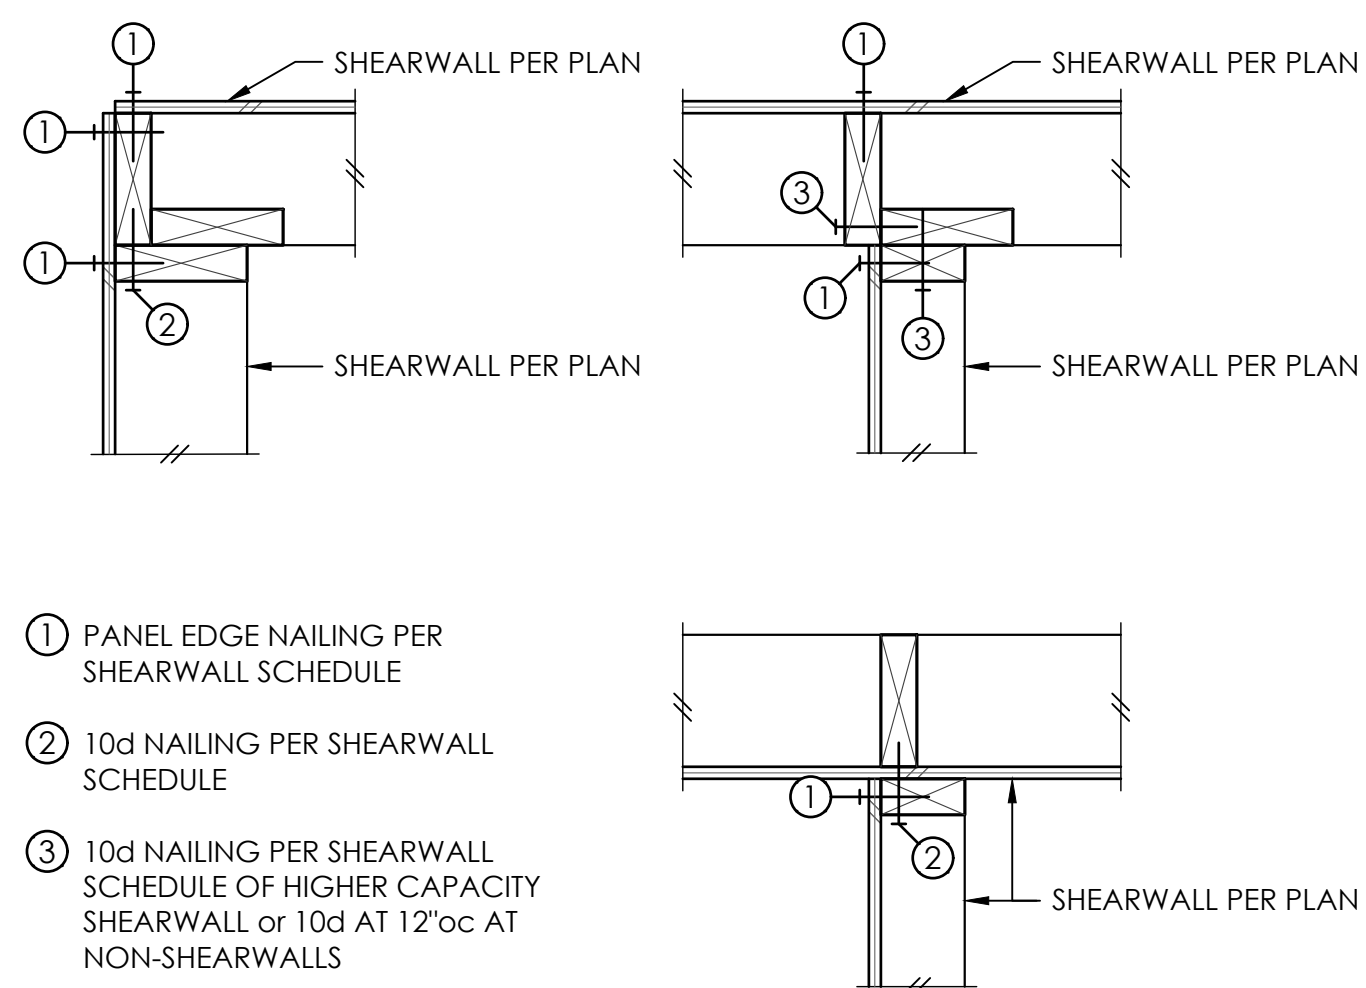


SCALE: 1'-1/2" = 1'-0"
TYPICAL SHEARWALL INTERSECTIONS 1

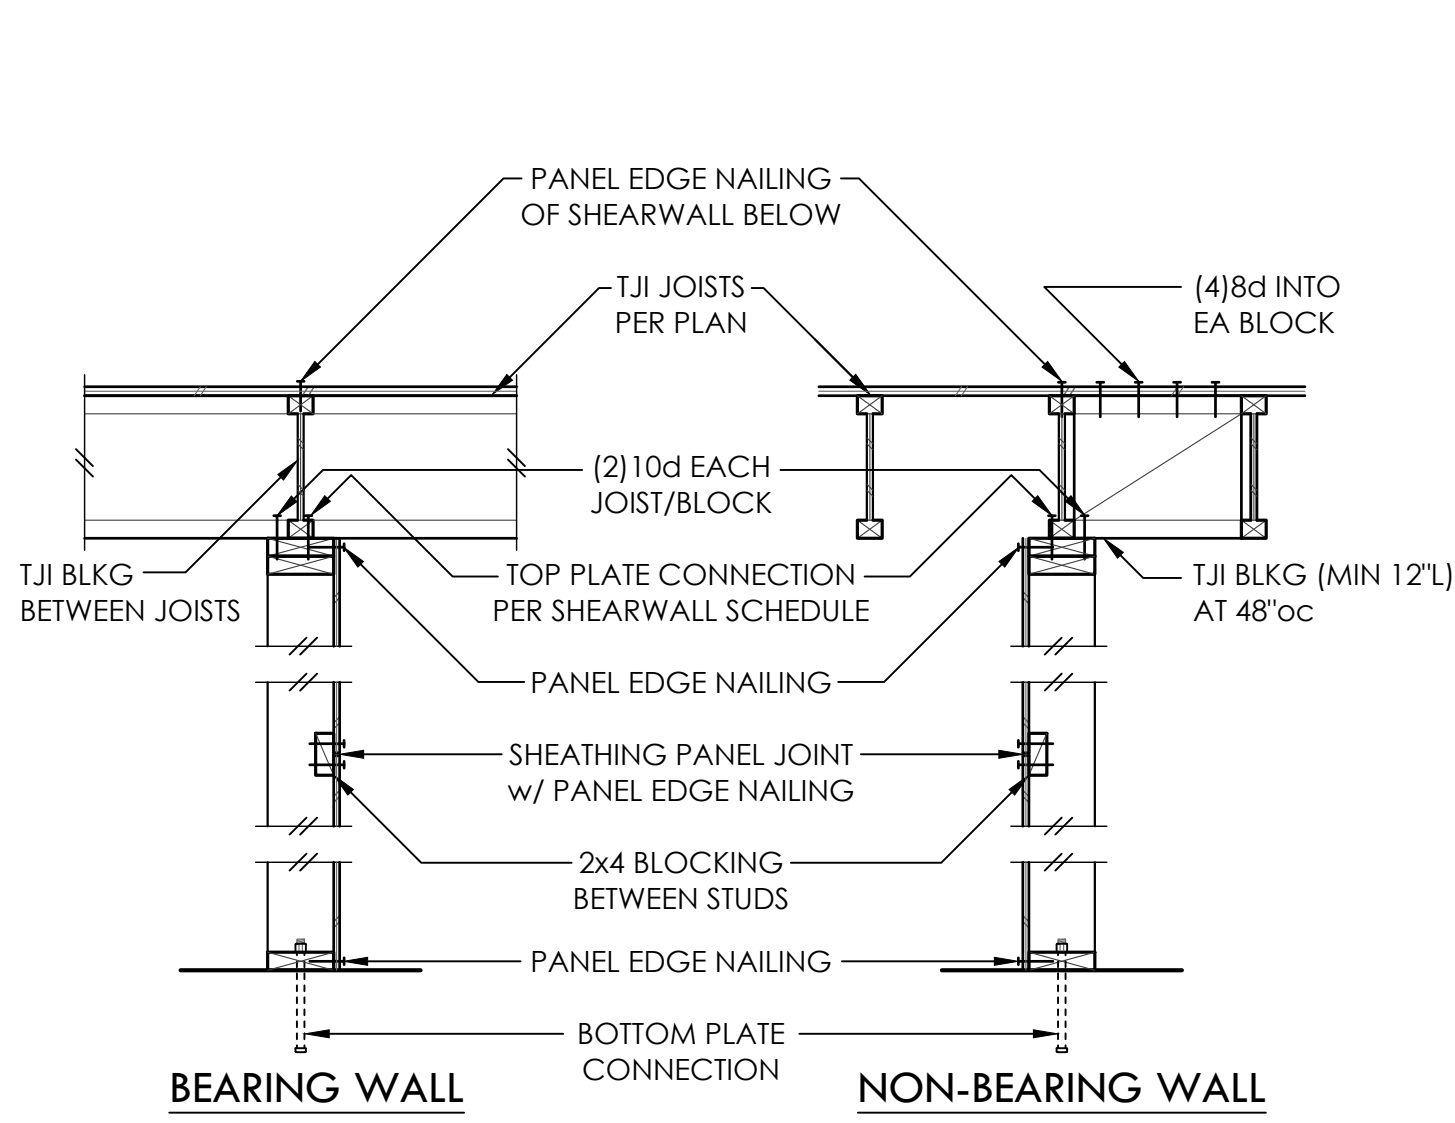


NOTE:
SEE SHEARWALL SCHEDULE FOR ALL NAILING AND CONNECTIONS, UNO

TYPICAL SHEARWALL CONSTRUCTION 2

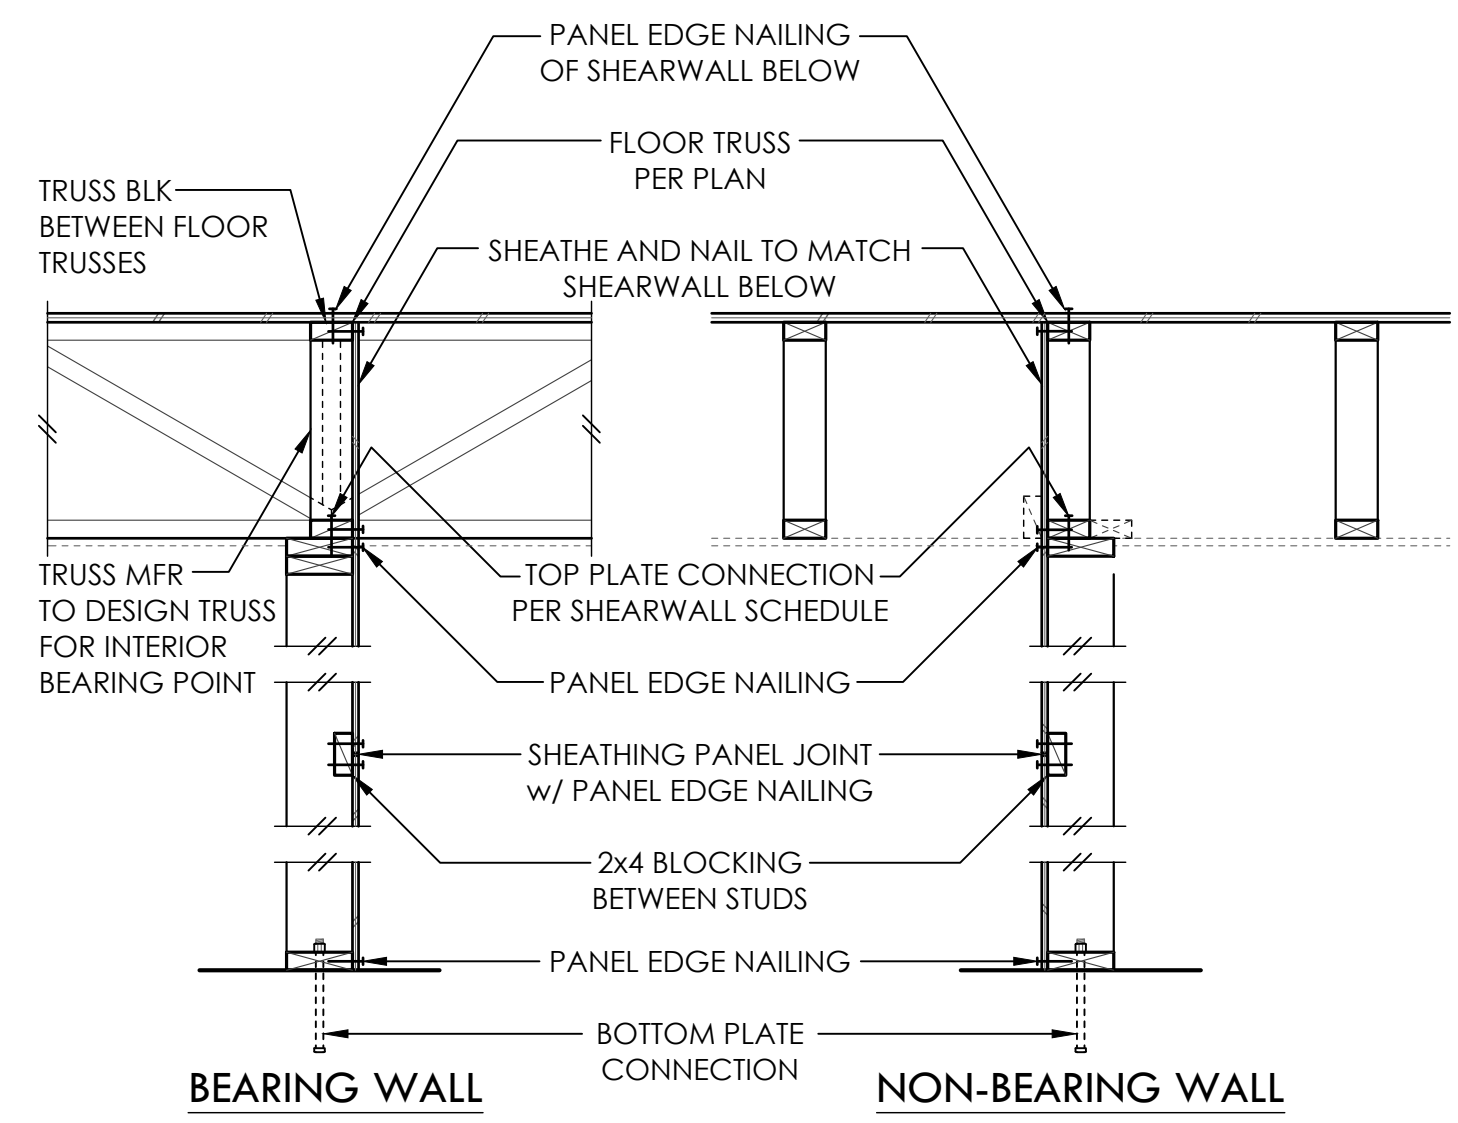

NOTE:
SEE SHEARWALL SCHEDULE FOR ALL NAILING AND CONNECTIONS, NOT OTHERWISE NOTED

TYPICAL SHEARWALL CONSTRUCTION 3

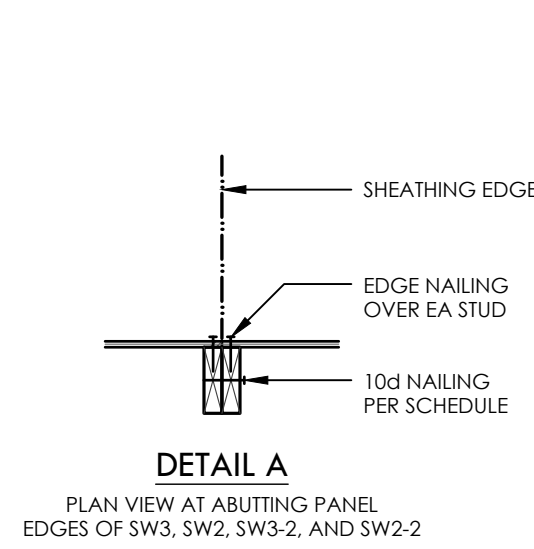


SHEARWALL SCHEDULE


MARK	SHEATHING	PANEL EDGE NAILING	TOP PLATE CONNECTION		BASE PLATE CONNECTION	
			TRUSS	RIM/BEAM	AT WOOD	AT CONCRETE
SW6	1/2" PLY or 7/16" OSB	8d AT 6"oc	10d AT 6"oc	A35 AT 30"oc	12d AT 6"oc	5/8"Ø AB AT 48"oc
SW4	1/2" PLY or 7/16" OSB	8d AT 4"oc	10d AT 4"oc	A35 AT 18"oc	12d AT 4"oc	5/8"Ø AB AT 42"oc
SW3	1/2" PLY or 7/16" OSB	8d AT 3"oc	(2)ROWS 10d AT 6"oc	A35 AT 12"oc	(2)ROWS 12d AT 6"oc	5/8"Ø AB AT 36"oc
SW2	1/2" PLY or 7/16" OSB	8d AT 2"oc	(2)ROWS 10d AT 4"oc	A35 AT 12"oc	(2)ROWS 12d AT 4"oc	5/8"Ø AB AT 24"oc
SW3-2	1/2" PLY or 7/16" OSB EA SIDE	8d AT 3"oc EA SIDE	N/A	A35 AT 8"oc	(2)ROWS 12d AT 3"oc	5/8"Ø AB AT 18"oc
SW2-2	1/2" PLY or 7/16" OSB EA SIDE	8d AT 2"oc EA SIDE	N/A	A35 AT 6"oc	(3)ROWS 12d AT 3"oc	5/8"Ø AB AT 12"oc

- 1 BLOCK PANEL EDGES WITH 2x4 LAID FLAT AND NAIL PANELS TO INTERMEDIATE SUPPORTS WITH 8d AT 12"oc.
- 2 8d NAILS SHALL BE 0.131"Ø x 2-1/2", 10d NAILS SHALL BE 0.131"Ø x 3", AND 12d NAILS SHALL BE 0.131"Ø x 3-1/4".
- 3 EMBED ANCHOR BOLTS AT LEAST 7" OR USE 5/8"Ø x 8" TITEN HD SCREWS, UNO. ALL BOLTS SHALL HAVE 3" x 3" x 0.229" PLATE WASHERS. THE PLATE WASHER SHALL EXTEND TO WITHIN 1/2" OF THE EDGE OF THE BOTTOM PLATE ON THE SIDE(S) w/ SHEATHING. AT 2x6 SW3-2 AND SW2-2 WALLS, PROVIDE 4-1/2" x 3" x 0.229" PLATE WASHERS CENTERED ON PLATE.
- 4 3x STUDS OR DBL STUDS NAILED TOGETHER w/ 10d NAILING IS REQD AT ABUTTING PANEL EDGES OF SW3, SW2, SW3-2, AND SW2-2. REFER TO DETAIL A. WHERE 3x STUDS ARE USED, STAGGER NAILS AT ADJOINING PANEL EDGES. ABUTTING PANEL EDGES SHALL BE OFFSET EACH SIDE OF WALL AT SW3-2 AND SW2-2.
- 5 TWO STUDS MINIMUM OR POST PER PLAN ARE REQUIRED AT EACH END OF ALL SHEARWALLS AND ALL END STUDS SHALL RECEIVE PANEL EDGE NAILING.
- 6 ALL EXTERIOR WALLS SHALL BE SW6, UNLESS NOTED OTHERWISE.
- 7 NAILS SHALL NOT BE SPACED LESS THAN 3/8" FROM EDGES OF SHEATHING. SHEATHING NAILS SHALL BE DRIVEN SO THEIR HEADS ARE FLUSH WITH SHEATHING (NOT COUNTERSUNK).
- 8 11P4s INSTALLED OVER SHEATHING WITH 8d (0.131"Ø x 2-1/2") NAILS MAY BE SUBSTITUTED FOR A35s AT CONTRACTORS OPTION.


5

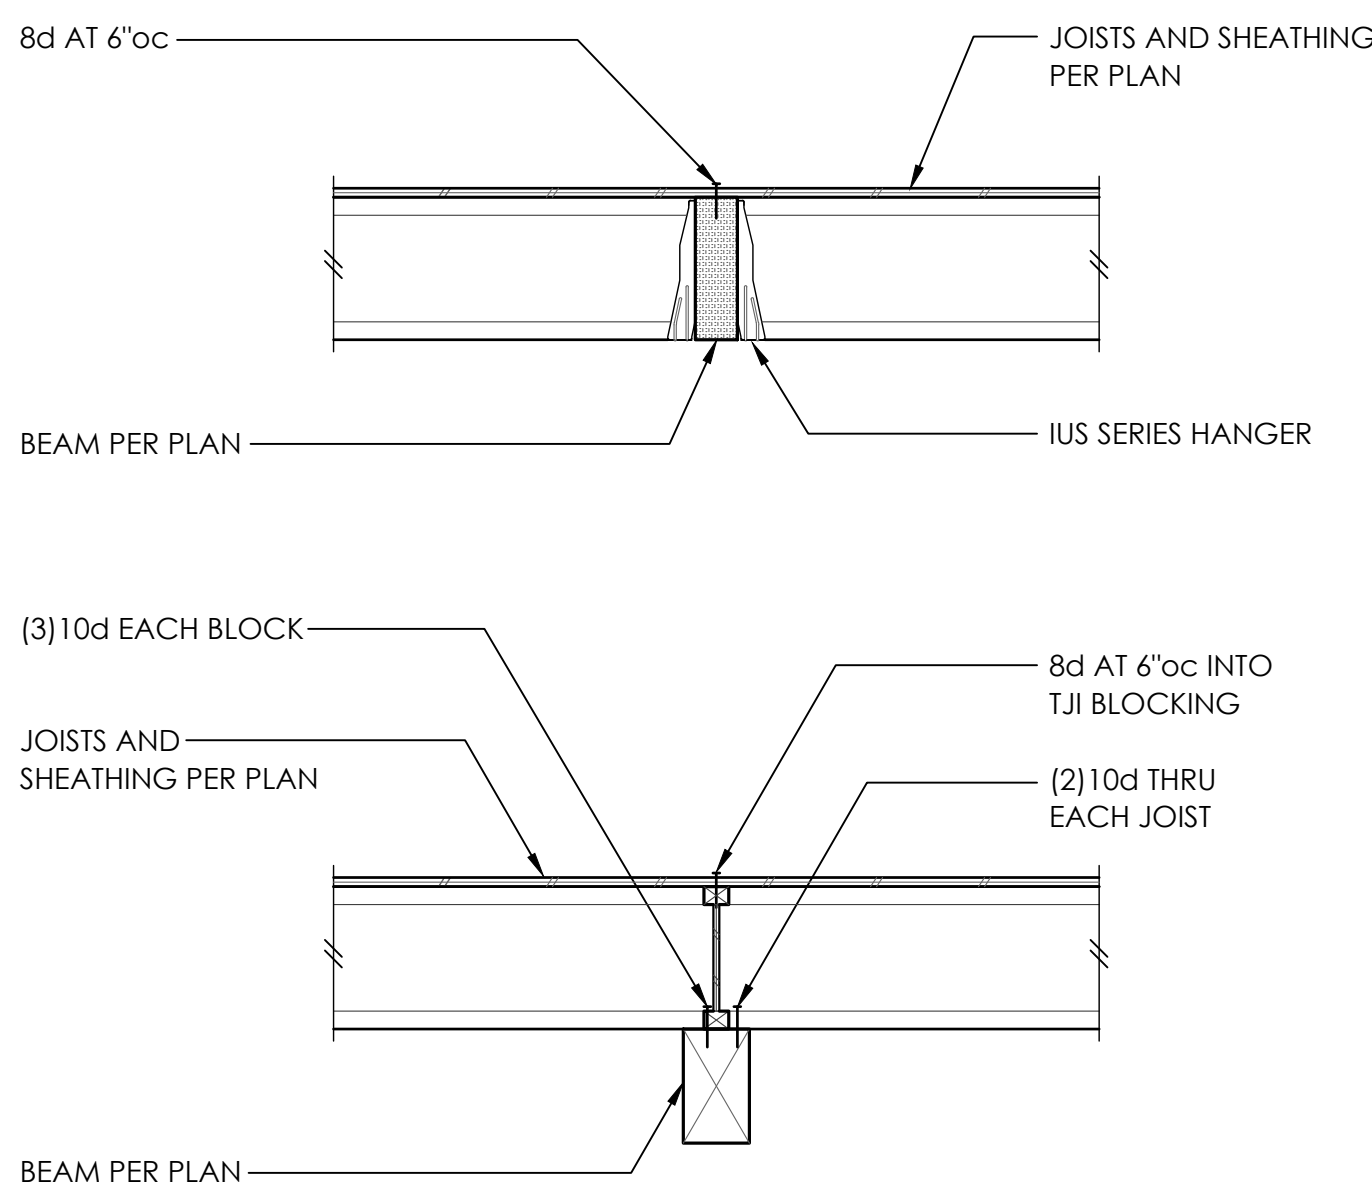

TYPICAL FLUSH AND DROPPED BEAM 6

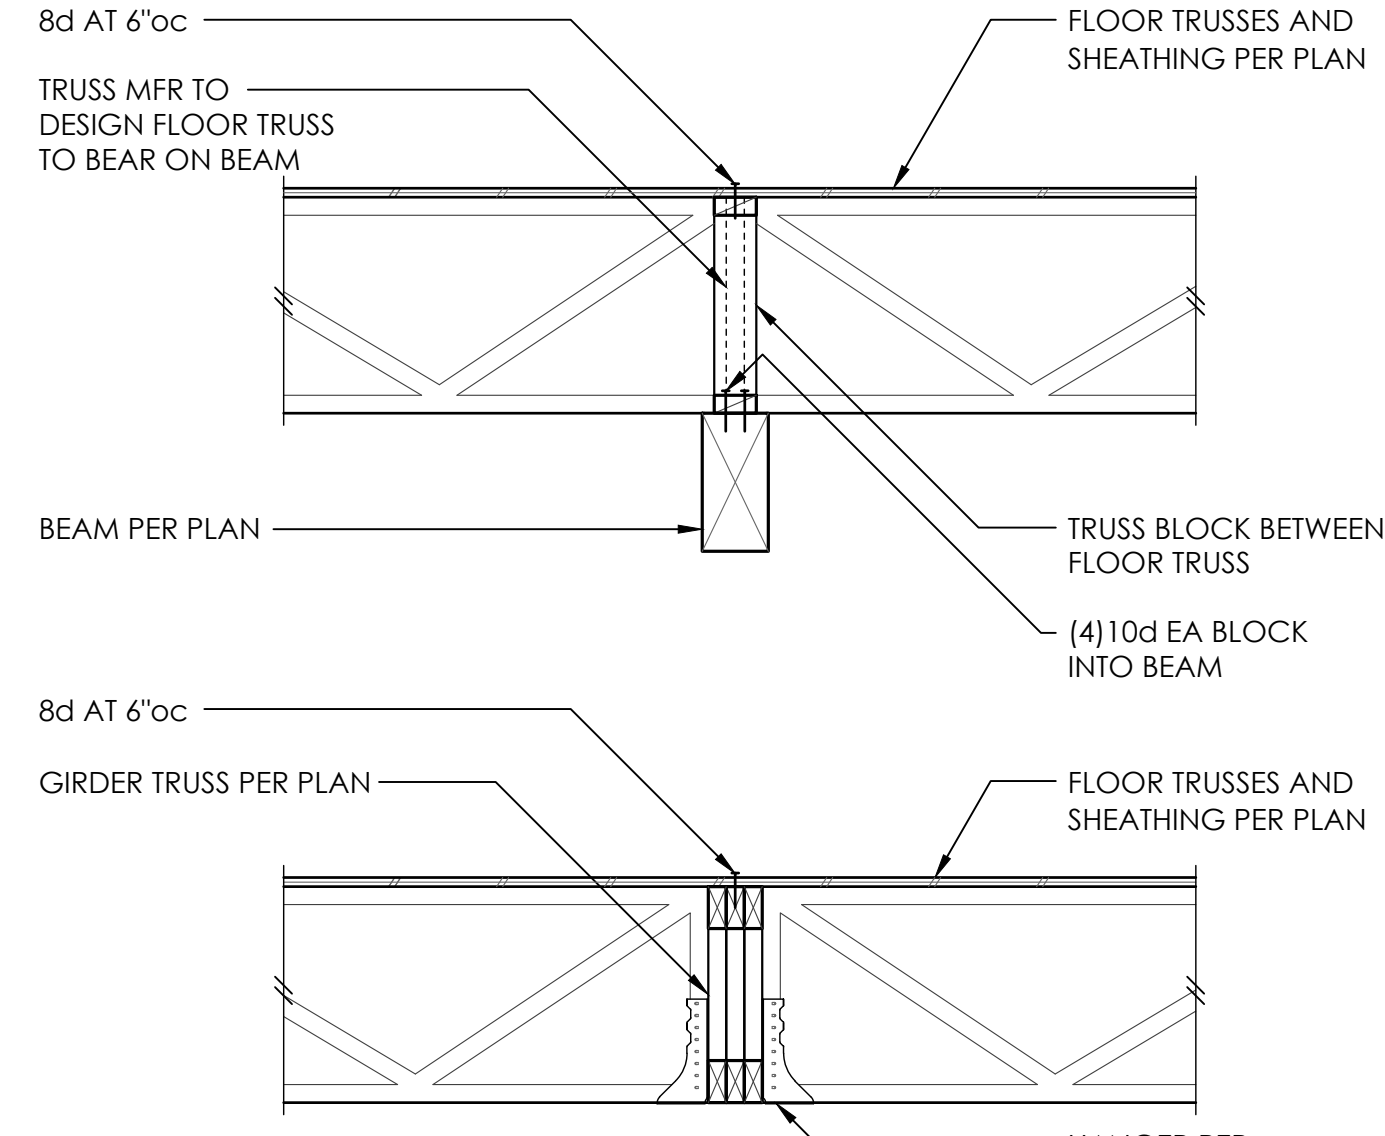


TYPICAL DROPPED BEAM AND GIRDER TRUSS 8

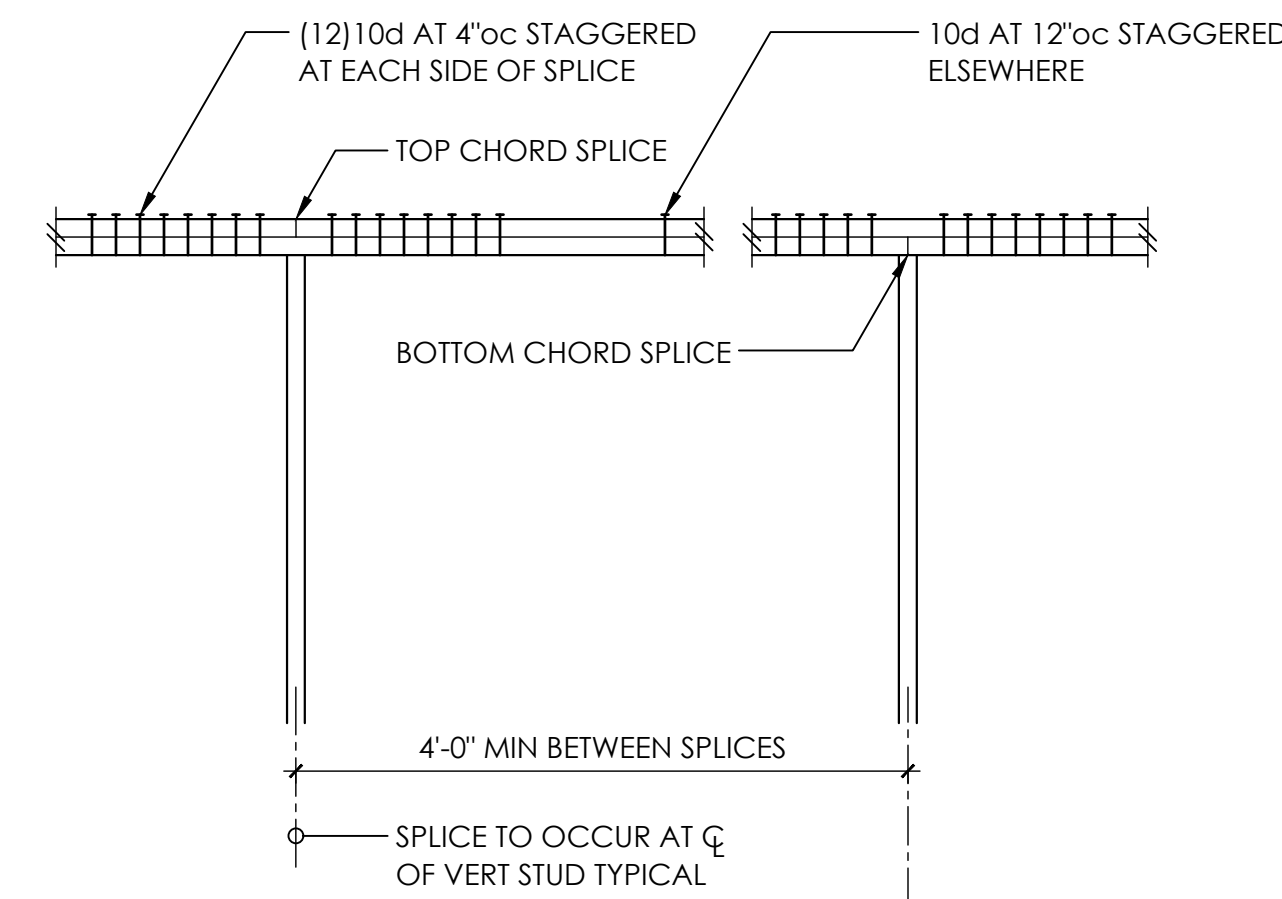


- NOTE:
1. NAILING AT TOP PLATE SPLICES MAY BE ELIMINATED w/ CS16 x 30".
 2. WHERE VERTICAL PENETRATIONS THRU PLATE EXCEED 1" FOR A 4x WALL OR 3" FOR A 6x WALL - PROVIDE CS16 x 30" AT TOP PLATE
 3. MINIMUM EDGE DISTANCE FOR VERTICAL PENETRATIONS THRU TOP PLATE IS 1-1/4"

TYPICAL TOP PLATE SPLICE 9

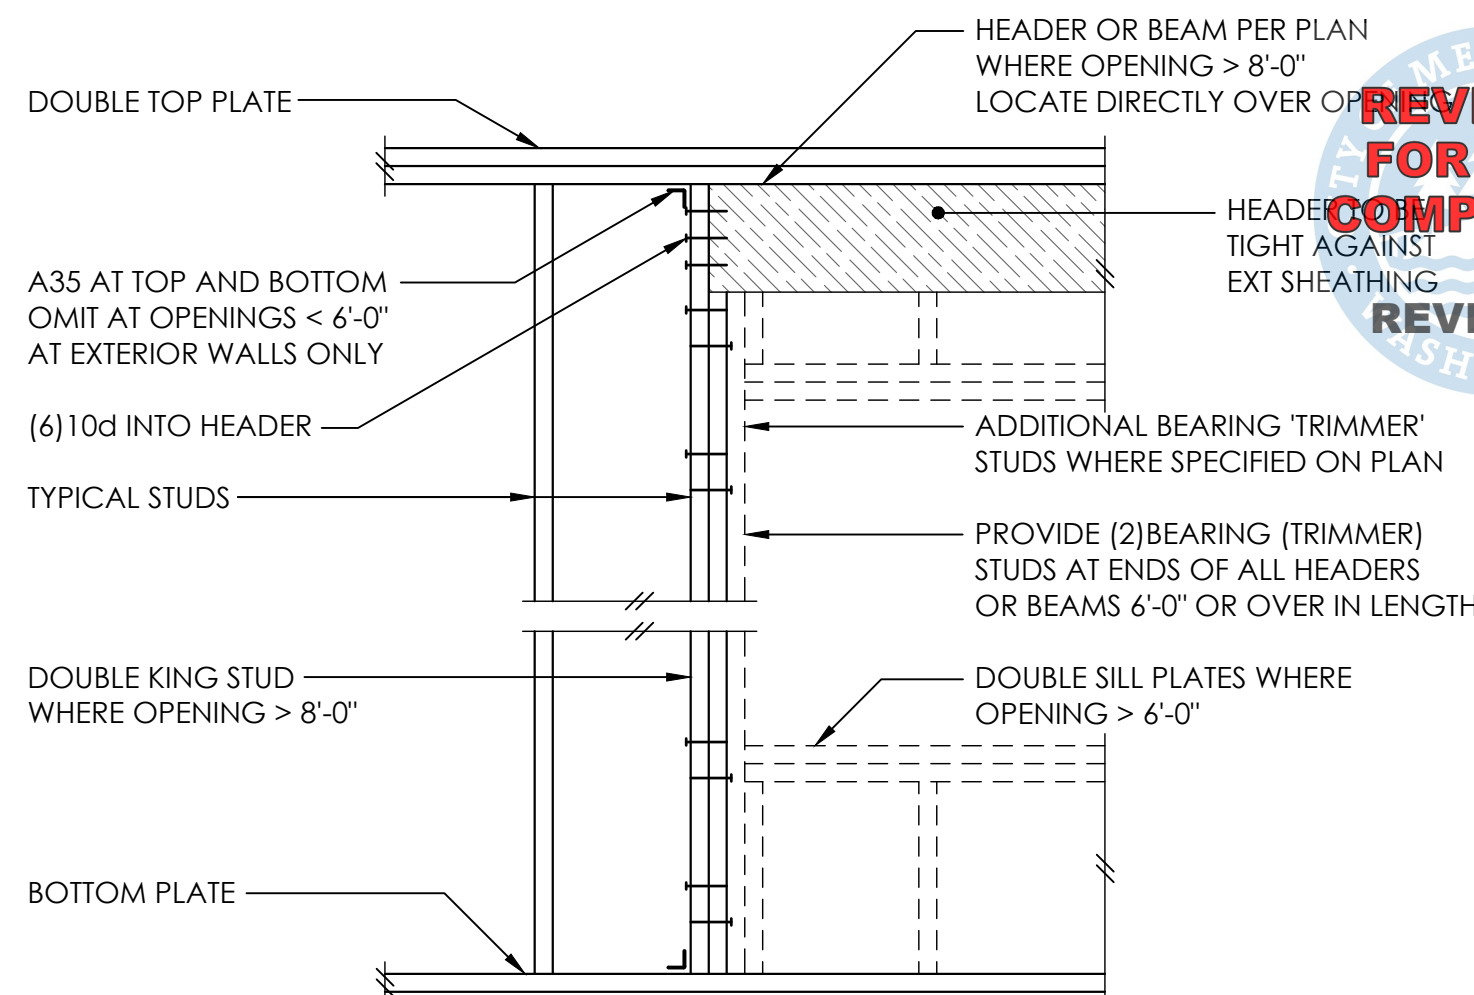


TYPICAL HEADER SUPPORT 10

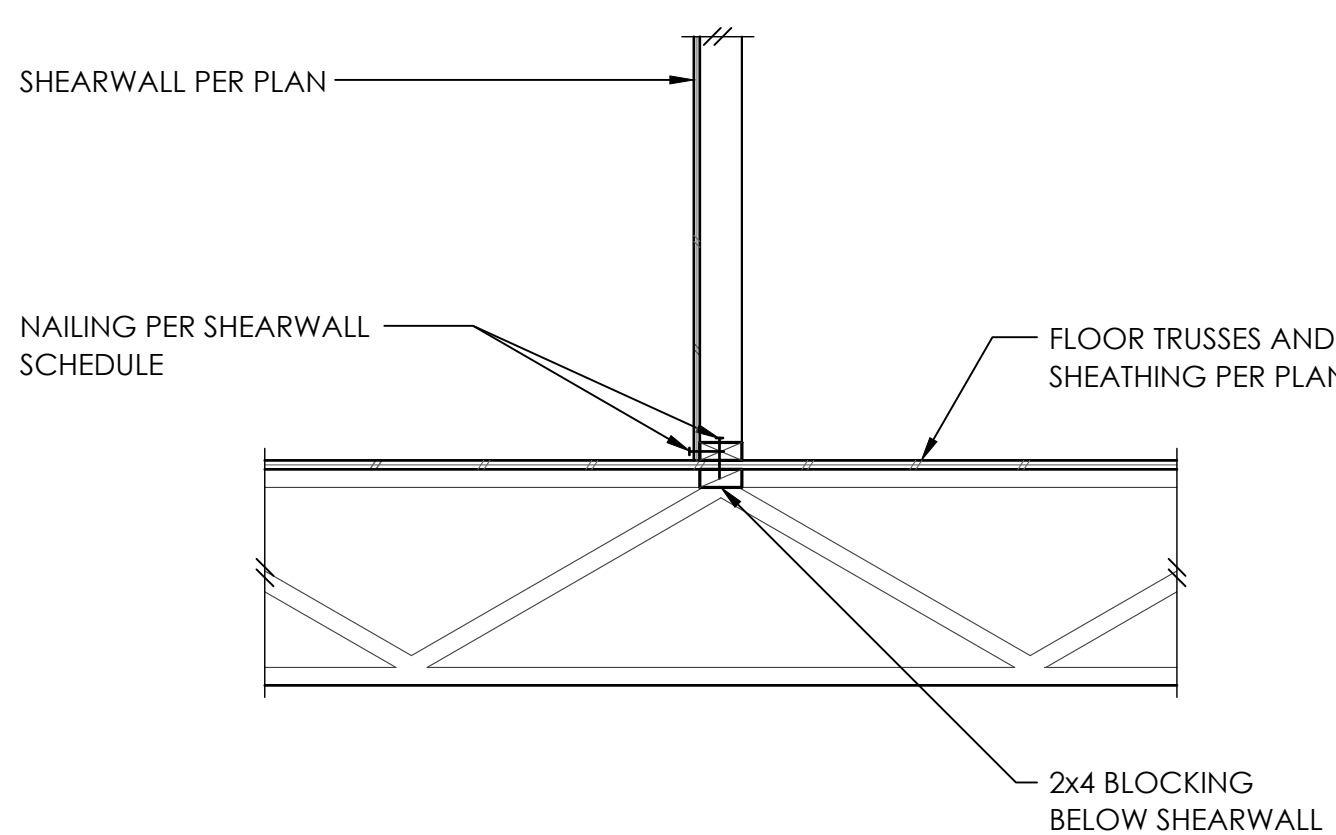


11

BEARING AND EXTERIOR WALLS			NON-BEARING WALLS		
STUD	MAX DEPTH OF NOTCH	MAX DIA. SIZE OF HOLE	STUD	MAX DEPTH OF NOTCH	MAX DIA. SIZE OF HOLE
2x4	3/4"	1-3/8"	2x4	1-3/8"	2"
2x6	1-1/4"	2-1/8"	2x6	2-1/4"	3-1/4"

HOLE AND NOTCH SIZE FOR NON-BEARING WALLS MAY BE USED FOR BEARING WALLS IF REQUIRED NUMBER OF STUDS ARE DOUBLED. DOUBLED STUDS SHALL BE LIMITED TO TWO SUCCESSIVE STUDS.

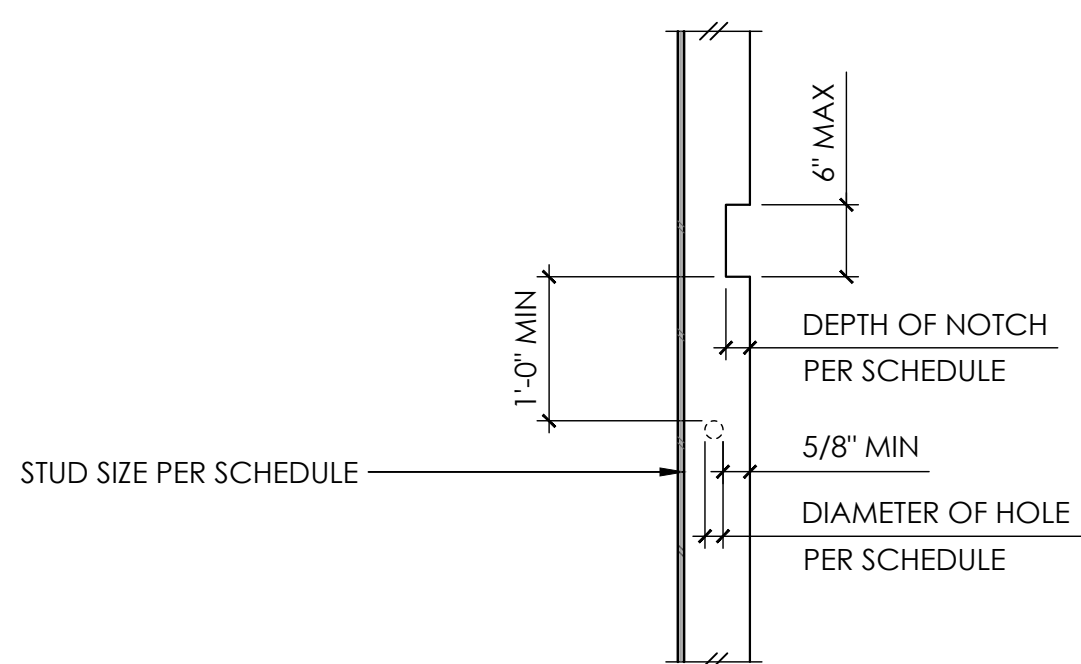


TYPICAL ALLOWABLE HOLES AND NOTCHES IN WALL STUDS 12

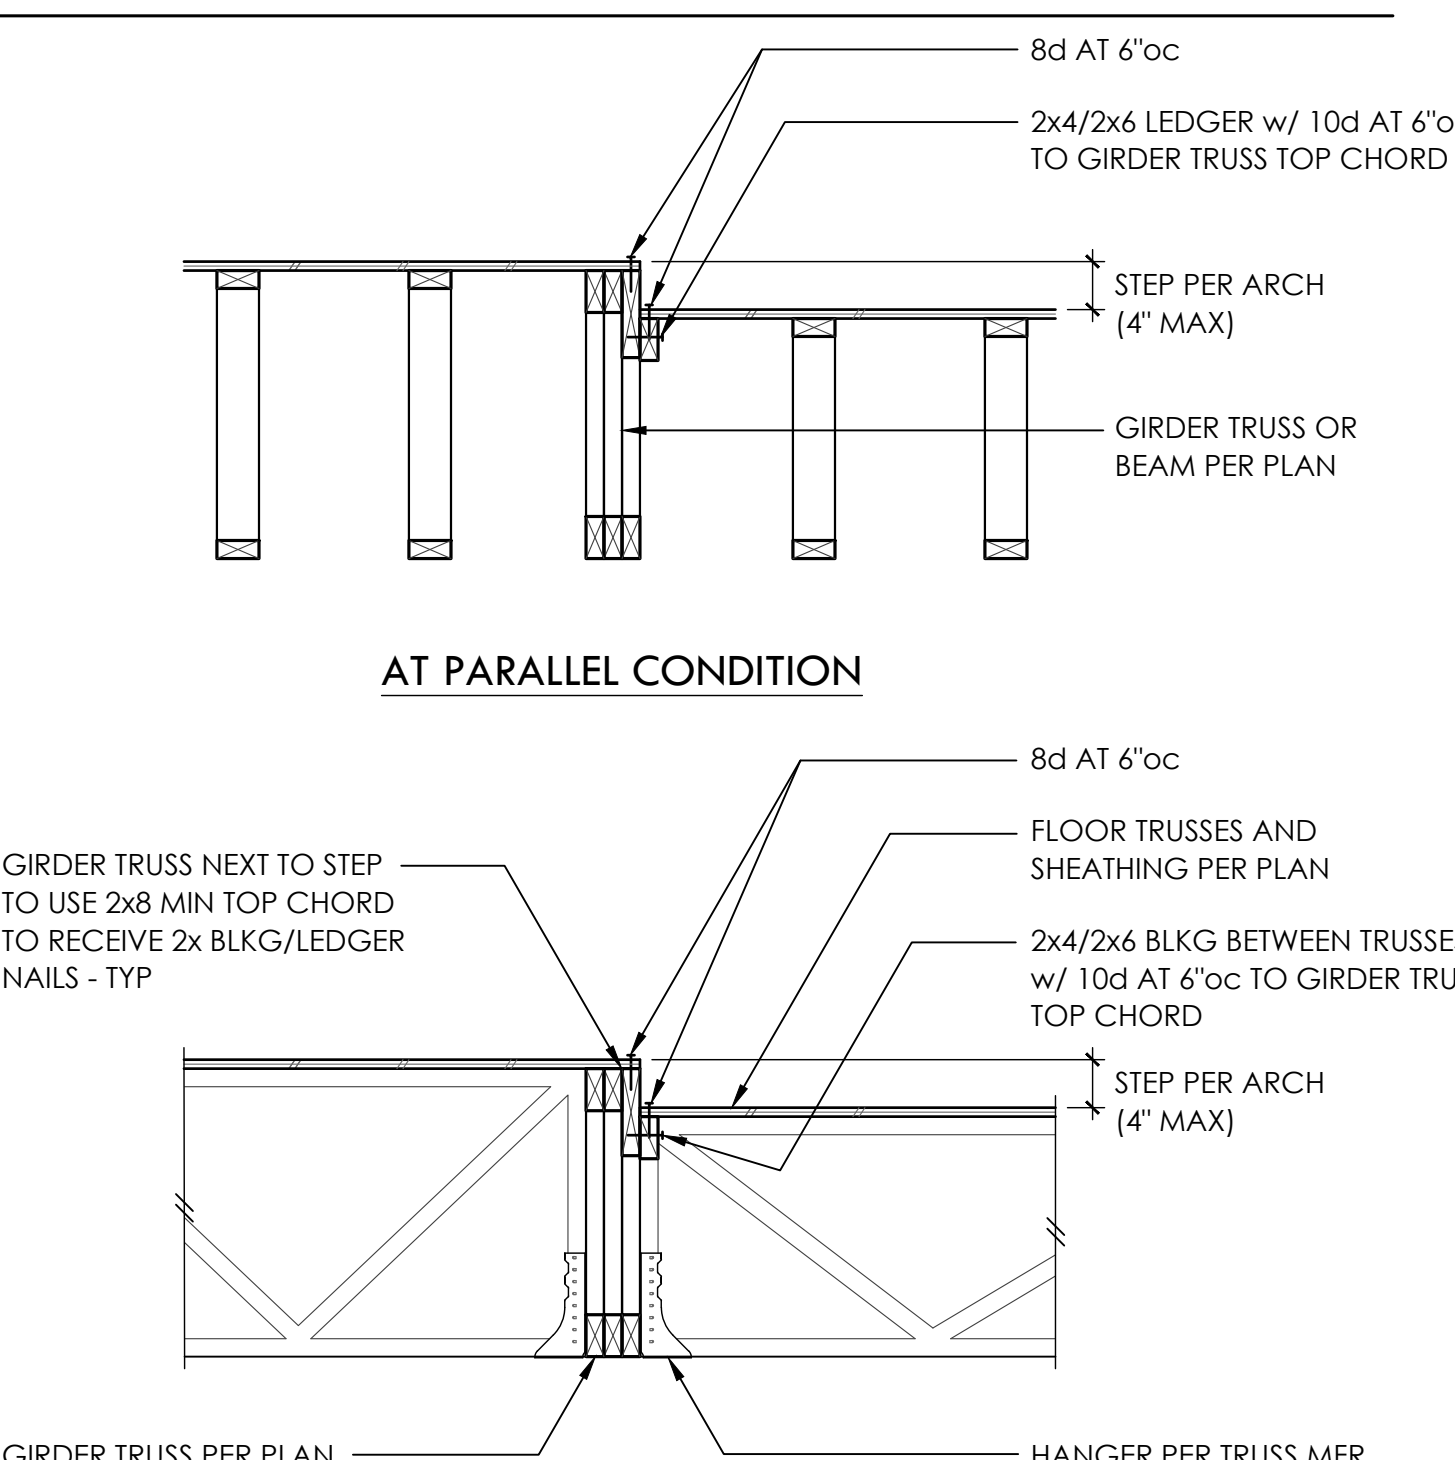


16


TYPICAL TRUSS TO GIRDER TRUSS STEP 17

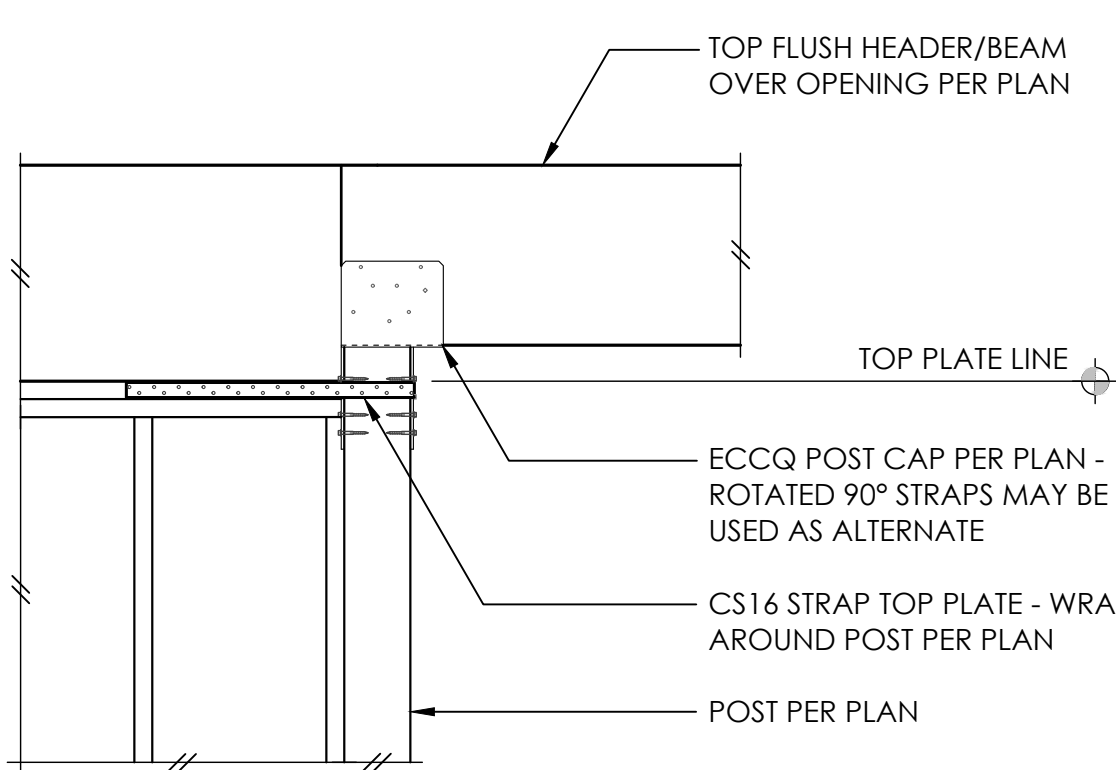


TYPICAL HEADER/BEAM END CONNECTION OVER WDO/SGD 18

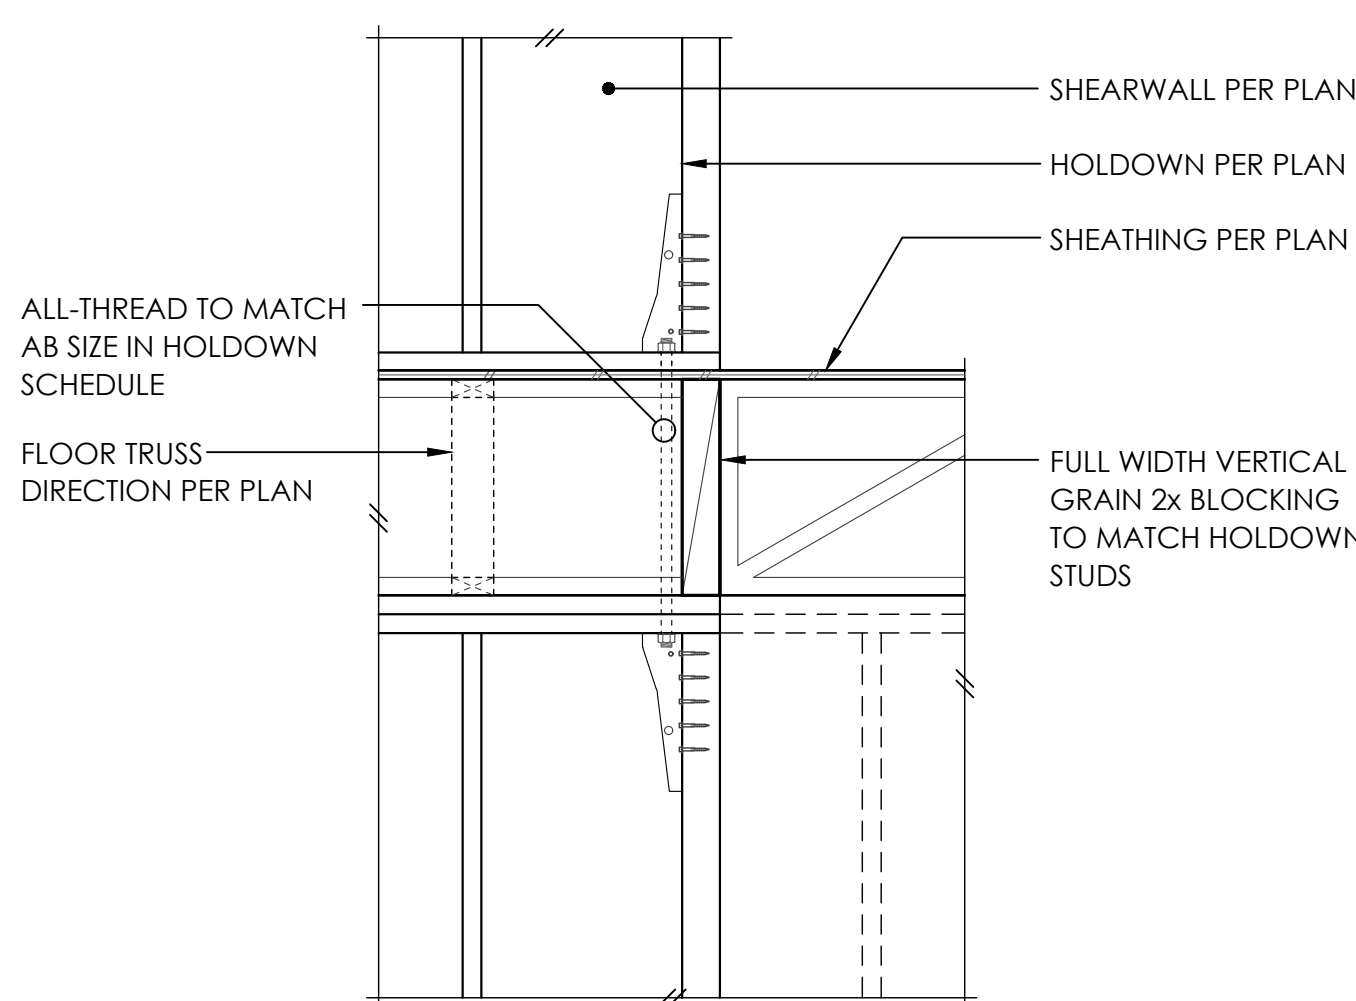


TYPICAL HDU HOLDOWN 14

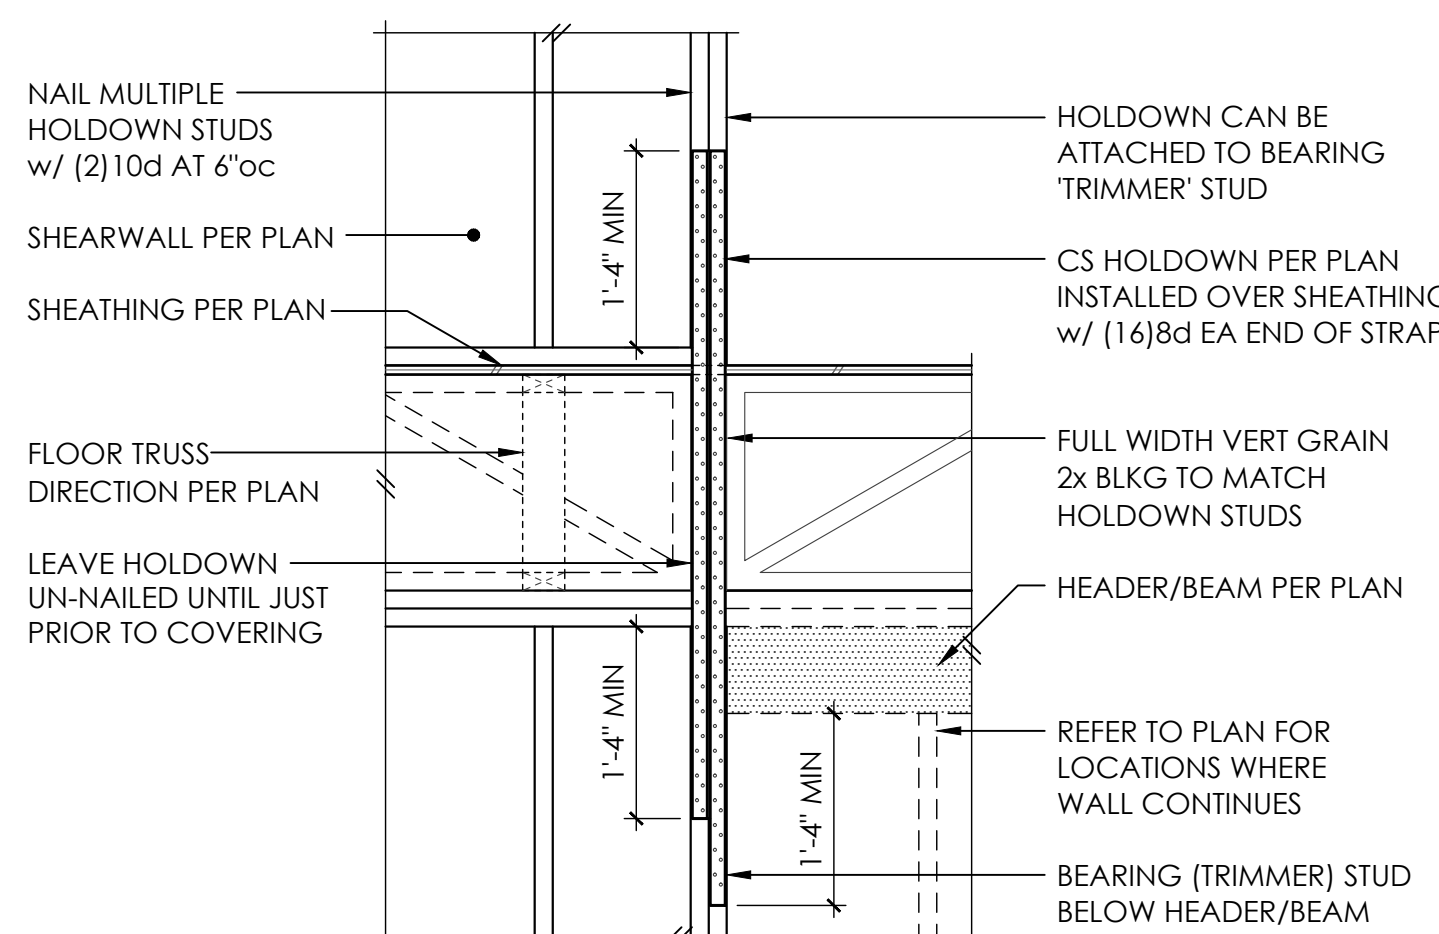


TYPICAL CS16 HOLDOWN 15

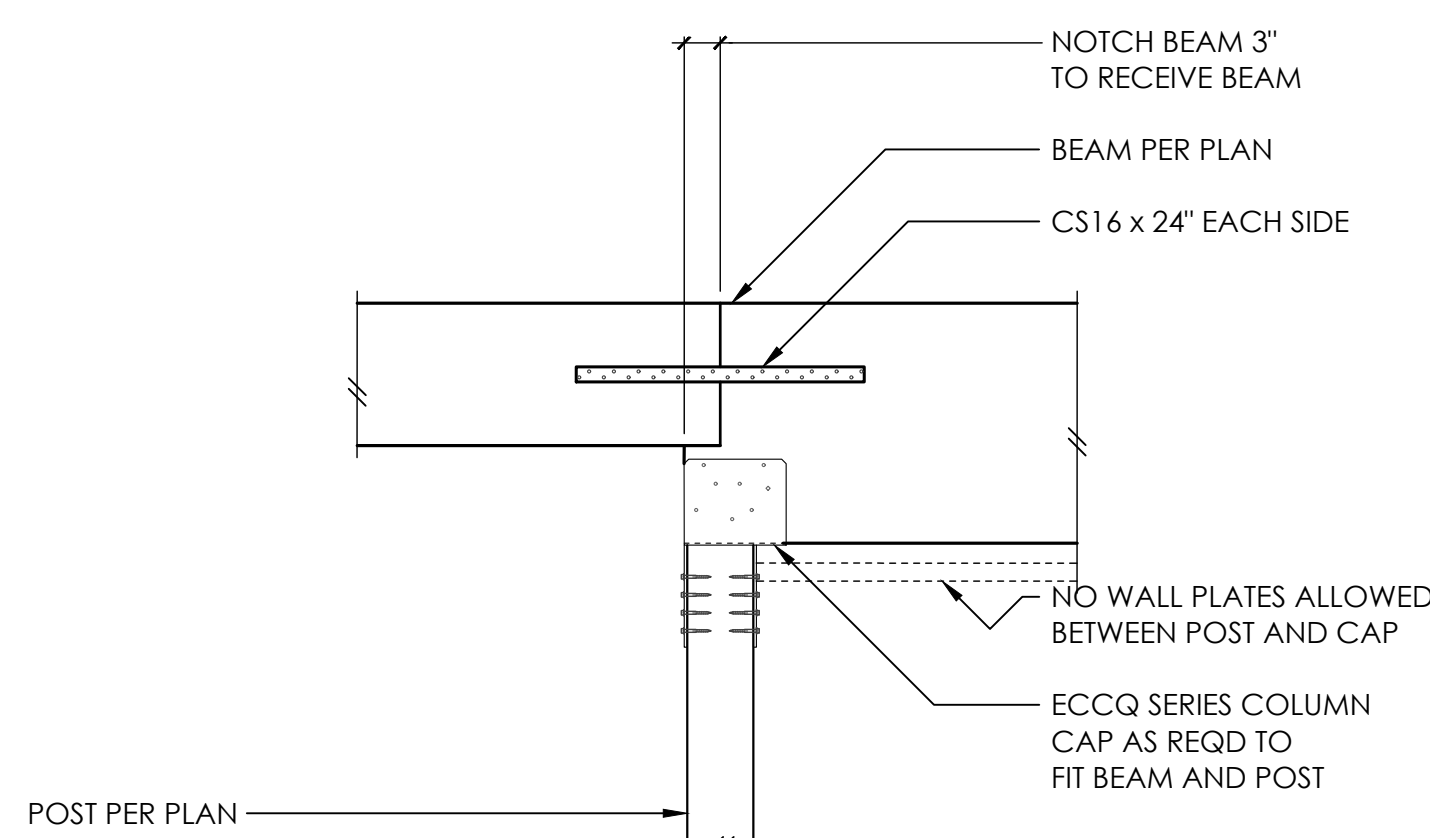


19

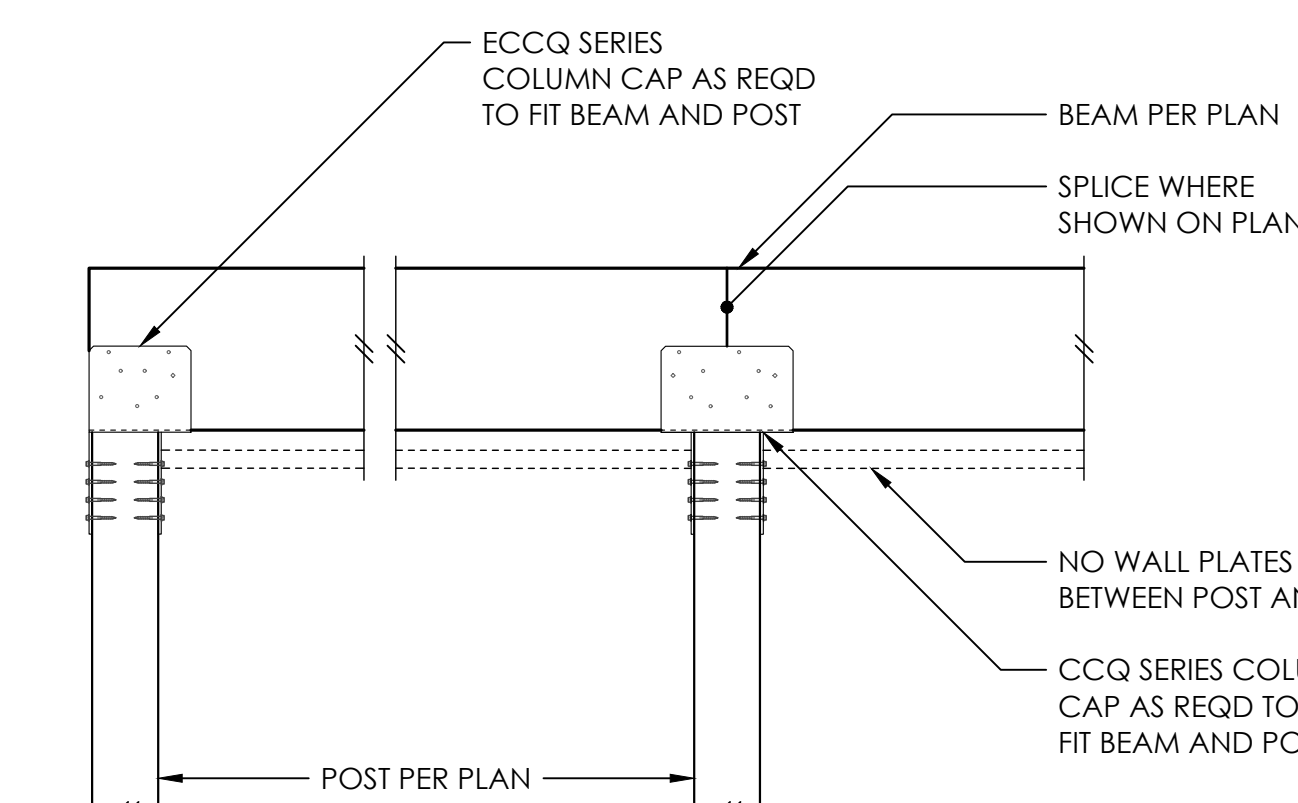


20

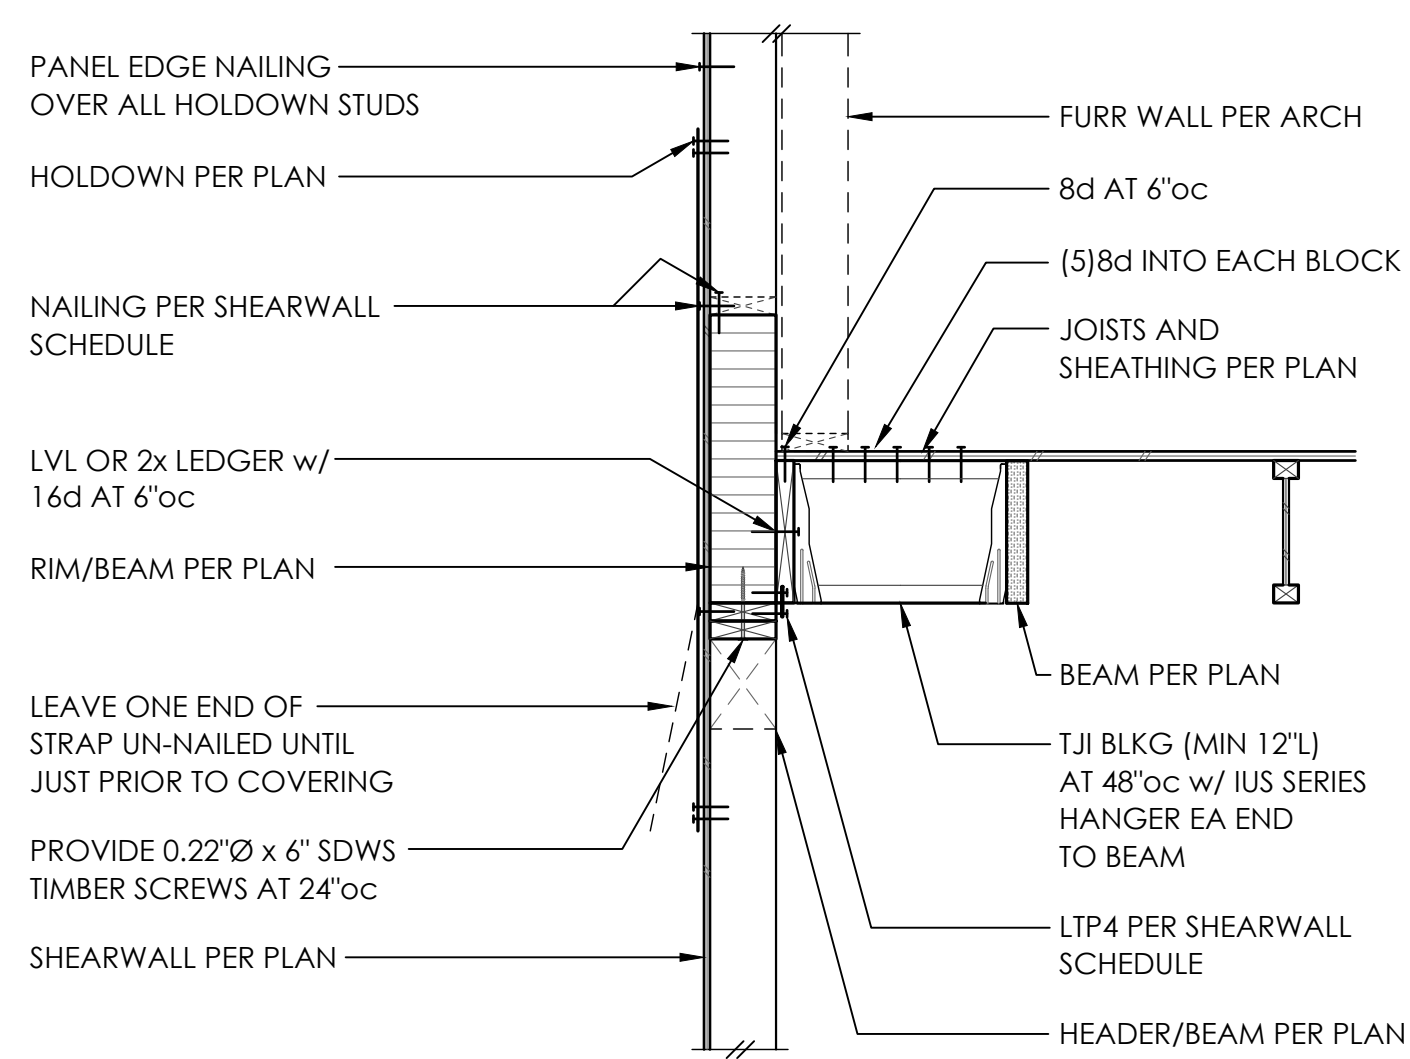


1

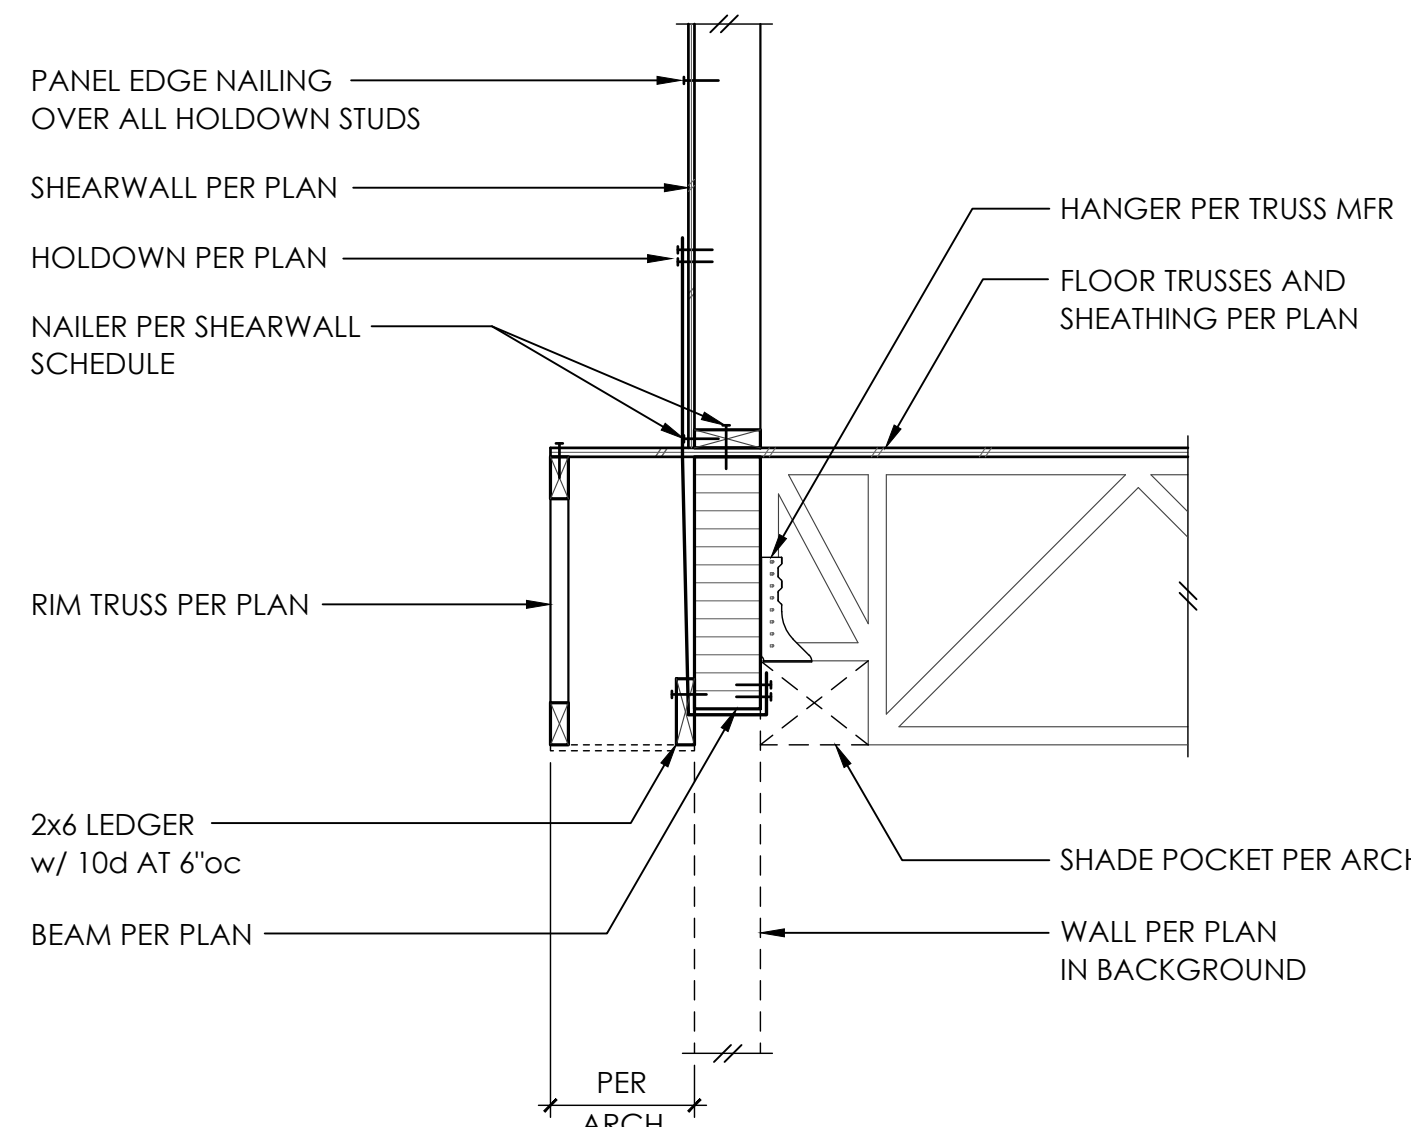


2

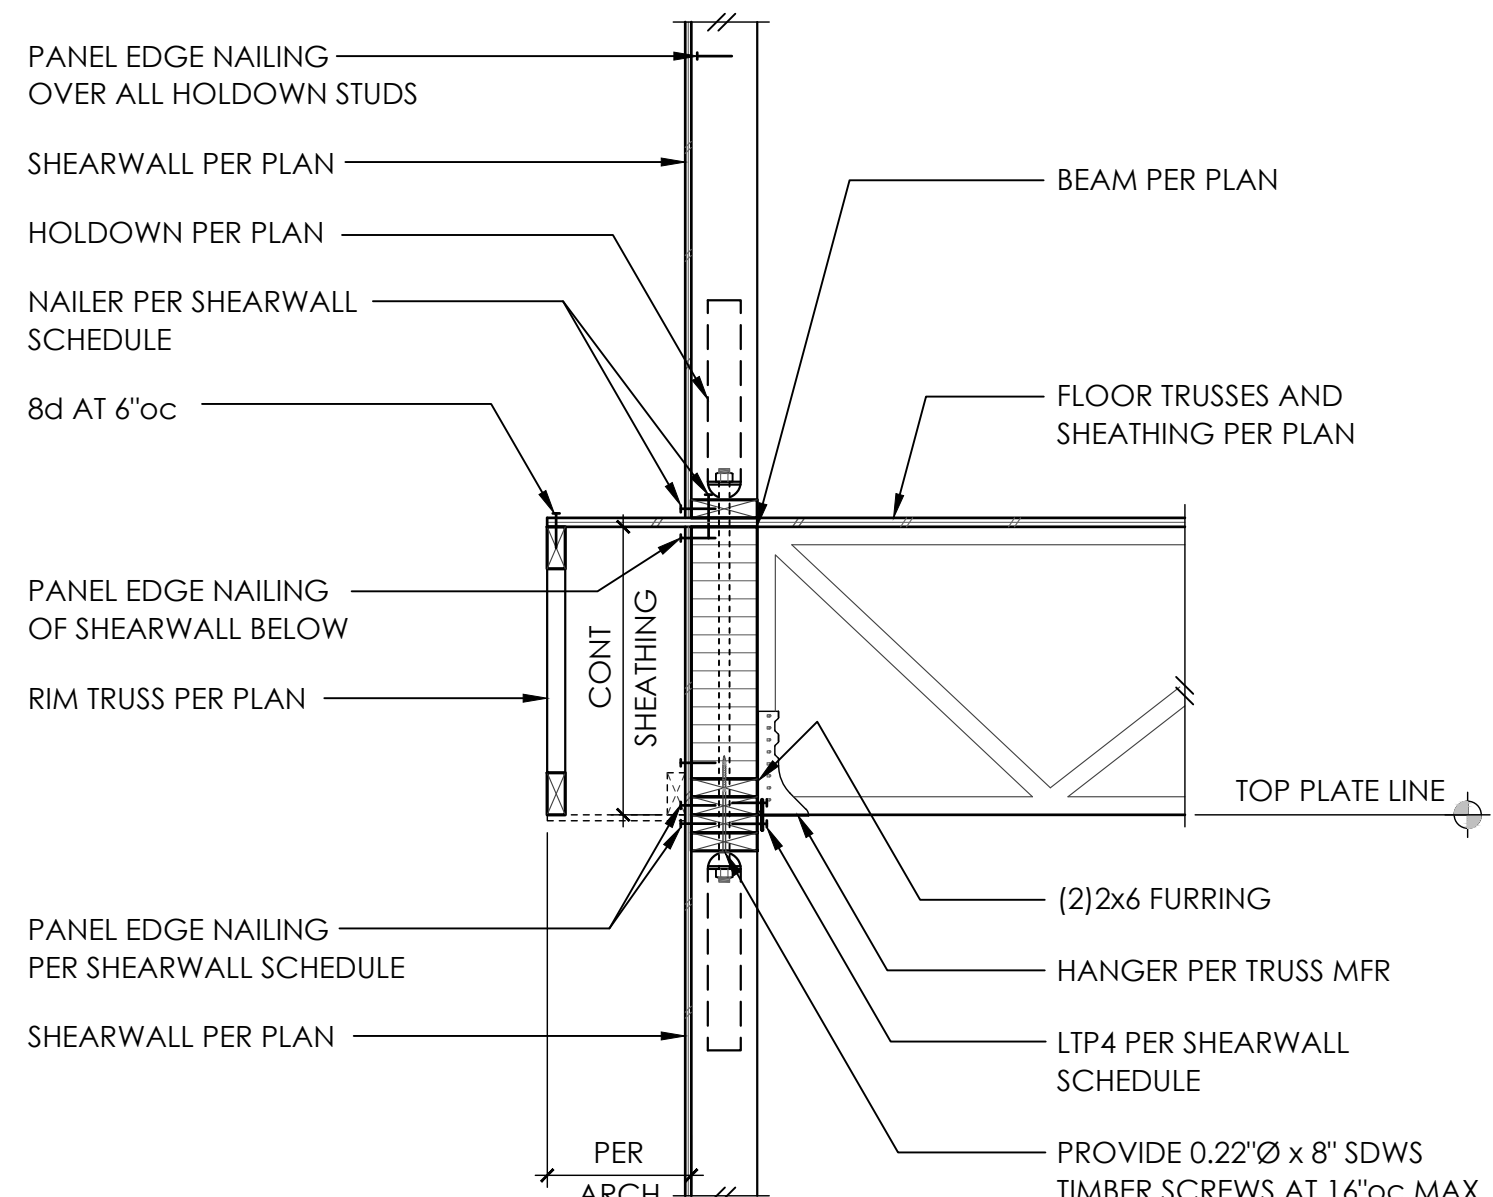


3

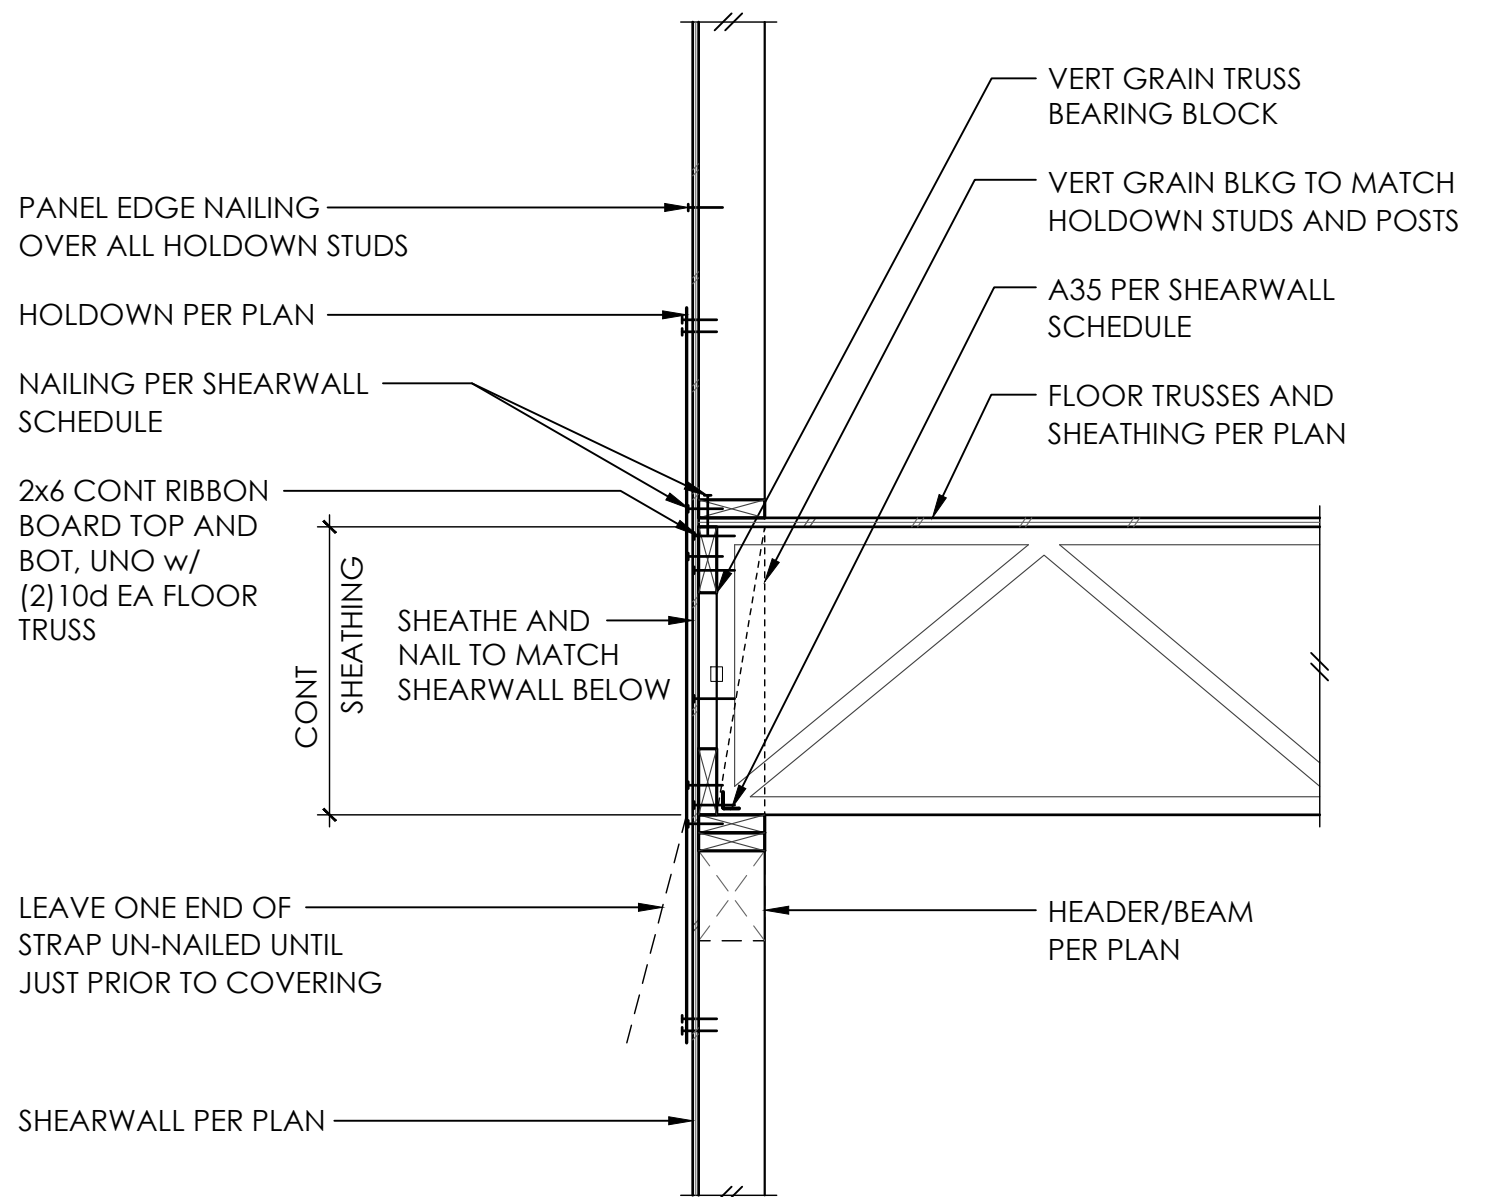


4

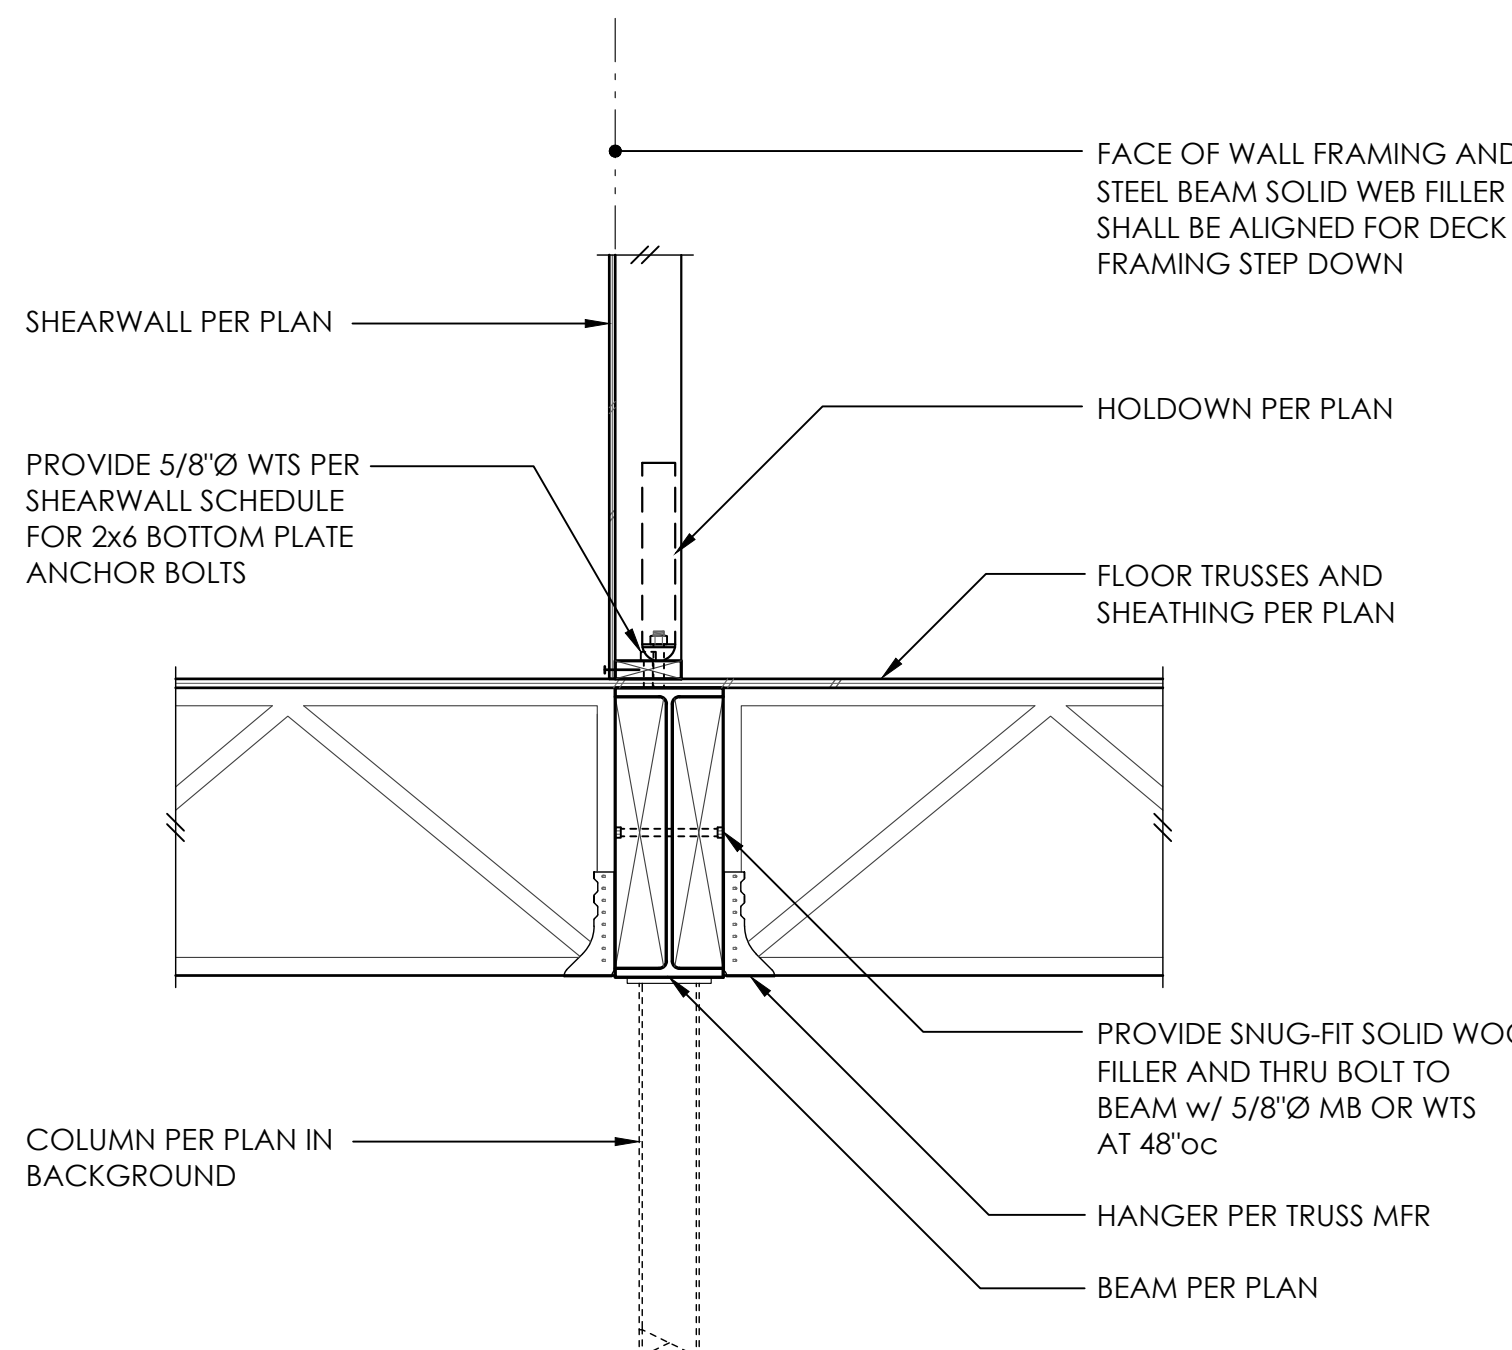


5

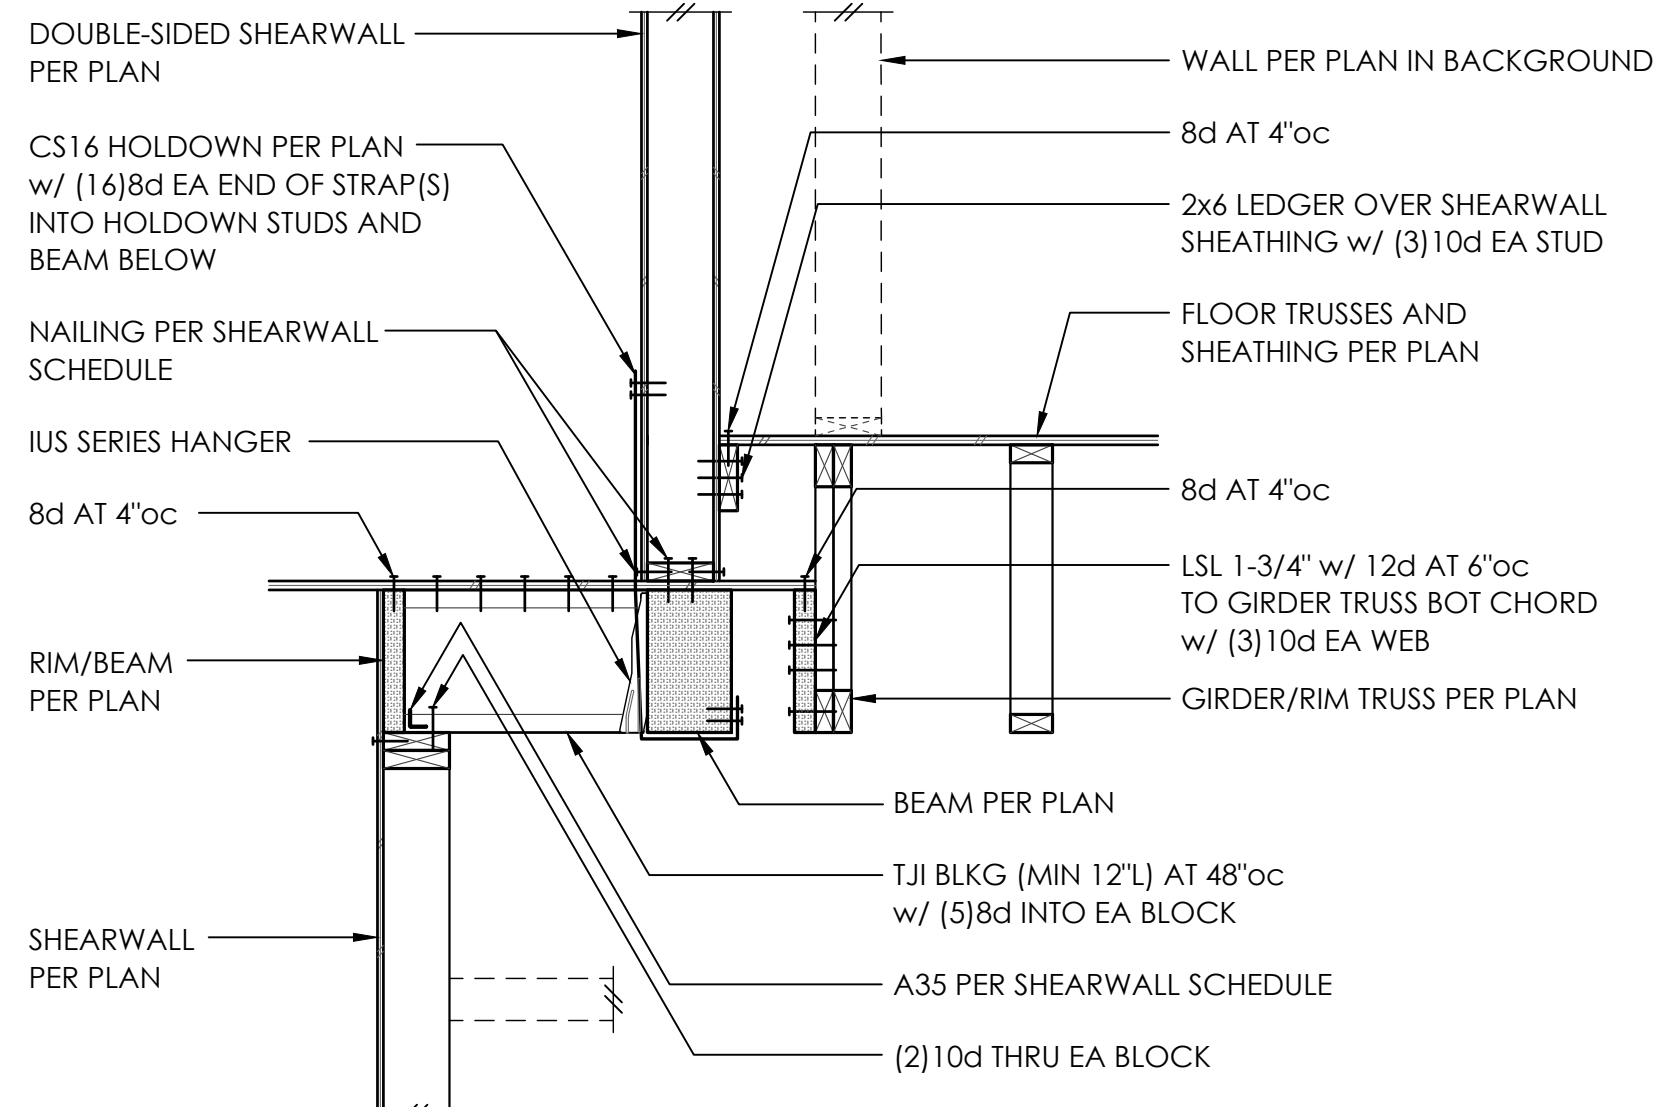


6

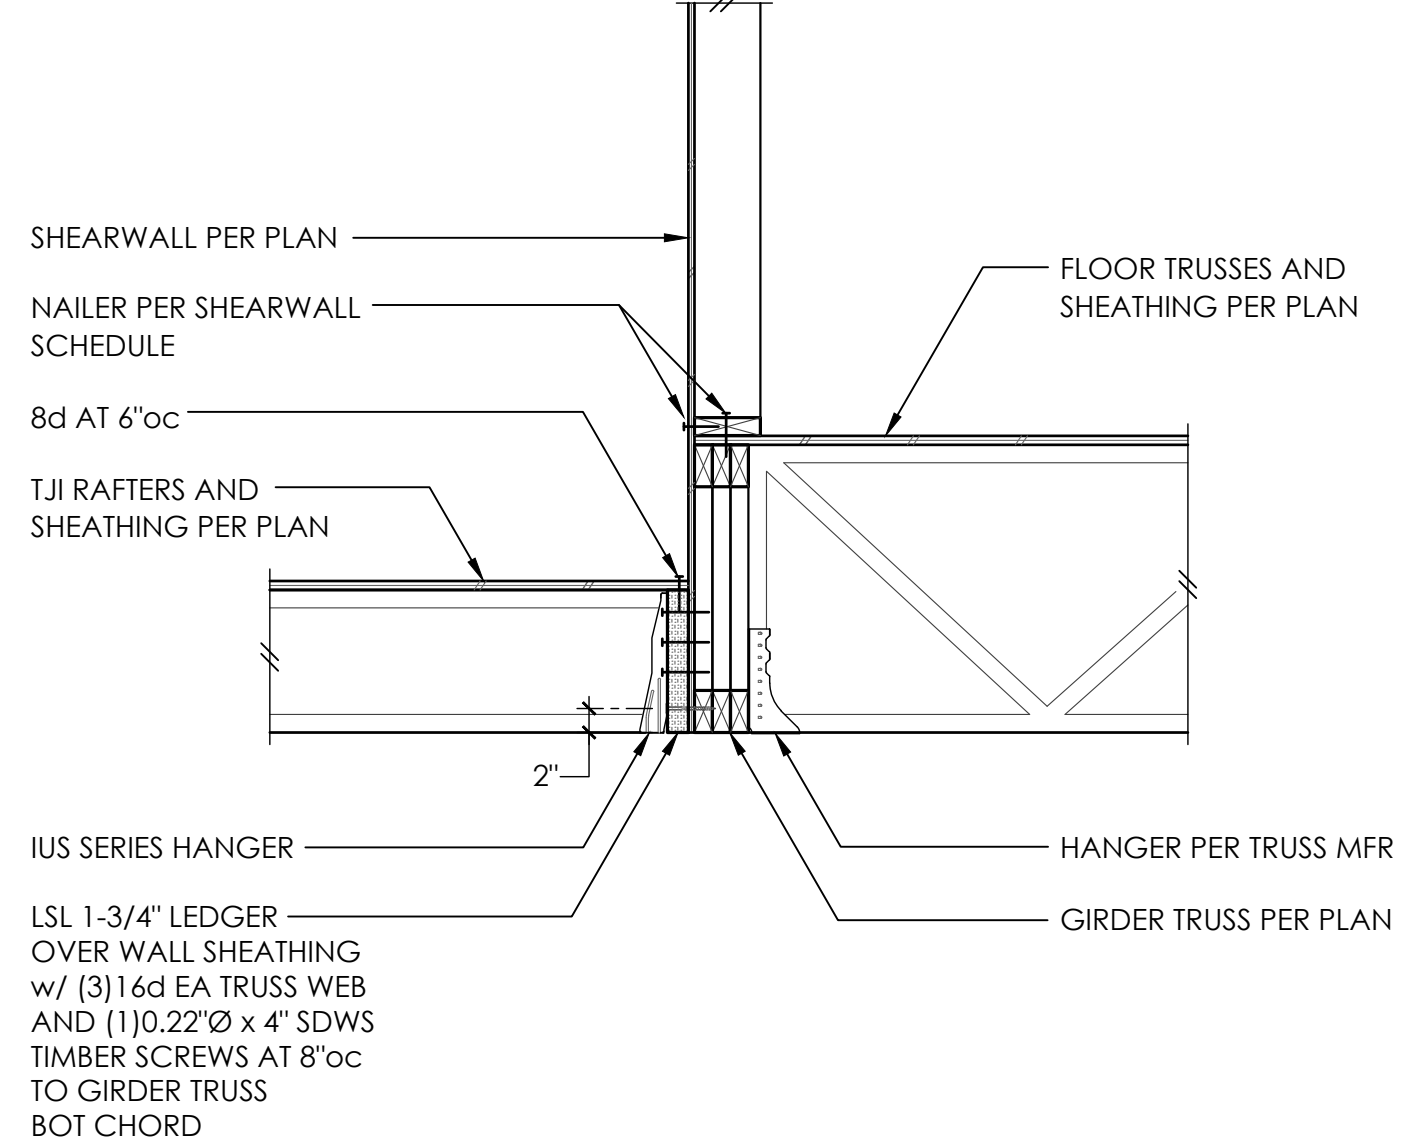


7

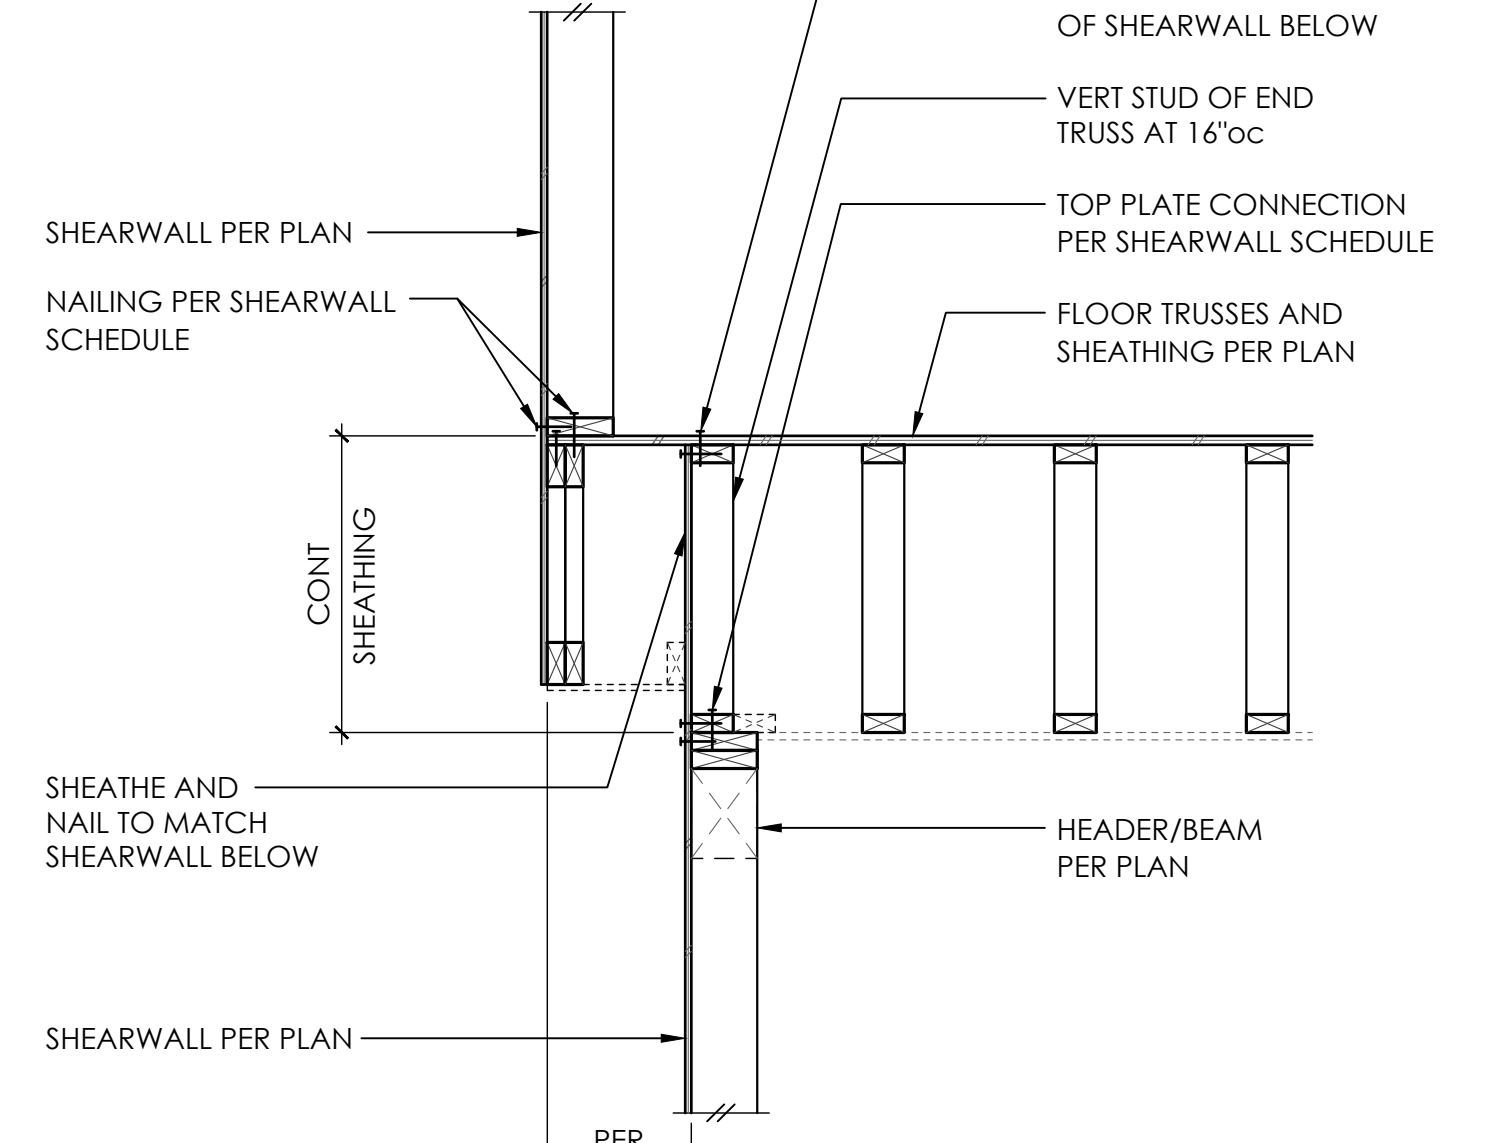


8

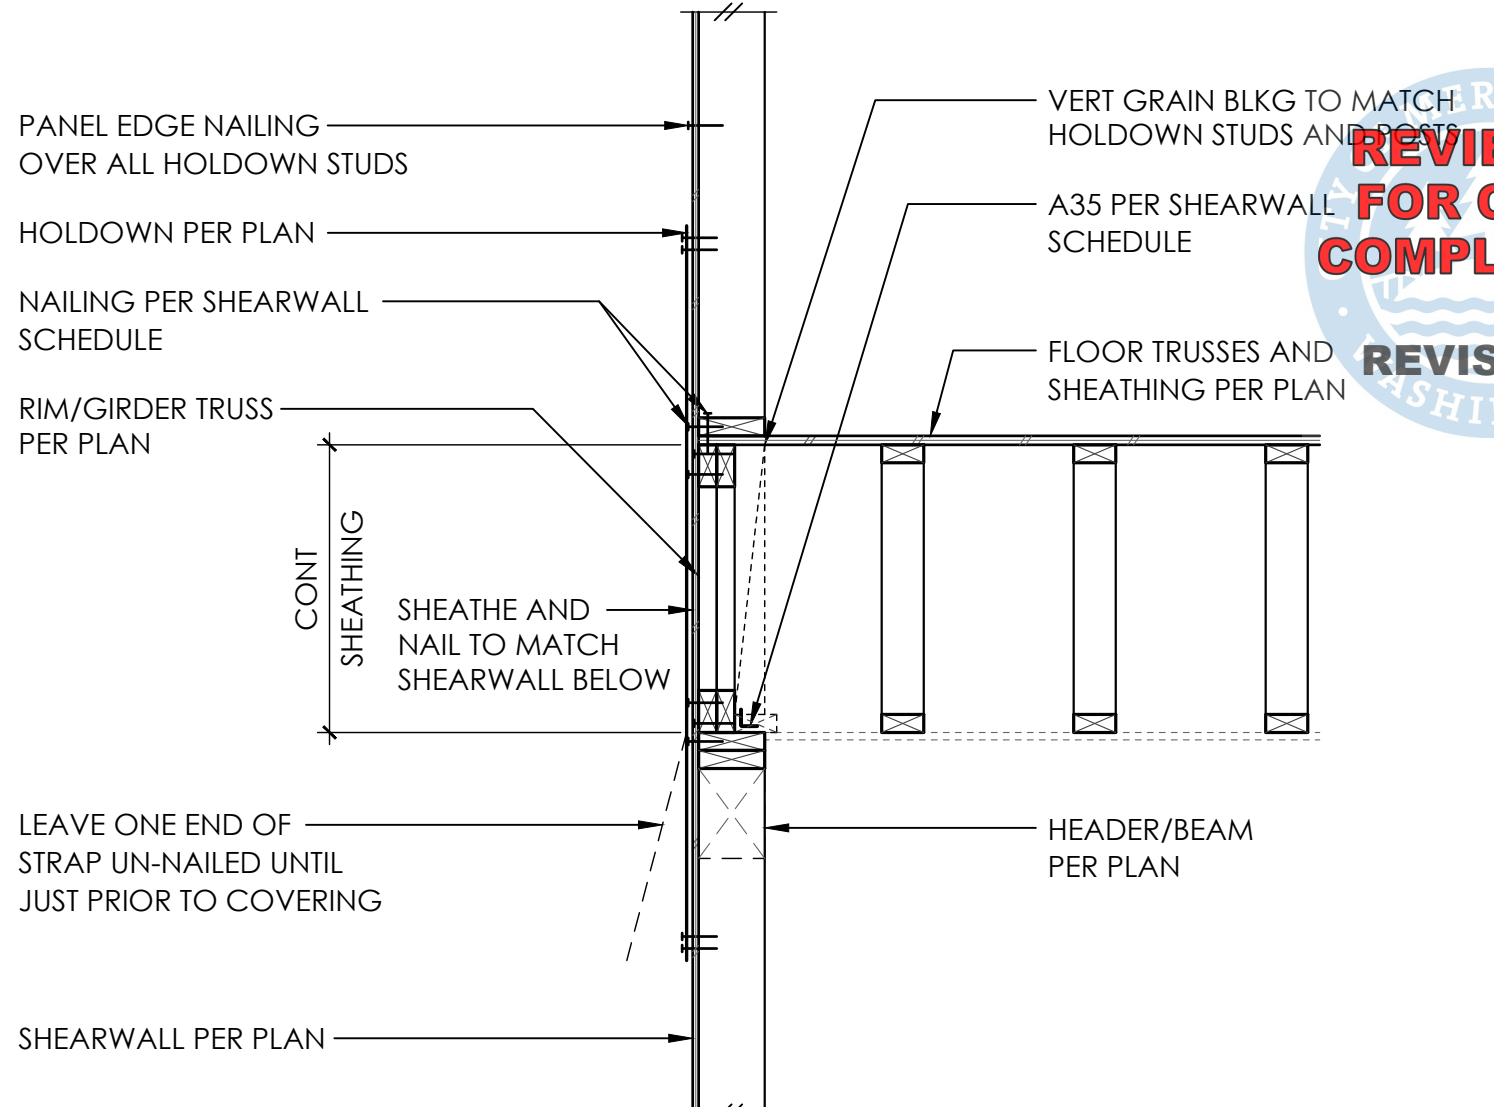


9

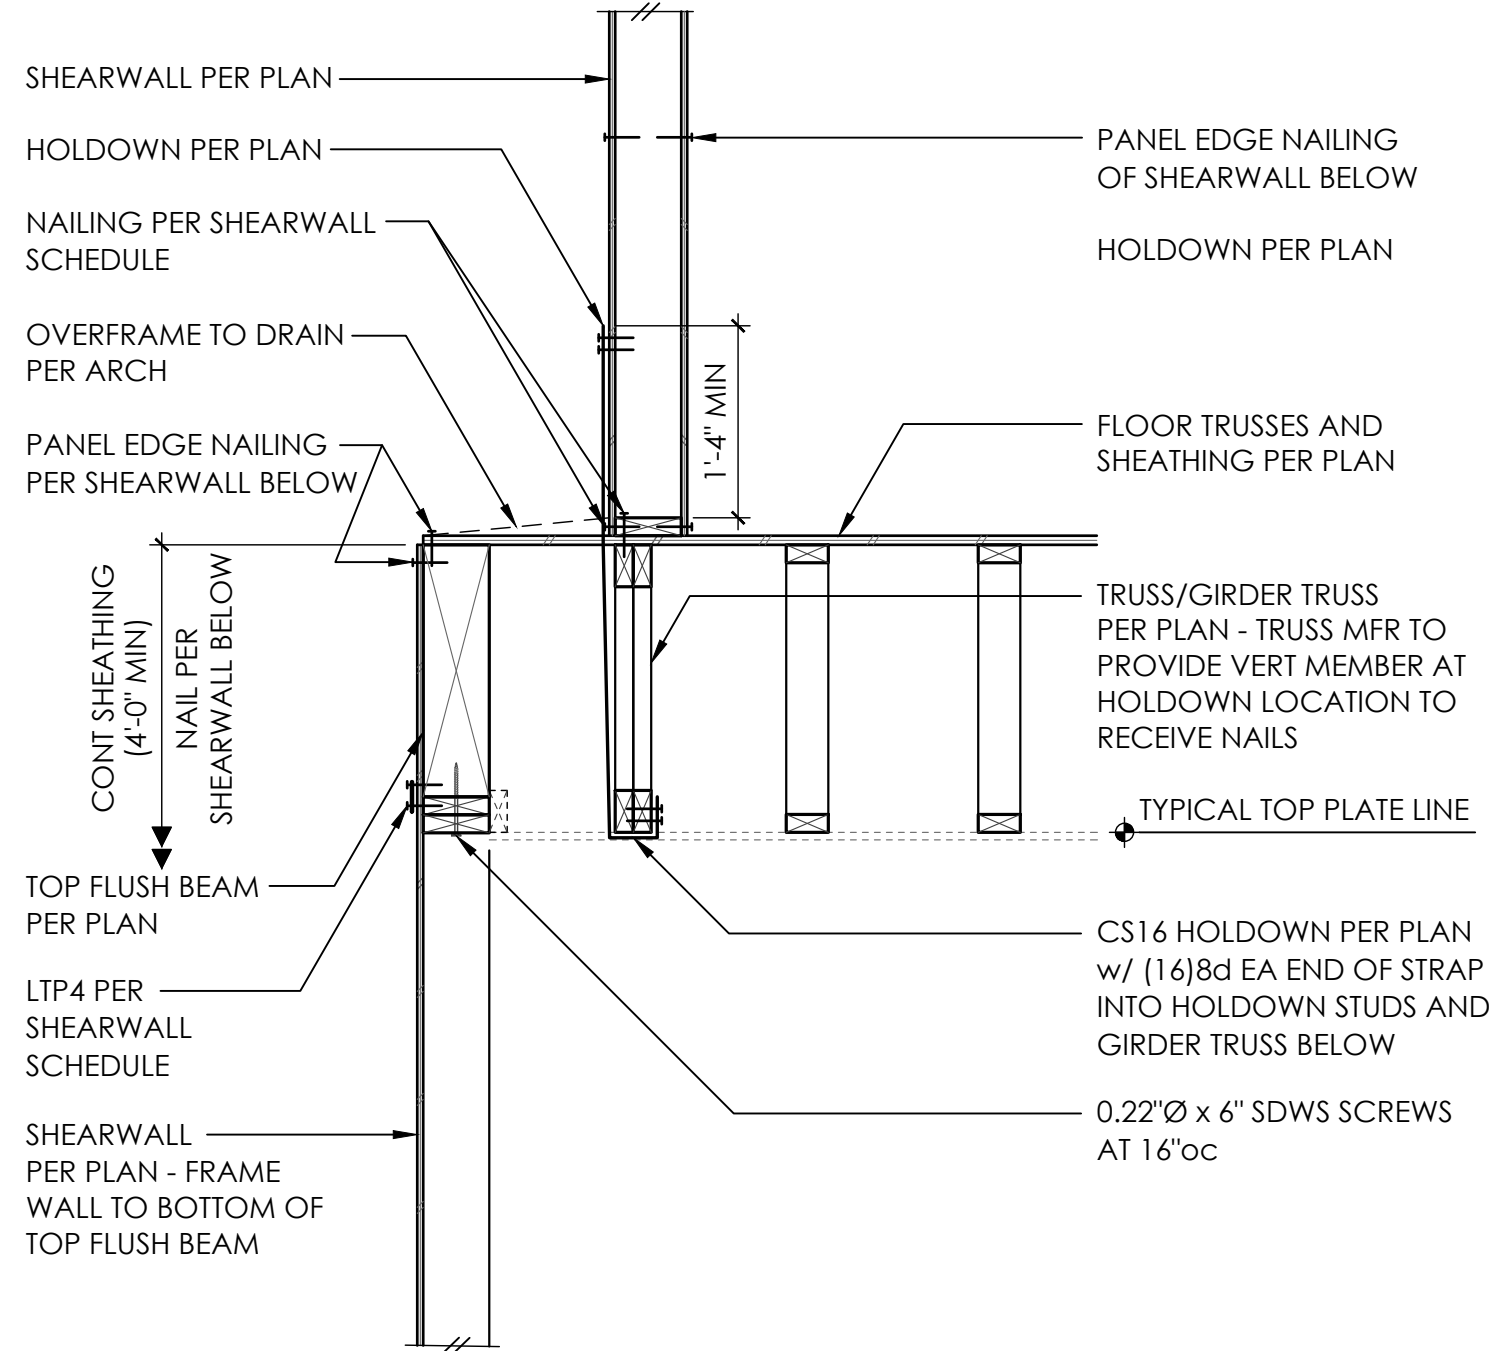


10

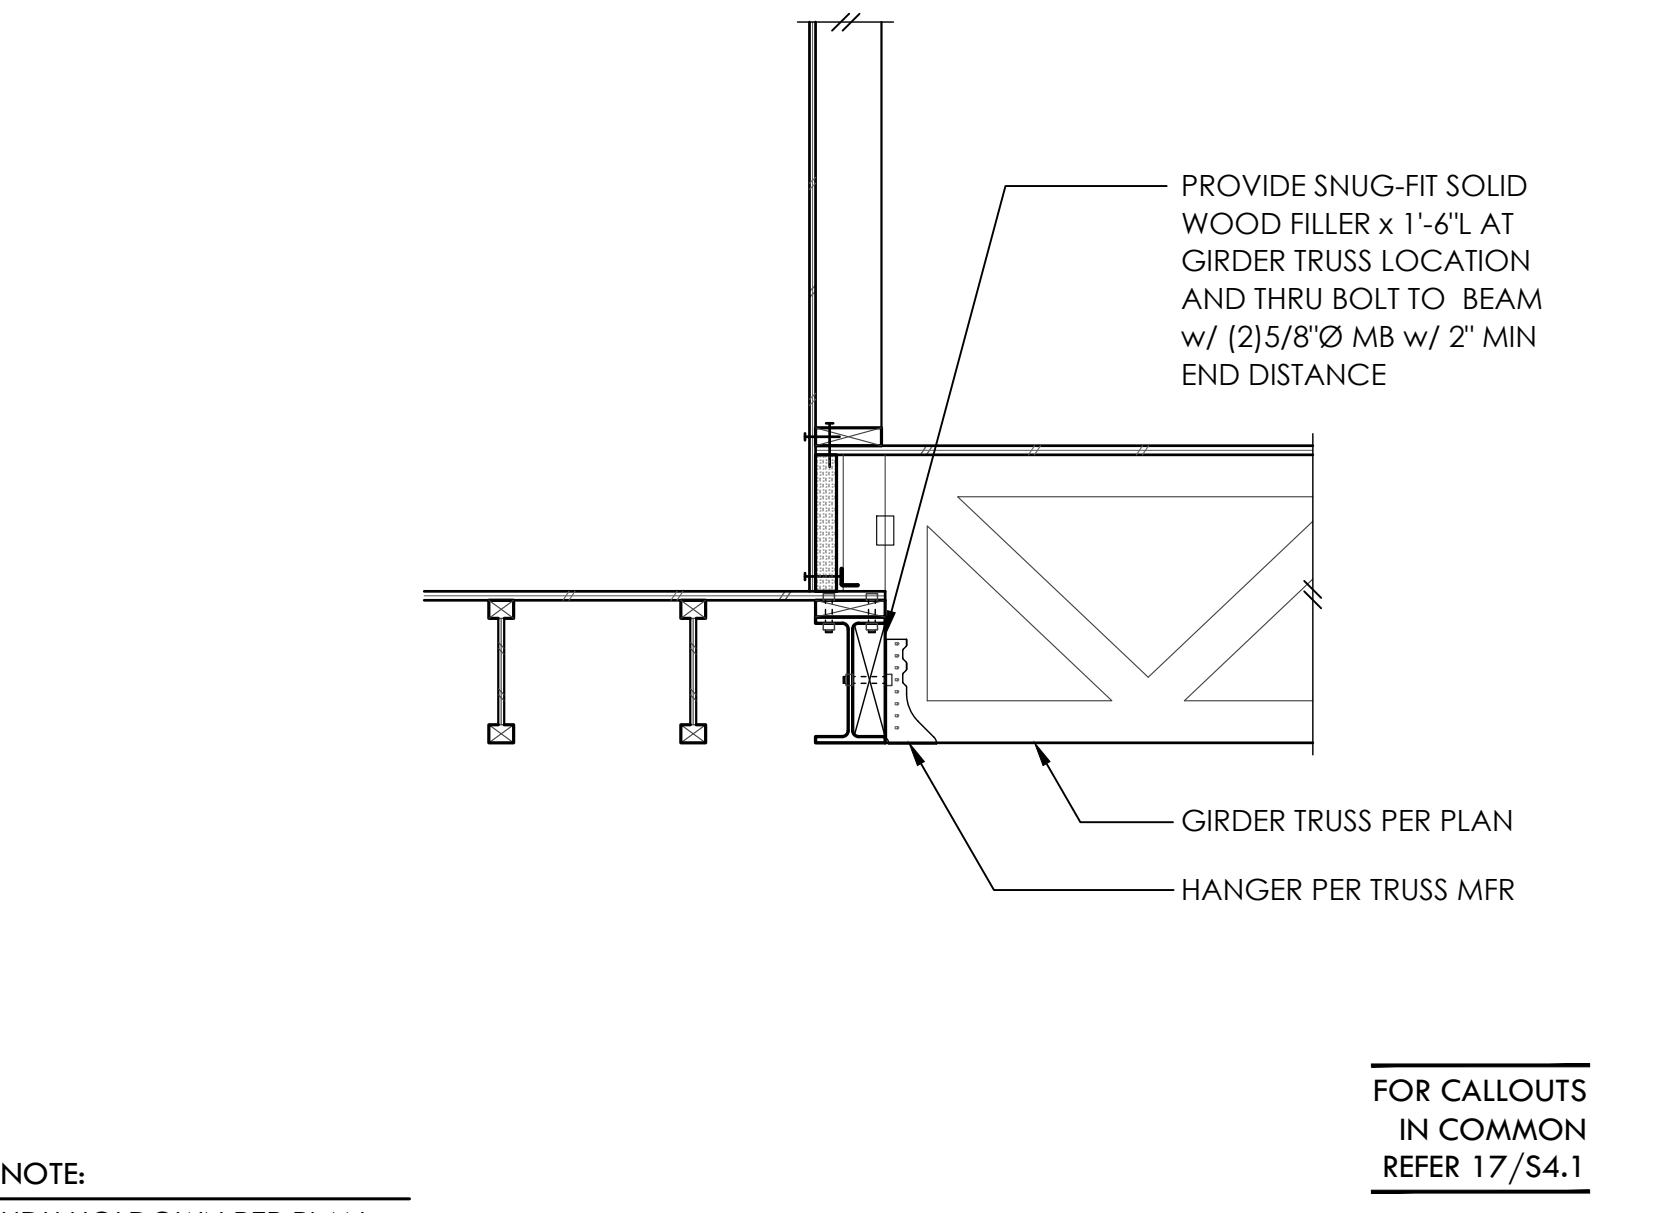


11

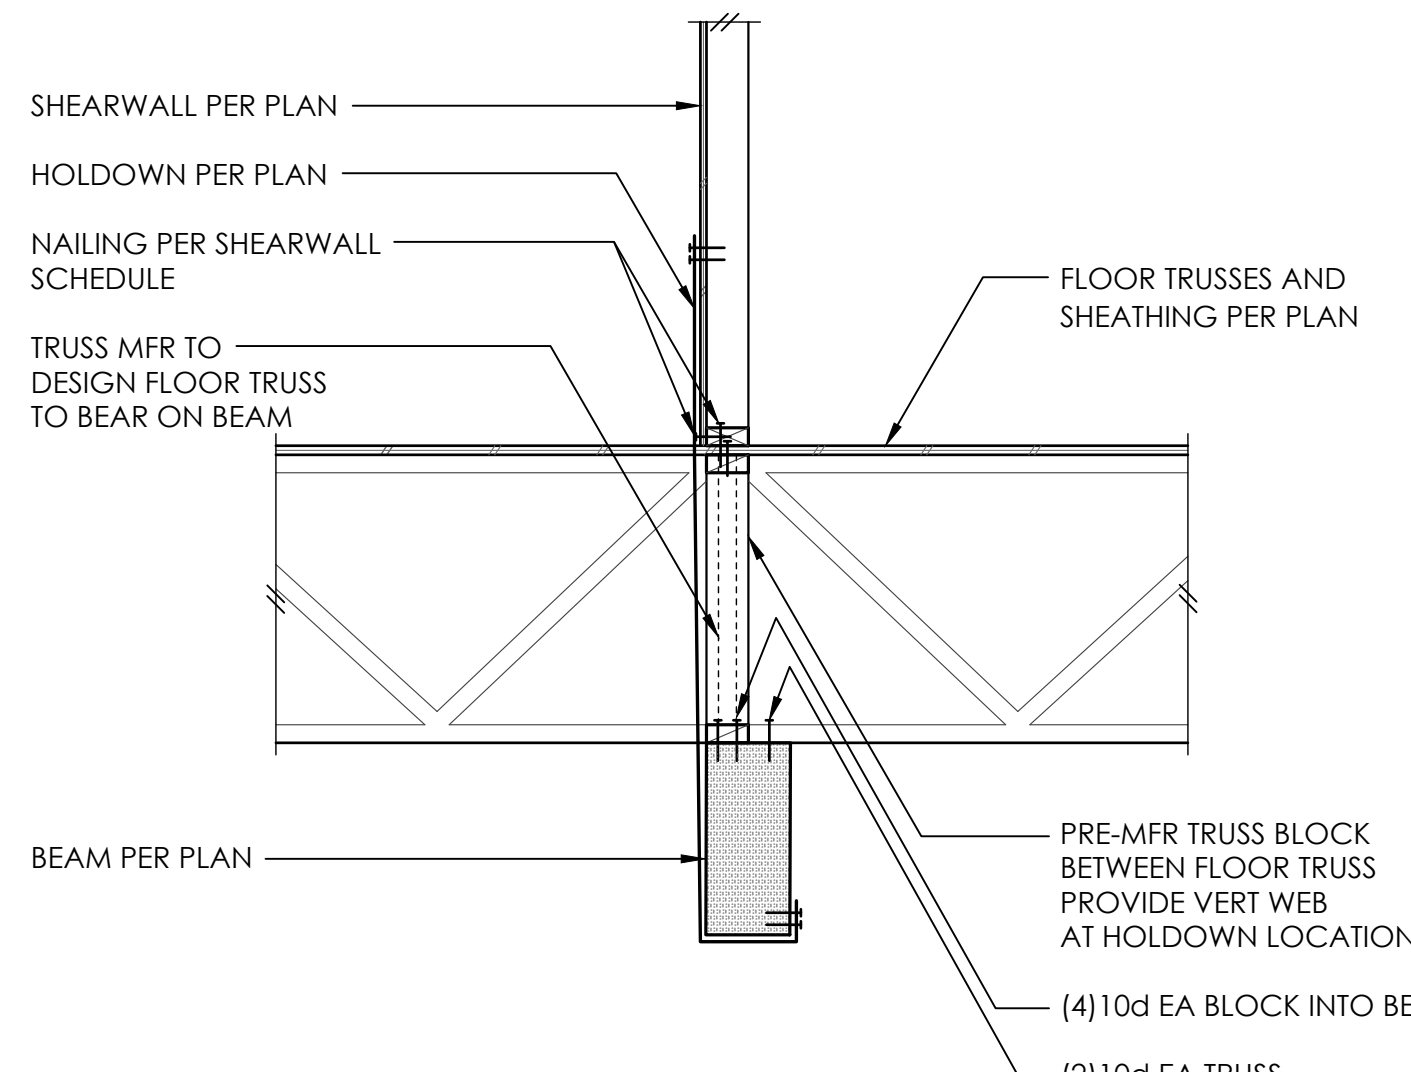


12

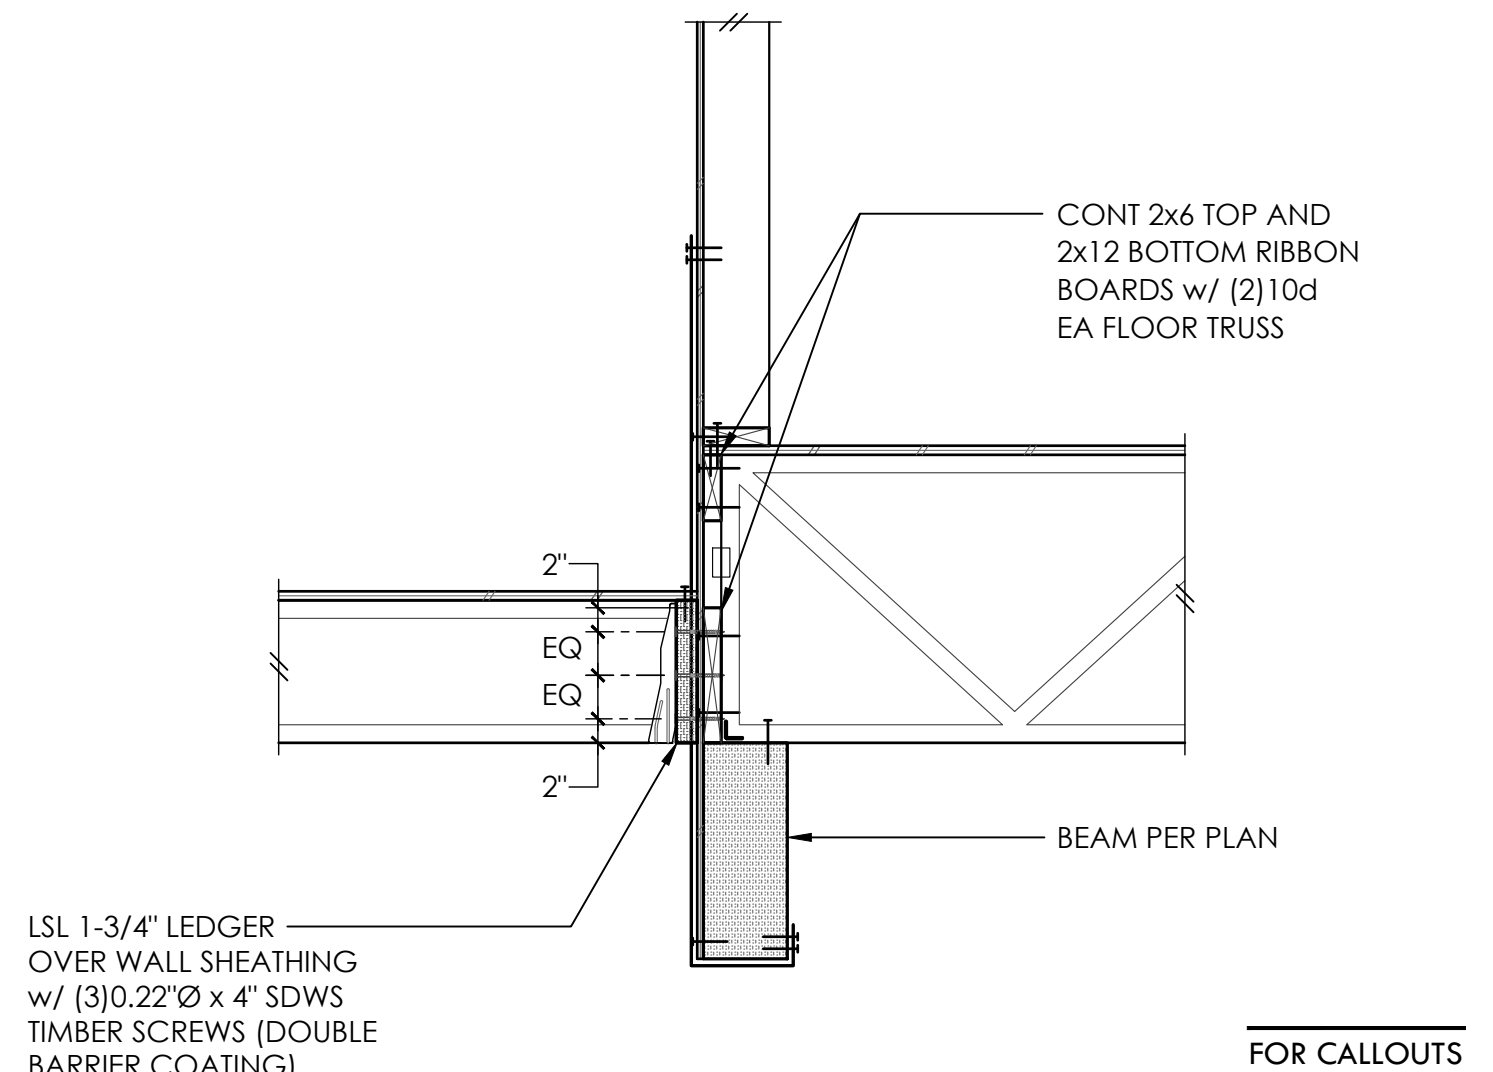


13

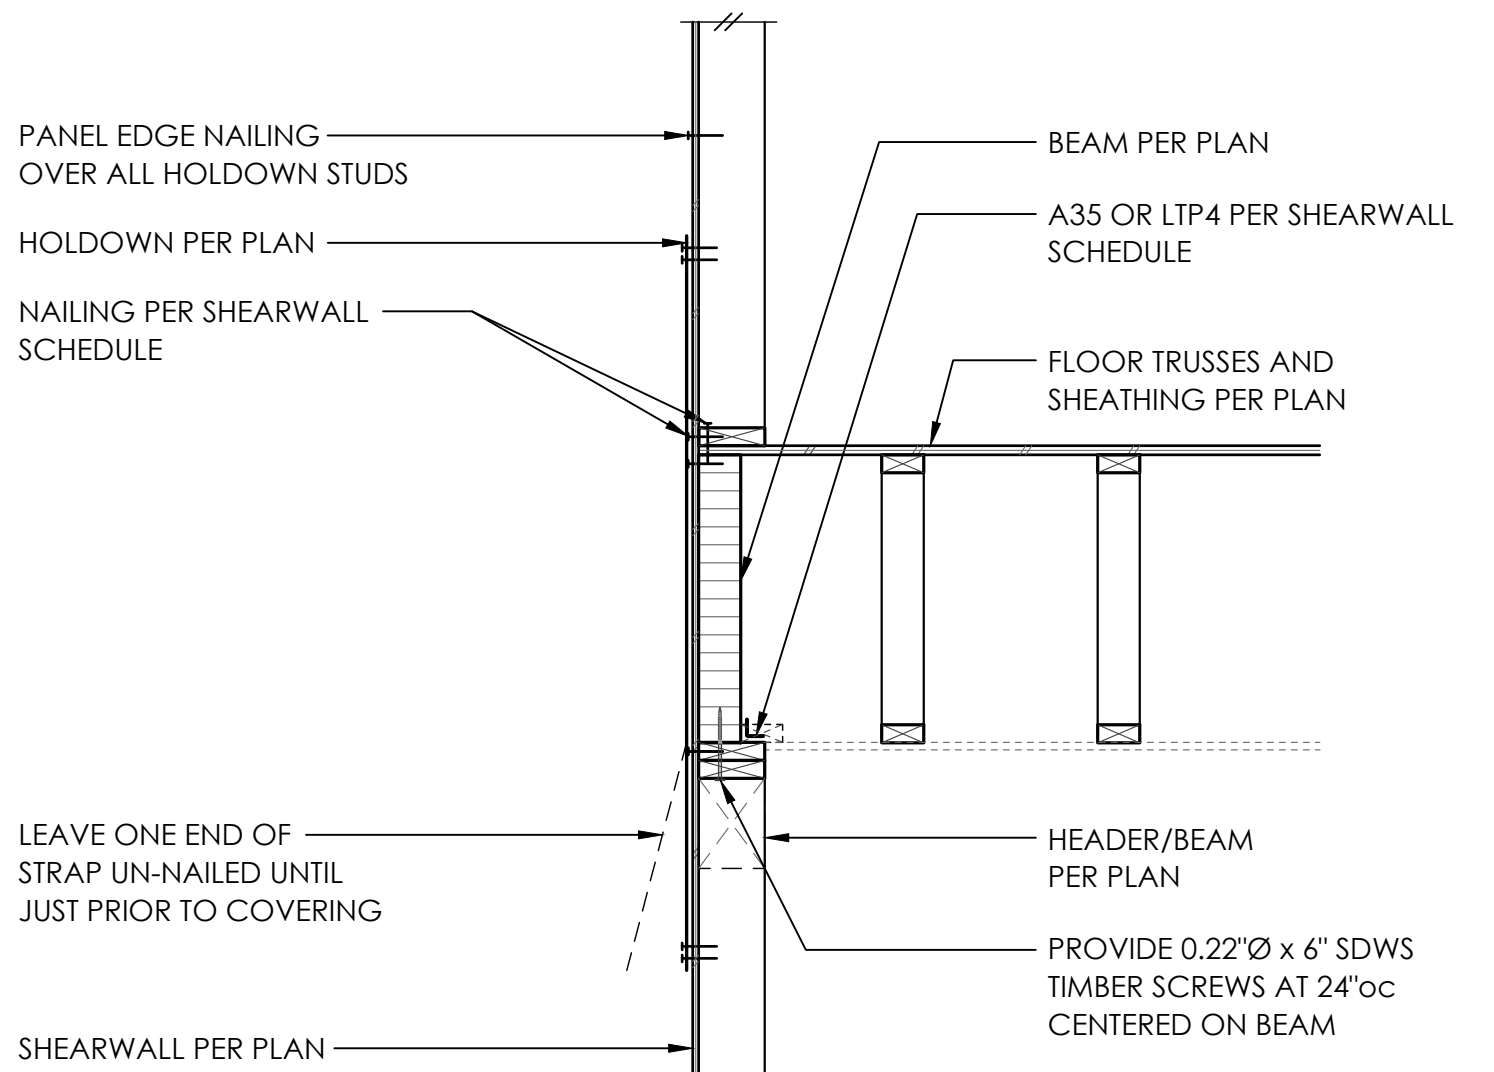


14

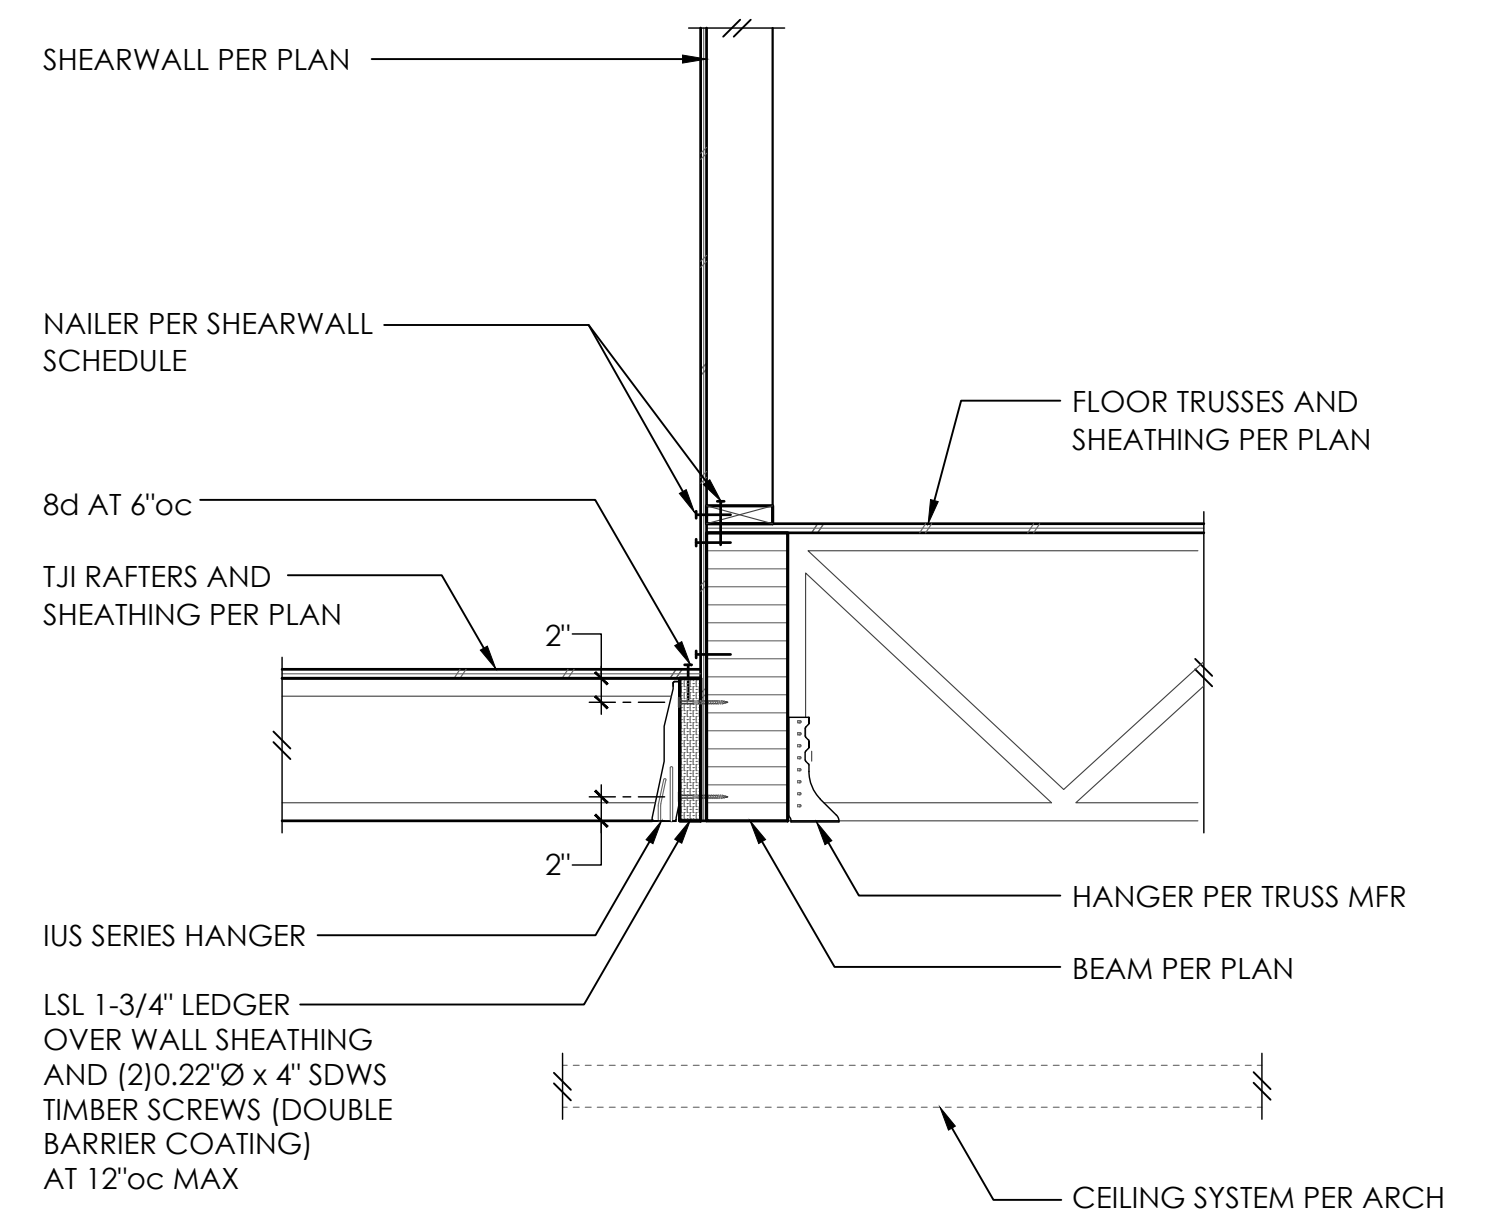


15

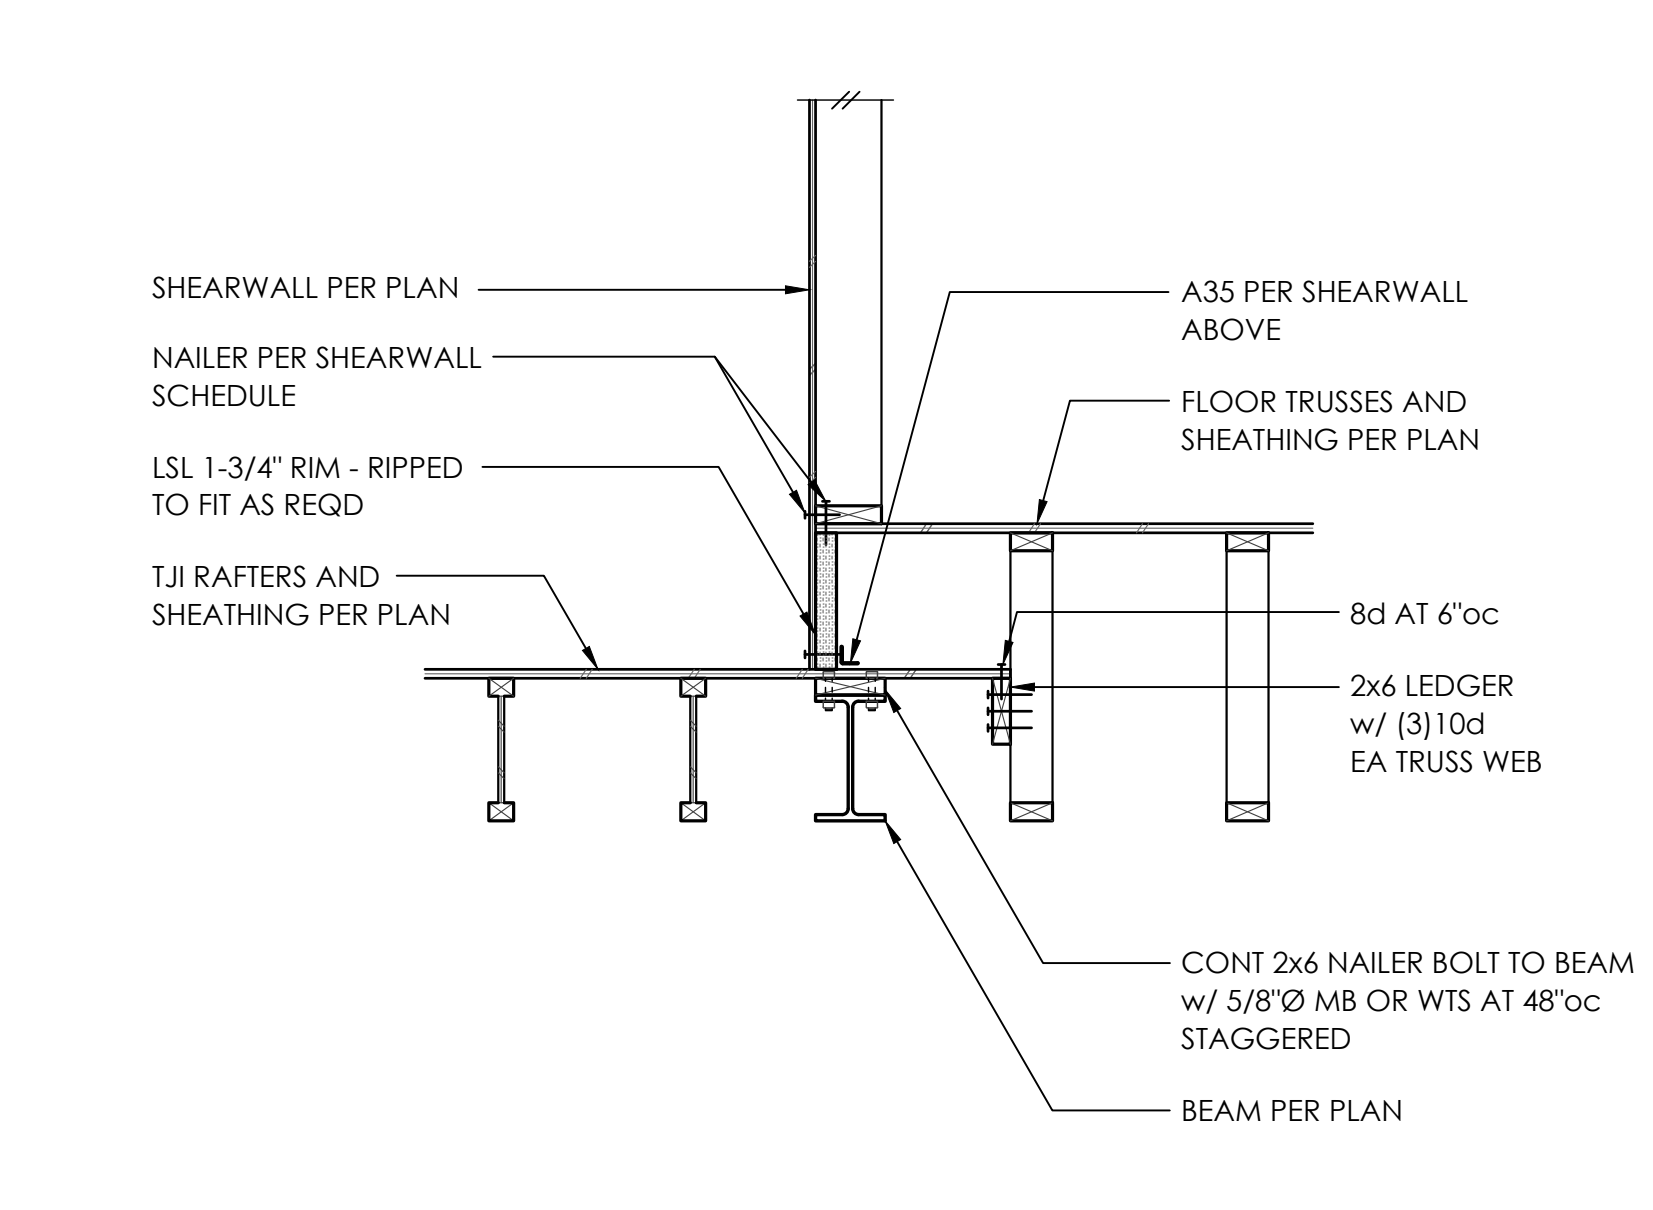


16

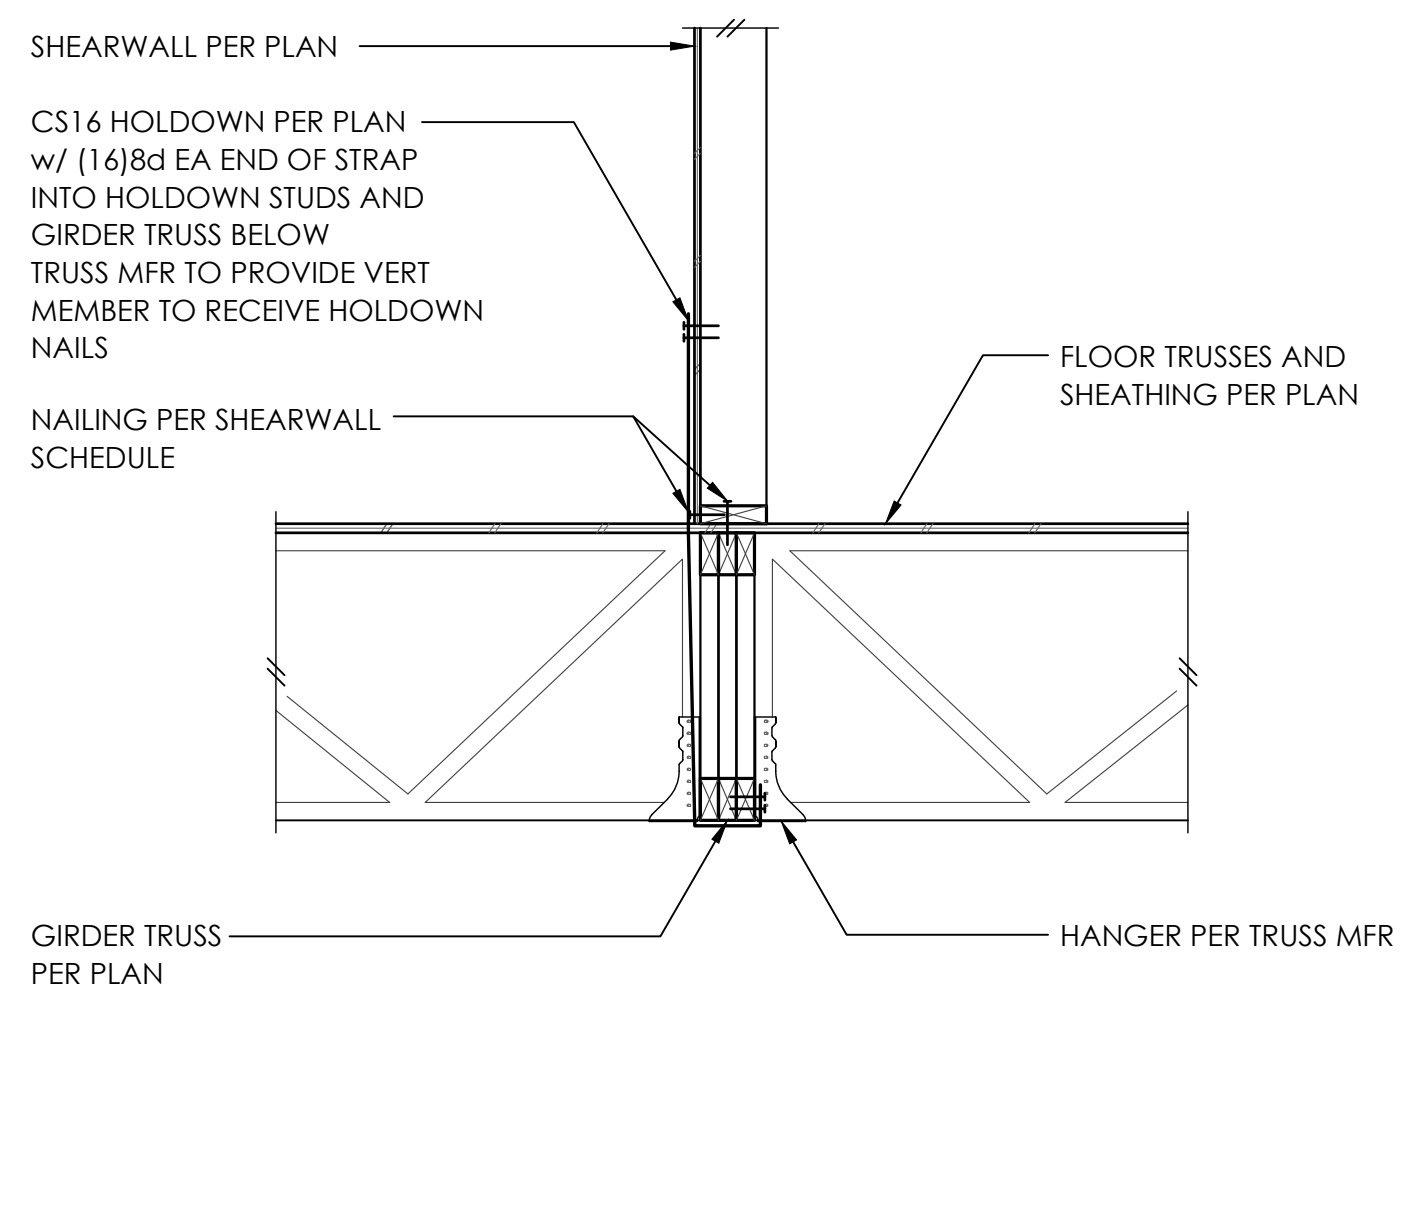


17

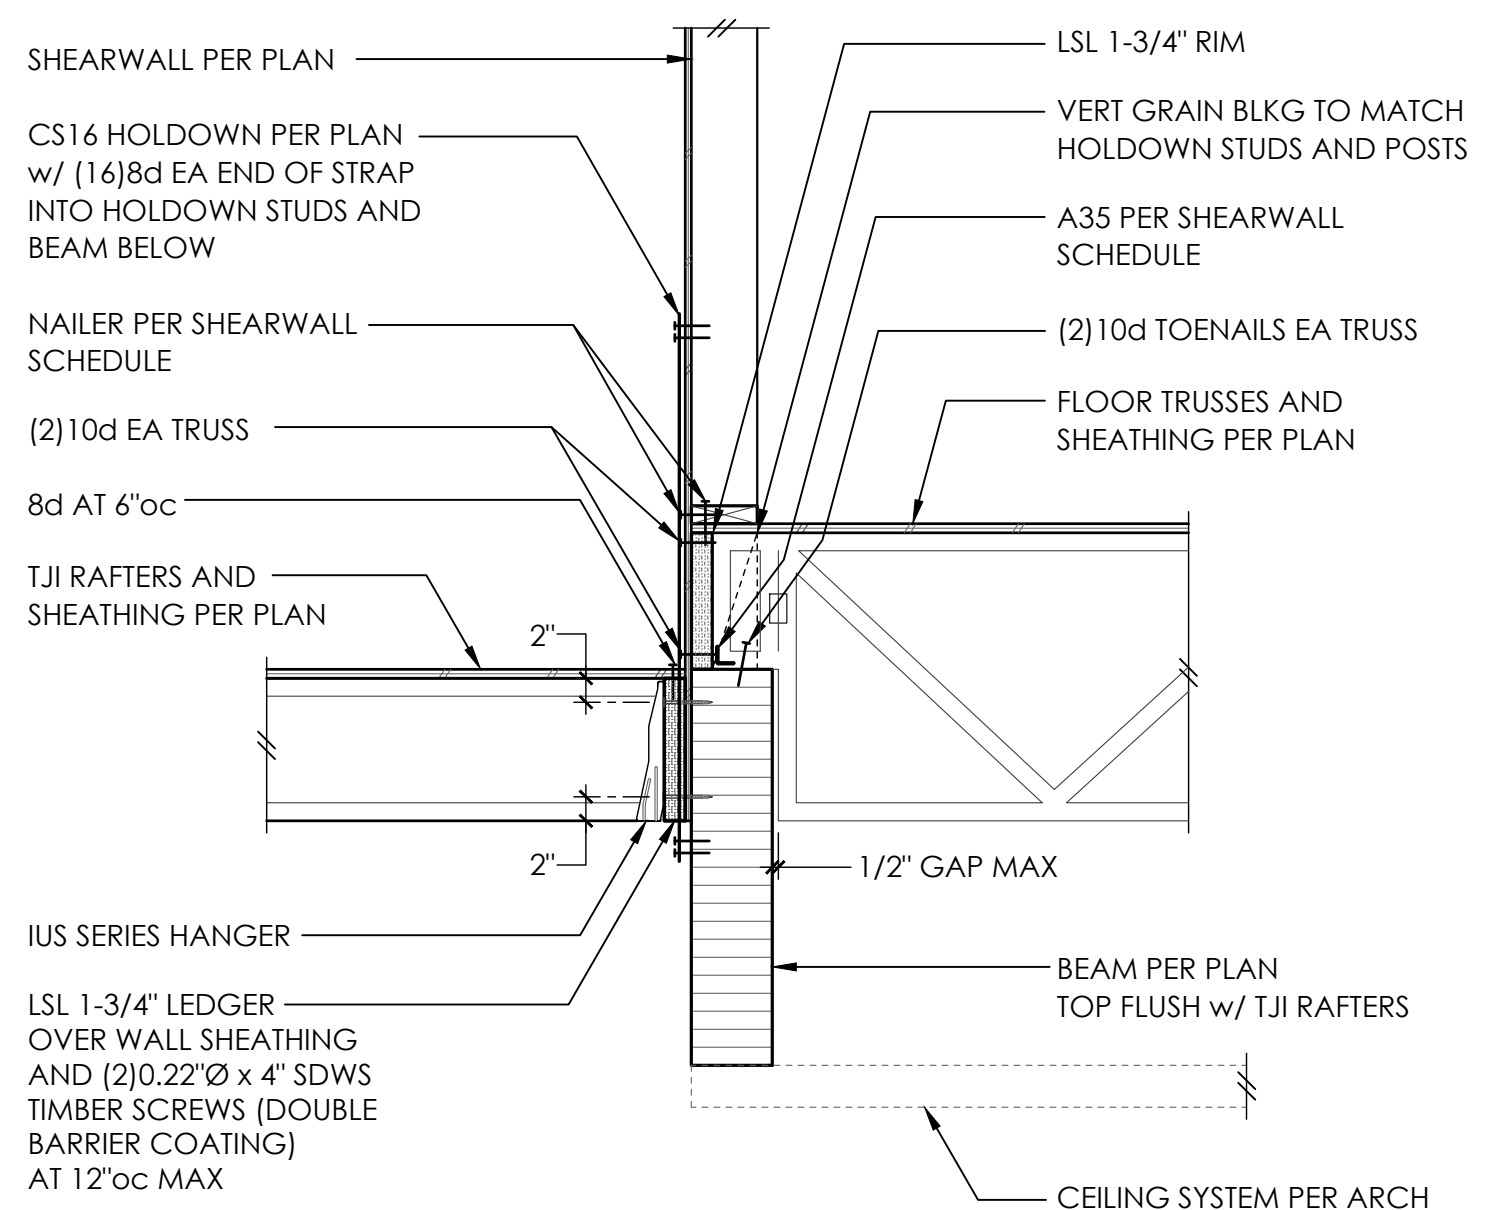


18

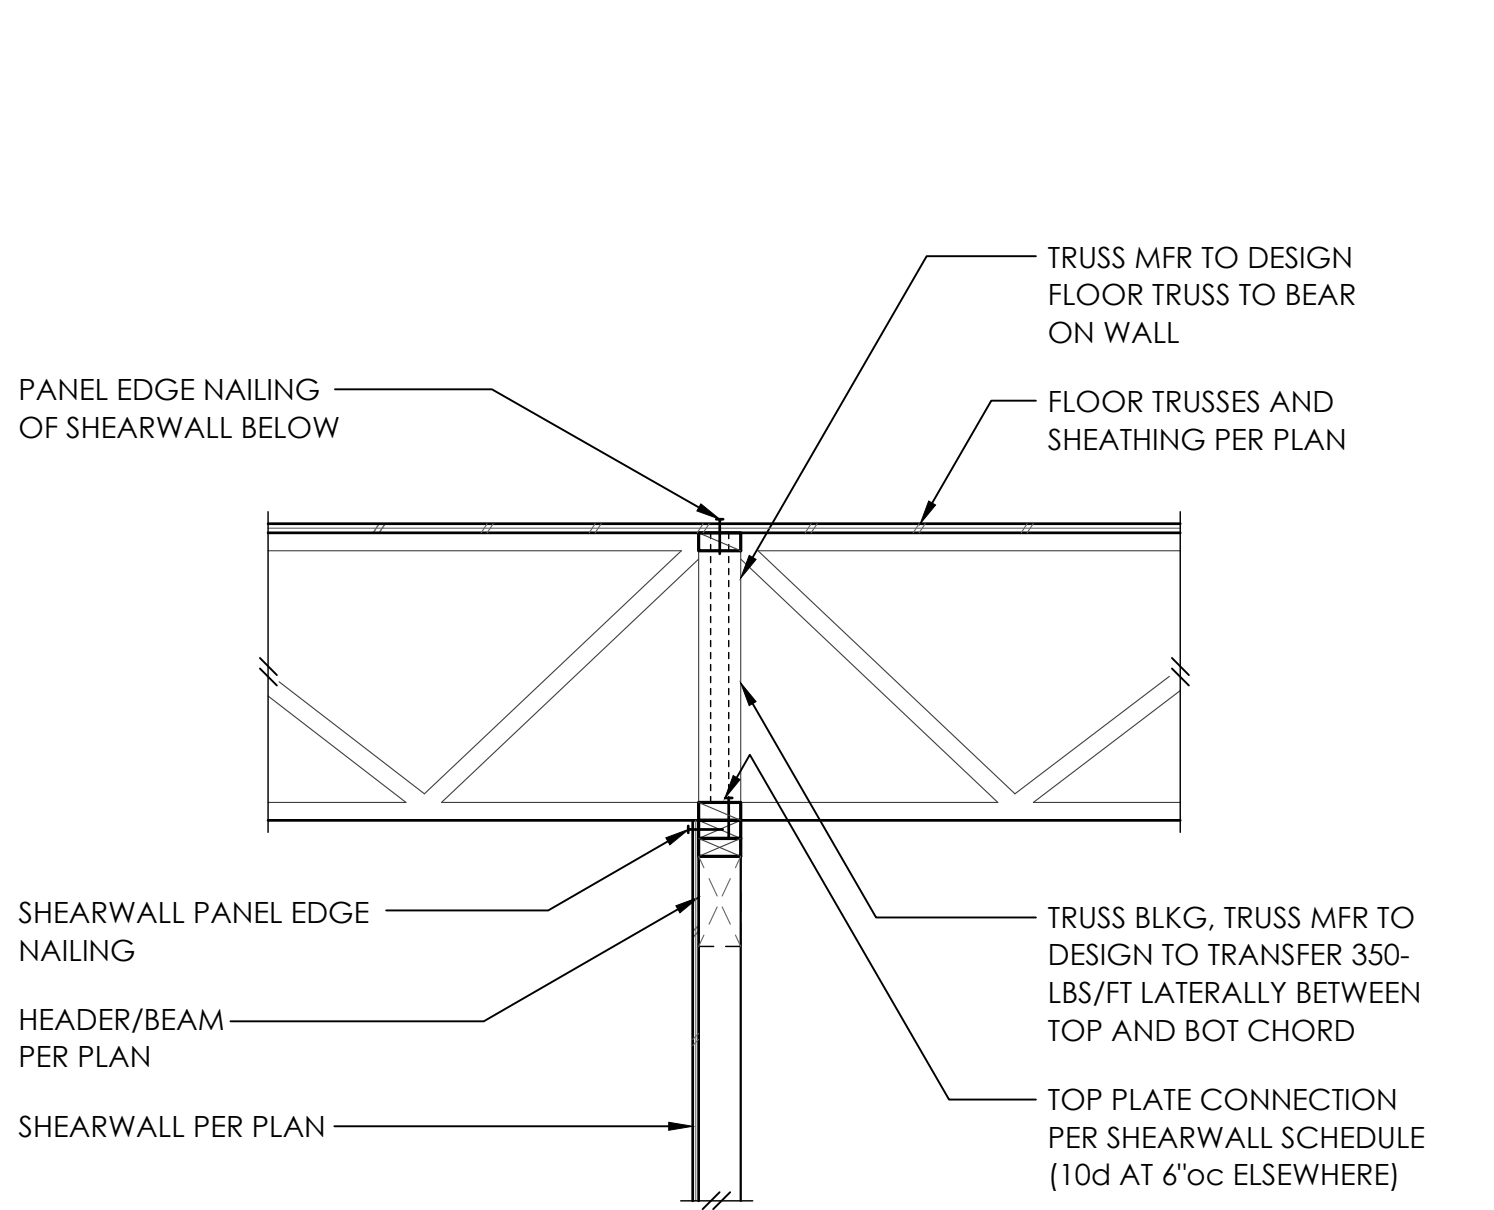

19

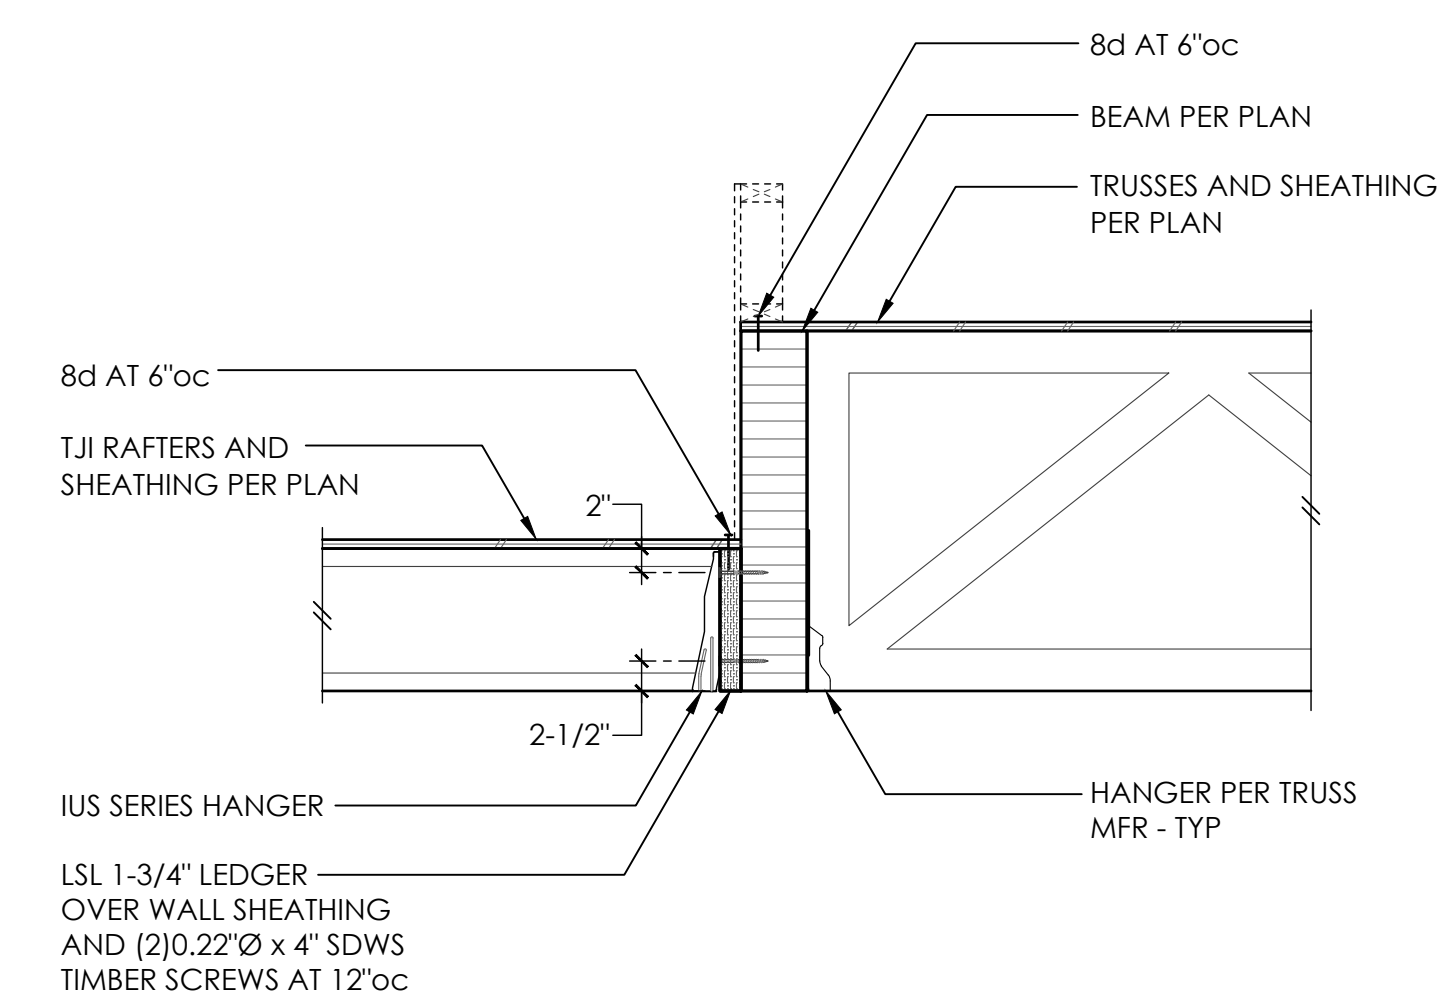


1

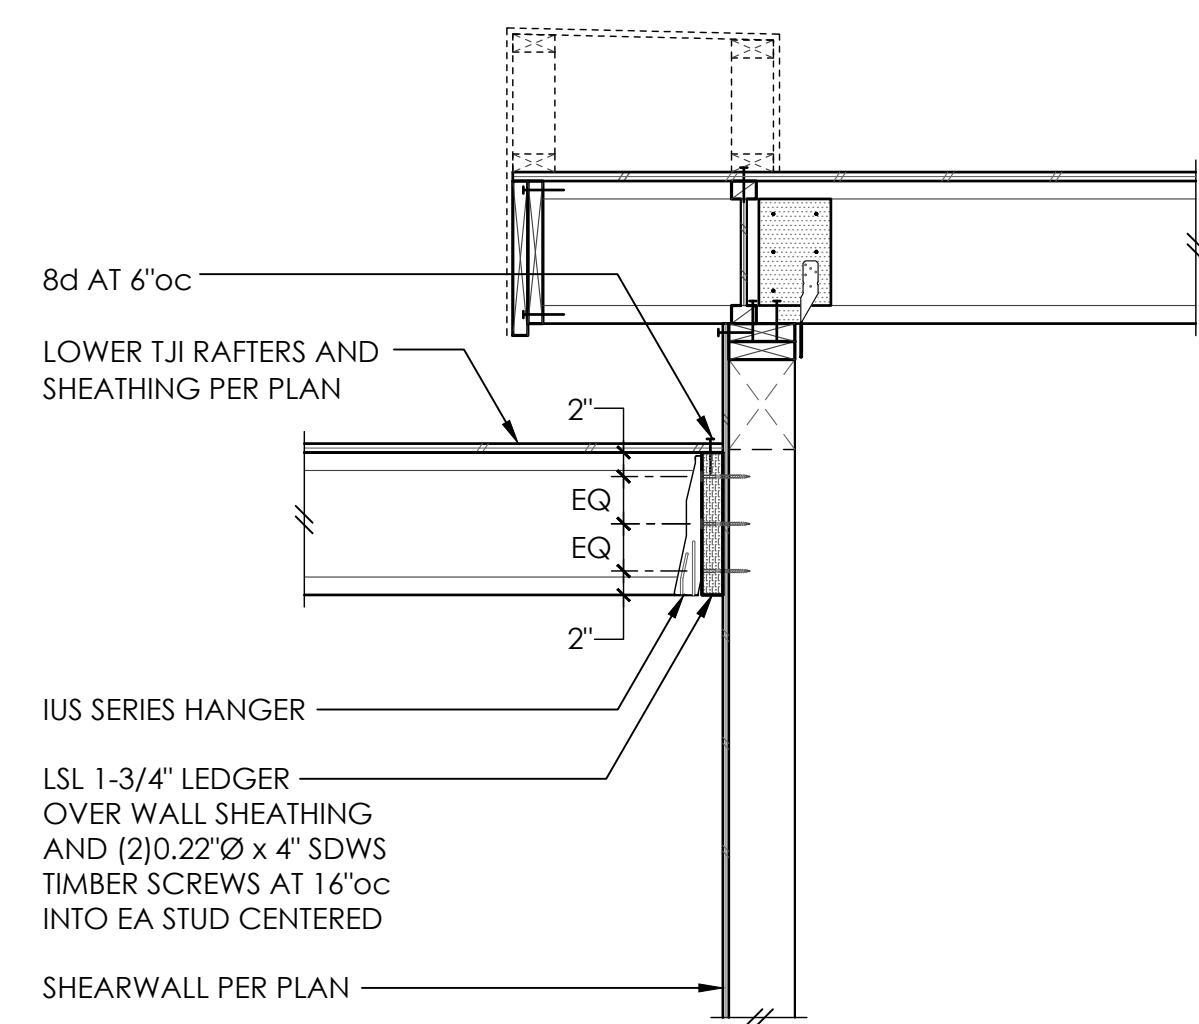


FOR CALLOUTS IN COMMON REFER 15/S4.2


2

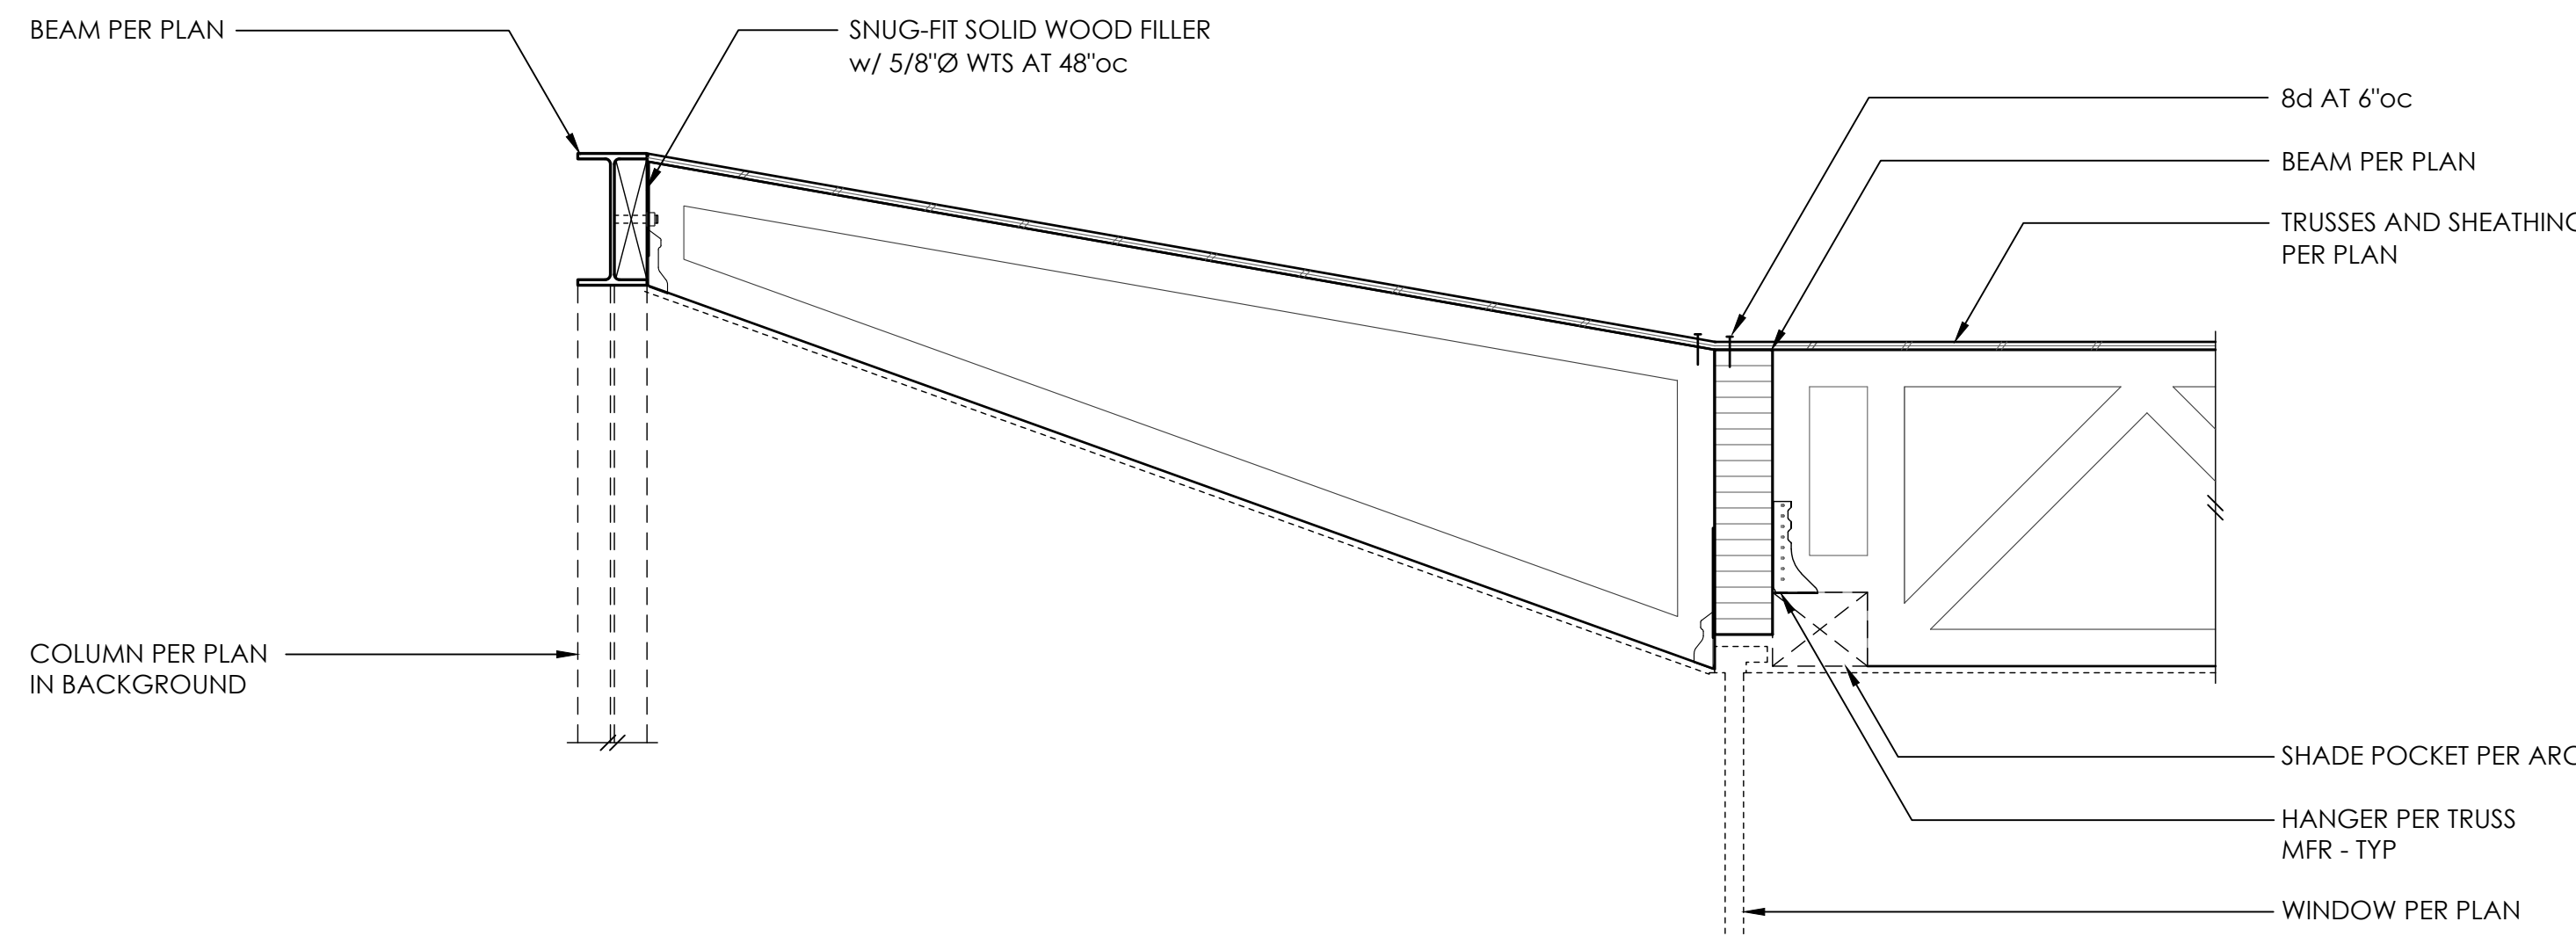


4

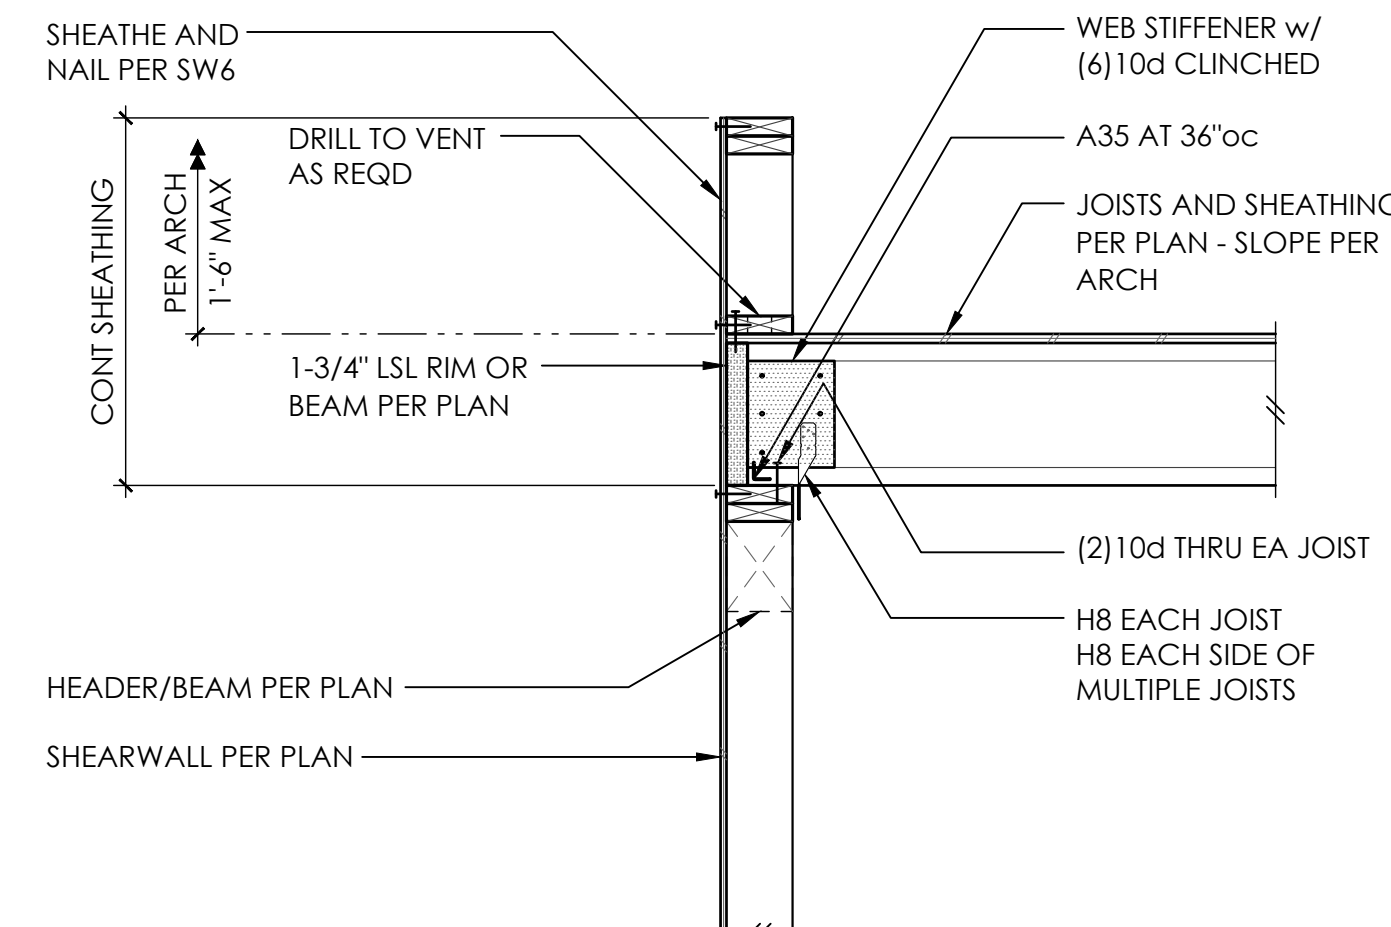


5

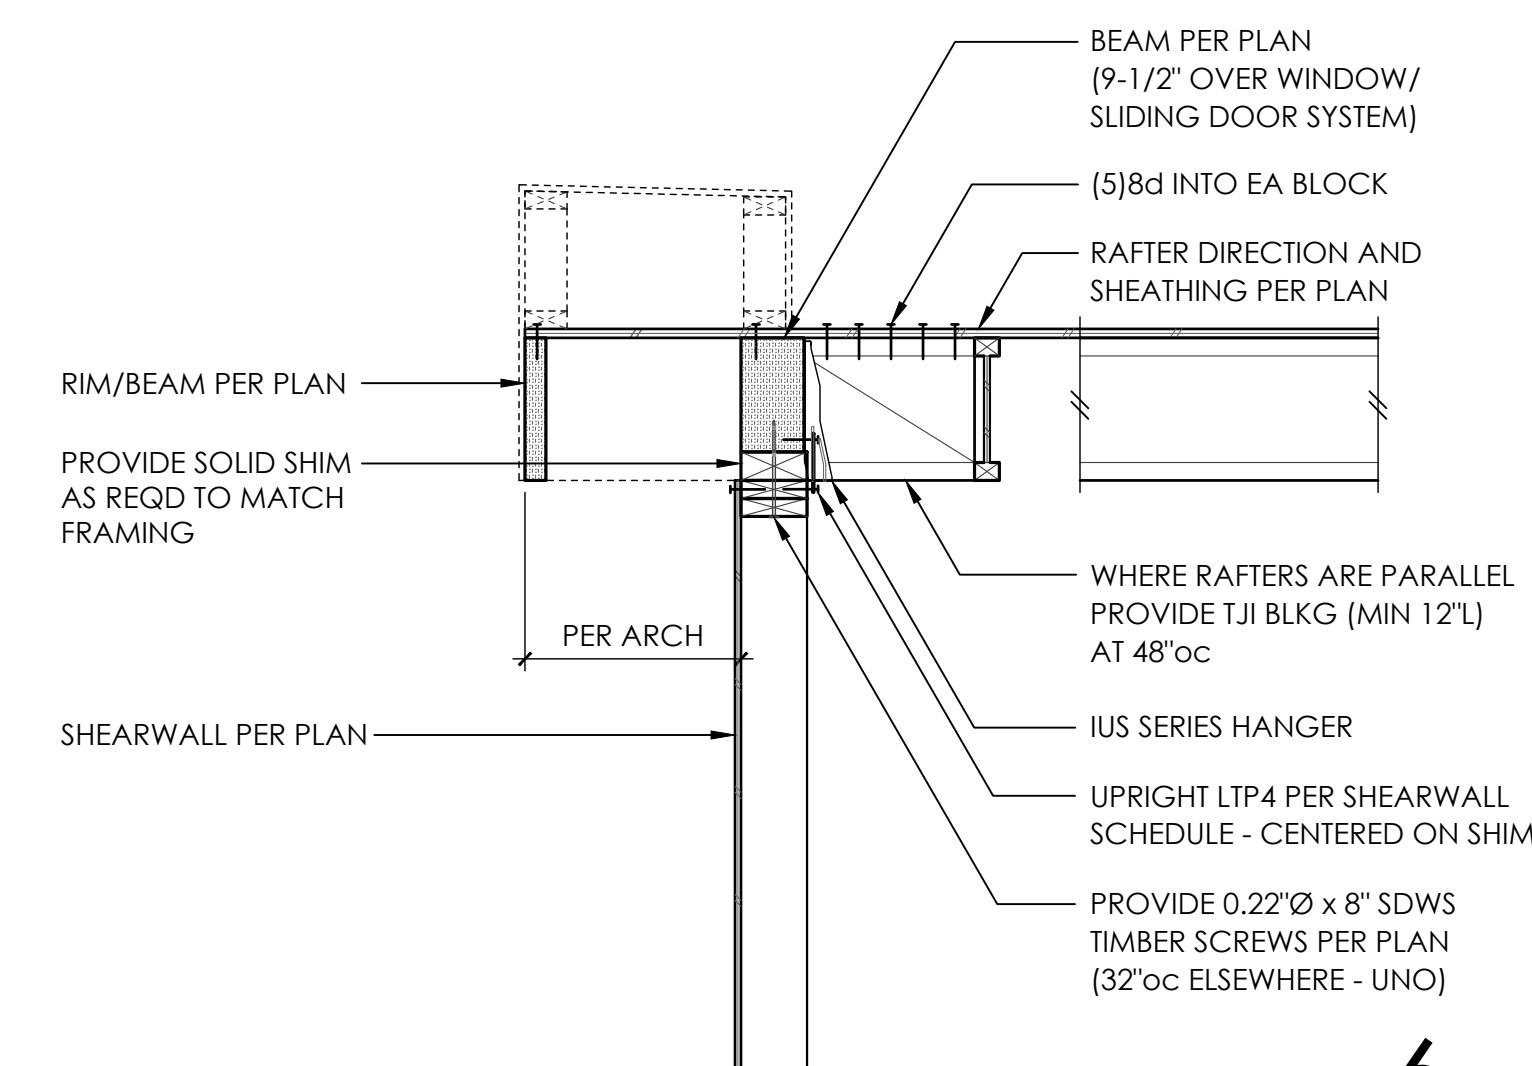


6

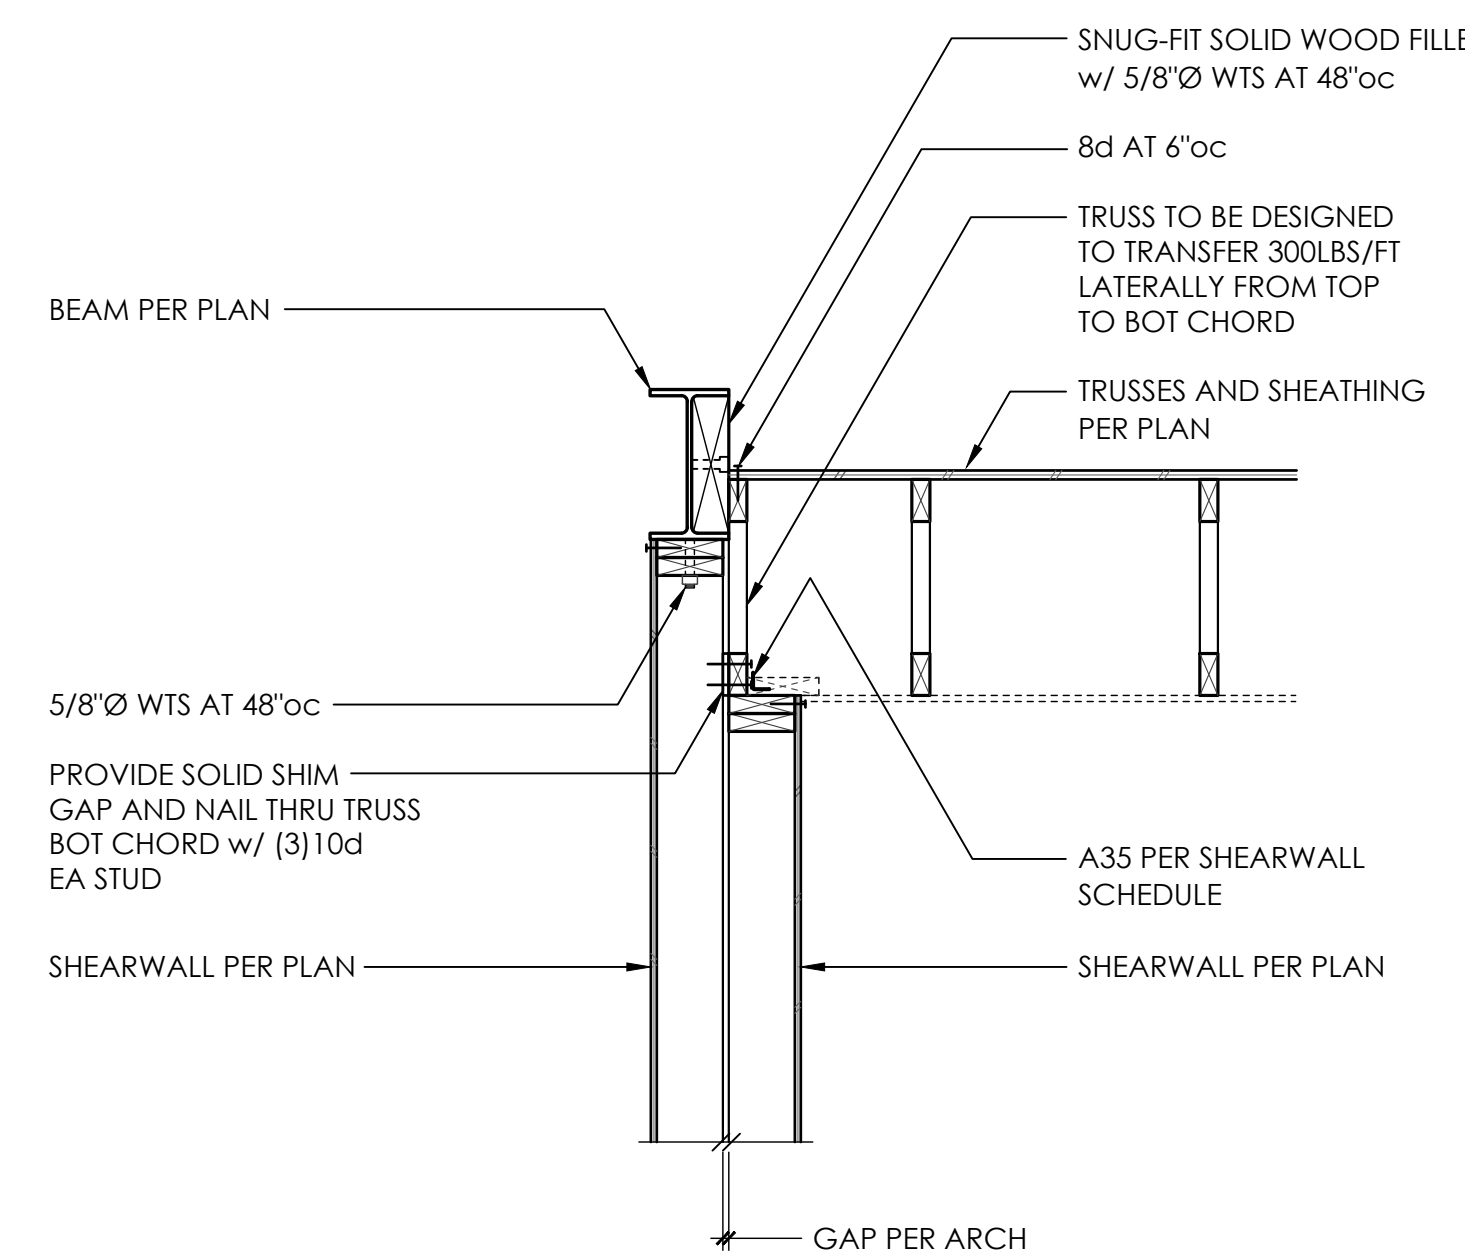


7

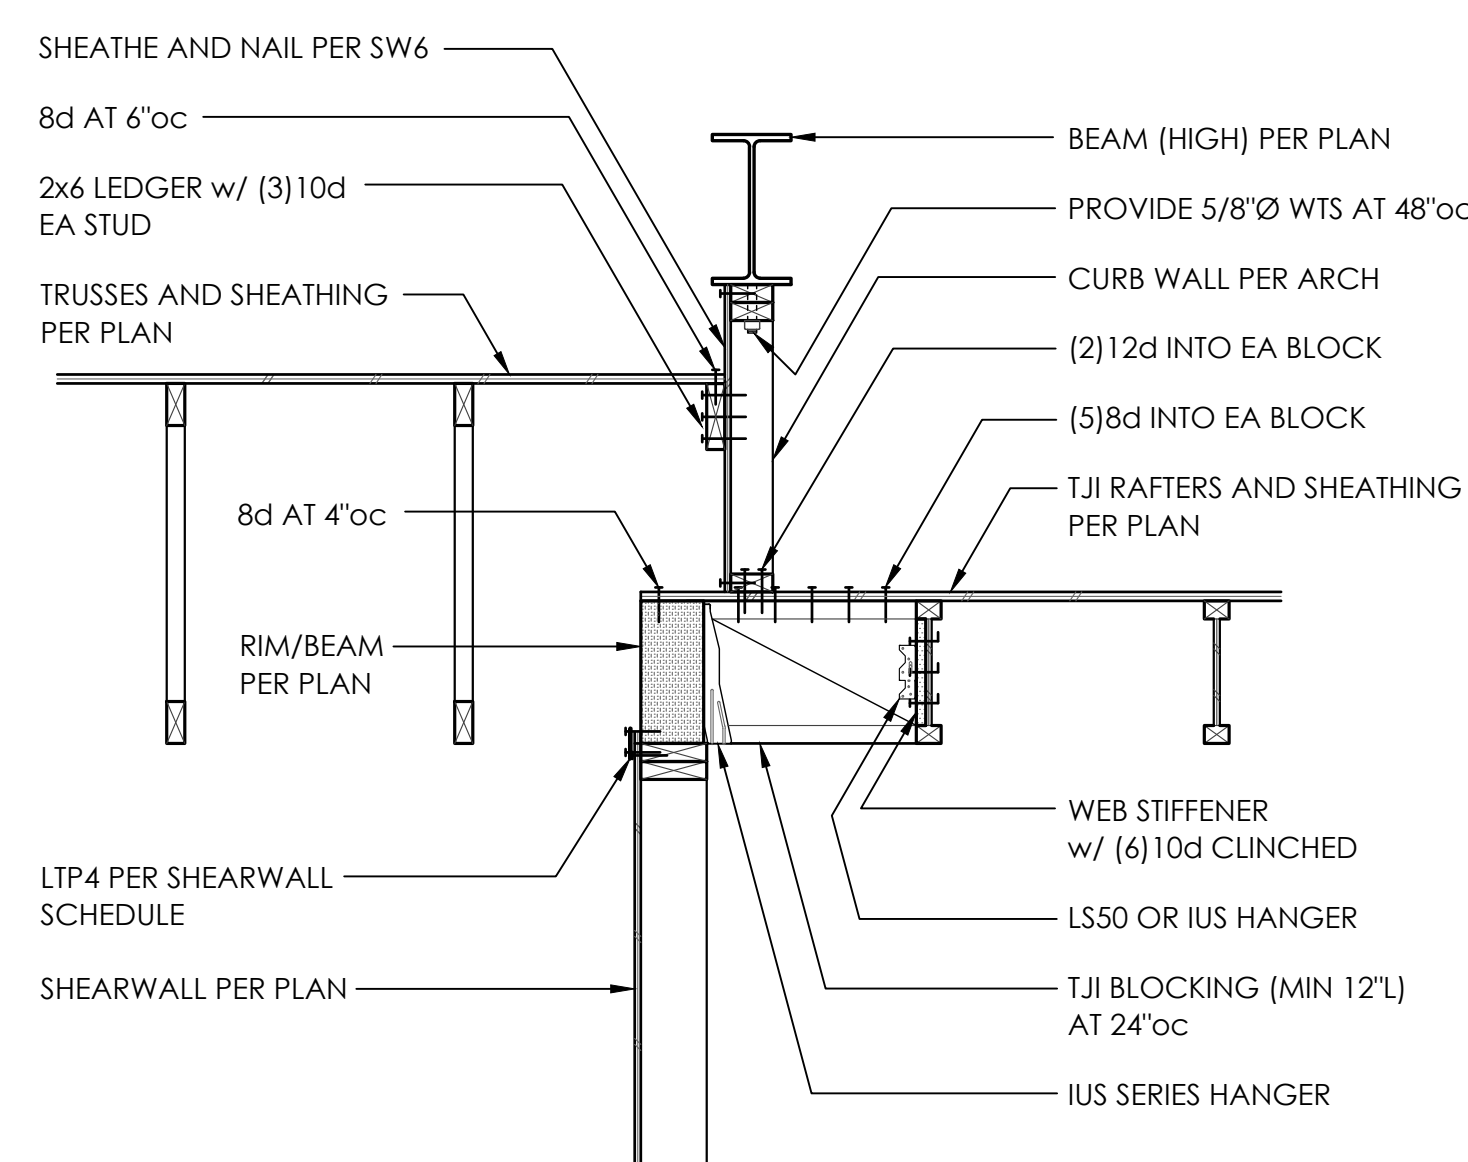


8

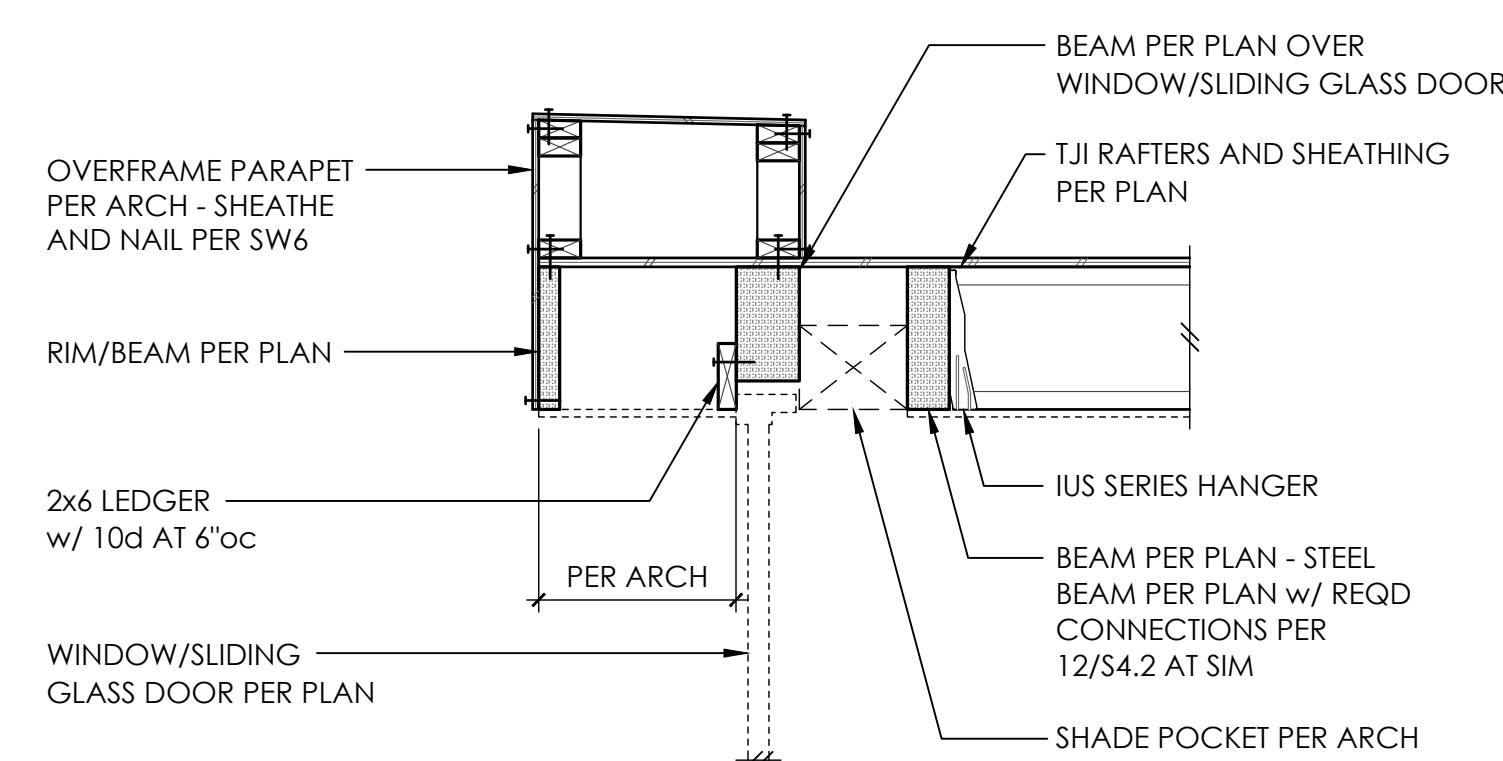

9

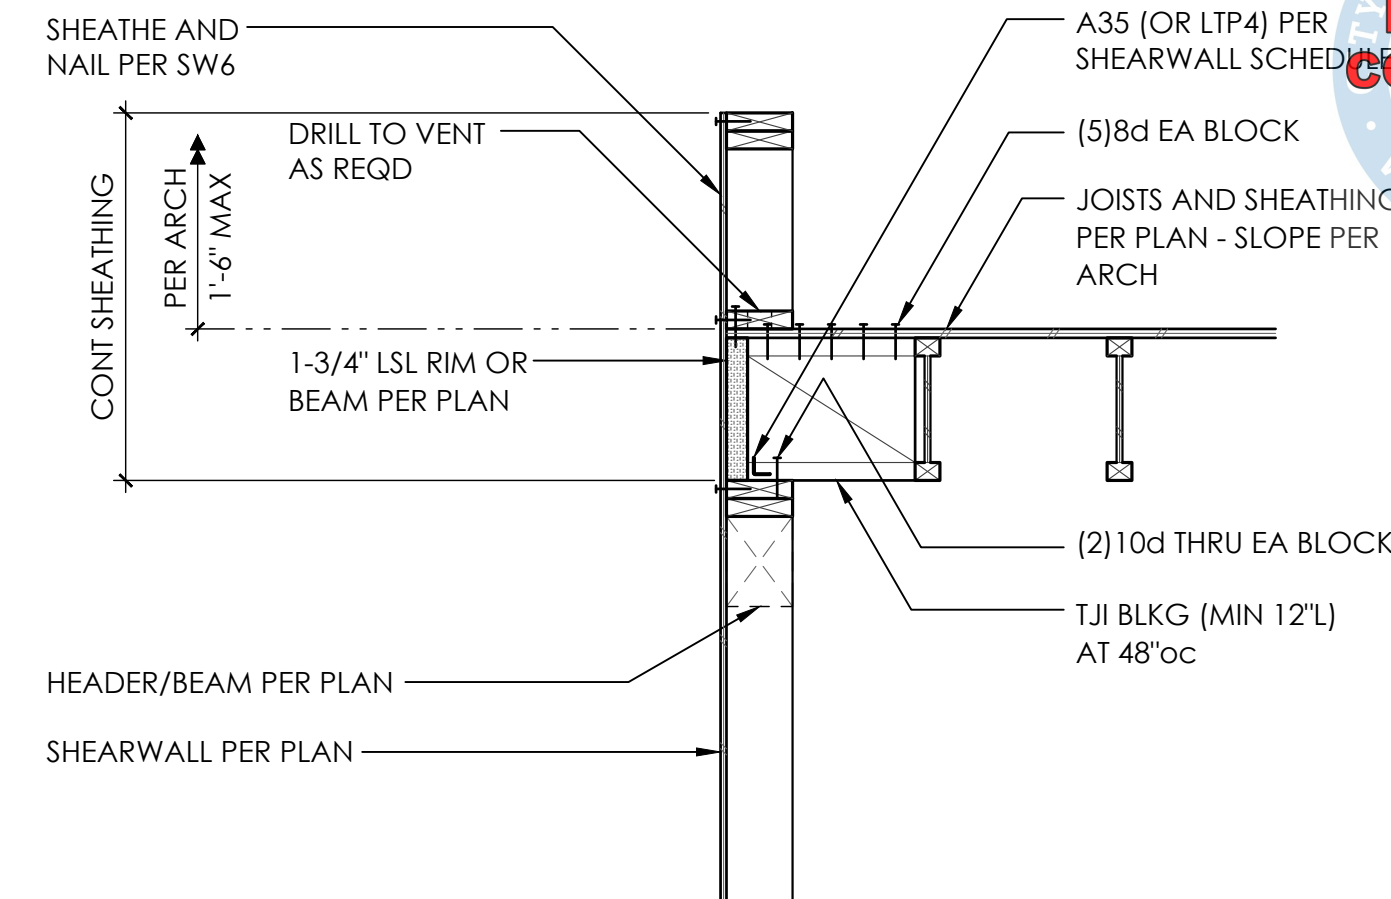


10

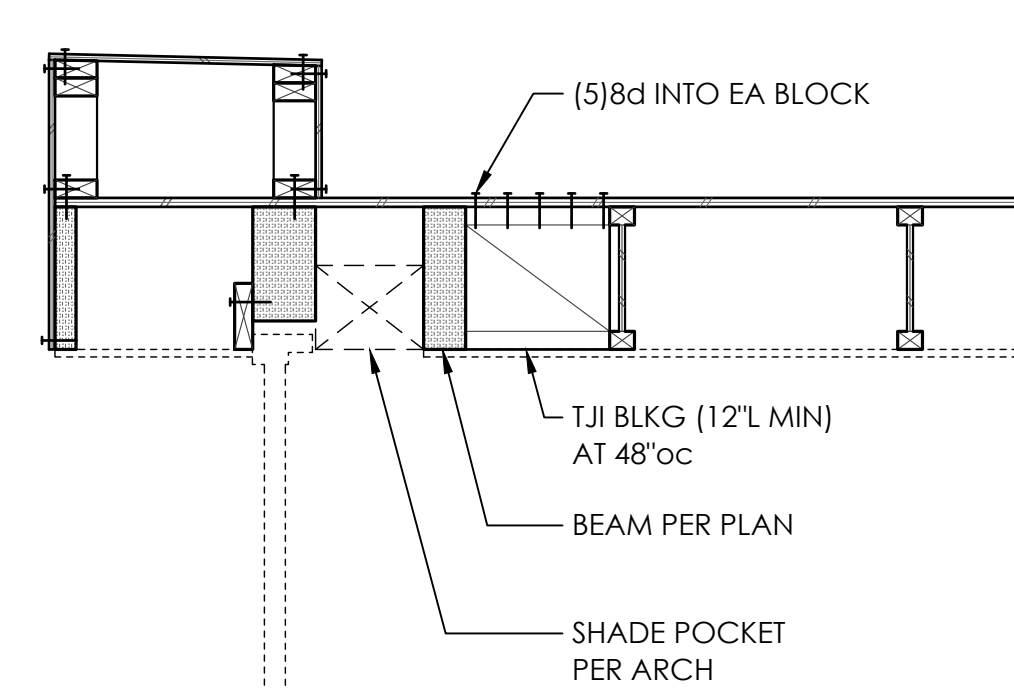


FOR CALLOUTS IN COMMON REFER 9/S4.2


11

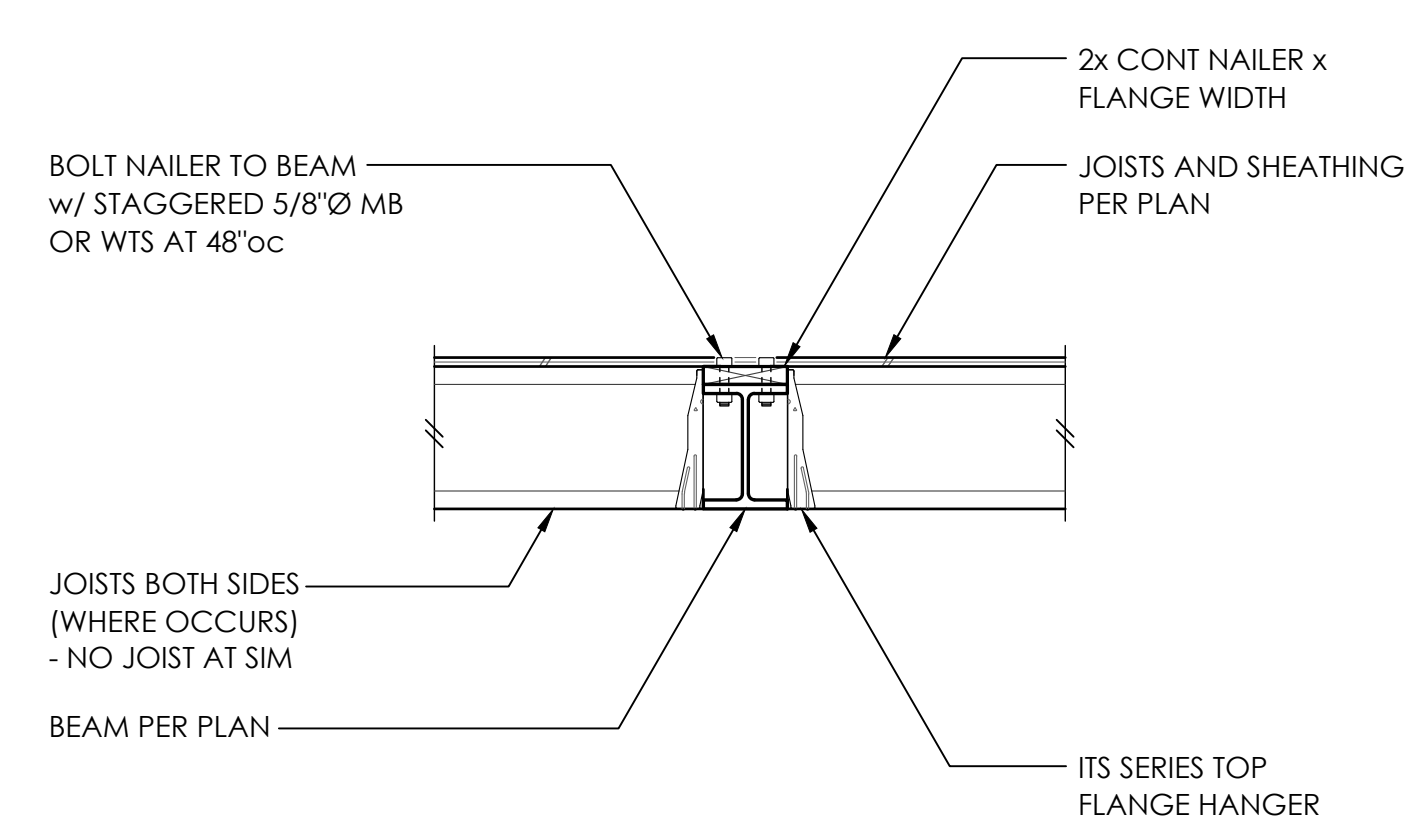

12

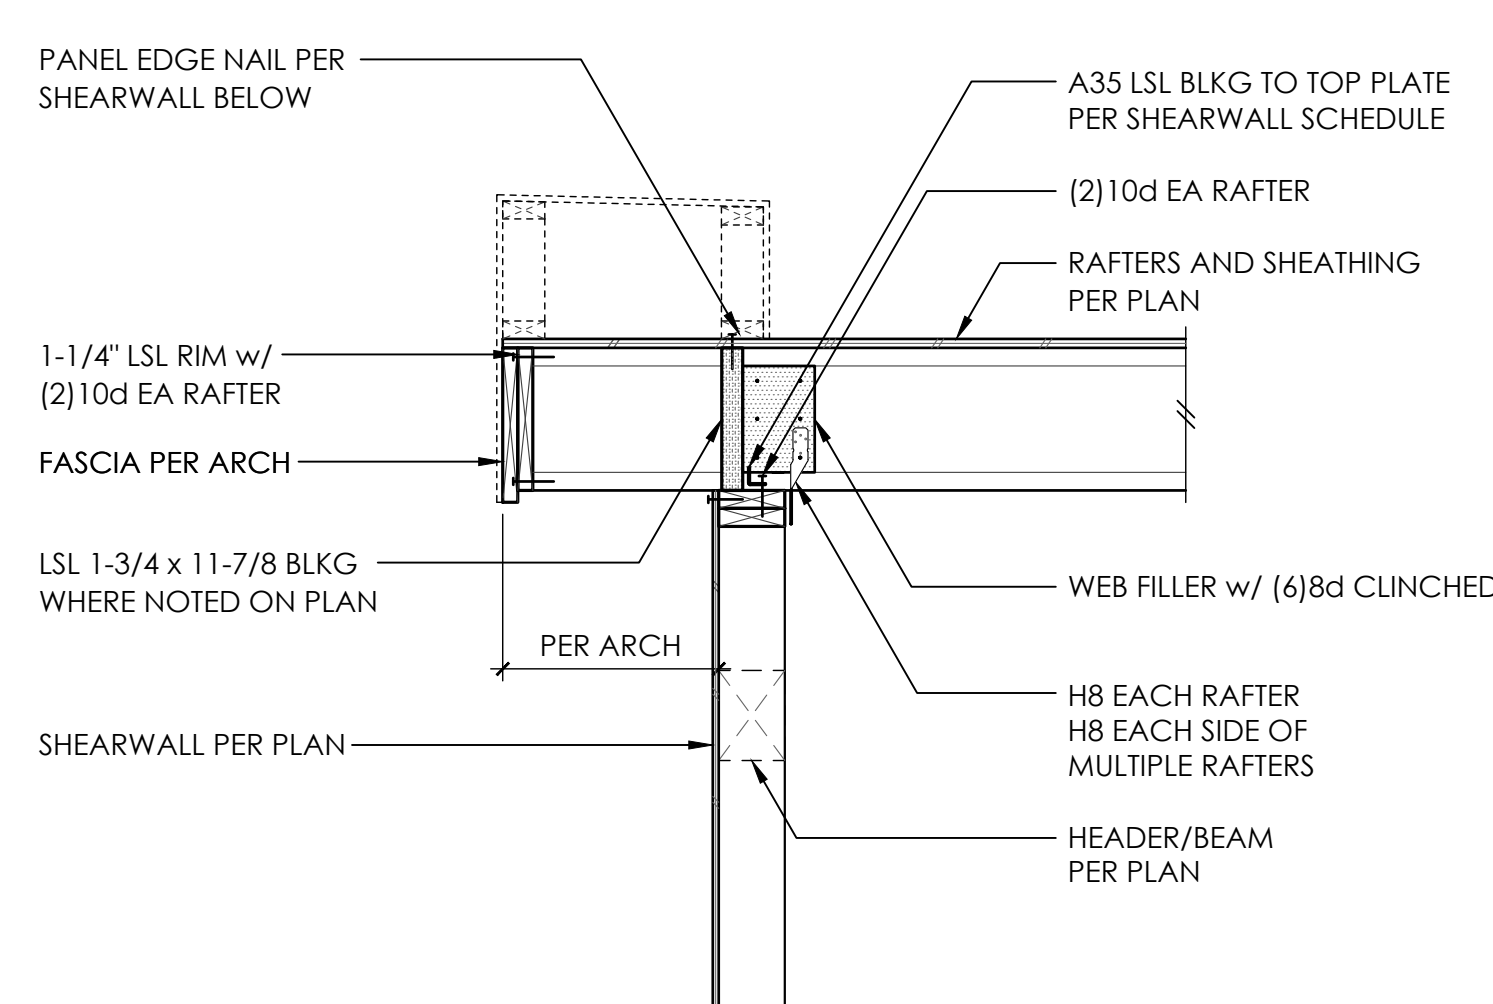


13

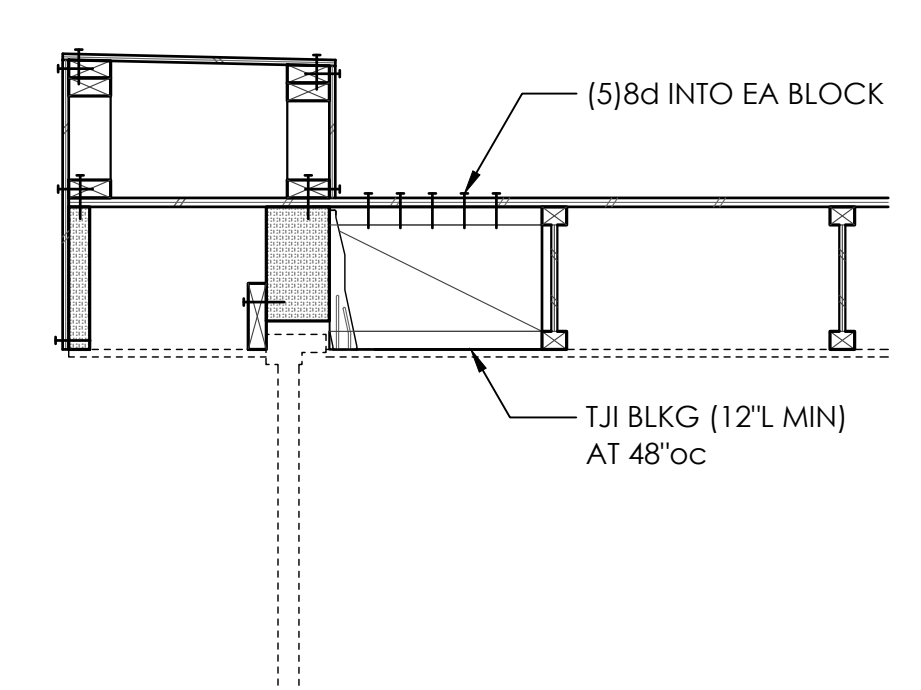


FOR CALLOUTS IN COMMON REFER 9/S4.2


14

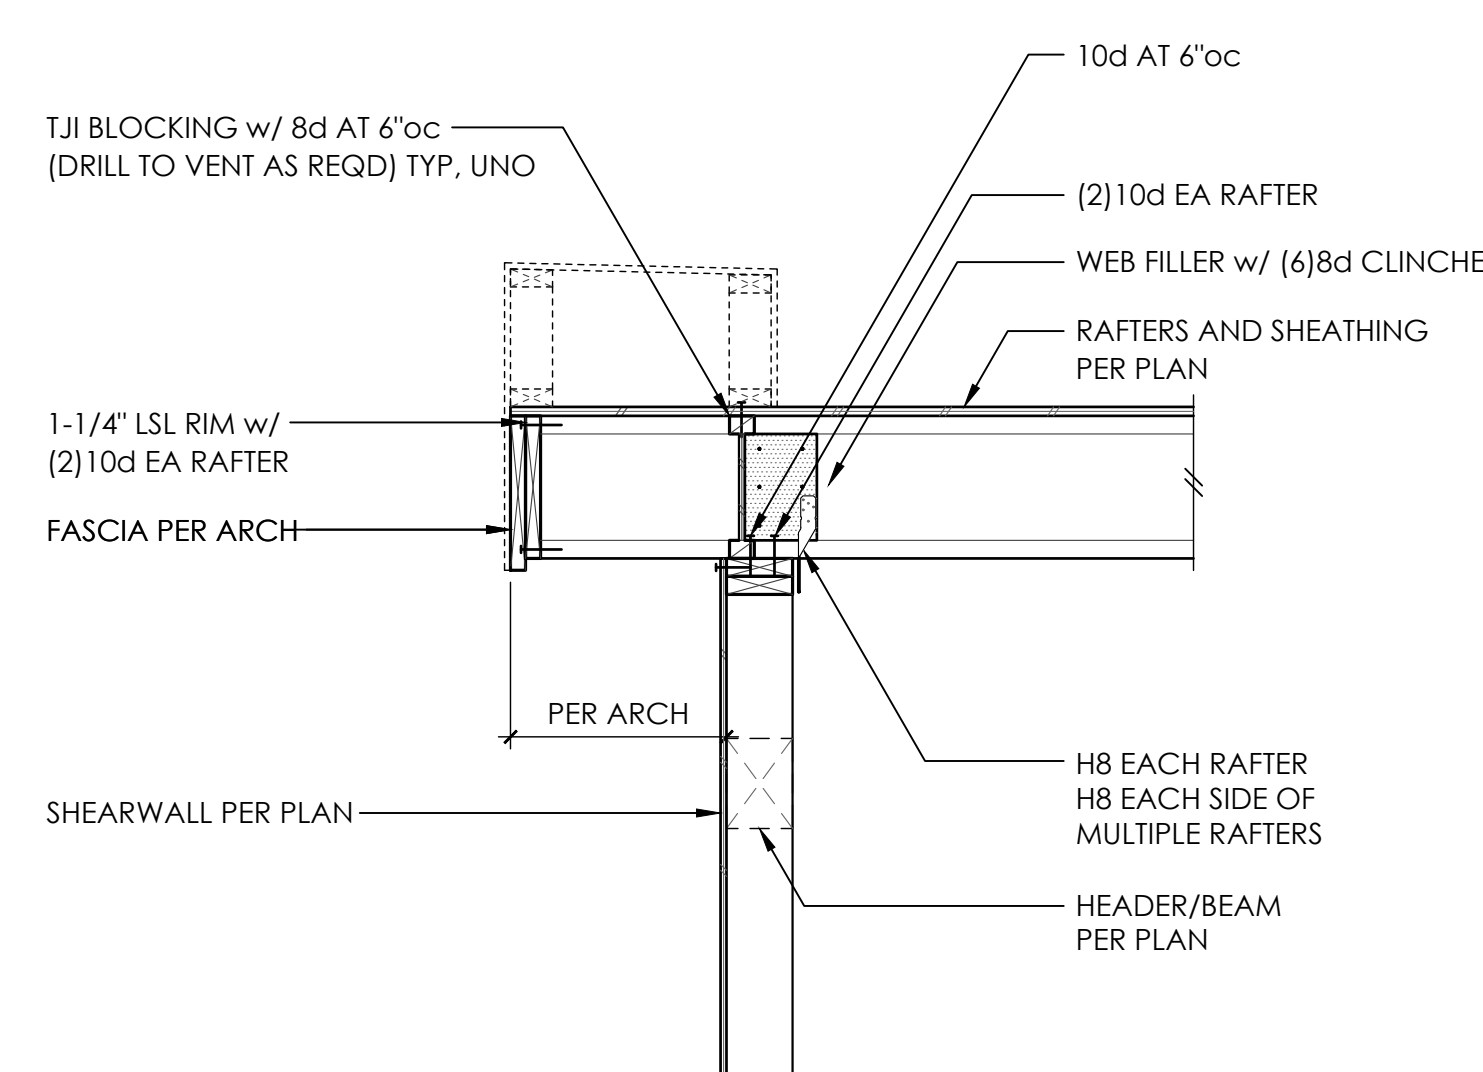


15

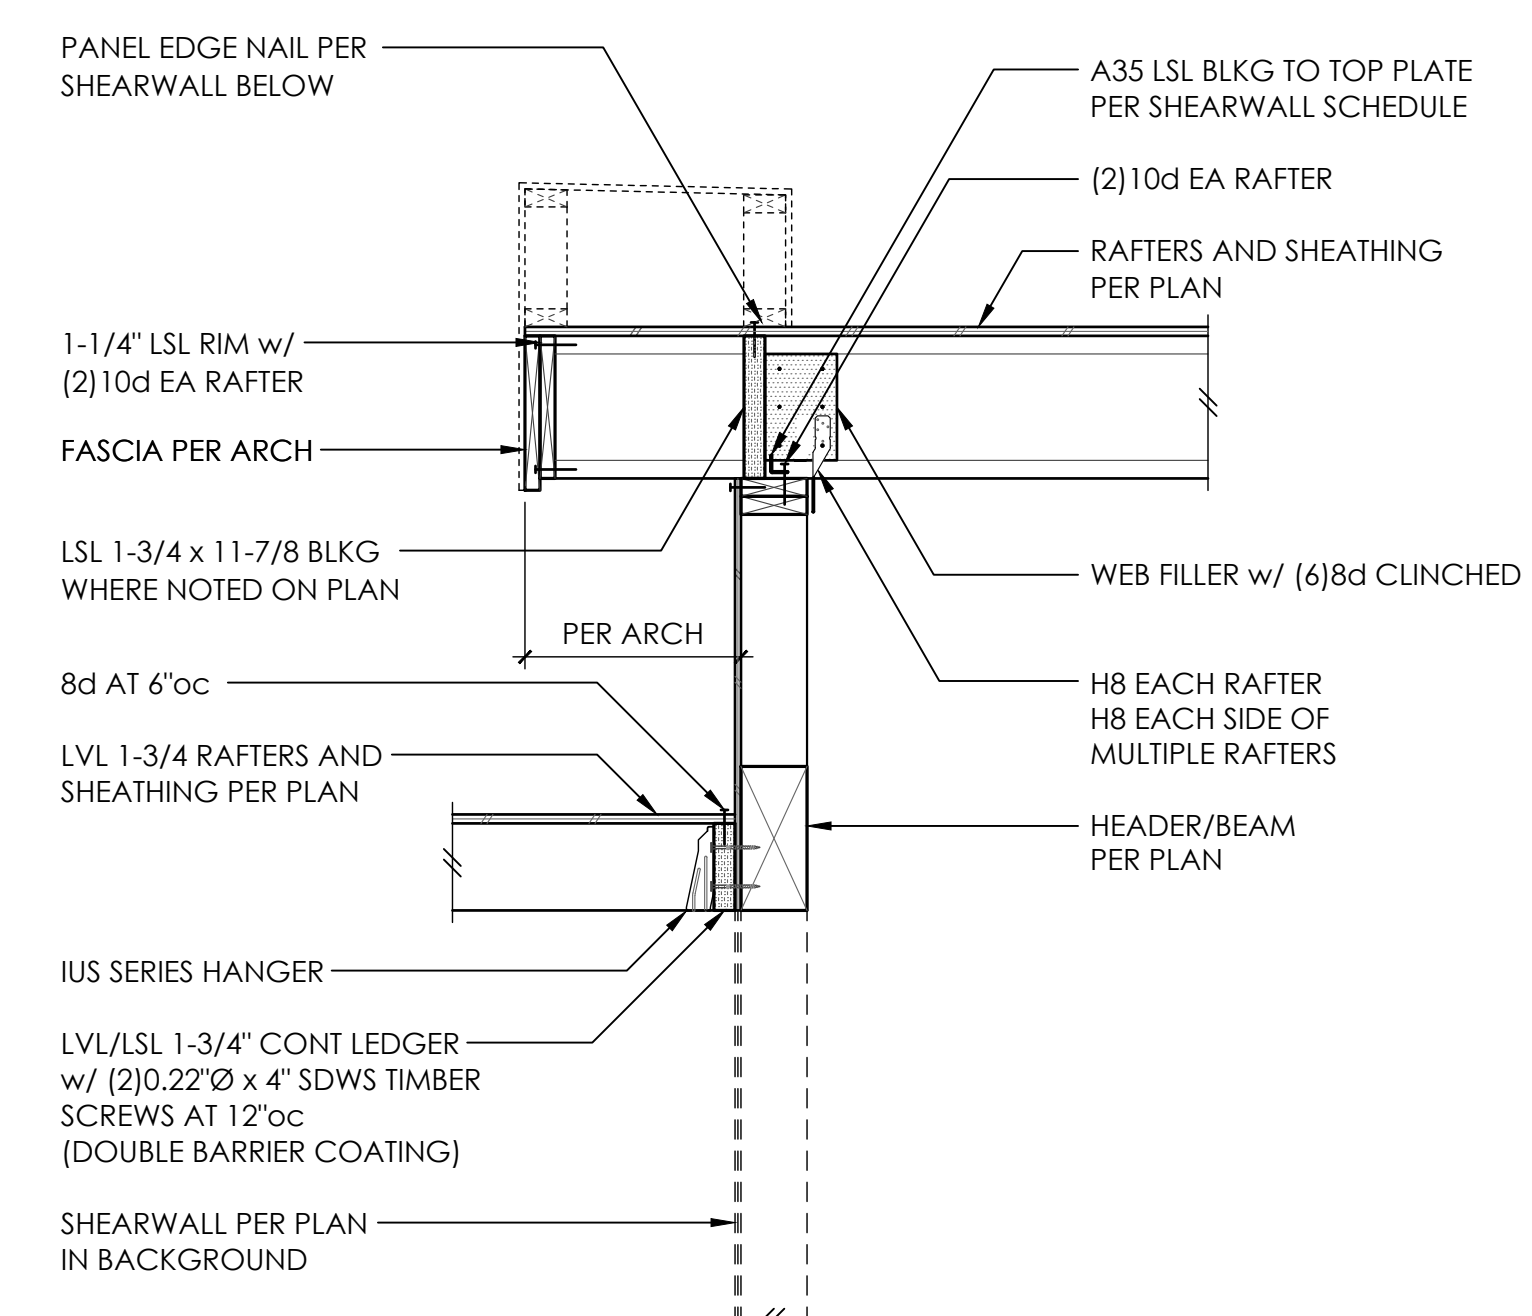


16

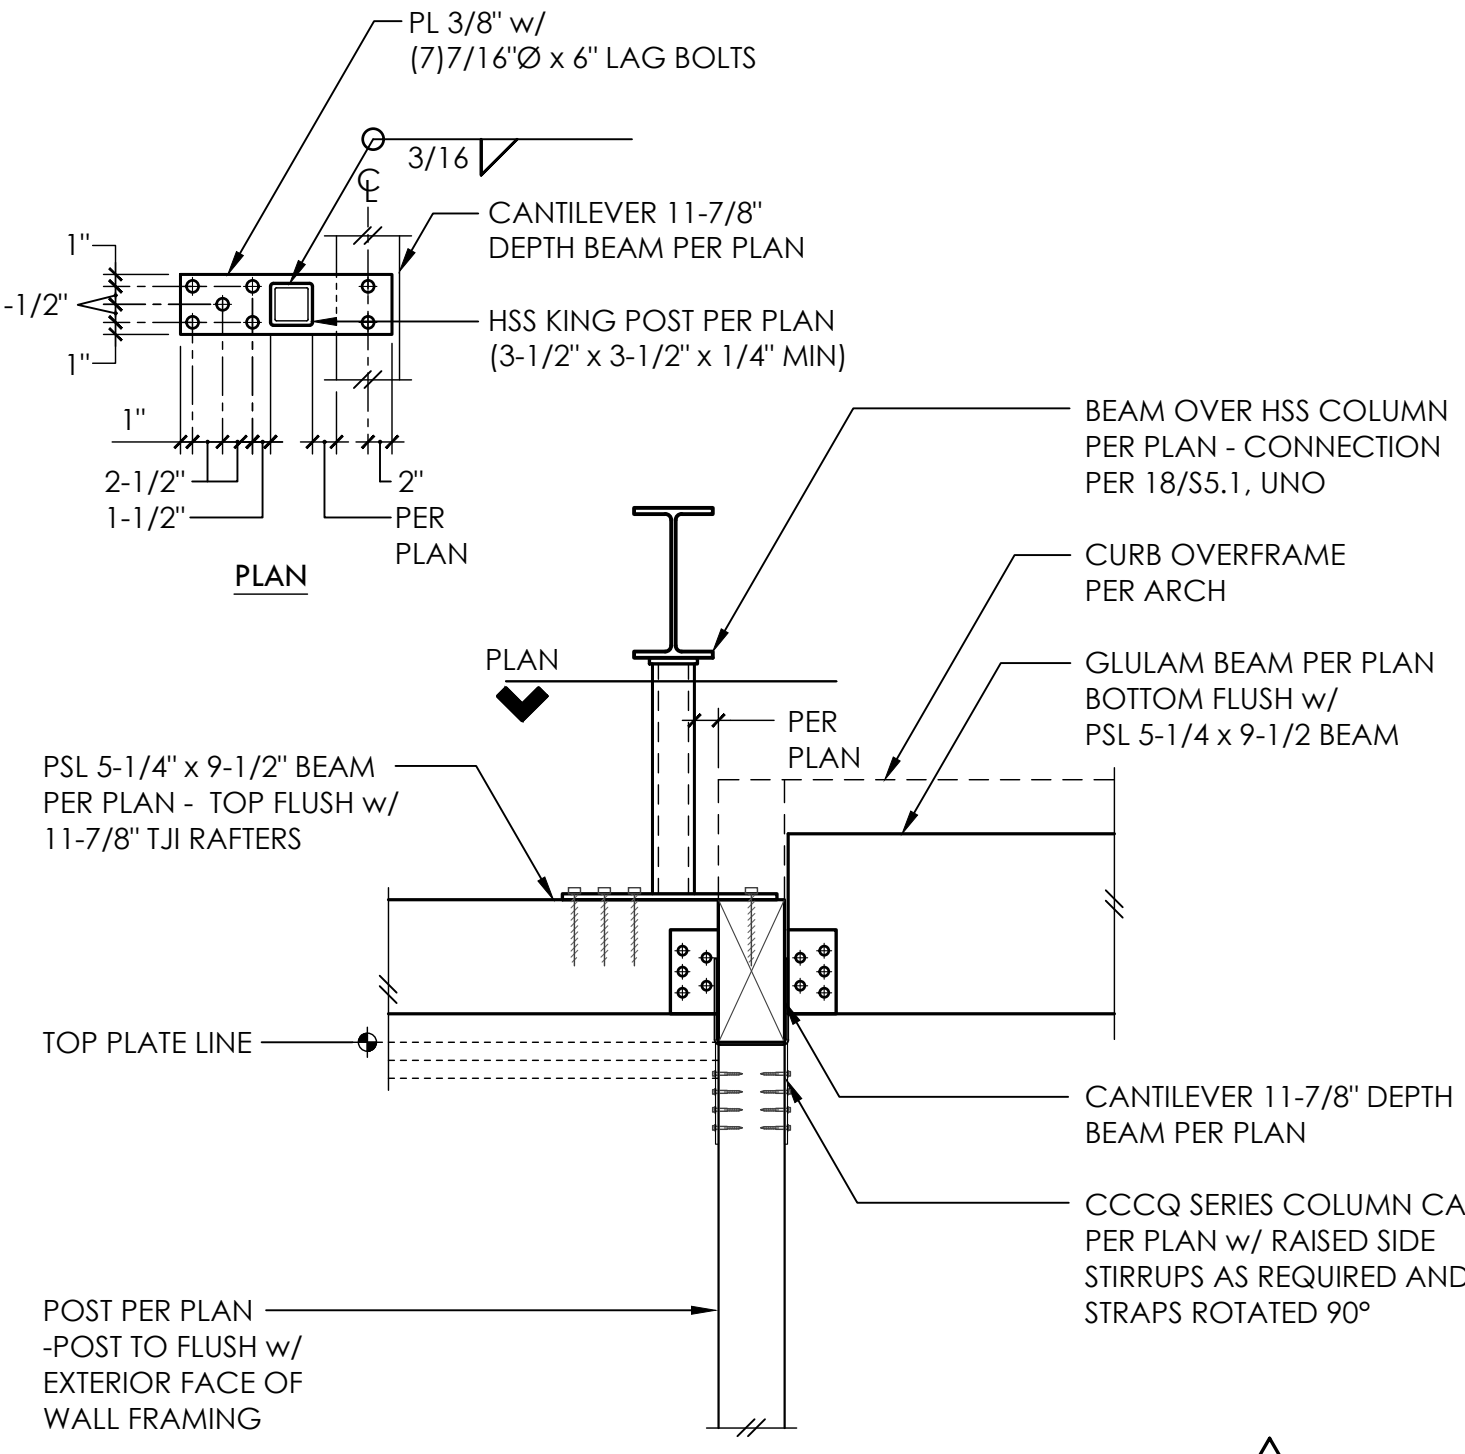


17

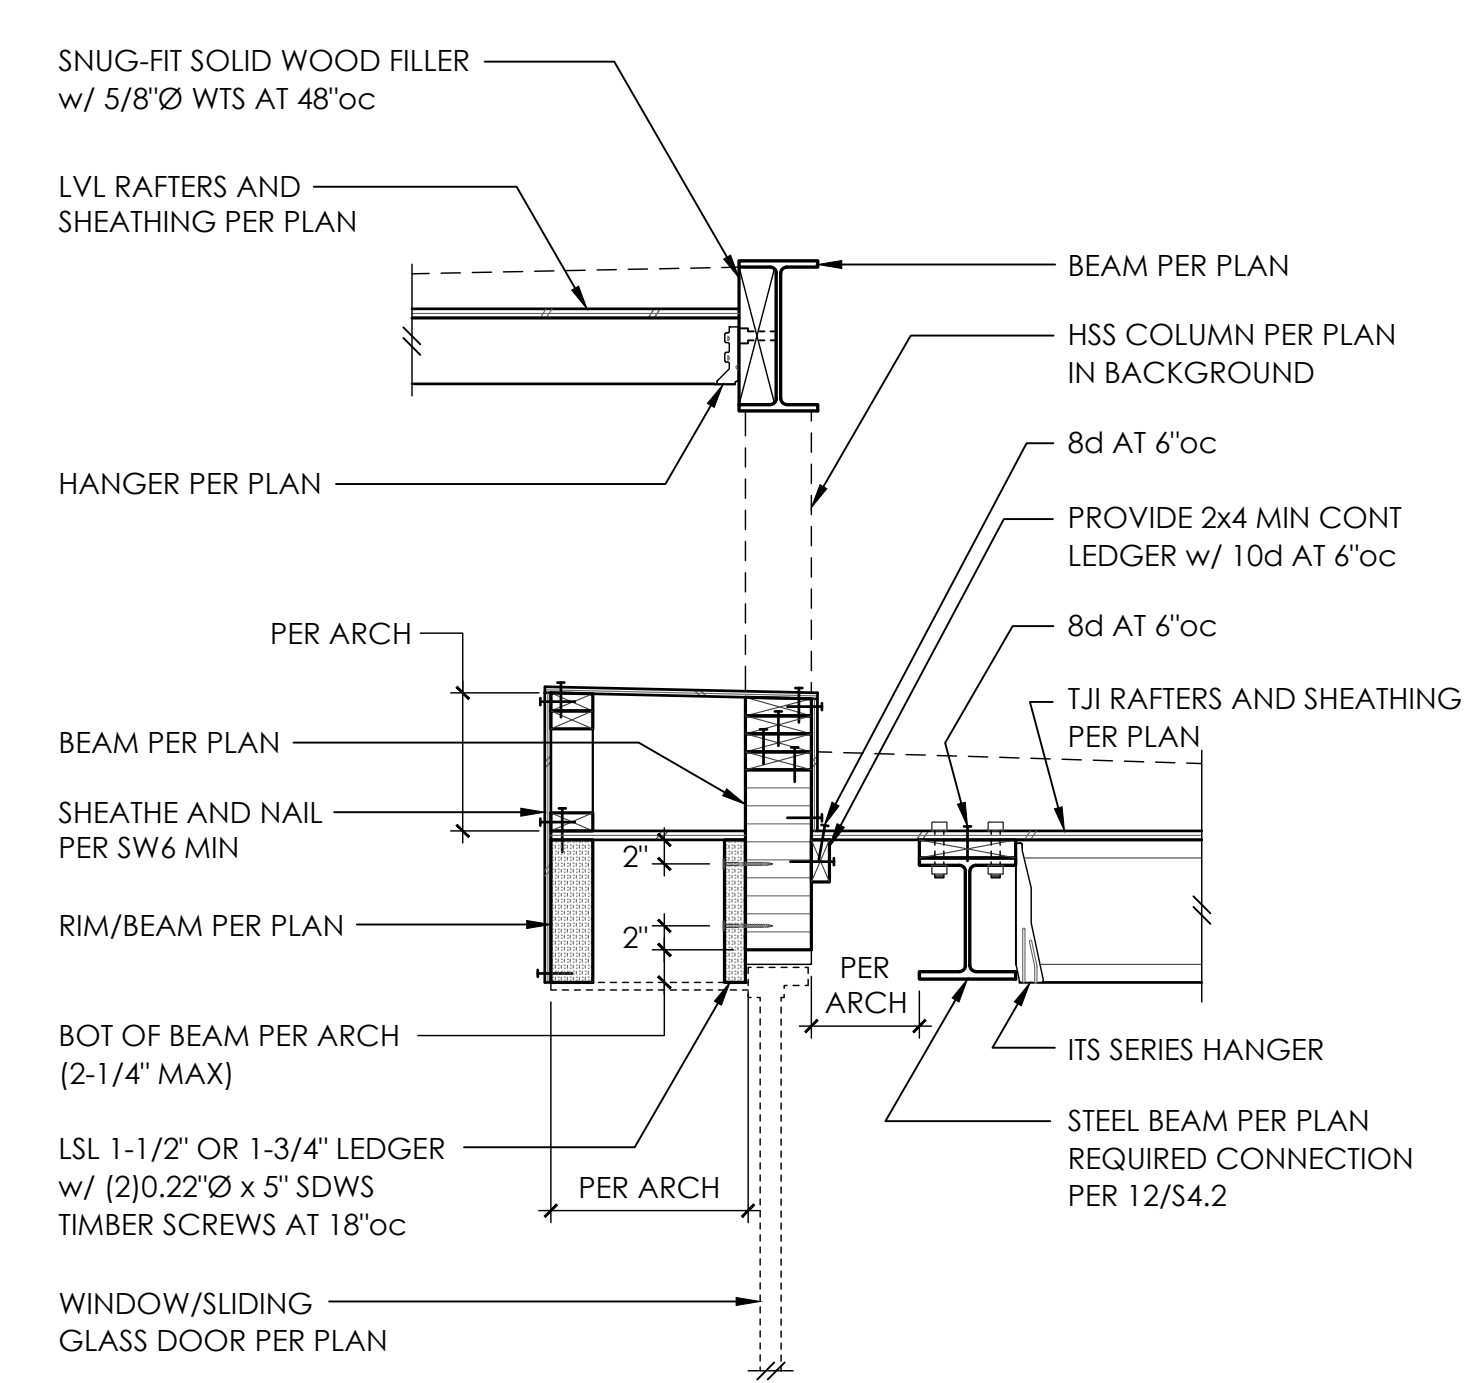


18

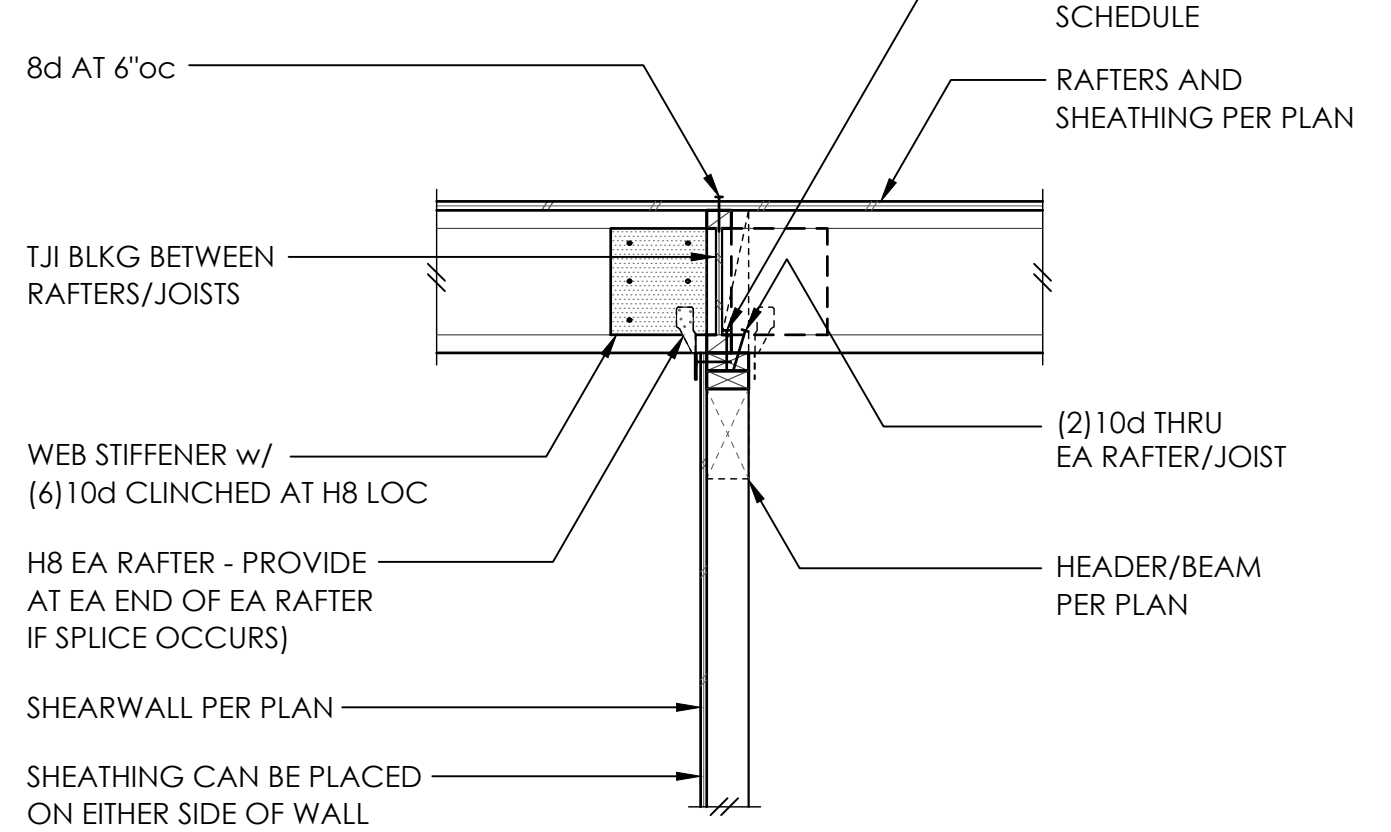


19

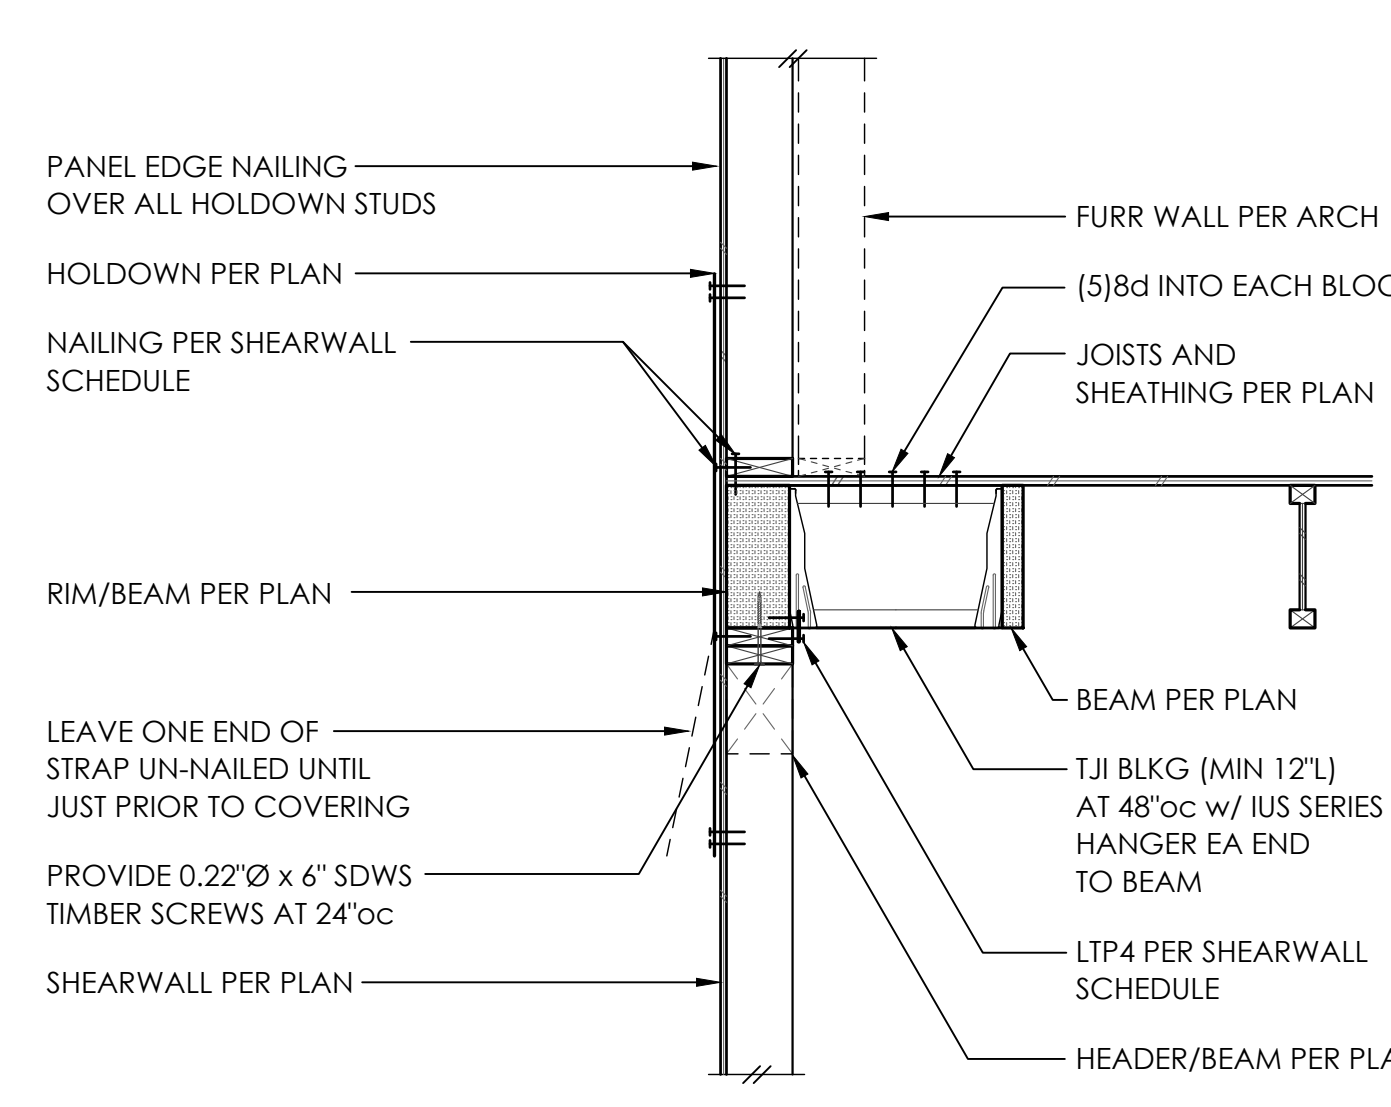


20

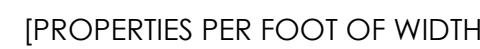


- NOTE:**
STIFFENER PLATE MAY BE OMITTED FOR
HDU2 HOLDOWN TO CLEAR SNUG-FIT
SOLID WOOD FILLER PER PLAN

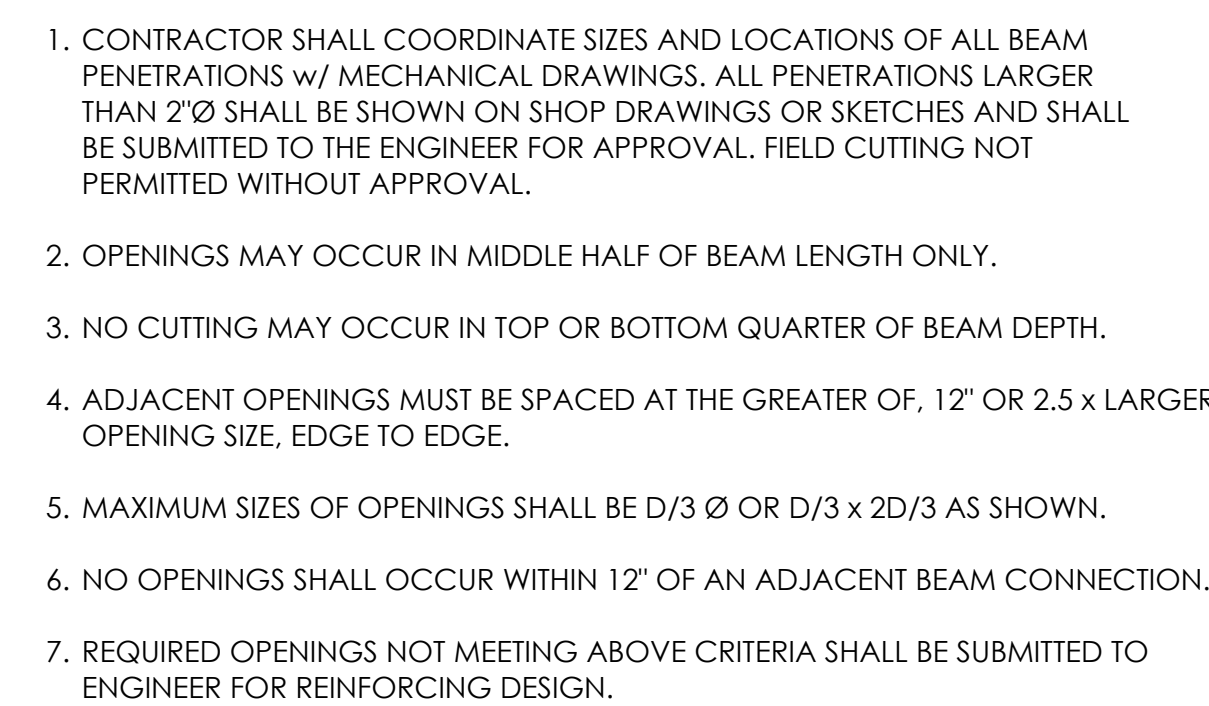


TYPICAL STEEL BEAM PENETRATIONS

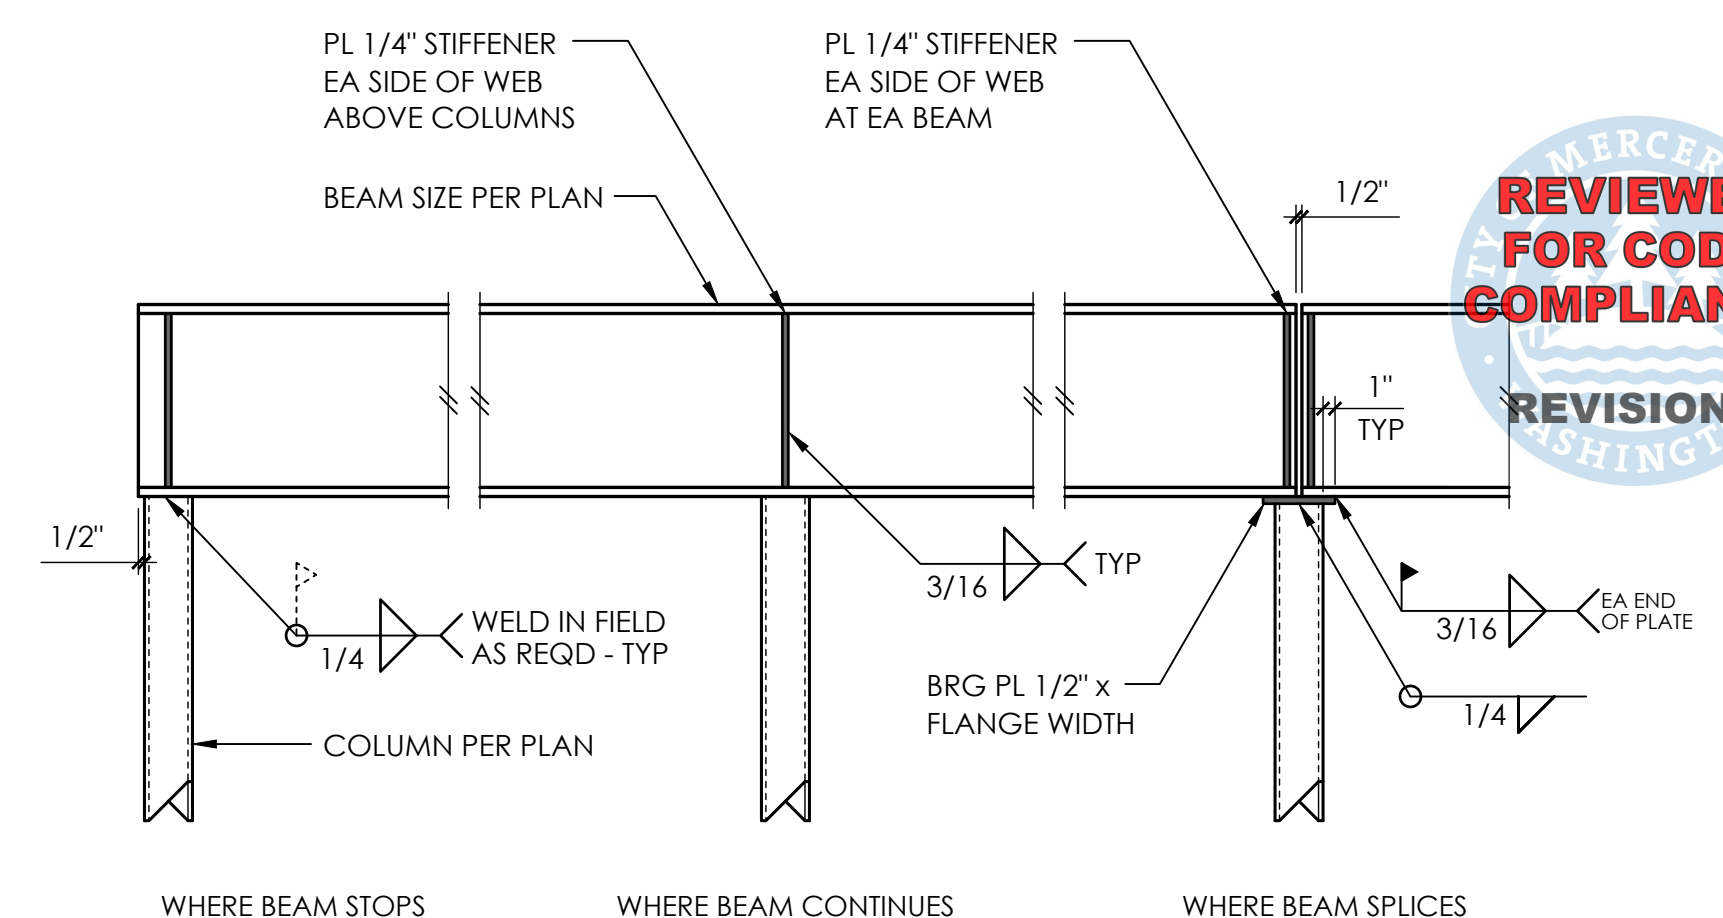


TYPICAL BEAM CORNER CONNECTION (WELD)

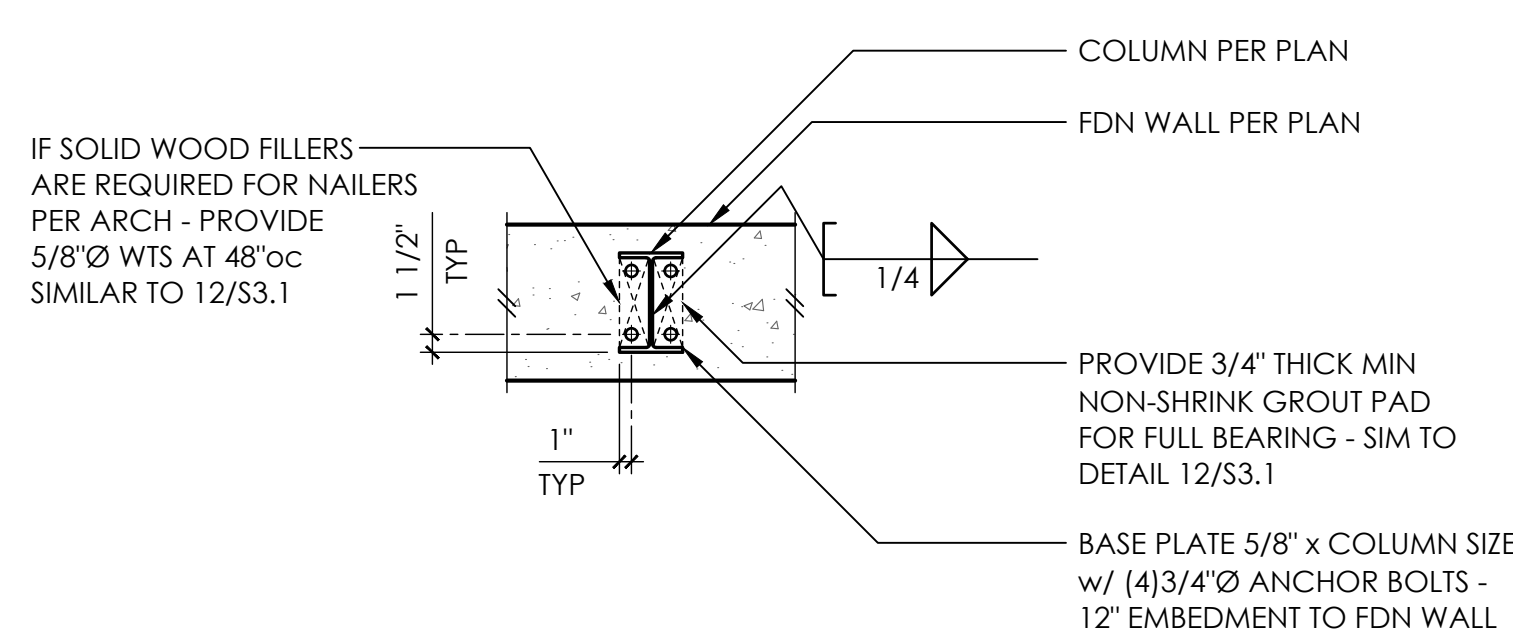



WIDE FLANGE COLUMN BASE PLATE (PLAN) 13

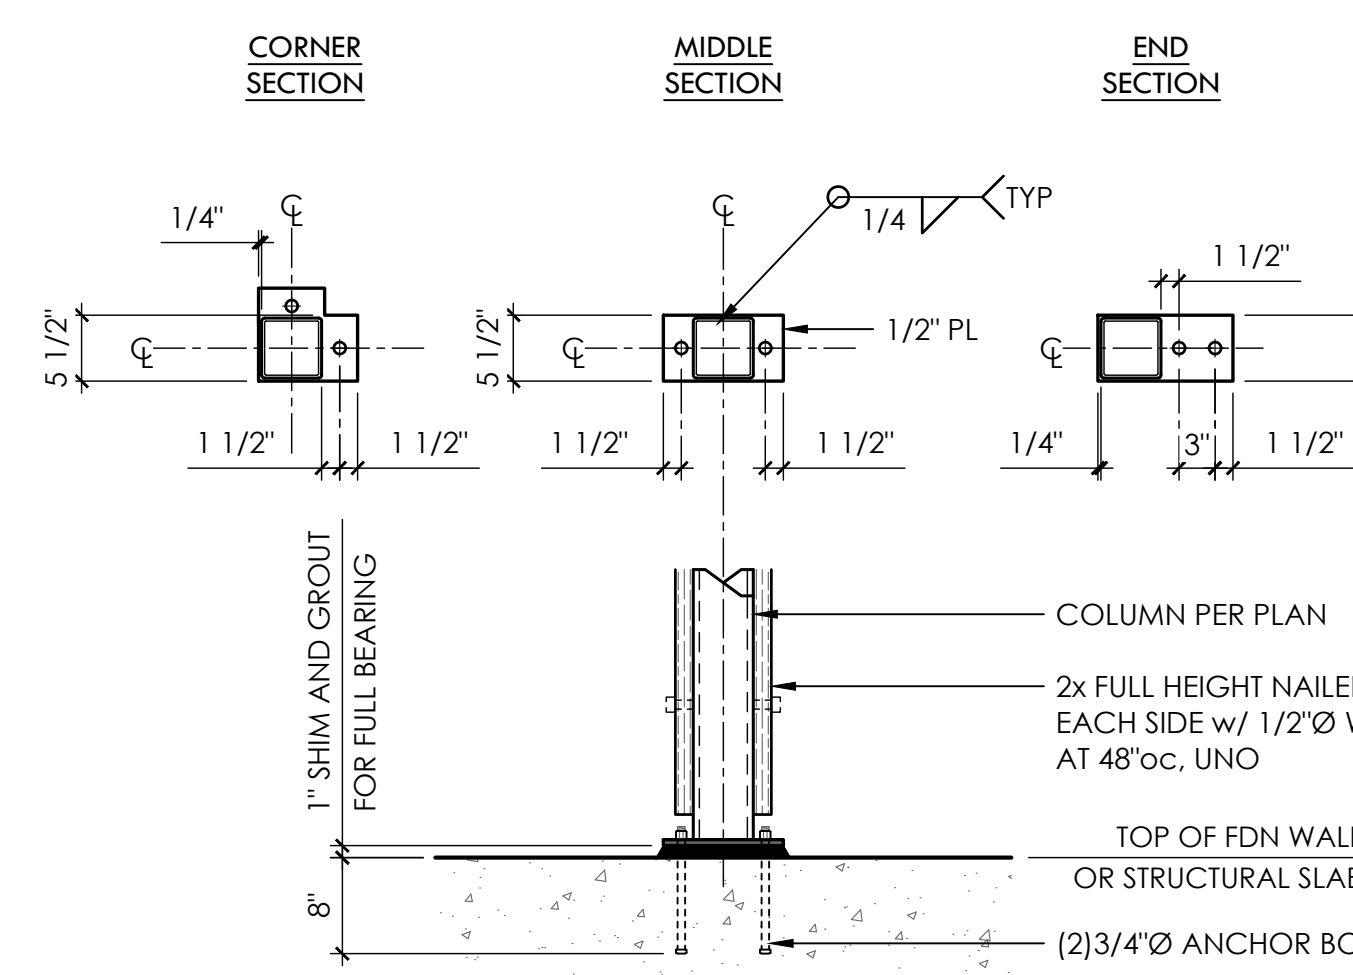


BASEPLATE - HSS COLUMN 14

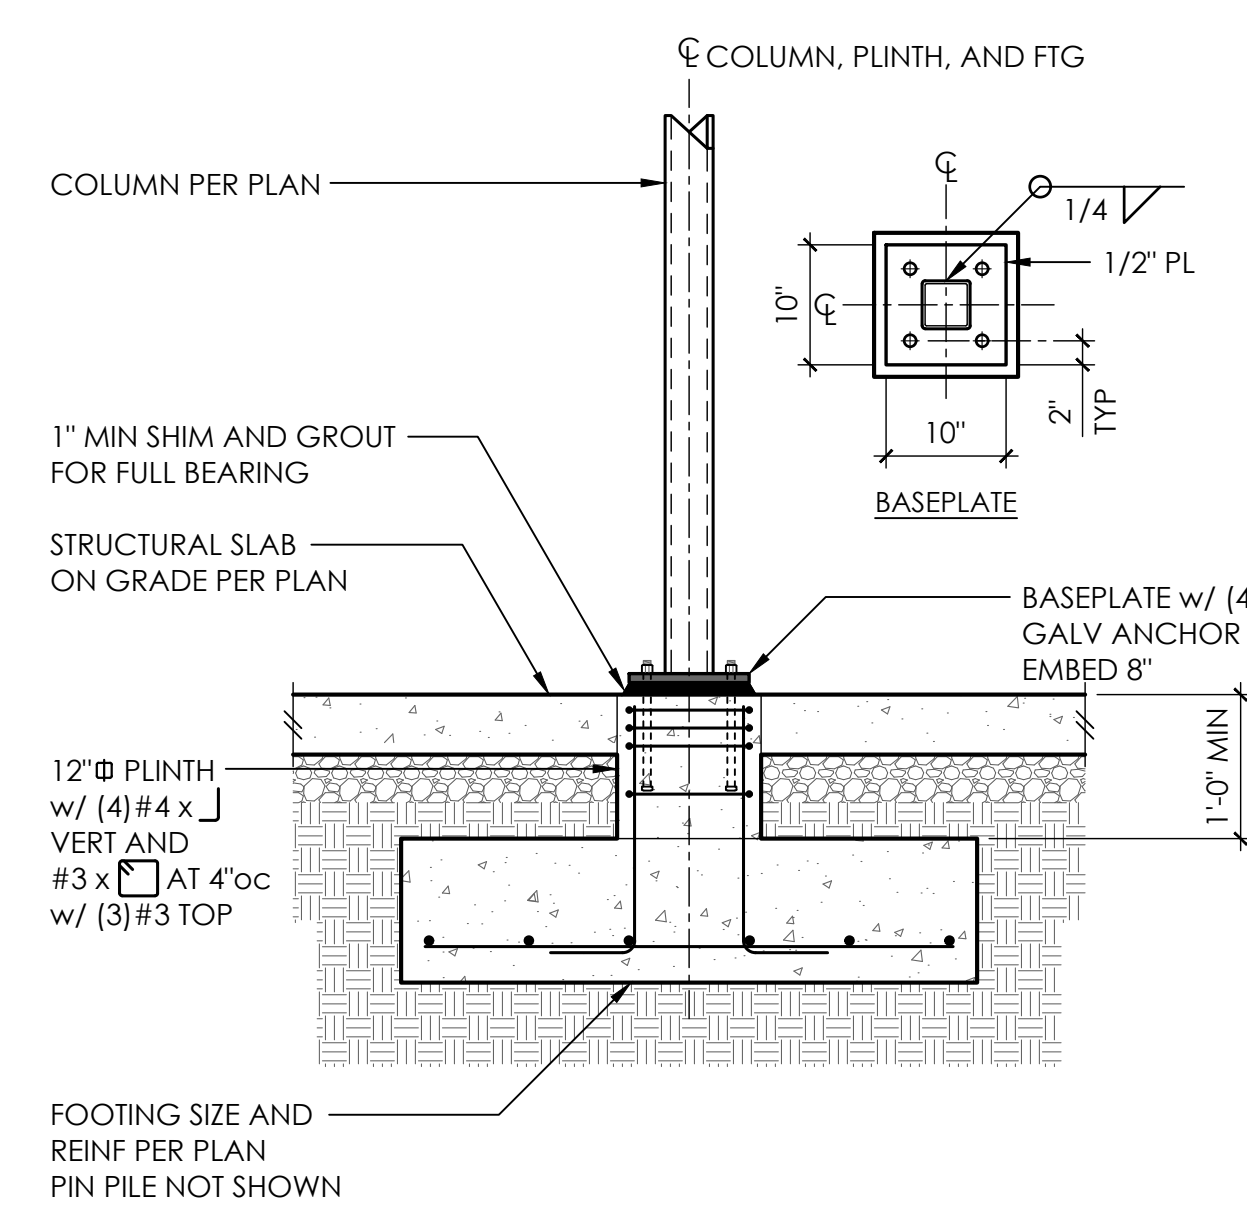

PLAN

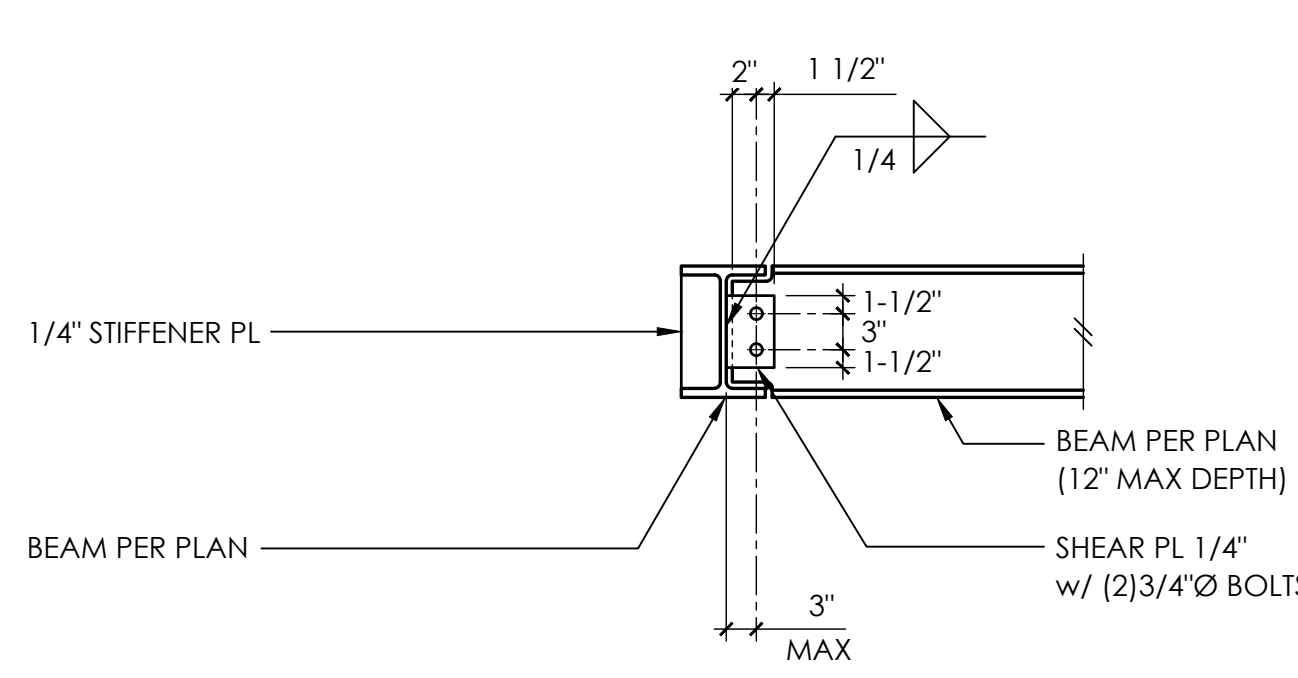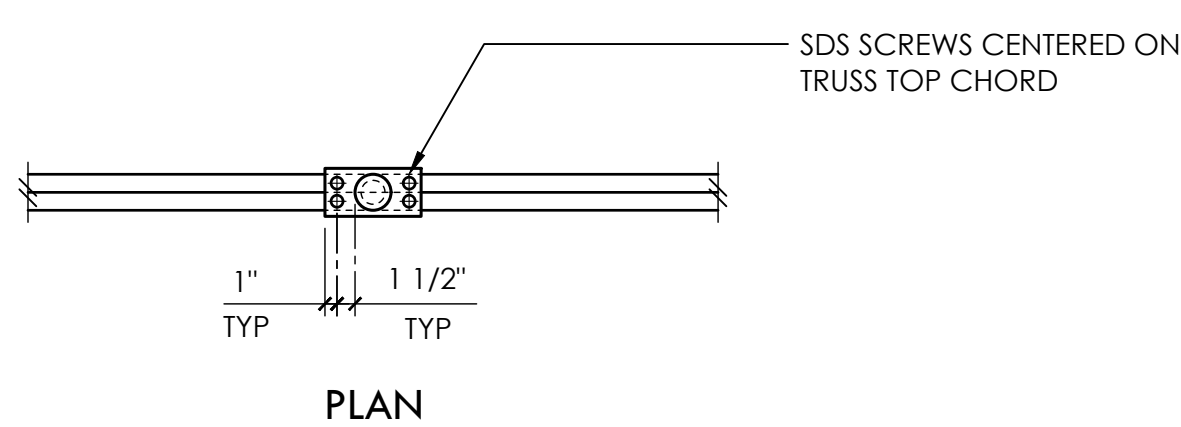

TYPICAL BEAM TO BEAM CONNECTION 19

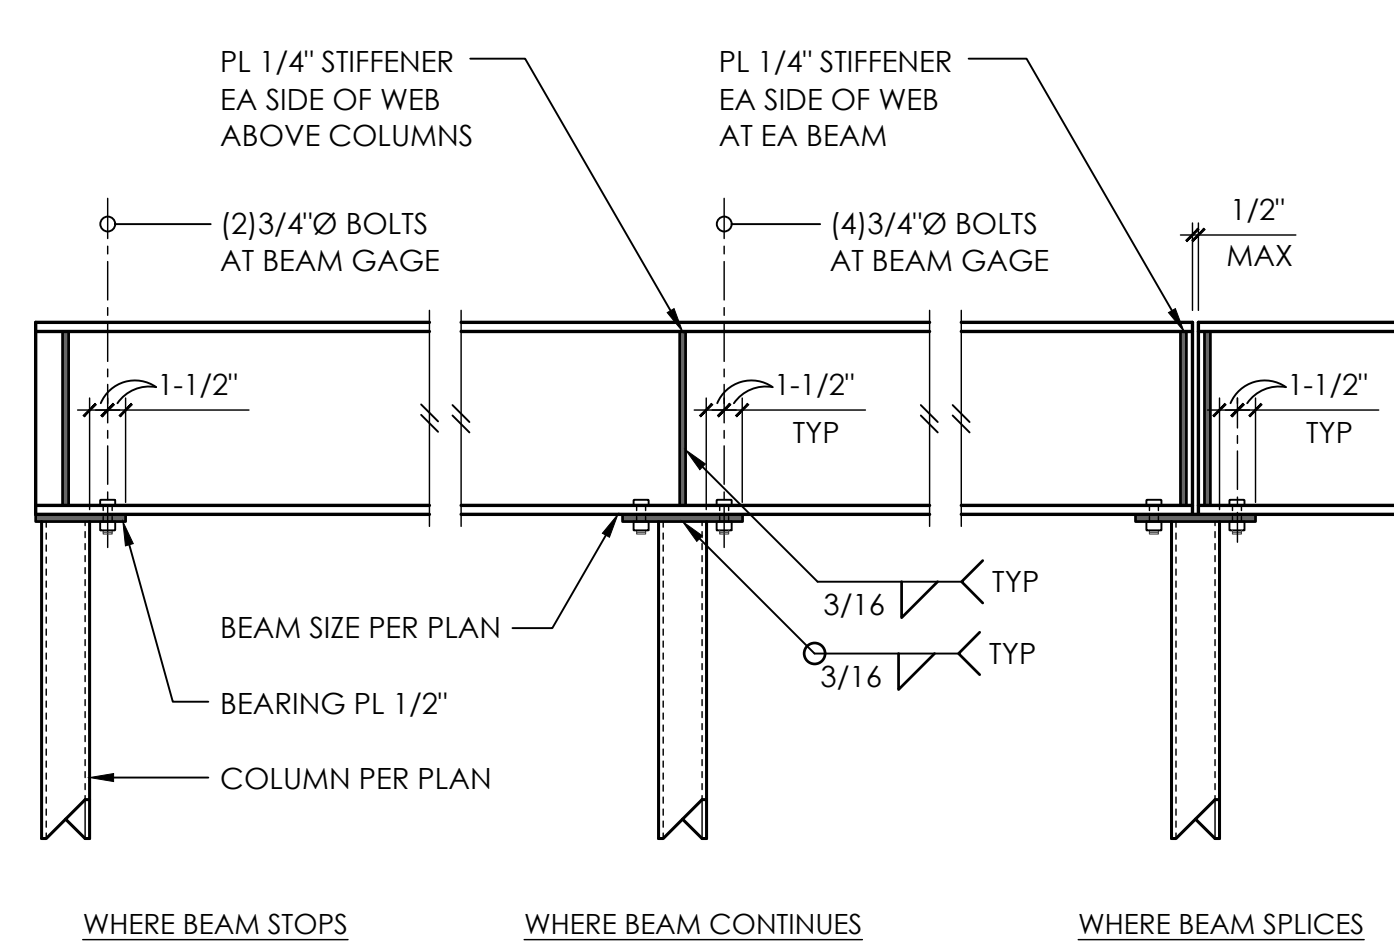


NOTE
BEARING PLATE THICKNESS SHALL BE 3/4" WHERE
DEPTH OF SUPPORTED MEMBER EXCEEDS 24"

20


STEEL FRAMING DETAILS

\$5.0
SCALE - 3/4" = 1'-0"

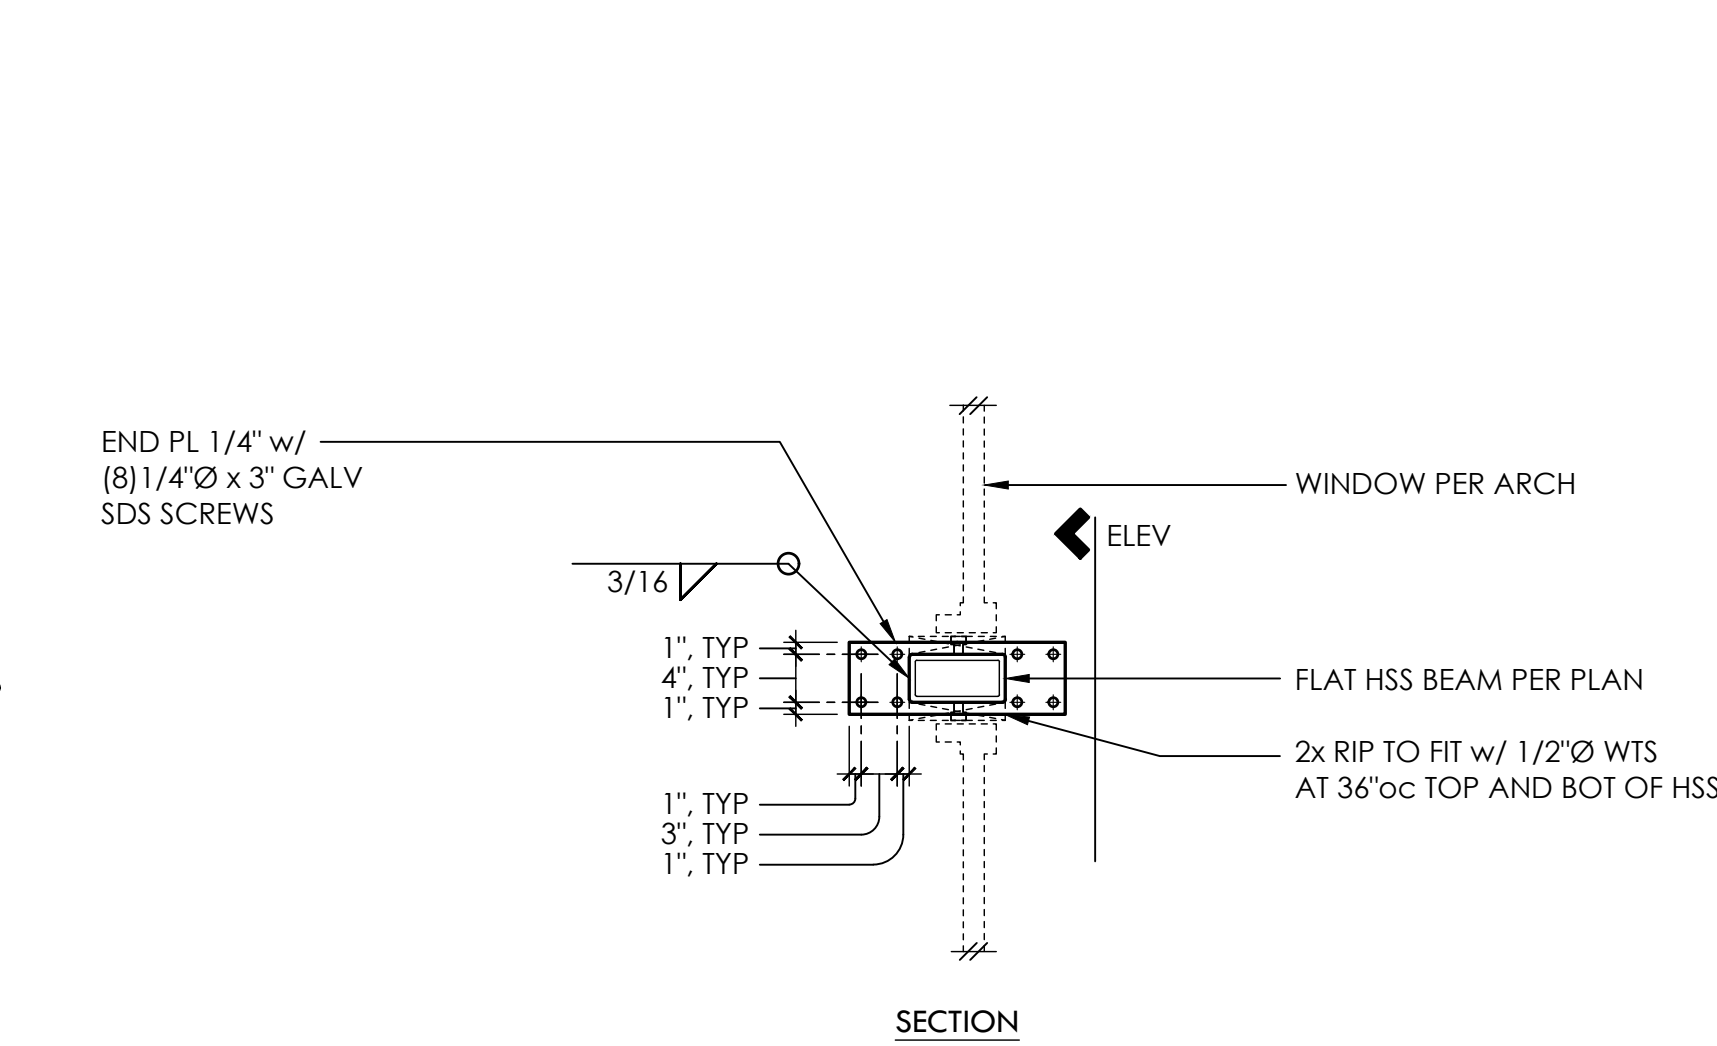


FOR CALLOUTS
IN COMMON
REFER 15/54.1

2

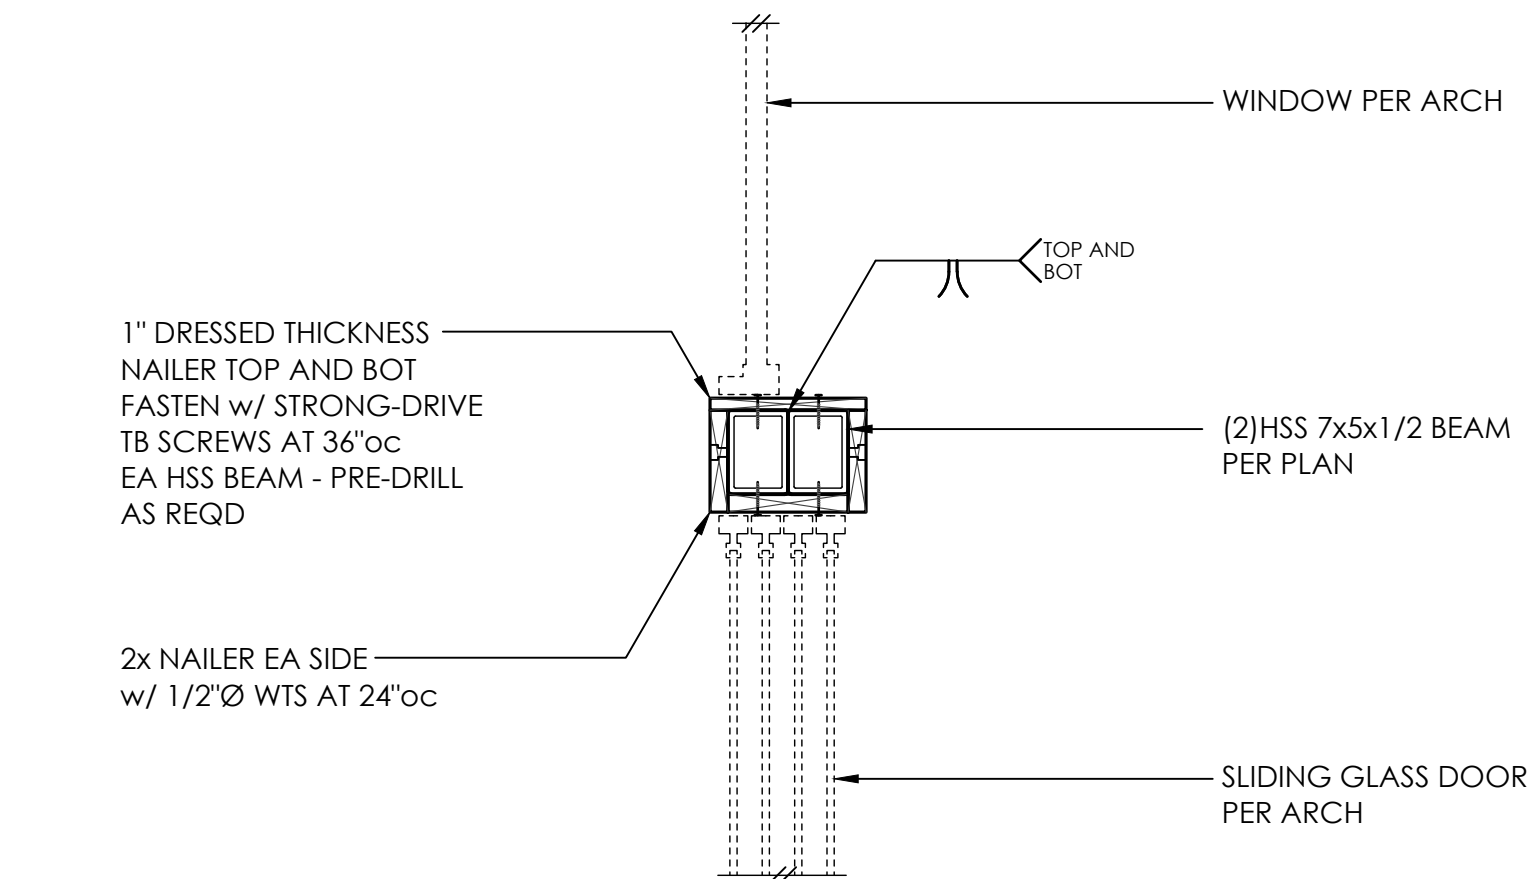


3

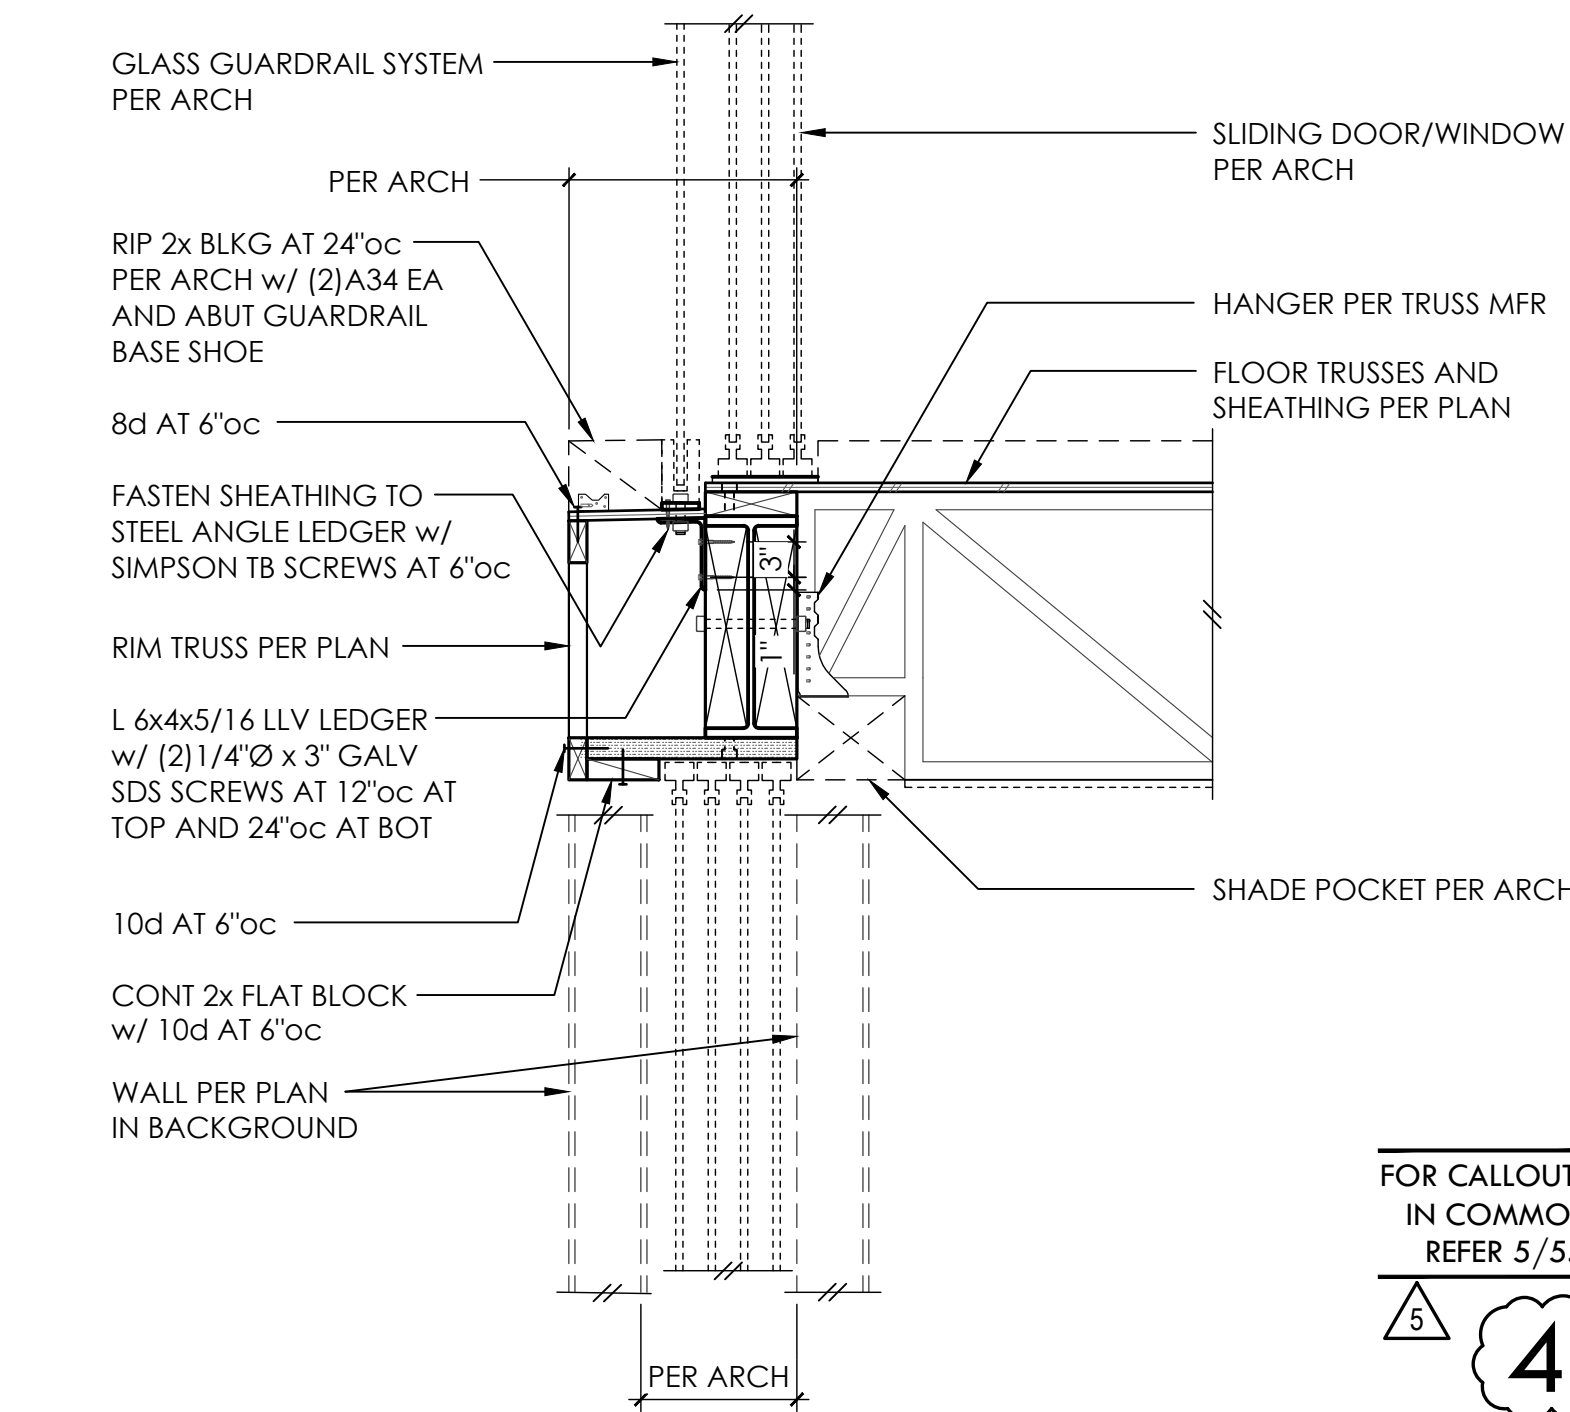


FOR CALLOUTS
IN COMMON
REFER 5/51.1

4

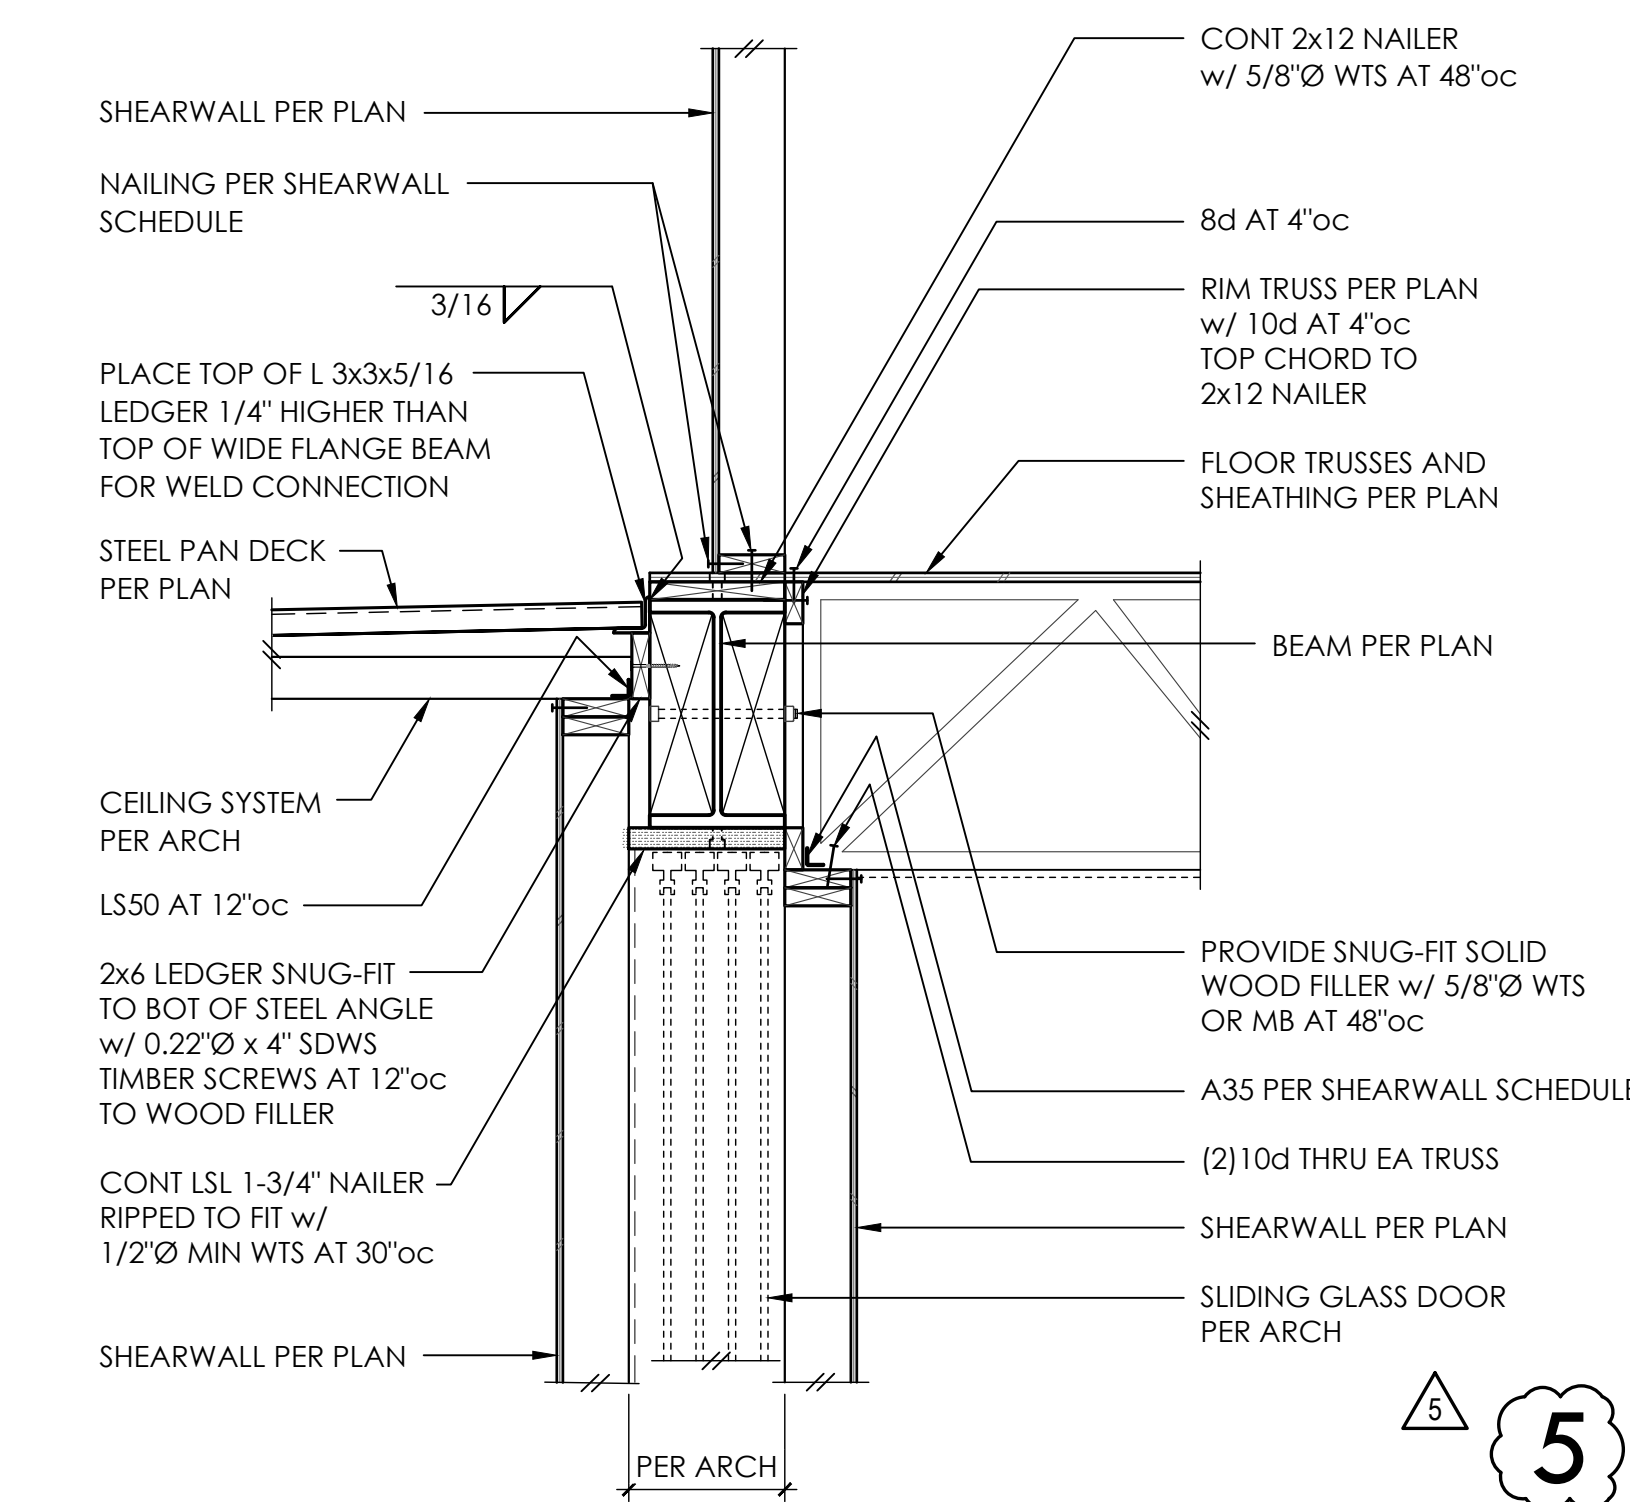


5

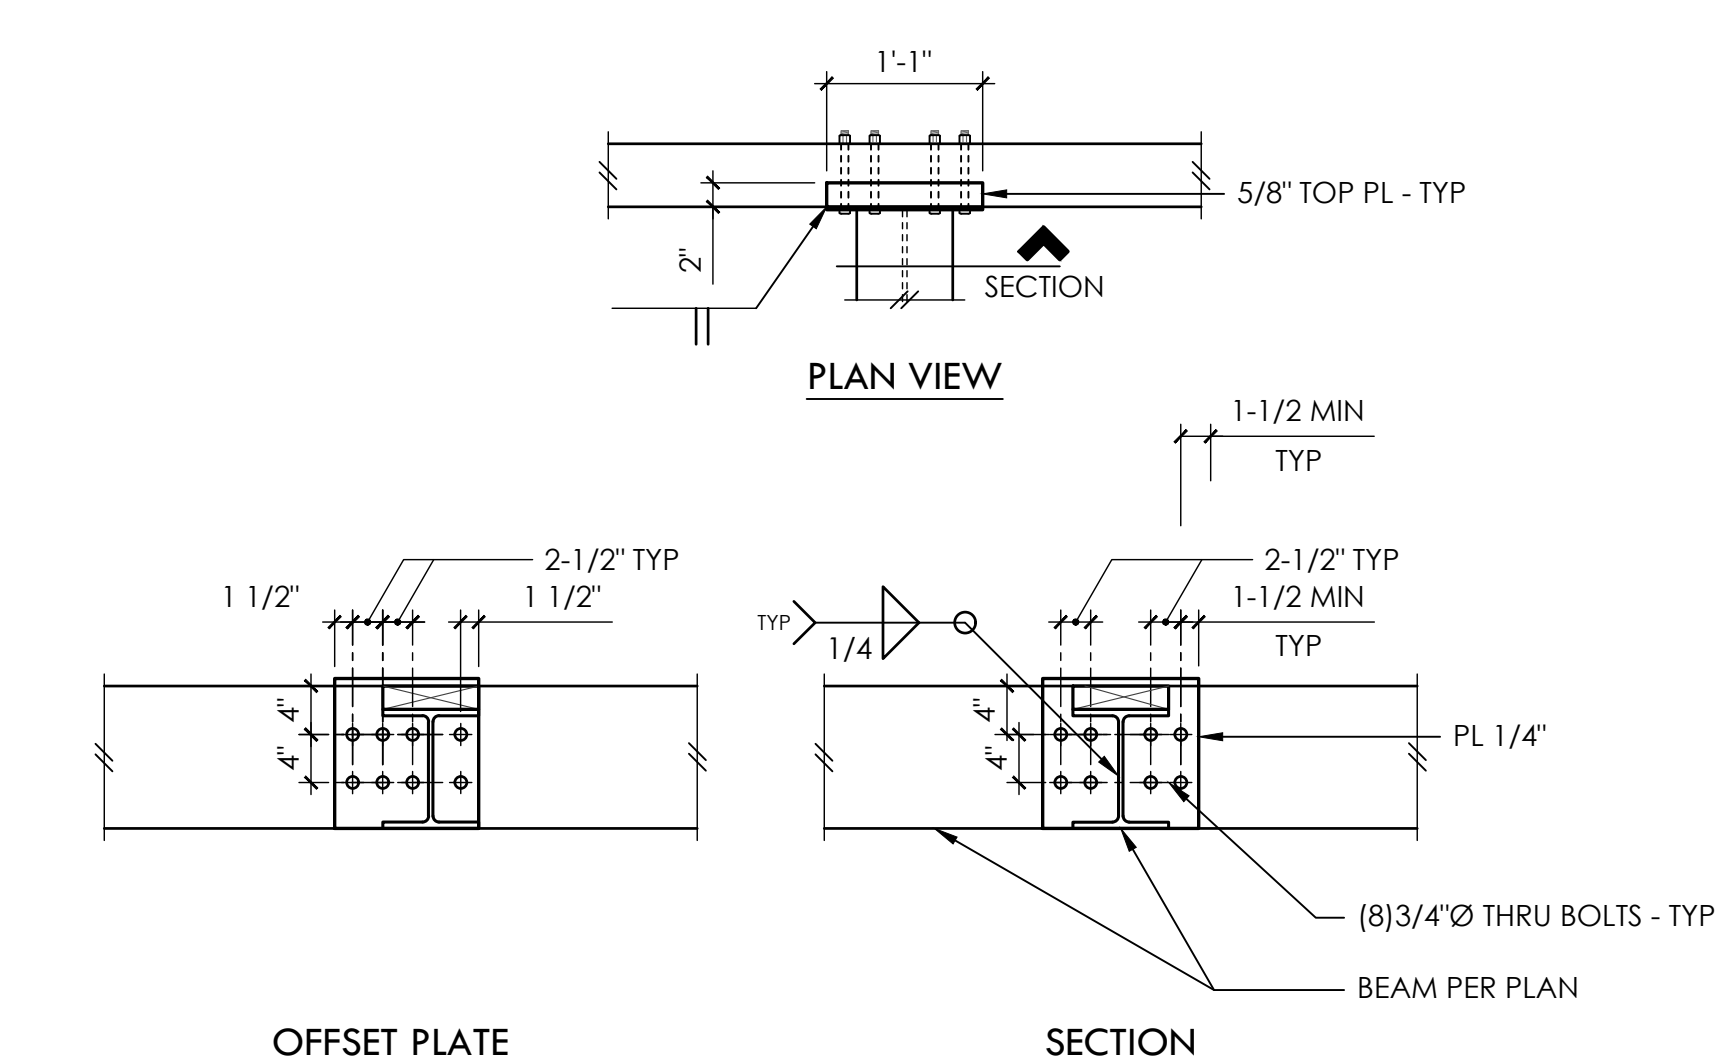


TYPICAL STEEL TO WOOD BEAM CONNECTION

6

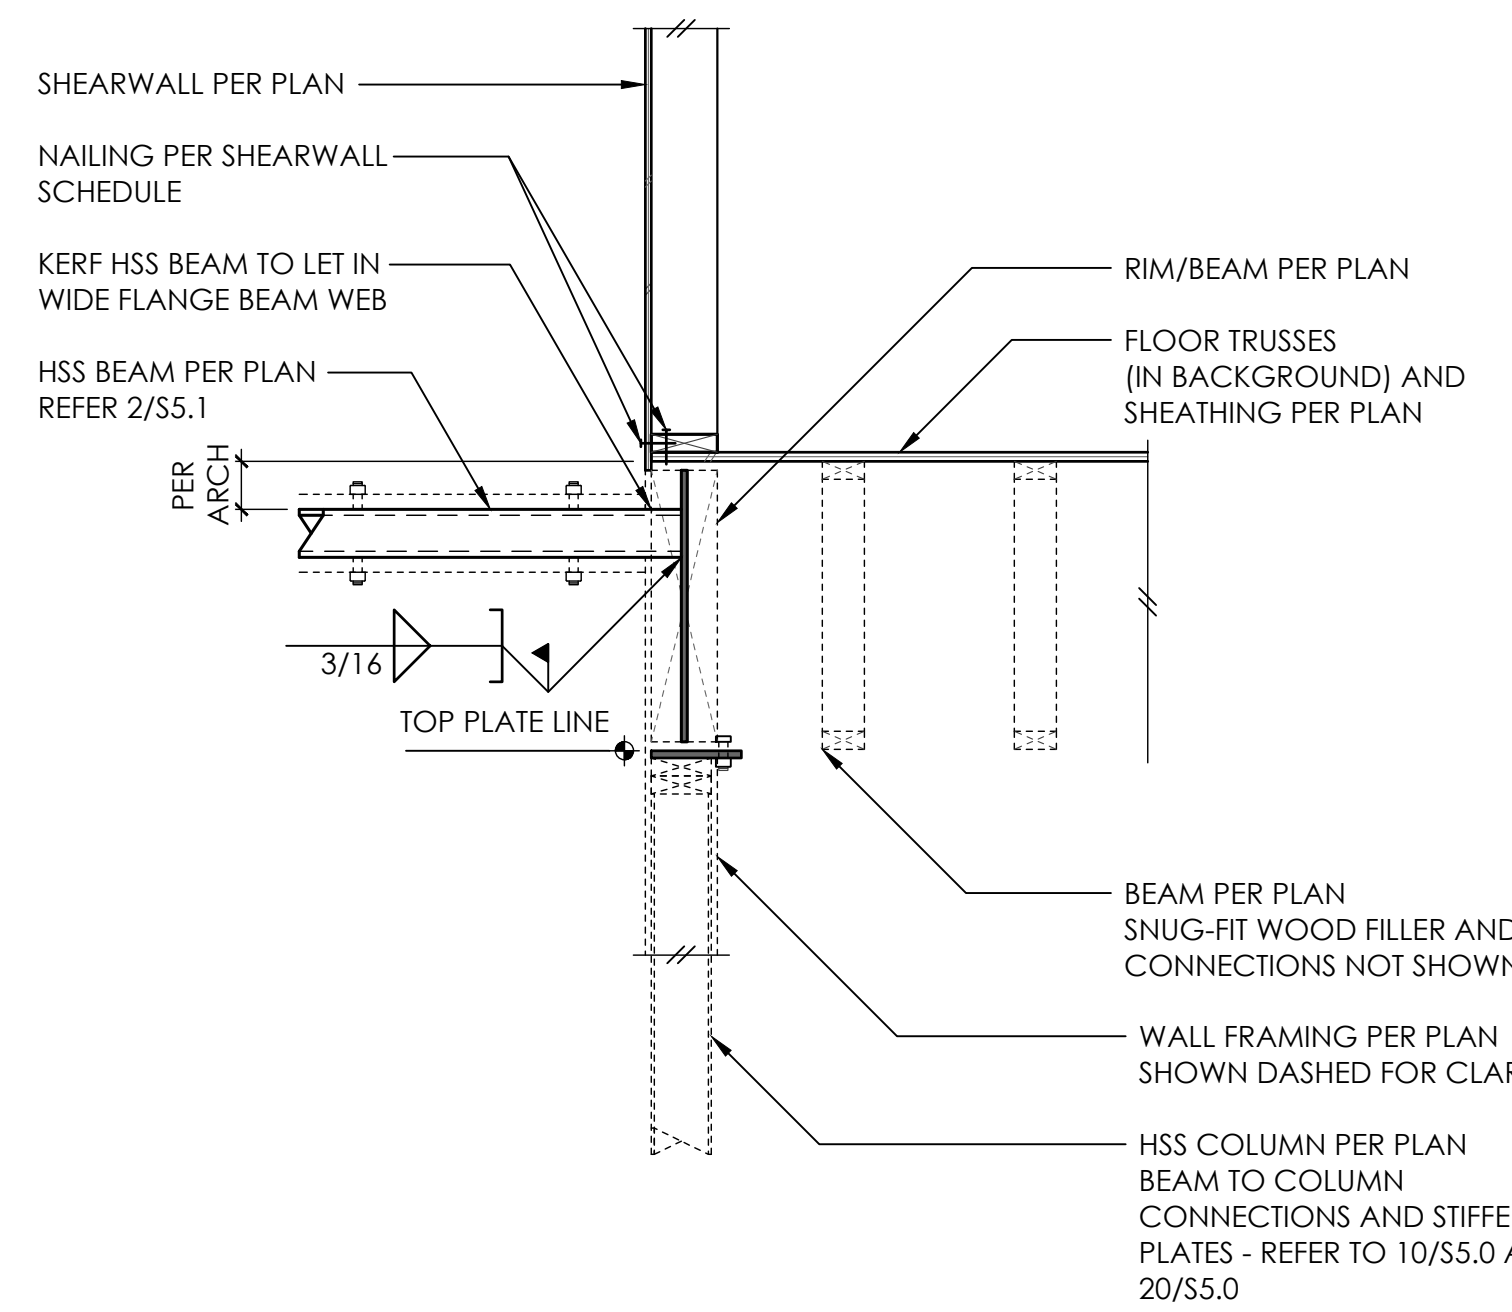


FOR CALLOUTS
IN COMMON
REFER 4/55.1

7

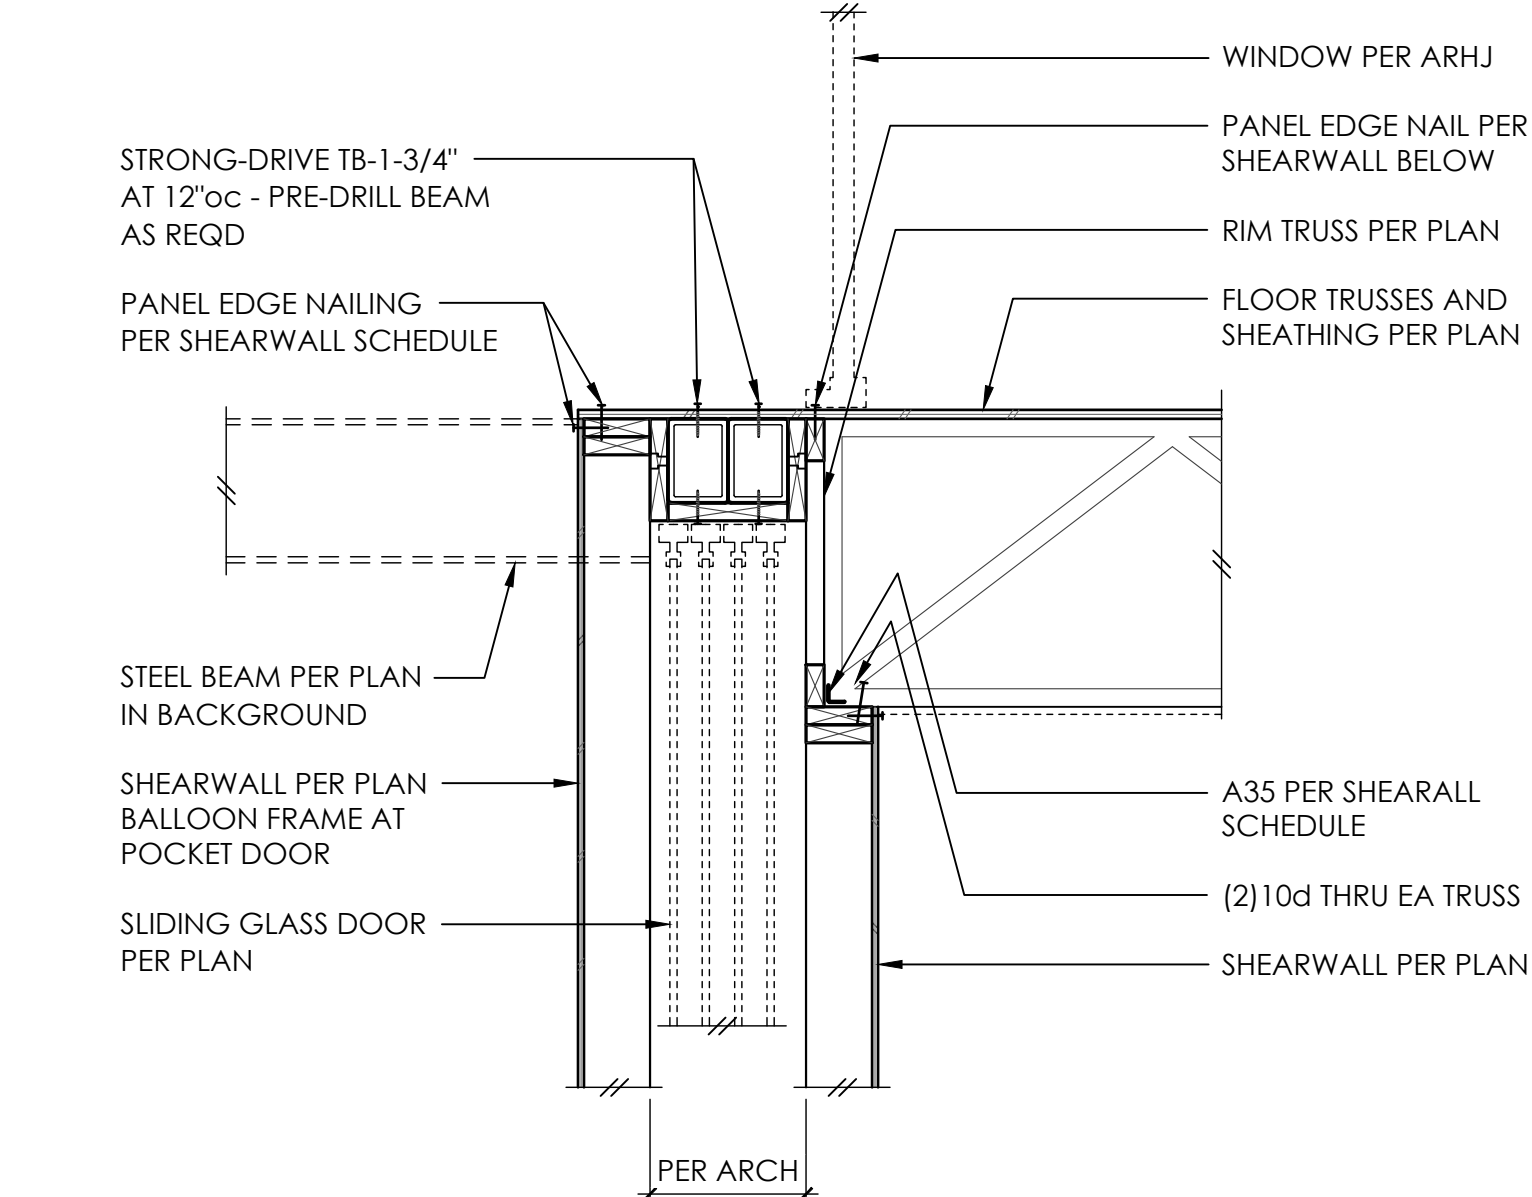


8

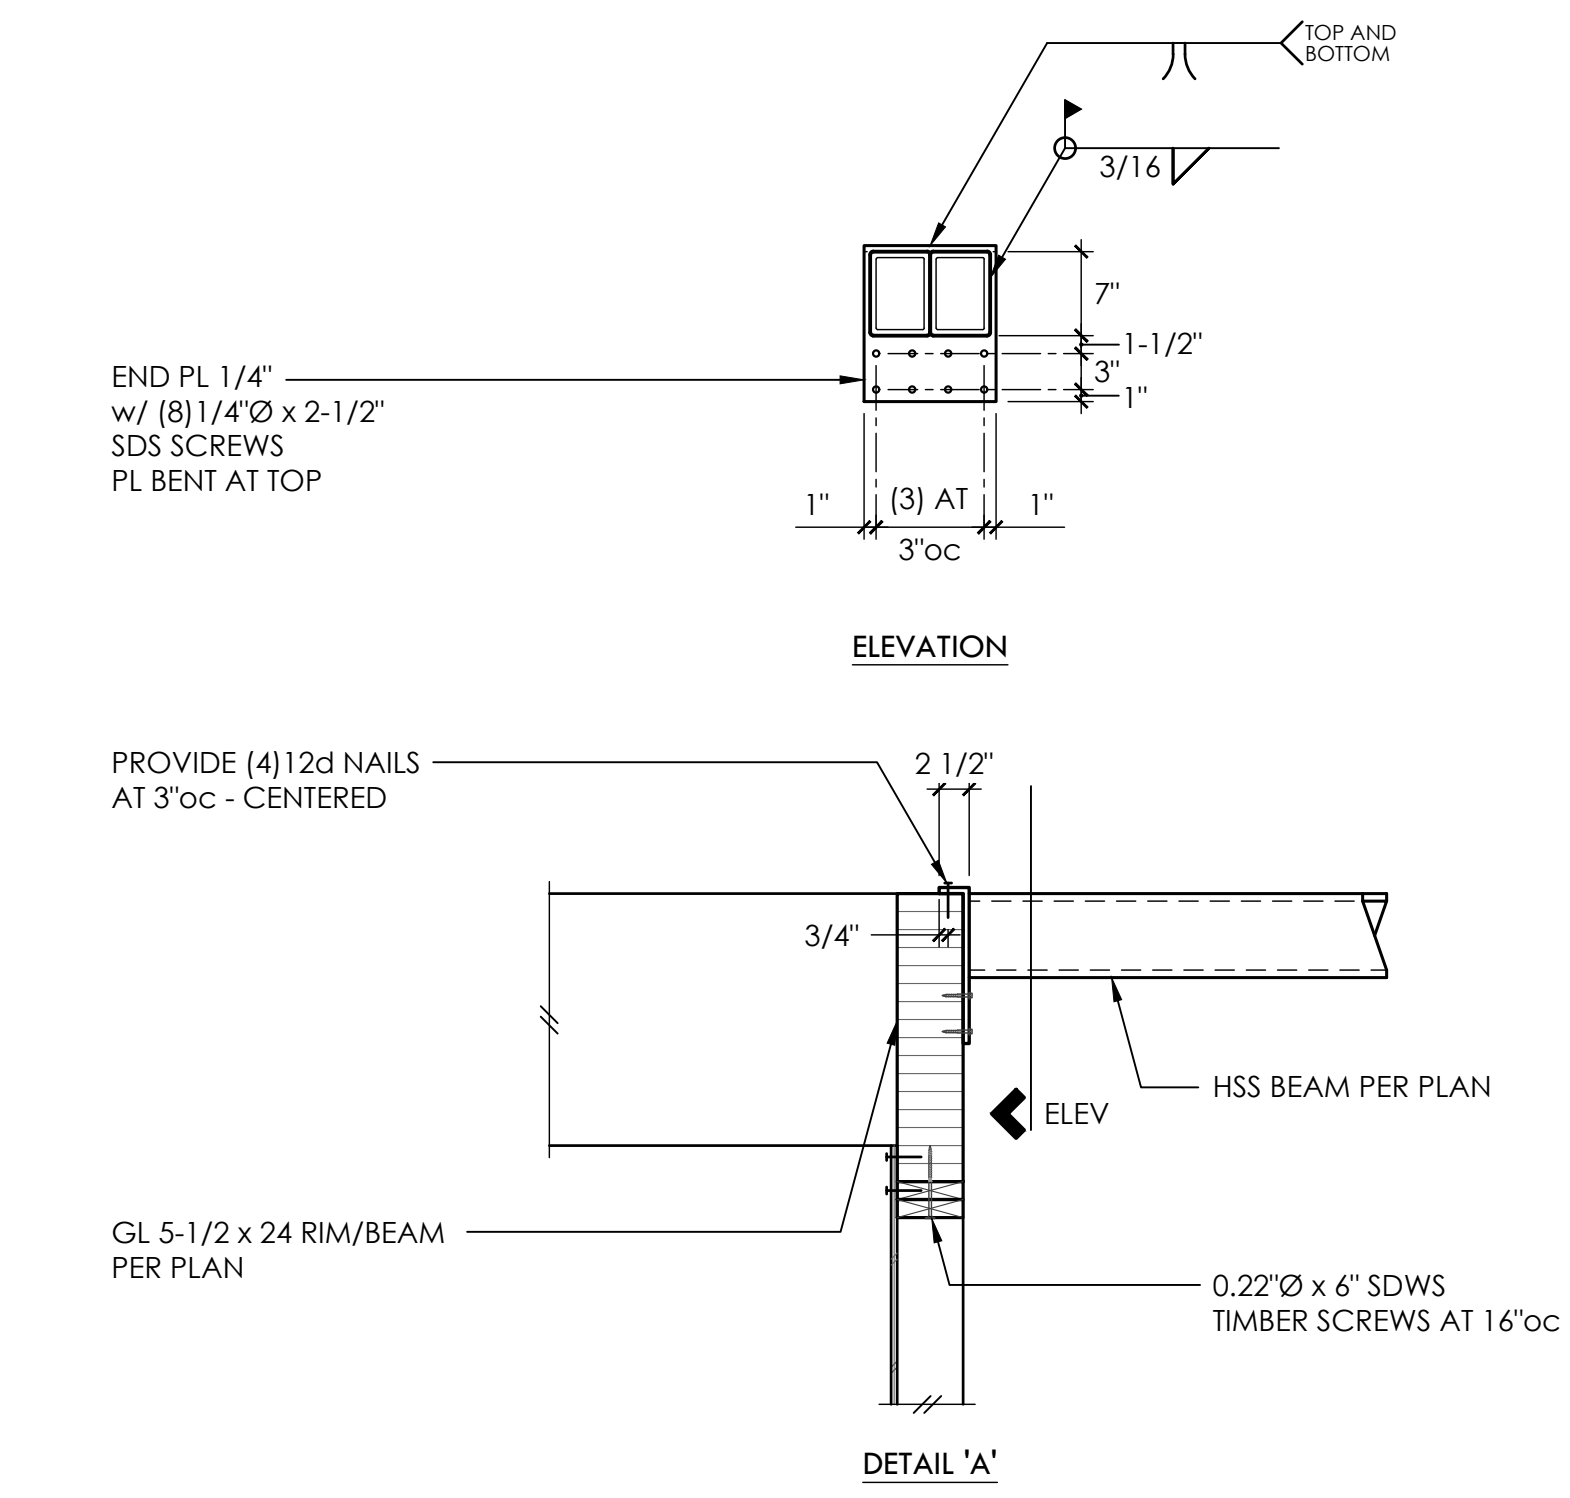


FOR CALLOUTS
IN COMMON
REFER 15/54.1


9

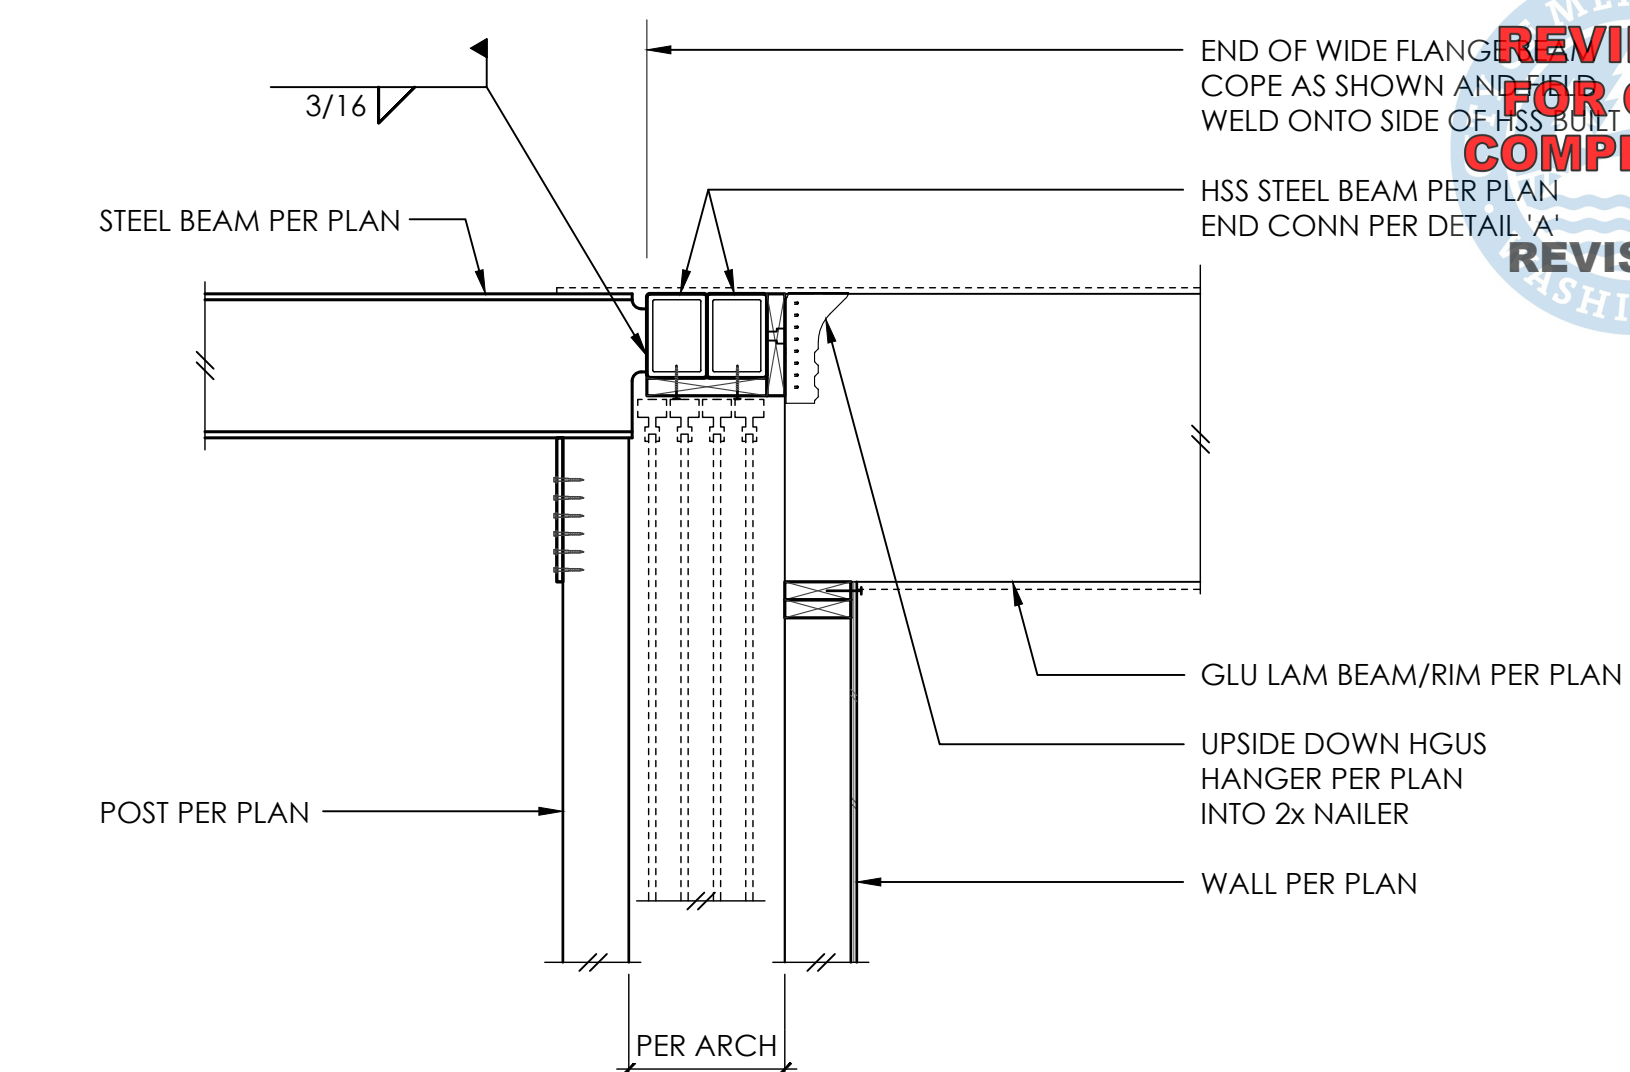

10

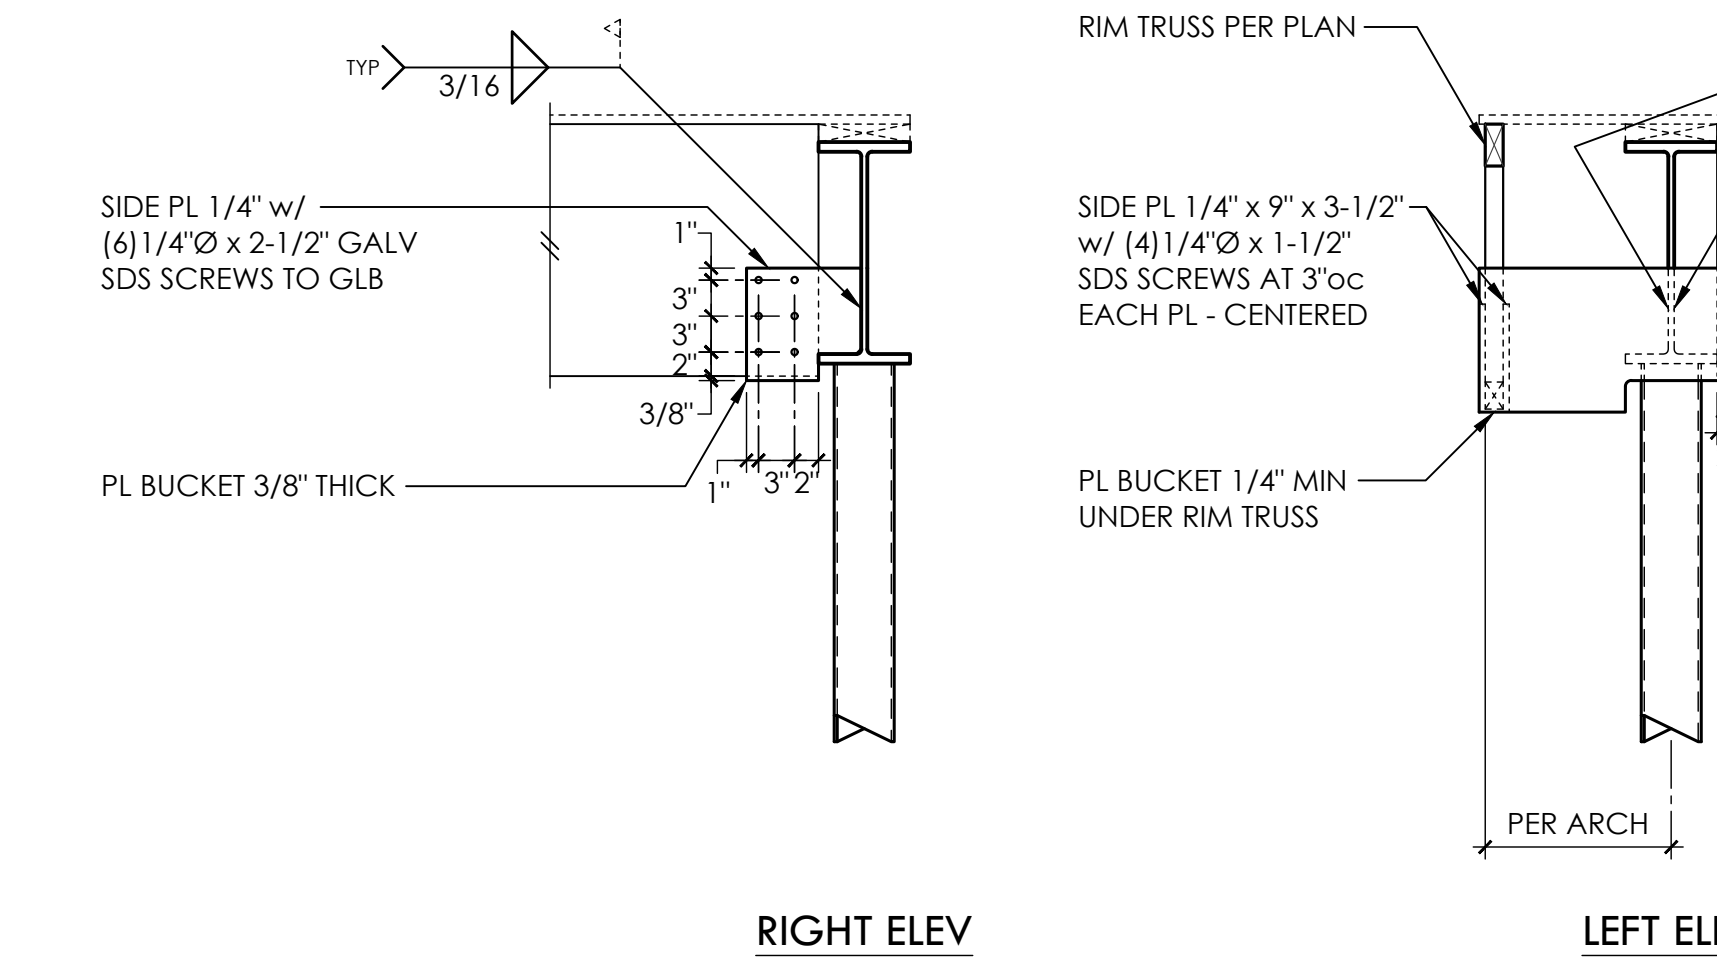

RIGHT ELEV

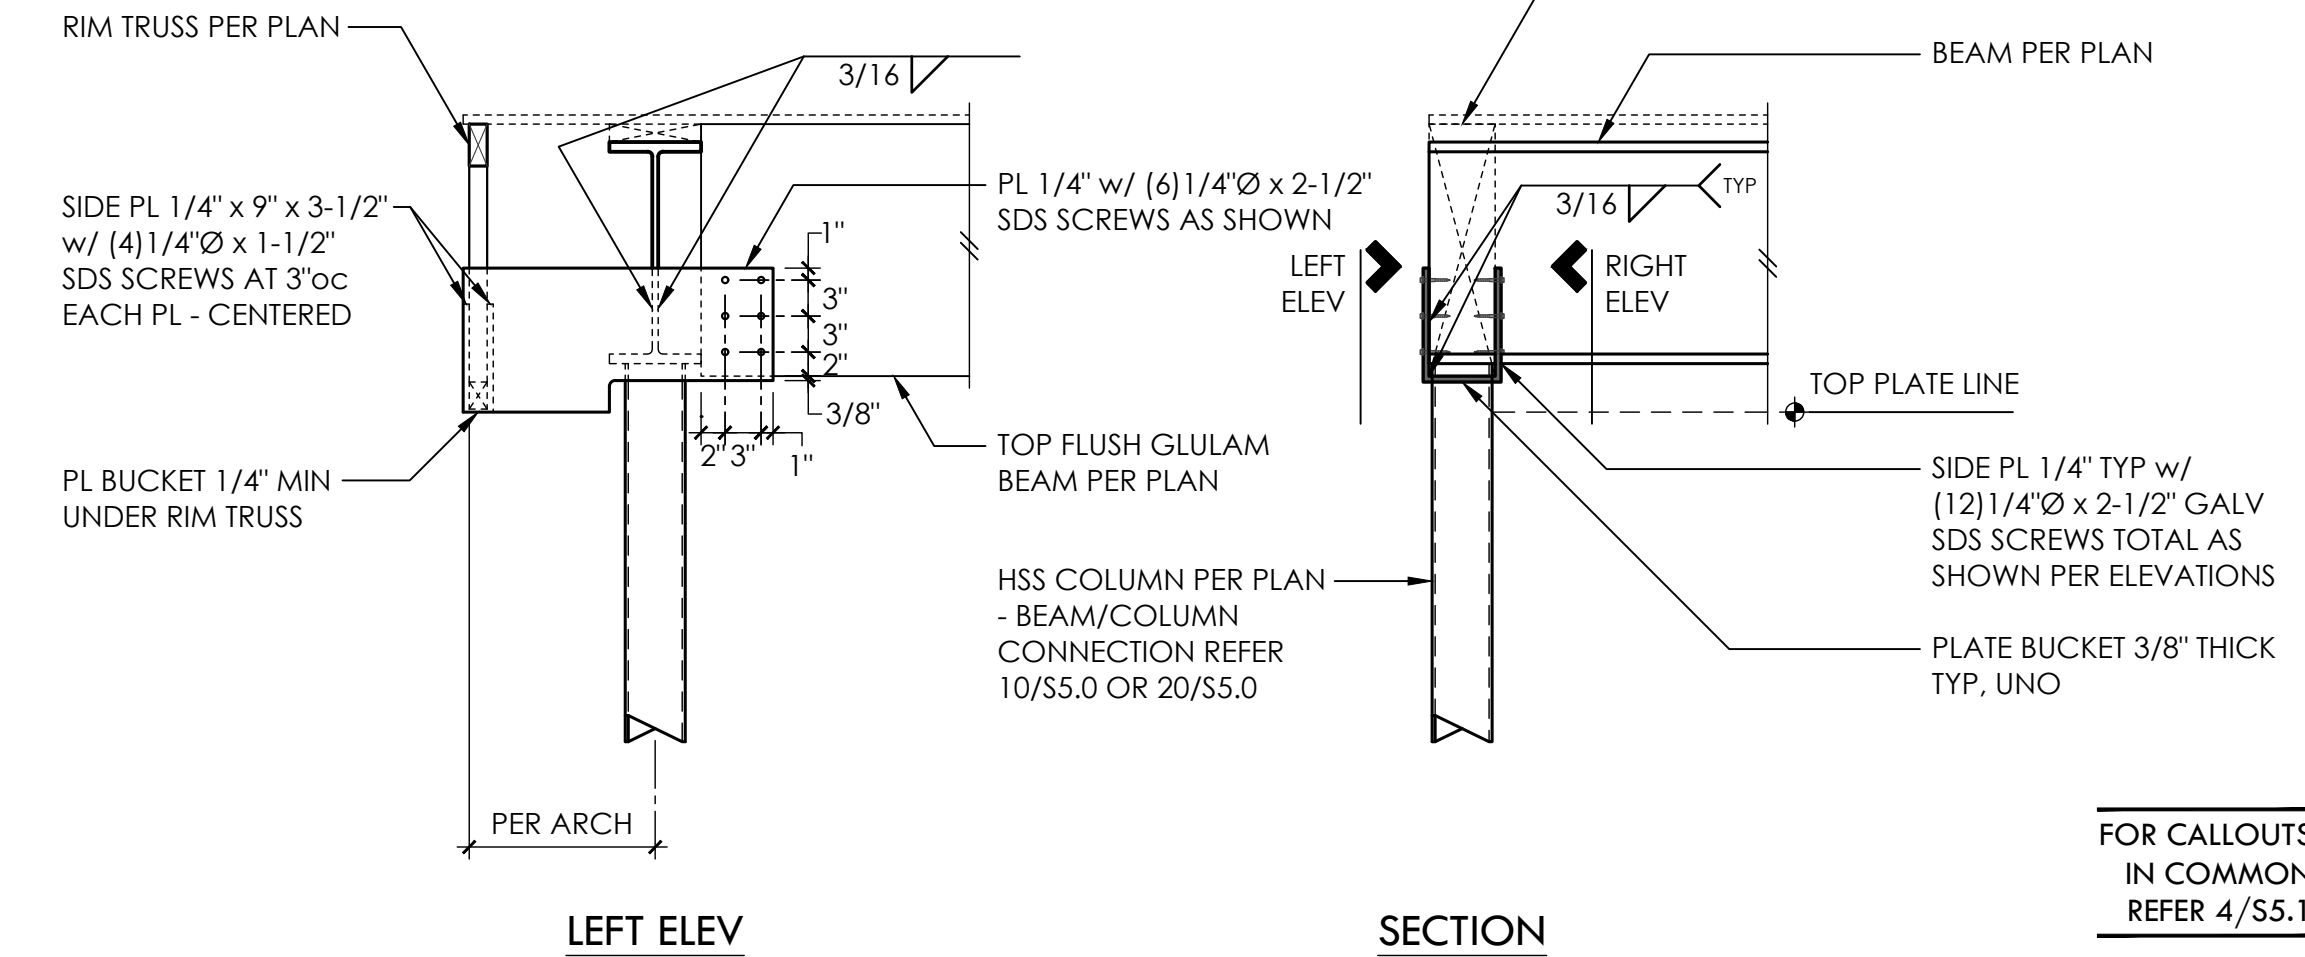


LEFT ELEV


SECTION
(LOOKING THRU EAST)

FOR CALLOUTS
IN COMMON
REFER 4/55.1


12

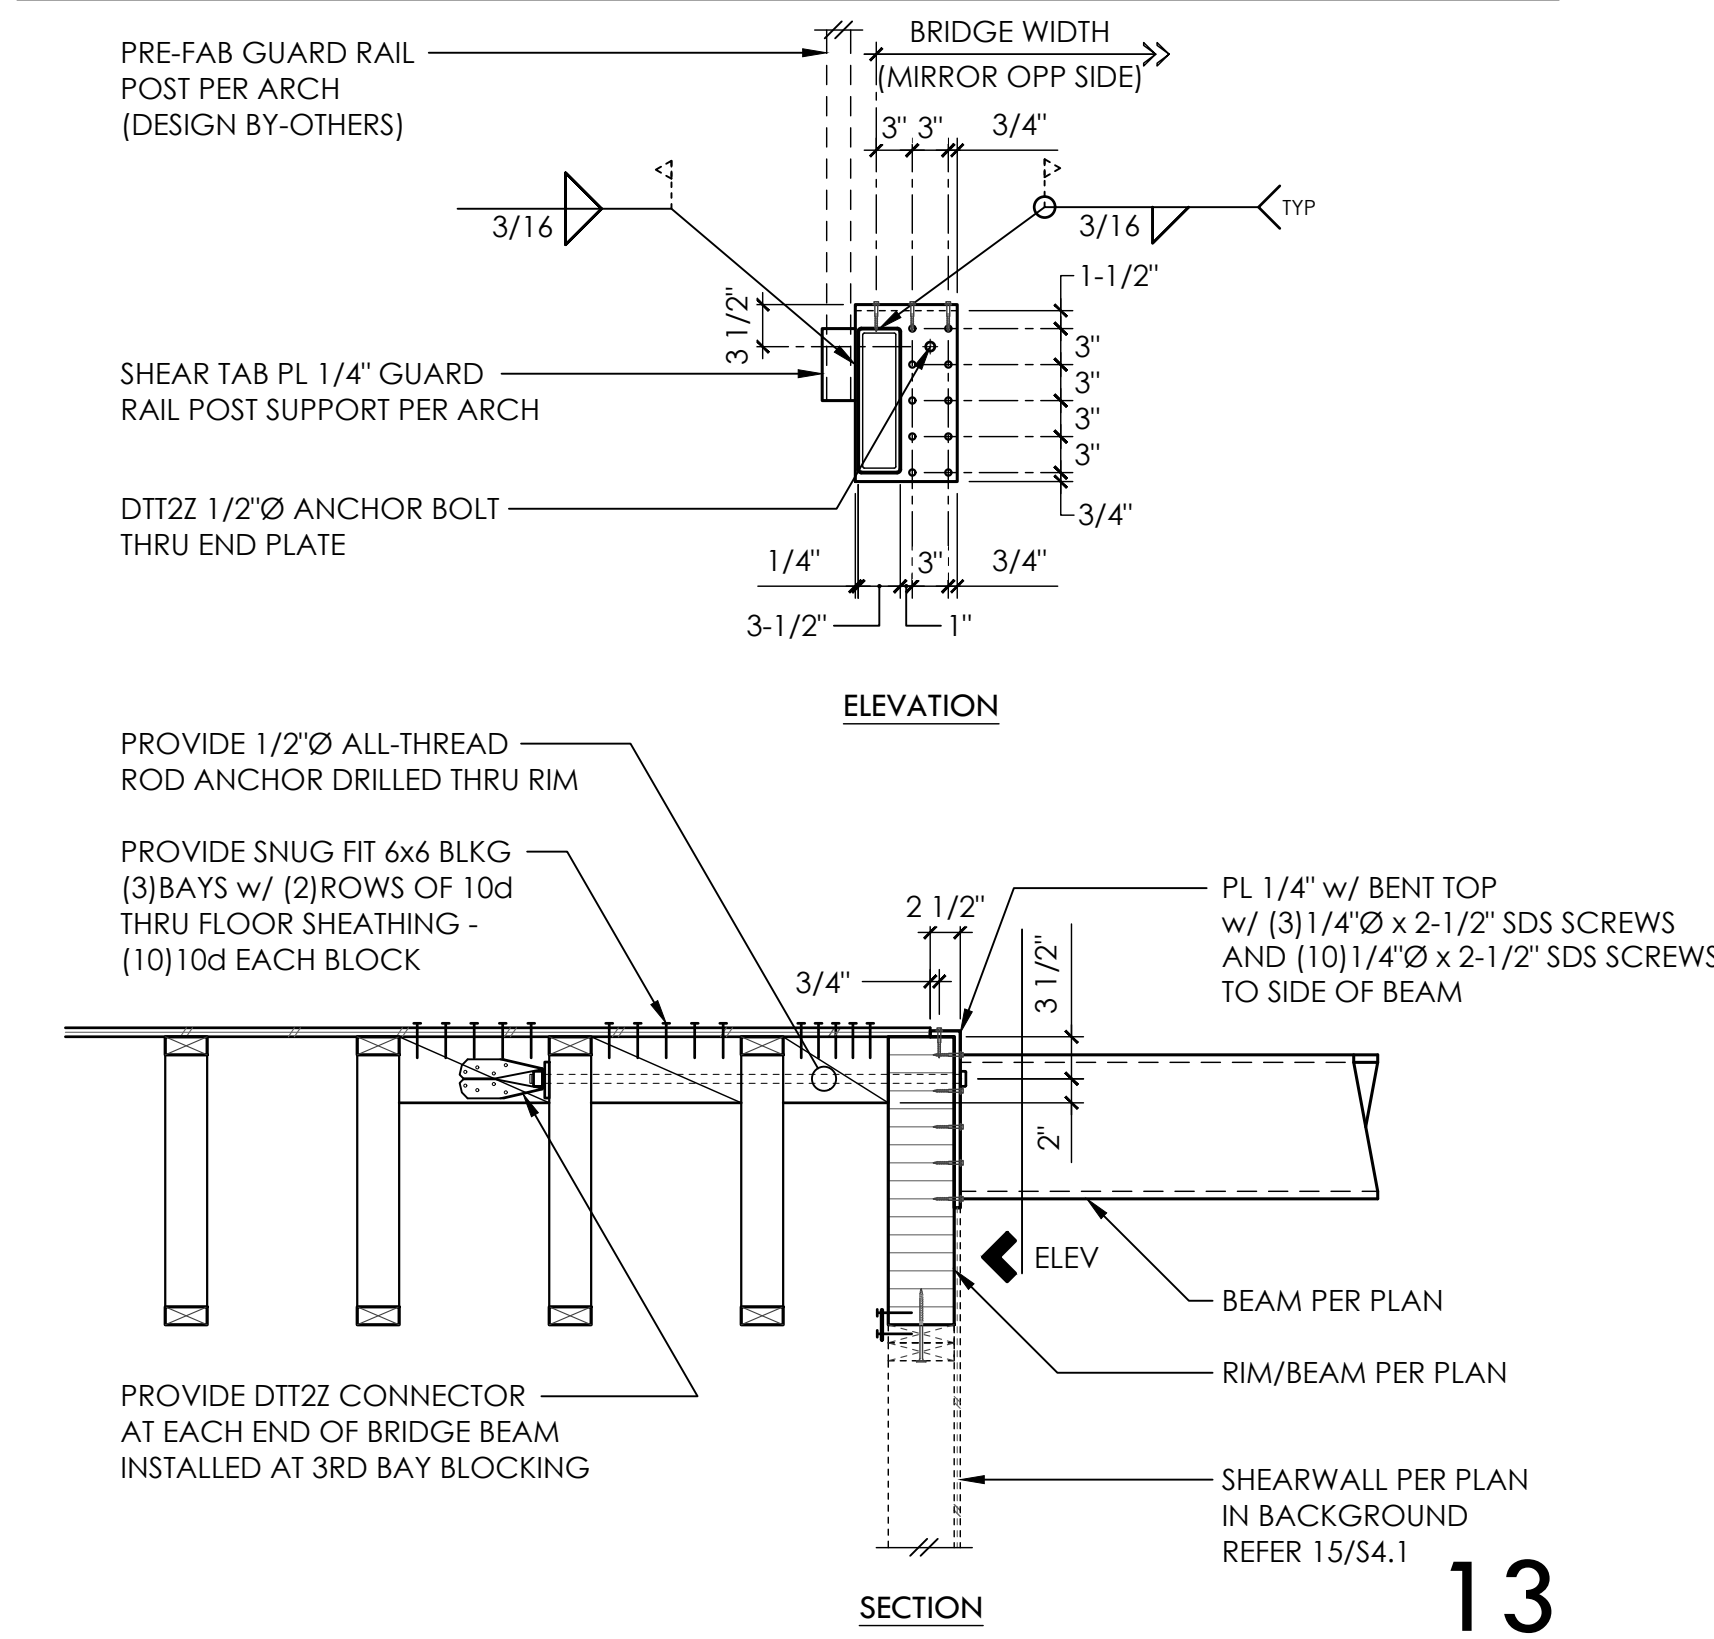

13

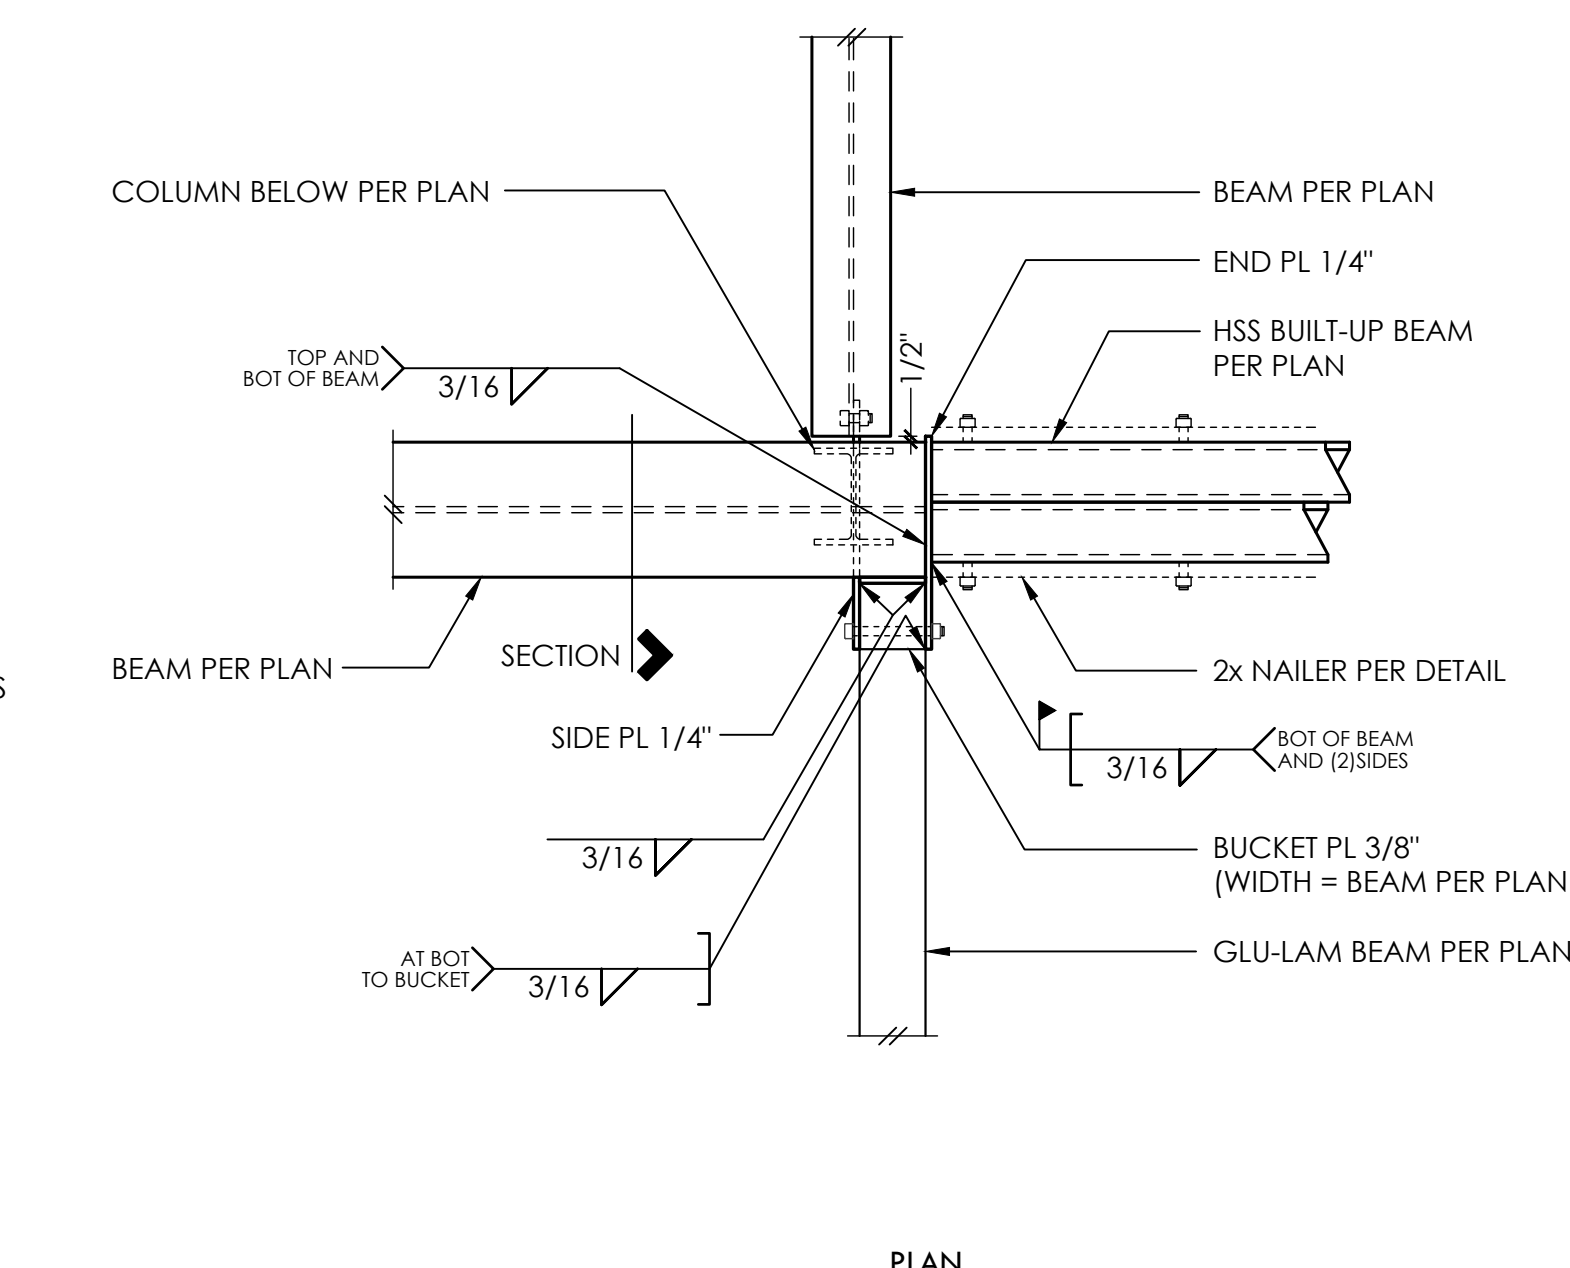


PLAN

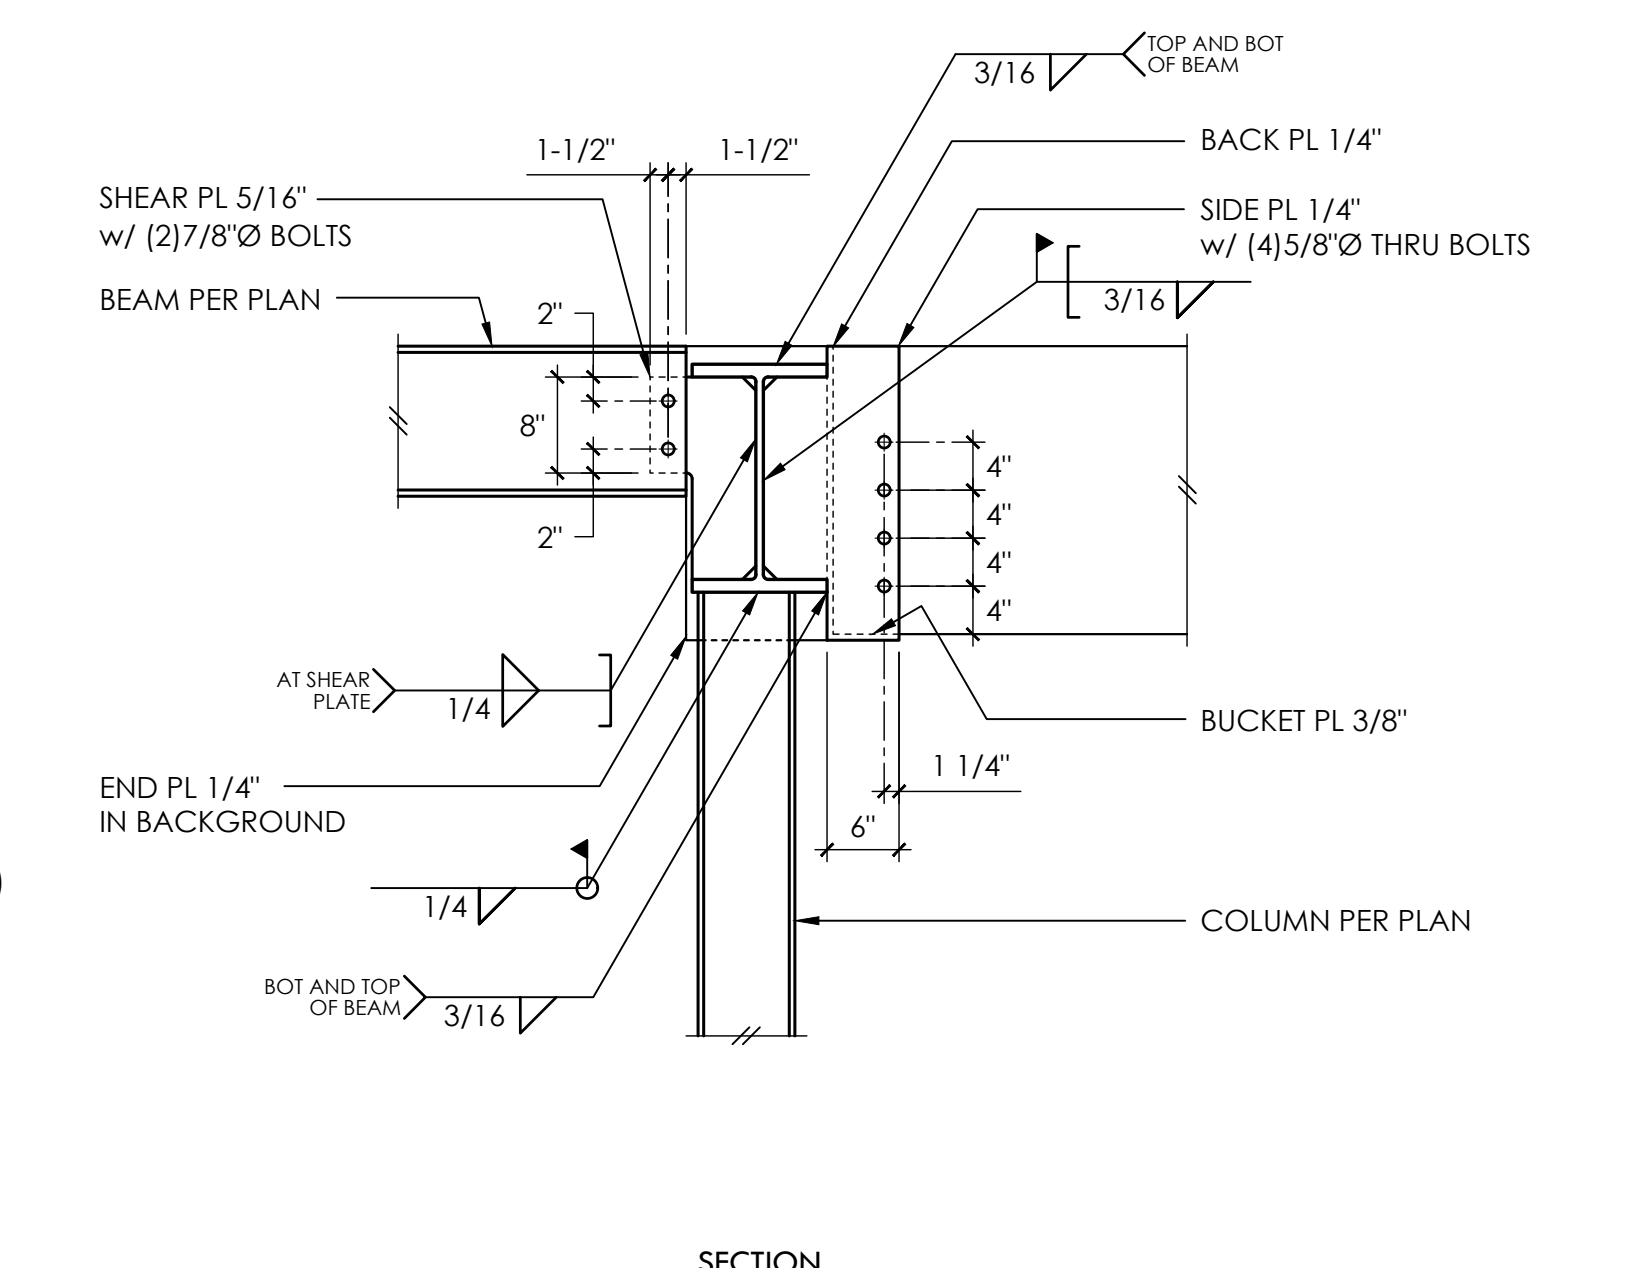


SECTION


15

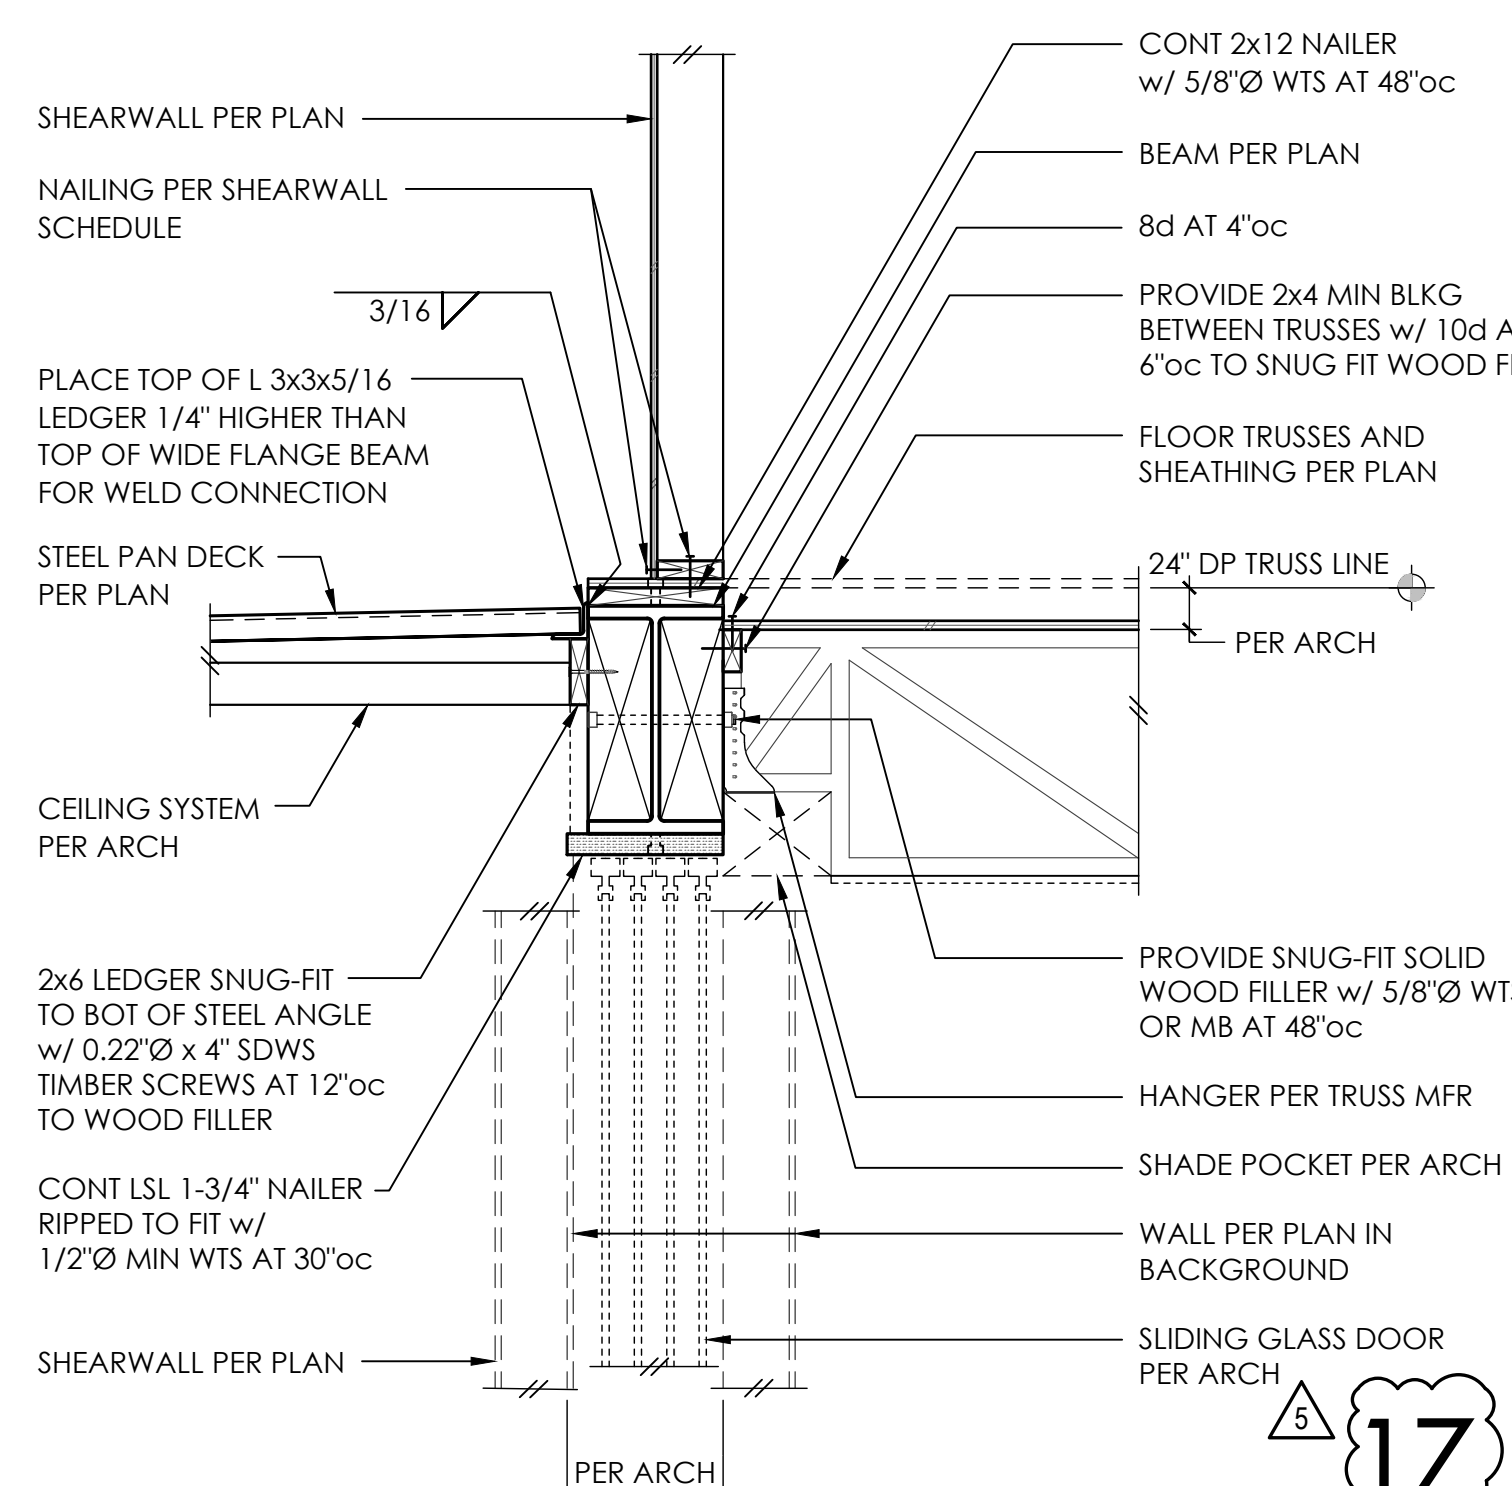


16

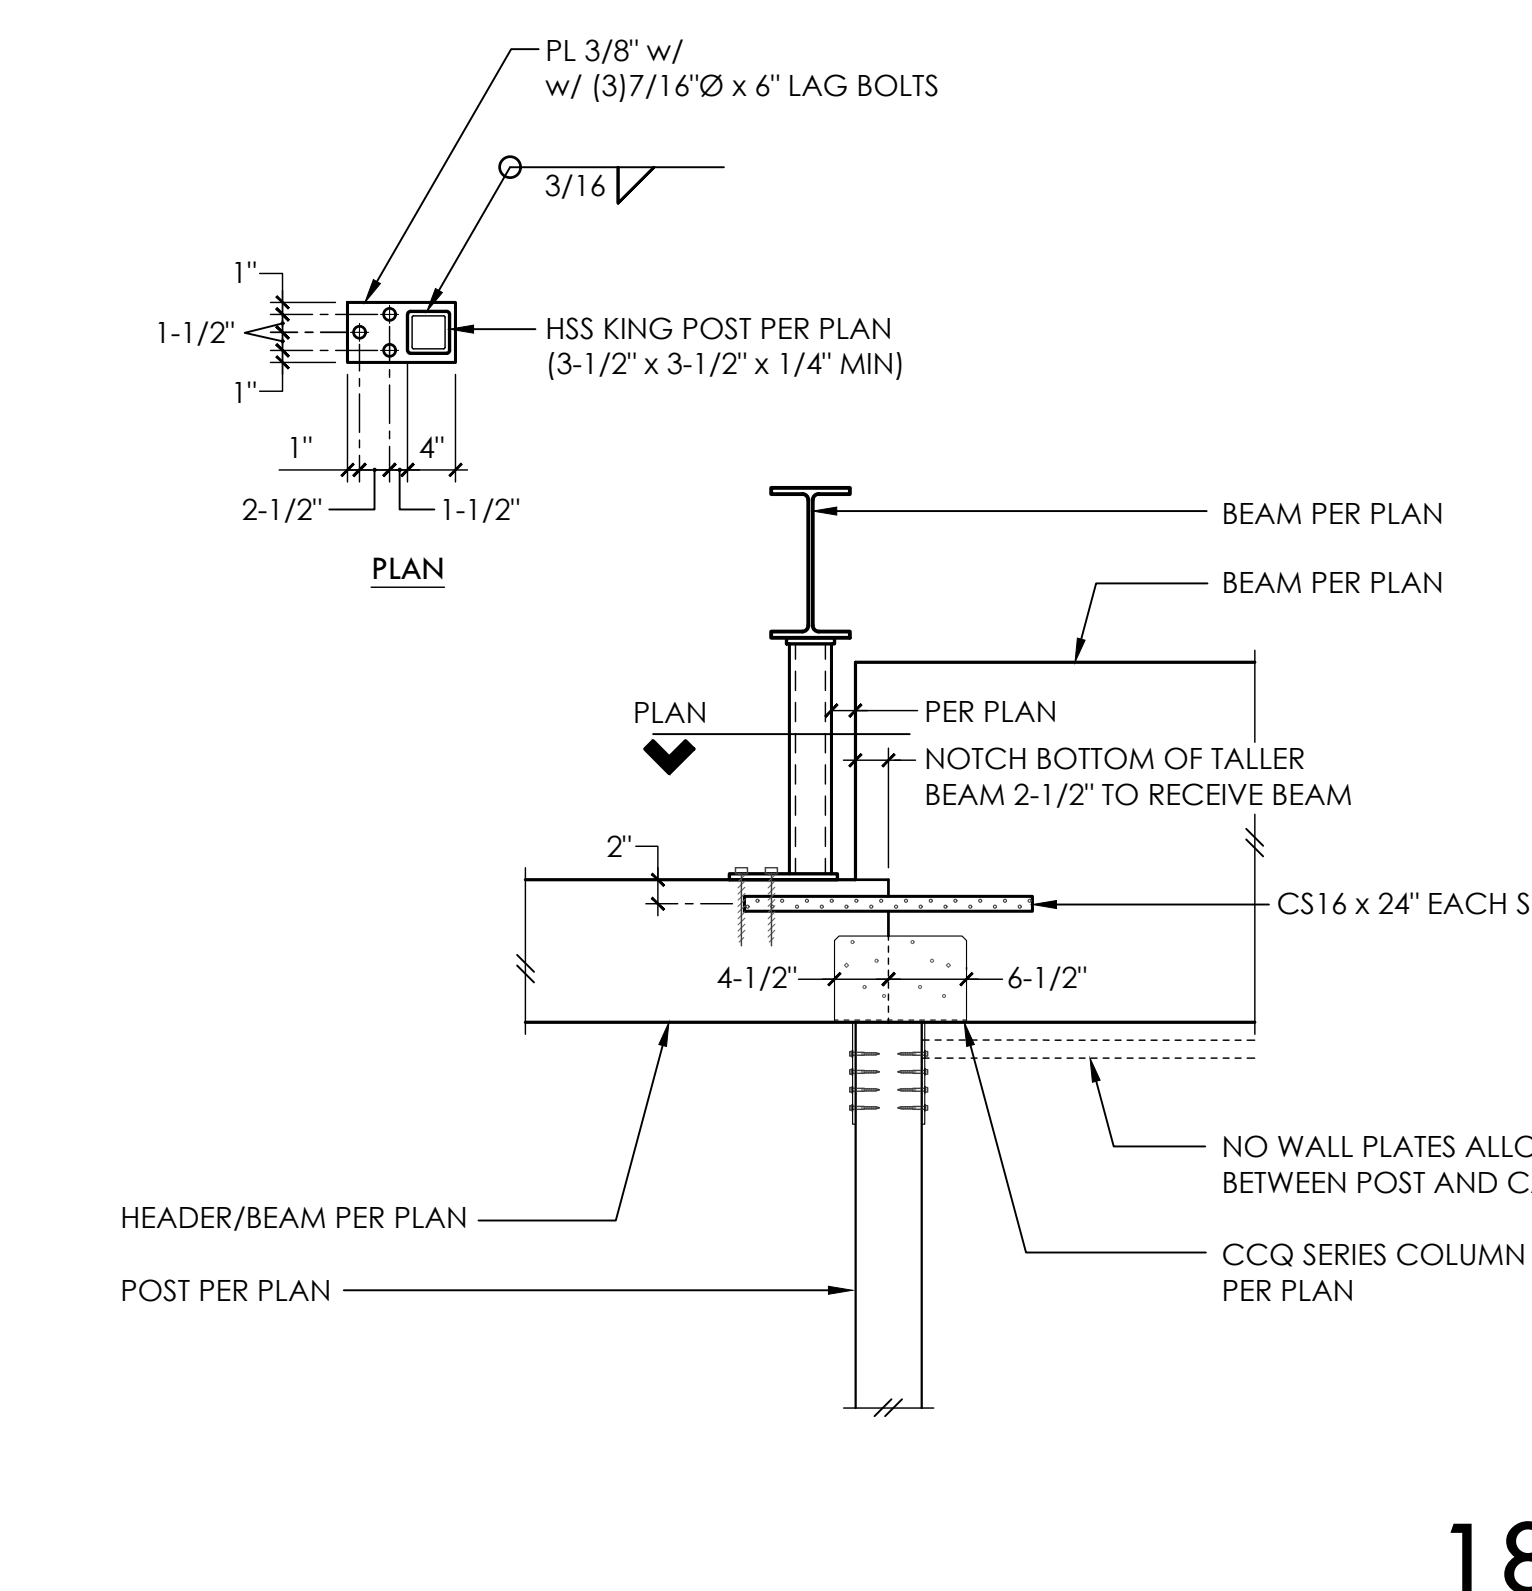

17

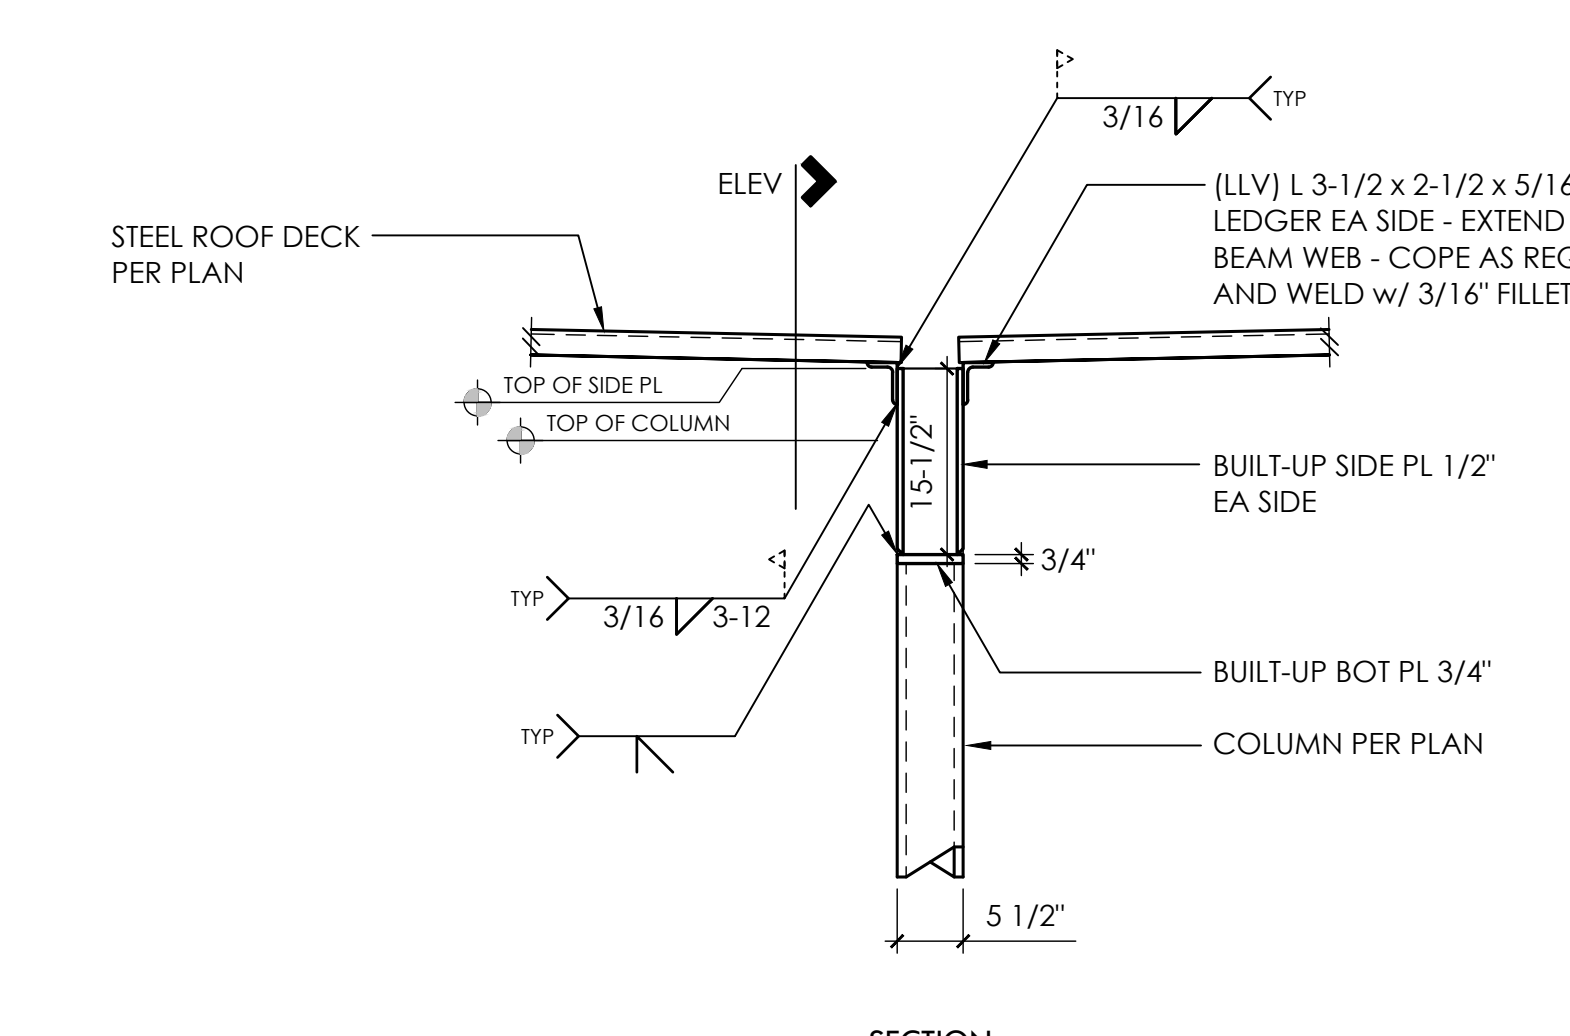

SECTION

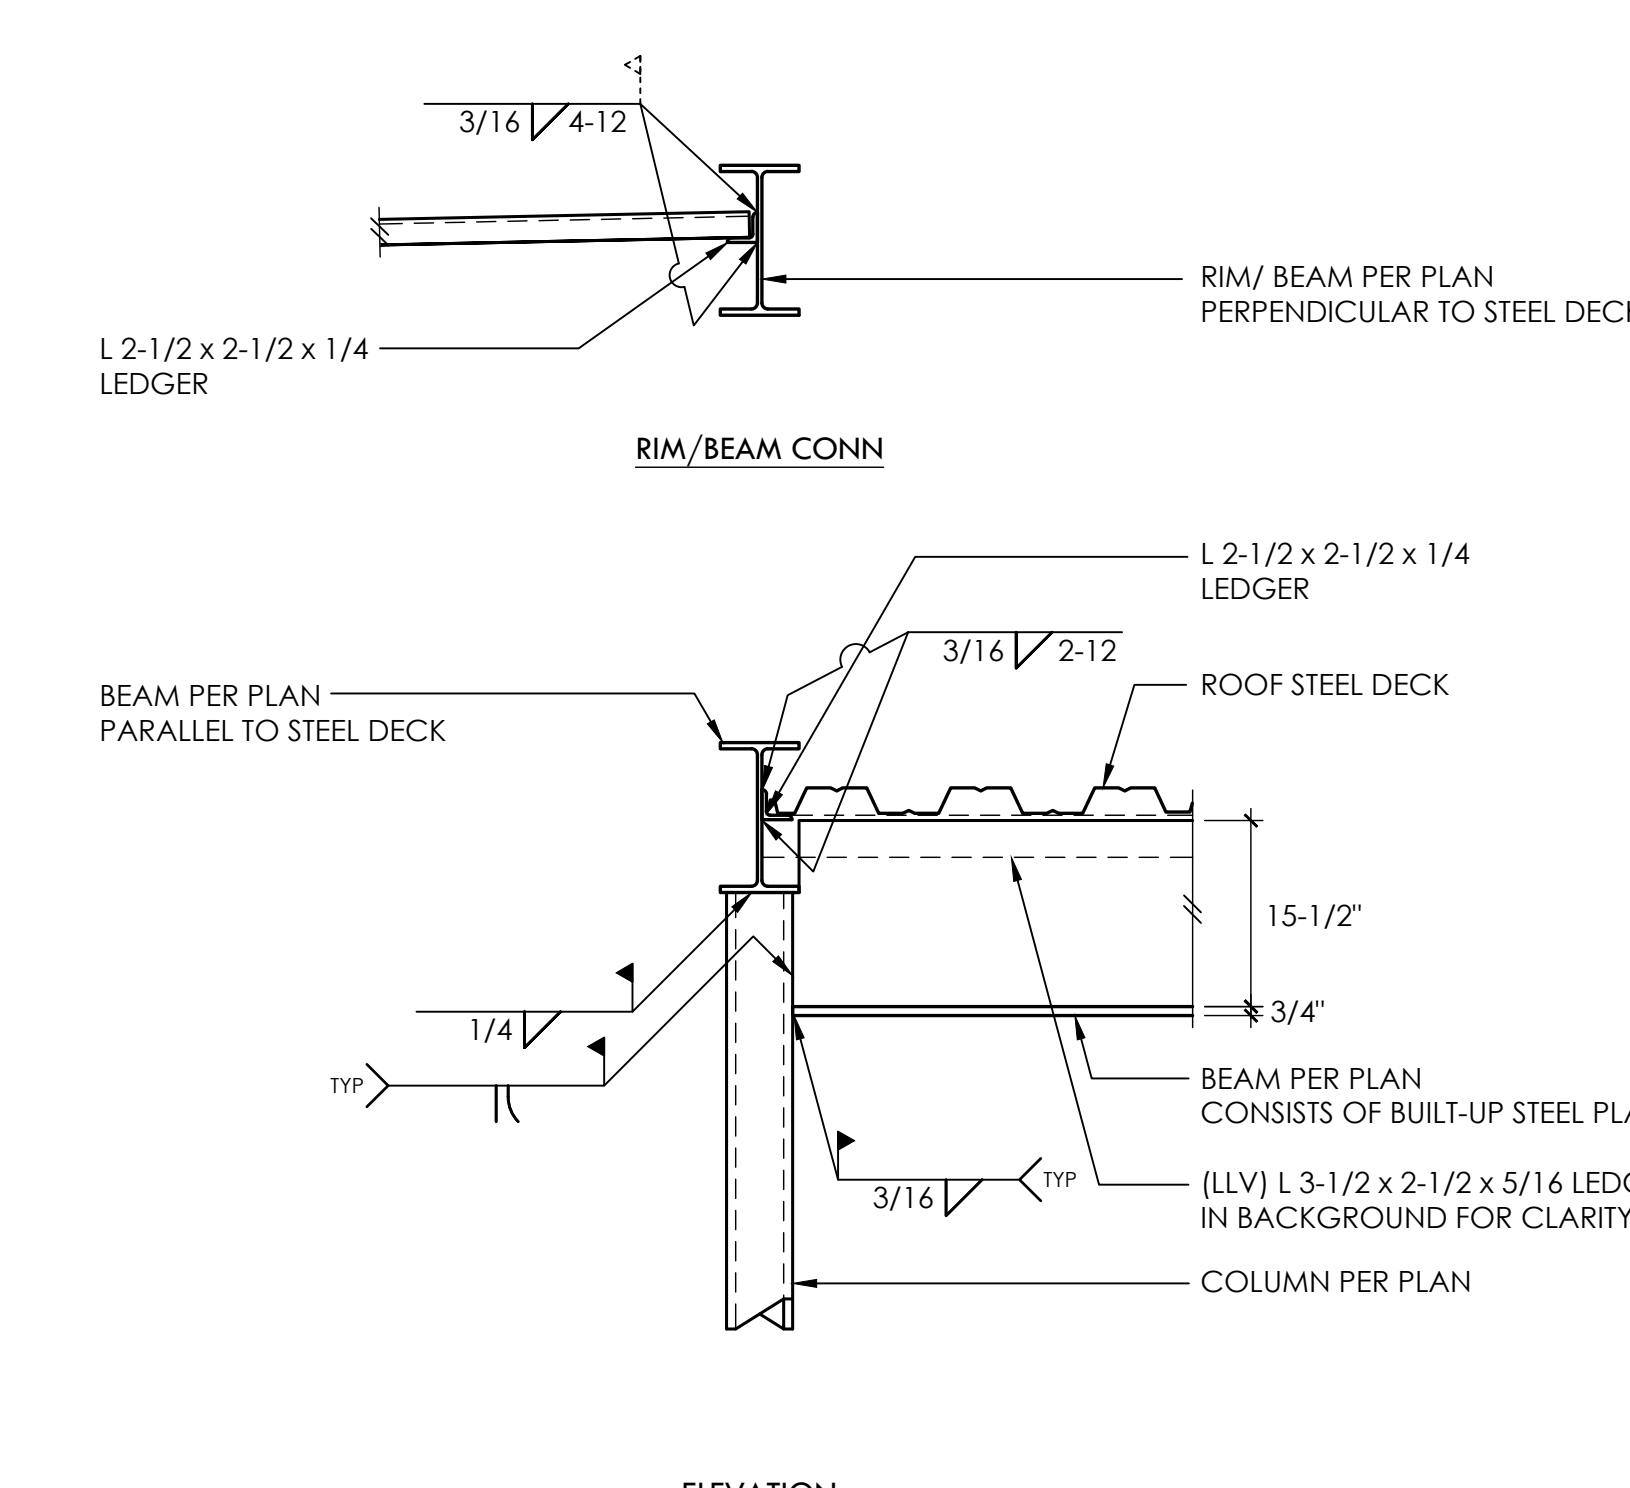

ELEVATION

20