CITY OF MERCER ISLAND
COMMUNITY PLANNING & DEVELOPMENT
RESIDENTIAL CODE COVERSHEET

(206) 275-7605 WWW.MERCERISLAND.GOV/CPD
EPERMIT.TECH@MERCERISLAND.GOV
DOCUMENTS ARE SUBJECT TO PUBLIC DISCLOSURE AS REQUIRED BY RCW 42.56

INSPECTION REQUESTS

CONSTRUCTION (206) 275-7730

FIRE INSPECTION eastsidefire-rescue.org

SF1
BUILDING PERMIT NUMBER

PROJECT NAME:

PROJECT ADDRESS:

PROJECT DESCRIPTION
This scope should match the Building Permit Application Form

PROJECT CONTACT INFORMATION
The Applicant shall provide the following information for each type of contact (Engineer and Geotech dependent on scope)

Permitting Contact:	Email:	Phone:
Construction Contact:	Email:	Phone:
Engineer:	Email:	Phone:
Geotech:	Email:	Phone:

DEFERRED SUBMITTALS
The Applicant is required to indicate all deferred submittals / shop drawings for submittal to the City for review and approval prior to item fabrication / construction. All deferred submittals require pre-approval from the City during the permit review process.

☐ No Deferred Submittals - all design included in these construction documents

☐ Connector plate wood roof trusses
☐ Metal joist / metal trusses
☐ Premanufactured structures (stairs, etc.)
☐ Exterior cladding
☐ Window wall / curtain wall construction
☐ Other:

ENERGY CODE AND WHOLE HOUSE VENTILATION INFORMATION
Indicate where the following information is located within the drawing set and select one box per line below.

Building Envelope- Define all components of the thermal envelope. Include U-factors, insulation and moisture control *WSEC Table 402.1.2* Sheet:

Energy Credit Information- Include complete information on plan for options selected and equipment specified *WSEC Tables 406.2 and 406.3* Sheet:

☐ No Credits Required ☐ Small Dwelling Unit ☐ Medium Dwelling Unit ☐ Large Dwelling Unit ☐ < 500 sf addition

New Construction Tests- The following are mandatory testing and reporting requirements of WSEC Ch 4 for new construction

● Certificate of Energy Efficiency *WSEC R401.3* ● Duct Leakage Testing *WSEC R403.3.5* ● Air Leakage Testing *WSEC R402.4.1.2*

☐ Air Leakage test report not to exceed 5 changes per hour *WSRC 1505.4.1.2* ☐ Air Leakage per selected energy credits

Whole House Ventilation- Specify system type below and include all system requirements on sheet noted *WSRC Section M1505.4* Sheet:

☐ Exhaust fans *WSRC 1505.4.1.2* ☐ Supply fans *WSRC 1505.4.1.3* ☐ Balanced system *WSRC 1505.4.1.4* ☐ Other permitted system

REQUIRED SPECIAL INSPECTIONS
The Applicant shall complete the following section. One of the options below must be selected prior to permit intake. Chapter 17 of the International Building Code (IBC) requires Special Inspection to evaluate components of construction that are critical to the safety of the structure. The project owner shall be responsible for contracting with and hiring the Special Inspection agents. Structural Special Inspectors are required to be certified by the Washington Association of Building Officials (WABO). Geotechnical Special Inspectors shall be a licensed Washington State Professional Engineer. Where Special Inspection is required, all reports shall be emailed to InspectionReports@mercergov.org **and** provided to the City Building Inspector at time of the City inspection.

Inspections by the City Building Inspector are required in addition to the Special Inspection.
Do not cover or conceal any work prior to the City inspection.

PRESCRIPTIVE DESIGN
☐ This project is entirely non-structural, or is designed following the prescriptive gravity and lateral provisions of the International Residential Code (IRC) only. There are no engineered components that have been designed to the IBC or its referenced standards, e.g. American Concrete Institute (ACI), National Design Specifications (NDS), etc. No Special Inspections are required by IRC.

MINOR STRUCTURAL WORK
☐ This project has limited engineered design as permitted by IRC Section R301.1.3 and the construction is of a minor nature as excepted by IBC Section 1704.2. This option must be reviewed and accepted by the building official prior to permit issuance and shall be reevaluated for project revisions and deferred submittals.

ENGINEERED DESIGN
☐ This project is engineered to the provisions of the IBC and its referenced standards. Per IBC Chapter 17, a *Statement of Special Inspection* shall be completed by the Registered Design Professional (RDP) in responsible charge. The *Statement of Special Inspections* on coversheet SF2 has been reviewed and completed by the RDP.

REQUIRED STRUCTURAL OBSERVATION
Structural Observation may be required by the Registered Design Professional (RDP) in responsible charge or by the building official per IBC Section 1704.6.1. The RDP shall submit written statements to the building official prior to the commencement of observations (identifying frequency and extent of observations) and at the conclusion of work included in the permit (describing the site visit(s) performed and identifying any deficiencies that have not been resolved). Submit all statements to inspectionreports@mercerisland.gov

Structural Observation for this project is required by the:
☐ Registered Design Professional ☐ Building Official *(City use only)*

GEOTECHNICAL INFORMATION
Per Mercer Island City Code, designated geologic hazard areas require a geotechnical report and a statement of risk from a geotechnical professional be included with the project submittal. Refer to MICC 19.07.160 (B)(3) for statement of risk, and City GIS at https://www.mercerisland.gov/igs for hazard mapping. Some proposals may require a site restoration bond.

NO GEOTECHNICAL REPORT REQUIRED
☐ No geotechnical report is required due to either: 1. The absence of geologic hazards on site or 2. Scope of project does not include foundation construction, excavation, or alterations to a hazard (if a report is available or referenced it should be provided)

GEOTECHNICAL REPORT IS REQUIRED AND INCLUDED WITH SUBMITTAL
☐ A geotechnical report is required and has been provided. All construction must comply with the recommendations of the geotechnical report, and a copy of the report and any other geotechnical information must be kept on site at all times.

Geotechnical Engineer:	Phone:	Project or report #:

SEASONAL DEVELOPMENT LIMITATION - MICC 19.07.160(F)(2) limits certain development between Oct 1 and Apr 1
☐ An application for Seasonal Development Limitation Waiver will be submitted and approved prior to any such activity.
☐ No grading or excavation will occur between October 1st and April 1st. SDL waiver not applicable.

The City requires an applicant paid peer review when the Building Official determines any of the following are present:
- Advanced excavation or foundation systems, i.e. soil nail walls, tieback shoring systems, etc.
- Foundation systems not supported on competent soils, i.e. over-excavation, soil preloading, etc.
- Projects that require slope stability analysis or those which could pose a significant risk to adjacent properties or structures.
- Where liquifaction presents significant risk (at waterfront or other high water table with seismic mapping)

TO BE COMPLETED BY APPLICANT
TO BE COMPLETED BY CITY

GENERAL REQUIREMENTS FOR ☐ NEW SINGLE FAMILY BUILD ☐ DEMOLITION/REBUILD ☐ ADDITION ☐ REMODEL ☐ REPAIR ☐ DOCK ☐ SITE IMPROVEMENTS ☐ SEISMIC RETRO
Construction of the project shall be from ***approved plans only***. No deviation from the approved project plans is allowed without prior approval from the City of Mercer Island.
Approved plans must be kept on site and maintained in good condition.

☑ Refer to "Conditions of Permit Approval" provided at permit issuance for required construction rules and regulations, including:
- Site Considerations
- Hours of Work
- Construction Vehicle Parking Restrictions
- Access Road Requirements
- ROW restrictions
- Drainage Requirements
- Sewer Requirements
- Water Service Requirements
- Additional Fire Code Requirements
- Planning Requirements
- Noise Abatement Certification
- Tree Requirements

☐ PRECONSTRUCTION MEETING REQUIRED. Refer to the "Preconstruction Meeting Checklist" notes for additional requirements.
☑ Temporary site address with minimum 6" high numbers visible from the street must be installed.
☑ Erosion control measures must be as shown on approved project drawings. All erosion control is to be in place and inspected prior to the start of any work.
☑ A City of Mercer Island Business License is required for all subcontractors. Call (206) 275-7602 for more information.
☑ Additional rockeries, patios, gravel or concrete paths, and other hardscape revisions to the project shall be submitted to the City for review and approval prior to installation.

LEGAL NONCONFORMANCE/STORMWATER THRESHOLD
Certain thresholds in the Land Use Code (MICC 19) or Stormwater Code (MICC 15.09) can have a significant impact on the requirements to conform with current code. Take special care to conform to the construction documents as-issued to avoid additional improvements.

☐ This project includes modification of legally nonconforming structures - MICC 19.01.050
☐ This project retains existing construction to limit calculation of *New Plus Replaced Hard Surface* - MICC 15.09

TREE REQUIREMENTS
TREE REMOVAL NOT SHOWN ON APPROVED PLAN MAY REQUIRE A SEPARATE TREE PERMIT - REFER TO MICC 19.10
☐ Tree protection as shown on approved drawings shall be installed at tree dripline prior to start of any site work and must remain in place throughout the project. Tree damage due to failure to follow approved plans shall result in fines per MICC 19.19.160.
☐ Replacement conifer trees must be a minimum of six feet tall at installation. Deciduous trees must have a minimum caliper of 1-1/2 inches. They must be planted and approved prior to final inspection.
For this project, _____ trees are authorized to be removed and replaced with _____ trees.
This project may be within a protected eagle nest area. Contact Federal Fish and Wildlife at (360) 534-9304 or visit their website at www.fws.gov/pacific/eagle.

FIRE PROTECTION REQUIREMENTS
Separate Permits are required for ***ALL*** fire protection systems. Fire Inspections can be requested at eastsidefire-rescue.org using the QR above, and require 48 hour advanced notice. Do not request fire inspections via MBP or on the general inspection line.

☐ Fire Sprinkler
☐ NFPA 13D
☐ Full Coverage
☐ NFPA 13R
☐ NFPA 13
☐ Approved Fire Code Alternatives (FCA):
☐ FCA1 _____
☐ FCA2 _____
☐ Monitored Household Fire Alarm per NFPA 72
☐ Monitored Sprinkler Water Flow Alarm
☐ Other: _____
☐ FCA3 _____
☐ FCA4 _____

WATER SERVICE REQUIREMENTS
☐ New or upsized water supply system required.
☐ Water service pre-con meeting and parts inspection are required prior to scheduling the water tap with the City. Schedule these inspections under the water service permit
☐ Applicant Installation.
☐ Minimum Service Line Size (main to meter): _____
☐ Minimum Supply Line Size (meter to house): _____
☐ Minimum Required Meter Size: _____
☐ Abandonment of existing service and meter required at main.
☐ City Inspector must verify water supply line (water meter to the house) sizing prior to final inspection. Upsizing may be required.

Additional water supply requirements:
- Contractor shall provide water supply that meets the required fire sprinkler system fire flow. Fire calculations or fire flow testing outcome may require a larger water service/meter or water supply line.
- Pressure reducing valve required if water pressure exceeds 80 psi.
- Reduced pressure backflow assembly (RPBA) required for all waterfront lots and for lots with potential connection to non-city water supply. See mercerisland.gov/backflow

For additional information about Water Service Inspection process: https://www.mercerisland.gov/cpd/page/water-service

STORMWATER MANAGEMENT
The storm drainage system shown on the approved plans shall be constructed and approved by the City Inspector prior to the construction of the roof, driveway, and other impervious surface that generate runoff from the project.

☐ Dispersion / Infiltration system _____
☐ On-site detention system (MR #5) _____
☐ Direct discharge to lake _____
☐ Rain Garden / Bioretention / Permeable Pavement _____
☐ Flow control system (MR #7) _____
☐ Run-off treatment (MR #8) _____
☐ Connect / Extend public drainage system _____
☐ Full size storm drainage as-builts _____
☐ Drainage review not required _____
☐ Other: _____

SIDE SEWER REQUIREMENTS
☐ Side sewer requires a backflow preventer due to: a connection to the lake line, or elevation of the lowest plumbing fixture is lower than the elevation of the upstream manhole rim, or side sewer is shared with one or more properties
☐ Video tape of existing sewer required (see standard details)
☐ New connection ☐ Connect to existing ☐ Disconnect permit required ☐ Reconnect permit required
☐ Other: _____

APPROVED CODE ALTERNATIVES
Code alternatives must be approved by the Building Official prior to permit issuance. All code alternatives must be inspected. Refer to the adjacent Required Construction Inspections checklist.

☐ CA1: _____
☐ CA2: _____

PROJECT ALERTS AND NOTES TO INSPECTORS

WILDLAND/URBAN INTERFACE
-RESERVED FOR FUTURE USE-

TO BE COMPLETED BY APPLICANT
TO BE COMPLETED BY CITY

REQUIRED CONSTRUCTION INSPECTIONS
It is the applicant's responsibility to contact CPD to schedule ALL inspections applicable to the project. Request inspections online at www.MyBuildingPermit.com or by calling the Inspection Hotline at (206) 275-7730. Each MBP inspection type is in [square brackets]. Refer to FIRE PROTECTION REQUIREMENTS for information on scheduling a fire inspection.

Inspections marked with "*" are not building permit inspections, and should be requested under the appropriate permit number. Refer to the packet provided at permit issuance or search by address at mybuildingpermit.com for other issued permit numbers.

INSPECTIONS: (Listed in order of typical sequencing)

Inspector	Date	Approved	N/A	Inspection Description	MBP.com Inspection Name	PARTIAL 1	PARTIAL 2	PARTIAL 3
		☐	☐	Pre-construction Meeting to Review Conditions of Permit Approval	[PRE-CON MTG GENERAL]	☐	☐	☐
		☐	☐	Tree protection	[TREE PROTECTION]	☐	☐	☐
		☐	☐	Erosion control	[EROSION CNTROL]	☐	☐	☐
	*	☐	☐	Sewer disconnect and cap	[SIDE SEWER DISCONNEC]	☐	☐	☐
	*	☐	☐	Right-of-way use or work / easement, material delivery, etc. If applicable, separate ROW permit required	[ROW OR UTILITY IMPRO]	☐	☐	☐
	*	☐	☐	Land clearing, grading and demolition	[FINAL DEMO]	☐	☐	☐
		☐	☐	Pilings / Shoring / Shotcrete. If applicable, provide survey letter (property line); Geotechnical Engineer / Special Inspector reports of inspections (pile and shoring installation, etc.)	[FOUNDATION WALLS/CON]	☐	☐	☐
		☐	☐	Footings, setbacks, UFER ground. If applicable, provide survey letter (building height and setbacks); Special Inspector reports of inspections (soil bearing capacity, compaction, earthwork, pile installation, etc.)	[FOOTINGS, SETBACKS, U]	☐	☐	☐
		☐	☐	Foundation walls / concrete columns	[FOUNDATION WALLS/CON]	☐	☐	☐
	*	☐	☐	Roof and footing drains	[CONVEYANCE FACILITIE]	☐	☐	☐
		☐	☐	Foundation dampproofing	[FOUND DAMP PROOFING]	☐	☐	☐
	*	☐	☐	Storm drainage, including (but not limited to) ◦ Connections to storm main in ROW ◦ Area drains ◦ Det systems / Conveyance / Flow control ◦ Storm drain in ROW ◦ Infiltration systems / L.I.D. systems ◦ Pump systems ◦ Catch basins ◦ Retaining wall drainage	[CONVEYANCE FACILITIE]	☐	☐	☐
	*	☐	☐	Water Service	[3. WATER SERVICE TAP]	☐	☐	☐
		☐	☐	Water Supply	[WATER SUPPLY LINE]	☐	☐	☐
	*	☐	☐	Side sewer installation, including (but not limited to) ◦ Connections to side sewer main ◦ Back-flow valves ◦ Connections to existing side sewer ◦ Grinder pump systems	[SIDE SEWER INSTALLAT]	☐	☐	☐
	*	☐	☐	Driveway / Access road	[ROW OR UTILITY IMPRO]	☐	☐	☐
		☐	☐	Underslab electrical / mechanical / plumbing	[UNDER-SLAB ELECT/MEC]	☐	☐	☐
		☐	☐	Underslab insulation / vapor barrier / reinforcing	[UNDER-SLAB INSULATIO]	☐	☐	☐
		☐	☐	Underfloor framing	[UNDER-FLOOR FRAMING]	☐	☐	☐
		☐	☐	Nailing-Roof sheathing (See SF2 for Required Agency Inspection)	[NAILING-ROOF SHEATHING]	☐	☐	☐
		☐	☐	Shear wall construction (See SF2 for Required Agency Inspection)	[NAILING-EXTERIOR WALL]	☐	☐	☐
		☐	☐	Rough hydronic installation	[ROUGH HYDRONIC PIPIN]	☐	☐	☐
		☐	☐	Rough electric installation	[ROUGH ELECTRIC]	☐	☐	☐
	*	☐	☐	Rough fire alarm (wiring inspection)	[ROUGH-IN LOW VOLTAGE]	☐	☐	☐
		☐	☐	Rough plumbing installation (DWV, water)	[ROUGH PLUMBING]	☐	☐	☐
		☐	☐	Rough mechanical	[ROUGH MECHANICAL/HVA]	☐	☐	☐
		☐	☐	Electrical service	[ELECTRICAL SERVICE]	☐	☐	☐
		☐	☐	Gas Piping & Test	[GAS PIPING/TEST]	☐	☐	☐
	*	☐	☐	Rough fire sprinkler / hydrostatic and flow (bucket) test	[ROUGH SPRINKLER RES/STATUS]	☐	☐	☐
		☐	☐	Framing and glazing. (See SF2 for Required Agency Inspection)	[FRAMING (& GLAZING)]	☐	☐	☐
		☐	☐	Masonry construction (fireplace / walls / veneer / etc.)	[MASONRY]	☐	☐	☐
		☐	☐	Insulation installation	[INSULATION]	☐	☐	☐
		☐	☐	Stucco (paper and lath)	[STUCCO]	☐	☐	☐
		☐	☐	Shower pan (or tub)	[SHOWER PAN (OR TUB)]	☐	☐	☐
		☐	☐	Weather exposed balcony and walking surface waterproofing	[ROOF DECK WATERPROOFING]	☐	☐	☐
		☐	☐	Code Alternative CA1	[CODE ALT 1]	☐	☐	☐
		☐	☐	Code Alternative CA2	[CODE ALT 2]	☐	☐	☐

FINAL INSPECTIONS

Inspector	Date		
		☐	**Final Tree Inspection:** Tree Restoration [FINAL_TREE]
		☐	**Final Fire Inspection:** Fire protection [FINAL FIRE_ALL SYSTEMS/ACCESS] ◦ Sprinkler ◦ Fuel Tank Installation ◦ Access Road ◦ Fire Extinguishing System ◦ Fire Code Alternatives (see below) ◦ Fire Alarm System ☐ FCA1 ☐ FCA3: ☐ FCA2 ☐ FCA4:
		☐	**Final Civil Inspection:** Site and utility, landscape, utilities, ROW, and Site [FINAL_CIVIL] Water supply protection/Backflow devices for: ◦ Waterfront property ◦ Well water on property ◦ Fire / lawn sprinkler ◦ Boiler
		☐	**Final Building Inspection:** [FINAL_BUILDING] provide closeout (summary) letters from Engineer, Special Inspectors, Geotechnical Engineer, and EIFS inspectors. **Final MEP Inspections:** ☐ Mech ☐ Electrical ☐ Plumbing
		☐	**Impact Fees Paid** (If applicable)

TCO APPROVALS

Inspector	Date	
		☐ [TCO_TREE]
		☐ [TCO_FIRE]
		☐ [TCO_CIVIL]
		☐ [TCO_BLDG]

90 DAY TEMPORARY CERTIFICATE OF OCCUPANCY (TCO)
Applicant option. Additional fees required. All TCO Approvals above must be complete.

_____ *Approved* _____ *Start Date* _____ *End Date*

ADDITIONAL REQUIRED CITY INSPECTIONS
Use the contact information below to arrange these additional inspections.

Required Inspection(s):	Contact:	Contact email:

IMPACT FEES
If required for the project but deferred beyond permit issuance.

☐ Impact fees apply and are due ***prior*** to Final Inspection or on _____ *Date*, whichever occurs first.

PLAN REVIEW APPROVALS
Not all review disciplines may be required to review the documents.

Building	*Planning*	*Engineering*	*Tree*	*Fire*
_____	_____	_____	_____	_____
Date	*Date*	*Date*	*Date*	*Date*

CERTIFICATE OF OCCUPANCY
Issued after all required inspections have been performed and approved.

_____ *Approved* _____ *Date*

APPROVED DRAWINGS MUST BE KEPT ON THE BUILDING SITE AT ALL TIMES

REVIEWED FOR CODE COMPLIANCE

_____ *Approved* _____ *Date*

FILE NAME: *CPD CVR PG1 2023v1a.dwg Code Revision: 2021 WSRC*

CITY OF MERCER ISLAND
COMMUNITY PLANNING & DEVELOPMENT
THIRD PARTY INSPECTIONS

(206) 275-7605 WWW.MERCERISLAND.GOV/CPD
EPERMIT.TECH@MERCERISLAND.GOV
DOCUMENTS ARE SUBJECT TO PUBLIC DISCLOSURE AS REQUIRED BY RCW 42.56

INSPECTION REQUESTS
Request inspections online via QR code or voicemail
FIRE INSPECTION
(206) 275-7979
ALL OTHER INSPECTION
(206) 275-7730

REQUIRED SPECIAL INSPECTIONS

Indicate on the form below the required Special Inspections for this project. Special Inspections are regulated by IBC Section 1705. If the method of construction is included in project scope, the inspections are required.

REGISTERED DESIGN PROFESSIONAL

IBC Section 1704.2.3 requires the Registered Design Professional (RDP) in Responsible Charge to complete a *Statement of Special Inspections*. For City of Mercer Island permitting purposes, submitting this document is confirmation that the RDP has completed and reviewed the Special Inspections requirements and acknowledges this information complies with IBC Section 1705.

Name: | License Number: | License Type: | License Expiration:

SPECIAL INSPECTION DESCRIPTION		APPROVALS: Special Inspector sign-off	APPROVALS: City Inspector sign-off
ALTERNATIVE MATERIALS AND SYSTEMS (IBC 1705.1)			
Construction materials and systems that are alternatives to materials and systems prescribed by the IBC.	Notes:		
Unusual design applications of materials described in the code.	Notes:		
Materials and systems required to be installed in accordance with additional manufacturer's instructions that prescribe requirements not contained in the IBC or in standards referenced by the IBC.	Notes:		

SPECIAL INSPECTION DESCRIPTION	REFERENCES	SPECIAL INSP REQUIRED	FREQUENCY	APPROVALS: Special Inspector sign-off	APPROVALS: City Inspector sign-off
STEEL CONSTRUCTION (IBC 1705.2)					
Structural Steel: Special Inspections for structural steel shall be in accordance with the inspection requirements of AISC 360 Chapter N.	AISC 360 Chapter N	☐	Per Standard		
Quality Control: Procedures specified by the fabricator and erector to ensure that work is performed in accordance with AISC specification and the construction documents	AISC 360 Section N5 (1)	☐	Per Standard		
Quality Assurance: Review and inspection performed by an agency hired by the owner to ensure work is performed in accordance with the construction documents	AISC 360 Section N5 (2)	☐	Per Standard		
Cold Formed Steel Deck: Special Inspections and qualifications or welding special inspectors for cold form set floor and roof deck shall be in accordance with Steel Deck Institute QA/QC.	Steel Deck Institute QA/QC	☐	Per Standard		
Open-Web Steel Joists and Joist Girders: *End connections: welding or bolting.*	SJI Specification per IBC 2207.1	☐	Periodic		
Bridging: horizontal or diagonal.	SJI Specification per IBC 2207.1	☐	Periodic		
Standard Bridging.	SJI Specification per IBC 2207.1	☐	Periodic		
Bridging that differs from SJI Specifications listed in Section 2207.1.	SJI Specification per IBC 2207.1	☐	Periodic		
Temporary and permanent restraint / bracing of cold-formed trusses over 60 feet.	IBC 1705.2.4	☐	Periodic		
CONCRETE CONSTRUCTION (IBC 1705.3) [a.]					
Inspect reinforcement, including prestressing tendons, and verify placement	ACI 318 Ch 20, 25.2, 25.3, 26.5.1-26.5.3	☐	Periodic		
Reinforcing bar welding: *Verify weldability of reinforcing bars other than ASTM A706.*	AWS D1.4 ACI 318 Ch 26.6.4	☐	Periodic		
Inspect single-pass fillet welds, maximum 5/16 inches.	AWS D1.4 ACI 318 Ch 26.6.4	☐	Periodic		
Inspect all other welds.	AWS D1.4 ACI 318 Ch 26.6.4	☐	Continuous		
Inspect anchors cast in concrete.	ACI 318 Ch 17.8.2	☐	Periodic		
Anchors post-installed in hardened concrete members: *Adhesive anchors installed in horizontally or upwardly inclined orientations to resist sustained tension loads.*	ACI 318 Ch 17.8.2.4	☐	Continuous		
All other post-installed mechanical and adhesive anchors.	ACI 318 Ch 17.8.2	☐	Periodic		
Verify use of required design mix.	ACI 318 Ch 19, 26.4.3, 26.4.4; IBC 1904.1, 1904.2, 1908.2, 1908.3	☐	Periodic		
Prior to concrete placement, fabricate specimens for strength tests, perform slump and air content tests, and determine the temperature of the concrete.	ASTM C 172, ASTM C31 ACI 318 Ch 26.5, 26.12	☐	Continuous		
Inspect concrete and shotcrete placement for proper application techniques.	ACI 318 Ch 26.5	☐	Continuous		
Verify maintenance of specified curing temperature and techniques.	ACI 318 Ch 26.5-26.5.5	☐	Periodic		
Prestressed concrete: *Application of prestressing forces.*	ACI 318 Ch. 26.10	☐	Continuous		
Grouting of bonded prestressing tendons.	ACI 318 Ch. 26.10	☐	Continuous		
Inspect erection of precast concrete members.	ACI 318 Ch. 26.9	☐	Periodic		
Precast concrete diaphragm connections	ACI 318 Ch. 26.13.1.3	☐	Periodic		
Precast diaphragm installation tolerances	ACI 550.5	☐	Continuous		
Verify in-situ concrete strength prior to stressing of tendons in post-tensioned concrete and prior to removal of shores and forms from beams and structural slabs.	ACI 318 Ch. 26.11.2	☐	Periodic		
Inspect formwork for shape, location and dimensions of the concrete member being formed	ACI 318 Ch. 26.11.2(b)	☐	Periodic		
MASONRY CONSTRUCTION (IBC 1705.4) [b.]					
Empirically designed masonry, glass unit masonry, or masonry veneer as part of a Risk Category IV structure requiring Level B Quality Assurance per ACI 530	ACI 530 Chapter 3 IBC 1705.4	☐	Per Standard		
Vertical masonry foundation elements requiring Quality Assurance per ACI 530	ACI 530 Chapter 3 IBC 1705.4	☐	Per Standard		
WOOD CONSTRUCTION (IBC 1705.5)					
High-Load diaphragms: *Panel thickness, framing member sizes, and nail or staple diameters and patterns (includes any diaphragms utilizing more than one row of fasteners at edges designed per IBC Section 2306.2/SDPWS 4.2.7.1.2);*	IBC 1705.5.1	☐	Periodic		
Metal-plate-connected wood trusses spanning 60 feet or greater: *Verify temporary and permanent individual truss member restraint / bracing are installed in accordance with approved truss submittal package.*	IBC 1705.5.2	☐	Periodic		
Mass timber construction per IBC Table 1705.5.3	IBC 1705.5.3	☐	Periodic		
Mass timber (upwardly inclined adhesive anchors)	IBC 1705.5.3	☐	Continuous		

a. Concrete special inspection not required where work meets the exceptions listed in IBC Section 1705.3

b. Masonry special inspection not required where work meets the exceptions listed in IBC Section 1705.4

SPECIAL INSPECTION DESCRIPTION	REFERENCES	SPECIAL INSP REQUIRED	FREQUENCY	APPROVALS: Special Inspector sign-off	APPROVALS: City Inspector sign-off
SOILS (IBC 1705.6)					
Verify materials below shallow foundations are adequate to achieve the design bearing capacity.	Geotechnical Report	☐	Periodic		
Verify excavations are extended to proper depth and have reached proper material.	Geotechnical Report	☐	Periodic		
Perform classification and testing of compacted fill materials.	Geotechnical Report	☐	Periodic		
Verify use of proper materials, densities and lift thicknesses during placement and compaction of compacted fill.	Geotechnical Report	☐	Continuous		
Prior to placement of compacted fill, inspect subgrade and verify that site has been prepared properly.	Geotechnical Report	☐	Periodic		
DRIVEN DEEP FOUNDATIONS (IBC 1705.7)					
Verify element materials, sizes and lengths comply with the requirements noted in the drawings and geotechnical report.	Geotechnical Report, Construction Documents	☐	Continuous		
Determine capacities of test elements and conduct additional load tests, as required.	Geotechnical Report, Construction Documents	☐	Continuous		
Inspect driving operations and maintain complete and accurate records for each element.	Geotechnical Report, Construction Documents	☐	Continuous		
Verify placement locations and plumbness, confirm type and size of hammer, record number of blows per foot of penetration, determine required penetrations to achieve design capacity, record tip and butt elevations and document any damage to foundation element.	Geotechnical Report, Construction Documents	☐	Continuous		
For steel elements, perform additional Special Inspections in accordance with Section 1705.2.	Geotechnical Report, Construction Documents	☐			
For concrete elements and concrete-filled elements, perform additional Special Inspections in accordance with Section 1705.3.	Geotechnical Report, Construction Documents	☐			
For specialty elements, perform additional Special Inspections as determined by the Registered Design Professional in responsible charge.	Geotechnical Report, Construction Documents	☐			
CAST-IN-PLACE DEEP DRIVEN FOUNDATIONS (IBC 1705.8)					
Inspect drilling operations and maintain complete and accurate records for each element	Geotechnical Report, Construction Documents	☐	Continuous		
Verify placement locations and plumbness, confirm element diameters, bell diameters (if applicable), lengths, embedment into bedrock (if applicable), and adequate end-bearing strata capacity. Record concrete or grout volumes.	Geotechnical Report, Construction Documents	☐	Continuous		
For concrete elements, perform additional Special Inspections in accordance with Section 1705.3.	Geotechnical Report, Construction Documents	☐			
HELICAL PILE FOUNDATIONS (IBC 1705.9)					
Record installation equipment used, pile dimension, tip elevations, final depth, final installation torque and other pertinent installation information as determined by the Registered Design Professional in responsible charge.	Geotechnical Report, Construction Documents	☐	Continuous		
SPECIAL INSPECTION FOR WIND RESISTANCE (IBC 1705.11) [c.]					
Structural wood wind resistance elements: *Field gluing of wood elements of the windforce-resisting system.*	IBC 1705.11.1, Construction Documents	☐	Continuous		
Nailing, bolting, anchoring and other fastening of wood elements of the main windforce-resisting system, including wood shear walls, wood diaphragms, drag struts, braces and hold-downs. [d.]	IBC 1705.11.1, Construction Documents	☐	Periodic		
Cold-formed steel light-frame wind resistance elements: *Welding operations of cold-formed steel light-frame elements of the main windforce-resisting system.*	IBC 1705.11.2, Construction Documents	☐	Periodic		
Screw attachment, bolting, anchoring, and other fastening of elements of cold-formed steel light-frame elements of the main windforce-resisting system, including shear walls, braces, diaphragms, drag struts and hold-downs. [d.]	IBC 1705.11.2, Construction Documents	☐	Periodic		
Fastening of the following systems and components: *Roof covering, roof deck and roof framing connections.*	IBC 1705.11.3 (1), Construction Documents	☐	Periodic		
Exterior wall covering and wall connections to roof and floor diaphragms and framing.	IBC 1705.11.3 (2), Construction Documents	☐	Periodic		

c. Special inspection required in wind Exposure Category C or D per IBC Section 1705.11 (2).
d. Special inspection not required where wood or steel structural panels are on only one side of the shear wall and the fastener spacing for the sheathing is greater than 4 inches on center.

SPECIAL INSPECTION DESCRIPTION	REFERENCES	SPECIAL INSP REQUIRED	FREQUENCY	APPROVALS: Special Inspector sign-off	APPROVALS: City Inspector sign-off
SPECIAL INSPECTION FOR SEISMIC RESISTANCE (IBC 1705.12) [e.]					
Structural steel seismic force-resisting systems: *Special Inspections of MLFRS shall be in accordance with AISC 341 Chapter J. Submit all documents referenced in Section J3 "Quality Assurance Agency Documents" to the city for review.*	IBC 1705.12.1.1, AISC 341 *Seismic Provisions for Structural Steel Buildings*	☐	Per Standard		
Special inspection of structural steel elements shall be in accordance with AISC 341 Chapter J. Submit all documents referenced in Section J3 "Quality Assurance Agency Documents" to the city for review.	IBC 1705.12.1.2, AISC 341 *Seismic Provisions for Structural Steel Buildings*	☐	Per Standard		
Structural wood seismic force-resisting systems: *Special inspection during field gluing operations for elements of the seismic force-resisting system.*	IBC 1705.12.2 (1)	☐	Continuous		
Special inspection required for nailing, bolting, anchoring, and other fastening of elements of the seismic force-resisting system including wood shear walls, wood diaphragms, drag struts, braces, shear panels and hold-downs. [f.]	IBC 1705.12.2 (2)	☐	Periodic		
Cold-formed steel light-frame seismic force-resisting systems: *Special inspection during welding operations for elements of the seismic force-resisting system.*	IBC 1705.12.3 (1)	☐	Periodic		
Special inspection required for screw attachment, bolting, anchoring, and other fastening of elements of the seismic force-resisting system including shear walls, drag struts, braces, diaphragms and hold-downs.	IBC 1705.12.3 (2)	☐	Periodic		

e. Required where any of the following conditions exist (refer ASCE 7 Section 12.3): *Torsional or extreme torsional irregularity* *Nonparallel systems irregularity* *Stiffness (soft story) or extreme stiffness (extreme soft story) irregularity* *Discontinuity in lateral strength (weak story irregularity)*
f. Special inspection not required where wood or steel structural panels are on only one side of the shear wall and the fastener spacing for the sheathing is greater than 4 inches on center.

SPECIAL INSPECTION DESCRIPTION	REFERENCES	SPECIAL INSP REQUIRED	FREQUENCY	APPROVALS: Special Inspector sign-off	APPROVALS: City Inspector sign-off
SPRAYED FIRE-RESISTANT MATERIALS (IBC 1705.14)					
Special inspection and testing shall be per IBC Sections 1705.14.1 through 1705.14.6 as applicable.	IBC 1705.14	☐			
MASTIC AND INTUMESCENT FIRE RESISTANT COATINGS (IBC 1705.15)					
Special inspection is required for fire-resistant coatings applied to structural elements and decks.	AWCI 12-B, Construction Documents	☐			
EXTERIOR INSULATION AND FINISH SYSTEMS (IBC 1705.16)					
Special inspection and testing shall be provided for all EIFS applications. [g. h.]		☐			
Special inspection is required for water-resistive barrier complying with ASTM E 2570 when installed over a sheathing substrate.	ASTM E 570	☐			

g. Special inspection not required for EIFS applications where installed over water-resistive barrier with a means of draining moisture to the exterior.
h. Special inspection is not required for EIFS applications installed over masonry or concrete walls.

TO BE COMPLETED BY RDP
TO BE COMPLETED BY CITY

MERCER ISLAND REQUIRED AGENCY INSPECTIONS:

Reports documenting the quality of these types of construction are required by the Building Official as authorized by IRC Section R104.4x. The reports must be prepared by a WABO certified inspector for the specific type of construction, as indicated in the description, or as otherwise authorized by the Building Official.

AGENCY INSPECTION DESCRIPTION	REFERENCES	AGENCY INSPECTION REQUIRED	FREQUENCY	APPROVALS: Agency Inspector sign-off	APPROVALS: City Inspector sign-off
EXTERIOR PLASTER (IRC 703.7) [i.]					
Installation: *Lath and lath attachment.*	ASTM C 926, ASTM C 1063 IRC R703.7.1	☐	Periodic		
Portland Cement plaster mix, number of coats, thickness of coats.	IRC Tables R702.1(1), 702.1(3) IRC R703.7.2				
Weep screed material, attachment and location.	ASTM C 926, IRC R703.7.2.1				
Water resistive barrier installation, flashing installation, and drainage.	IRC R703.2, IRC R703.4, IRC R703.7.3				
Application of each coat and minimum curing.	ASTM C 926, IRC R703.7.4, IRC R703.7.5				
EXTERIOR INSULATION AND FINISH SYSTEM (IRC 703.7) [j.]					
Installation: *Installed in accordance with EIFS manufacturer's instructions.*	ASTM E 2568 IRC R703.9	☐	Periodic		
Drainage provided over all wall assemblies except substrates of masonry or concrete. Drainage shall have a 90 percent efficiency. EIFS and EIFS drainage shall terminate not less than 6 inches above finish grade.	ASTM 2273, ASTM E 2570, IRC R703.2				
Flashing shall be shall be provided per IRC R703.8. Decorative trim shall not be face-nailed through the EIFS.	IRC R703.8, IRC R703.4, IRC R703.7.3				
LATERAL RESISTING SYSTEM					
Installation: *Shearwall and diaphragm sheathing, panel edge and field nailing.*	Construction Documents	☐	Periodic		
Lateral load path continuity, i.e. roof and floor diaphragm to shearwall top plate below, shearwall to foundation.	Construction Documents				
Collector / drag strut nailing and connections. Holdown installation and location.	Construction Documents				
RESIDENTIAL WASHINGTON STATE ENERGY CODE					
Air Leakage Control: *Tested and verified as having an air leakage rate not exceeding 5 air changes per hour.*	WSEC R402.4.1.2	☐			
Tested and verified as having an air leakage rate not exceeding 3 air changes per hour as required by Energy Credit 2a.	WSEC R402.4.1.2, WSEC Table 406.3	☐			
Tested and verified as having an air leakage rate not exceeding 2 air changes per hour as required by Energy Credit 2b.	WSEC R402.4.1.2, WSEC Table 406.3	☐			
Tested and verified as having an air leakage rate not exceeding 1.5 air changes per hour as required by Energy Credit 2c.	WSEC R402.4.1.2, WSEC Table 406.3	☐			
Duct testing shall be provided in accordance with WSU RS-33 using the maximum duct leakage rates specified in WSEC R403.3.4. Written results shall be signed by the tester and provided to the code official.	WSEC R403.3.3, WSEC R403.3.4	☐			

i. Includes stucco installation.

j. Not required for EIFS applications installed over a water-resistive barrier draining moisture to the exterior or where installed over masonry of concrete.

TO BE COMPLETED BY RDP
TO BE COMPLETED BY CITY

MERCER ISLAND ADDITIONAL CIVIL ENGINEERING REQUIREMENTS:

The following civil engineering inspections and documentation shall be performed by the indicated Design Professional. Associated inspection reports and documentation shall be provided to the code official prior to final inspection.

CIVIL ENGINEERING INSPECTIONS				APPROVALS: Agency Inspector sign-off	APPROVALS: City Inspector sign-off
Project Civil Engineer or Geotechnical Engineer shall inspect and certify that the lawn and landscape areas meet the specified post-construction soil quality and depth requirements.	Construction Documents BMP T5.13 (2017 DOE manual)	☐	Periodic		
Project Civil Engineer shall inspect and certify the construction of the infiltration system, dispersion system, rain garden, bioretention, permeable pavement system and all LID systems for conformance to approved plans.	Construction Documents, Infiltration Report, Geotechnical Report	☐	Periodic		
Project Geotechnical Engineer shall observe and certify the infiltration system, dispersion system, rain garden, bioretention, permeable pavement system, and all LID systems to verify suitablity of existing soil conditions.	Construction Documents, Infiltration Report, Geotechnical Report	☐	Periodic		
CIVIL ENGINEERING DOCUMENTATION					
The Declaration of Covenant for the inspection and maintenance of private stormwater facilities must be signed, recorded and received by the City prior to final inspection.		☐			
A Right-of-Way Encroachment Agreement must be recorded for all private improvements in the right-of-way prior to final inspection.		☐			
Other as Specified:		☐			

SURVEY REQUIREMENTS (The following survey information must be submitted to planner when checked):

Surveyor shall verify points chosen for height calculations and point verification shall be submitted at the time of City foundation Inspection. A property survey may be required to verify setbacks and in some cases buildings must be surveyed onto the lot. The City reserves the right to request a lot coverage and hardscape area survey at any time prior to issuance of Certificate of Occupancy.

Land Use Planning Contact: _____ email: _____

☐ Building height survey _____ ☐ Hardscape survey _____
☐ Building setback survey _____ ☐ Gross floor area survey _____
☐ Lot coverage survey _____

☐ **MAXIMUM 40 PERCENT ALTERATION INSPECTION:** *MICC 19.01.050(D)(1)(b)(i)*
A Building Inspection prior to demolition is required for all legally nonconforming single family dwelling to ensure no more than 40 percent of the dwelling's exterior walls are structurally altered. Contact the Building Inspector at (206) 275-7730.

TO BE COMPLETED BY RDP
FIELD USE ONLY

SPECIAL INSPECTOR AND AGENCY INSPECTOR CONTACTS:

Each inspector designated in the field to perform any of the above Special Inspections or City initiated Agency Inspections shall provide the following information:

INSPECTOR NAME	INITIALS	COMPANY NAME	PHONE NUMBER	EMAIL ADDRESS

SF2
BUILDING PERMIT NUMBER

PROJECT NAME:
PROJECT ADDRESS:

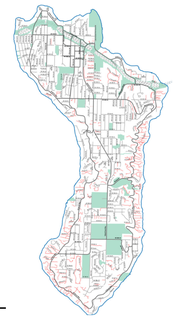

APPROVED DRAWINGS MUST BE KEPT ON THE BUILDING SITE AT ALL TIMES

REVIEWED FOR CODE COMPLIANCE
Date
Approved

Your Family Architect

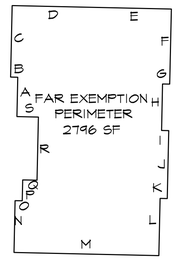

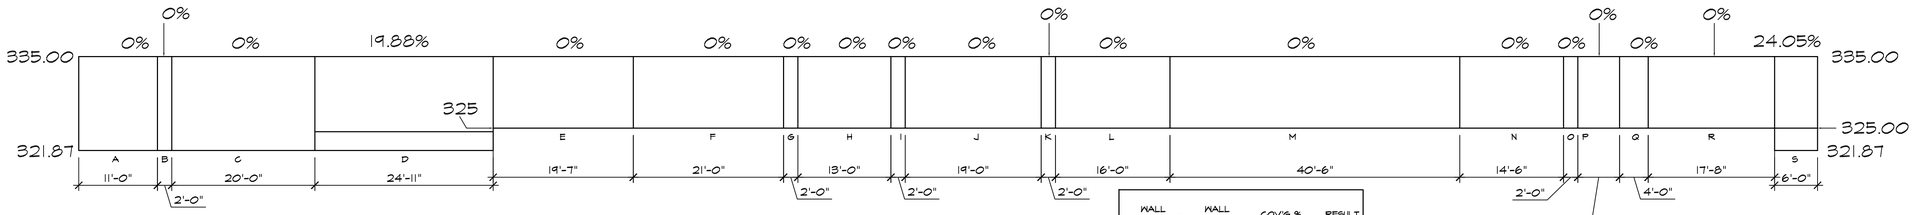

WALL SEGMENT	WALL LENGTH	COV'G %	RESULT
A	11.00'	0	0
B	2.00'	0	0
C	20.00'	0	0
E	19.58'	0	0
F	21.00'	0	0
G	2.00'	0	0
H	13.00'	0	0
I	2.00'	0	0
J	19.00'	0	0
K	2.00'	0	0
L	16.00'	0	0
M	40.50'	0	0
N	14.50'	0	0
O	2.00'	0	0
P	5.83'	0	0
Q	4.00'	0	0
R	17.67'	0	0
S	6.00'	.2405	1.44
	249.00		6.34%

249.00' / 6.34% = 0.026%
2796 SF x 0.026% = 72.70 SF EXCLUDED

HEIGHT CALCULATION

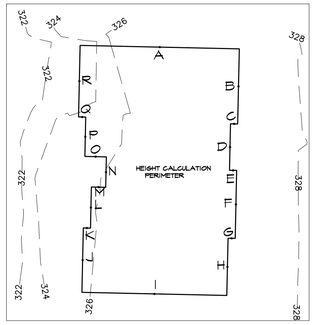

WALL SEGMENT	WALL LENGTH	* MIDPOINT ELEVATION	= PRODUCT
A	44.50	326.50	14529.25
B	21.00	327.40	6875.40
C	2.00	327.40	654.80
D	13.00	327.50	4257.50
E	2.00	327.50	655.00
F	19.00	327.50	6222.50
G	2.00	327.50	655.00
H	16.00	327.40	5238.40
I	40.50	326.70	13231.35
J	18.00	325.70	5862.60
K	2.00	325.80	651.60
L	11.50	325.80	3746.70
M	4.00	326.00	1304.00
N	8.50	326.00	2771.00
O	6.00	325.40	1952.40
P	11.00	324.90	3573.90
Q	2.00	324.30	648.60
R	20.00	323.40	6468.00
TOTALS:	243.00	5872.70	79298.00

AVERAGE EXG GRADE = TOTAL PRODUCTS/ TOTAL WALL LENGTHS:

79298.0 / 243.00 = 326.33 AVG. BLDG ELEV.
MAX HT. ALLOWABLE = + 30.00
MAX ELEVATION @ RIDGE = 356.33
PROPOSED RIDGE ELEVATION = - 355.70
PROPOSED RIDGE = 0.63 BELOW HT. LIMIT

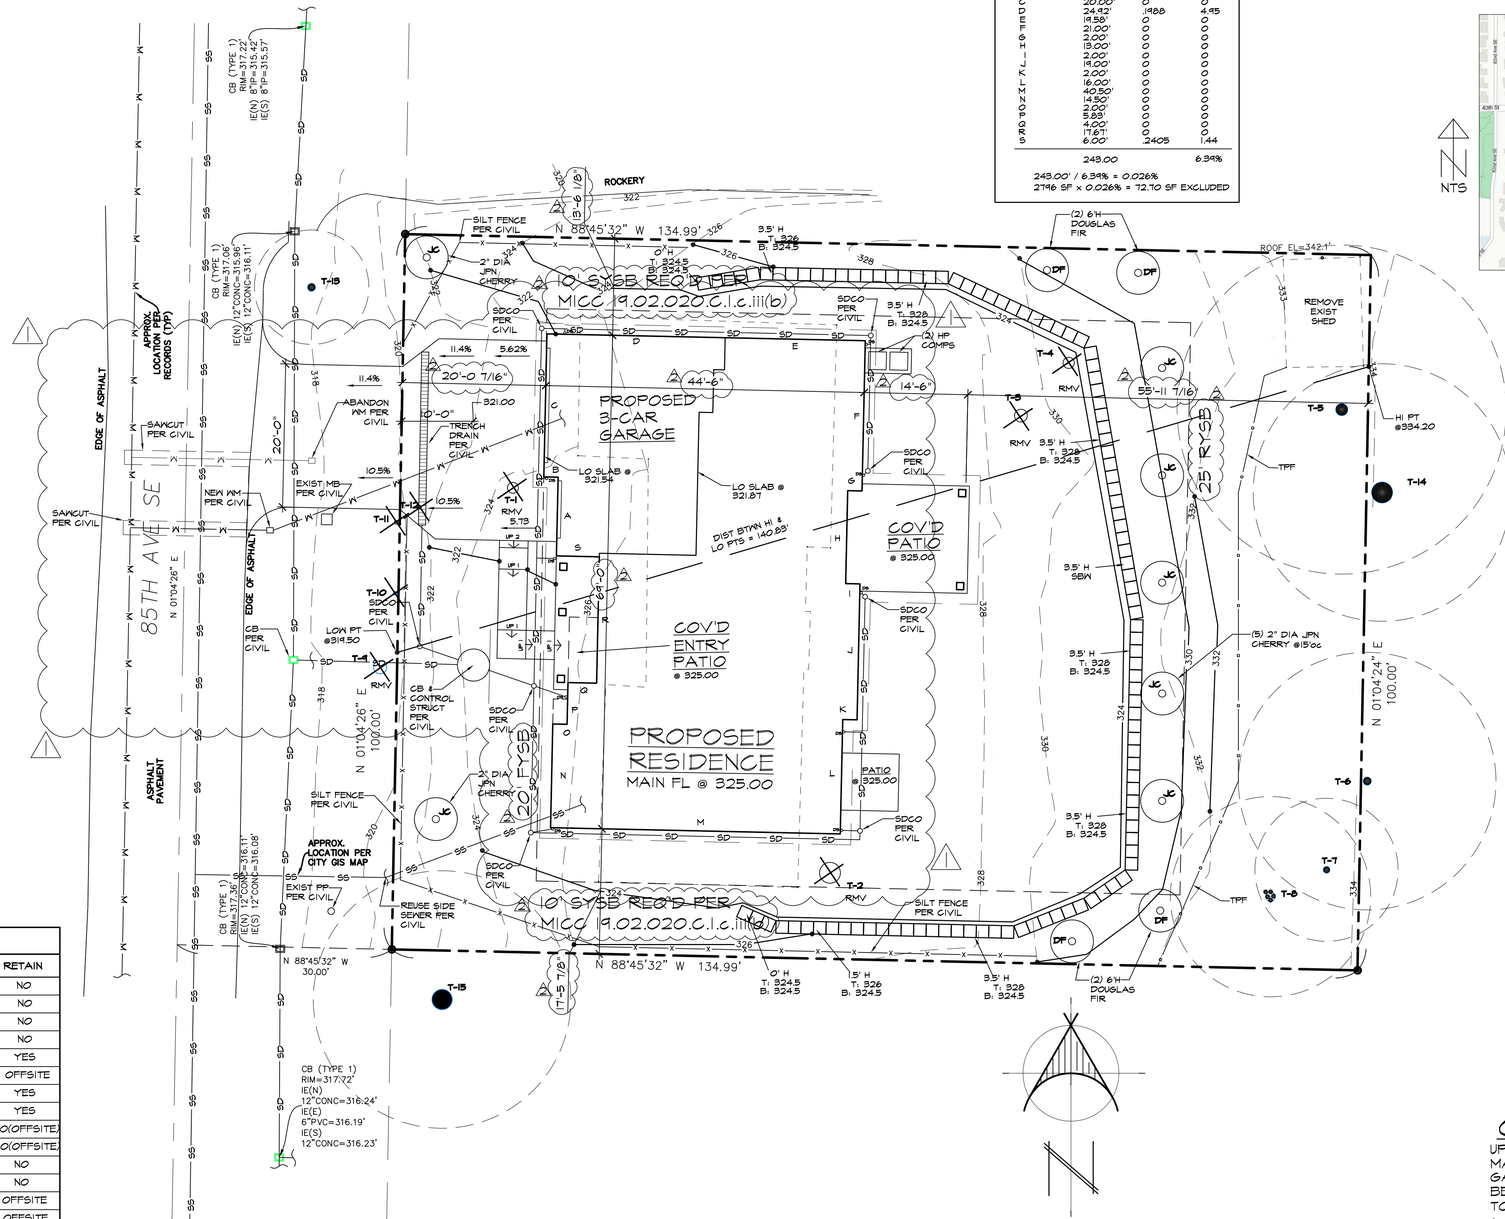

TREE SCHEDULE ON-SITE TREES

CATEGORY	GROVE	TREE NUMBER	DBH INCHES	SPECIES	DRIPLINE FEET	HEALTH	STRUCT	RETAIN
LARGE	NO	1	18.5	FLOWER CHERRY	17	2	2	NO
EXCEPTION	NO	2	35	WEST RED CEDAR	16	1	2	NO
LARGE	NO	3	21.5	GRAND FIR	20	1	1	NO
LARGE	NO	4	19	DOUGLAS FIR	22	1	1	NO
LARGE	NO	5	20	DEODAR CEDAR	23	1	2	YES
LARGE	NO	6	13.5	SCOTS PINE	18	1	2	OFFSITE
LARGE	NO	7	11	FLOWER CHERRY	10	3	3	YES
LARGE	NO	8	(5) 7-8	MAGNOLIA, TULIP	14	1	2	YES
LARGE	NO	9	11	FLOWER CHERRY	16	2	2	NO(OFFSITE)
SMALL	NO	10	6	JAPANESE MAPLE	12	1	2	NO(OFFSITE)
SMALL	NO	11	6	HOLLY	7	1	1	NO
SMALL	NO	12	6	PURPLELEAF PLUM	16	2	2	NO
LARGE	NO	13	13	BLUE SPRUCE	8	1	1	OFFSITE
EXCEPTION	NO	14	35	GRAND FIR	18	1	1	OFFSITE
EXCEPTION	NO	15	38	DEODAR CEDAR	18	1	1	OFFSITE
TOTAL REMOVED TREES <10" DBH:								2 (x1)
TOTAL REMOVED TREES 10" TO 24" DBH:								3 (x2)
TOTAL REMOVED TREES 24" TO 36" DBH:								1 (x3)
NEW PLANTED TREES REQ'D:								11
RETAIN 30% OF TREES WITH A DIAMETER 10" OR GREATER = 3/7								42.8%

CONIFEROUS REPLACEMENT TREES SHALL BE 6' TALL / DECIDUOUS TREES SHALL BE AT LEAST 1-1/2" CALIPER
PLANT (4) 6'H DOUGLAS FIR (PSEUDOTSUGA MENZIESII)
PLANT (7) 2" DIA JAPANESE CHERRY (PRUNUS SERRULATA)

SITE PLAN

SCALE : 1" = 10'-0"

0 10 20 40

VICINITY MAP

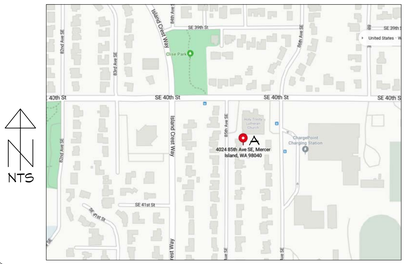

A: SITE LOCATION

NTS

OWNER
NW EASTSIDE BUILDERS LLC / JUSTIN LAGERS
PH: 206-453-5787
EM: JUSTIN@AMERICANCLASSICHOMES.COM

ARCHITECT
ARCHITECTS NW / JEFFREY DEROULET, RA
PH: 426-485-4900
EM: JEFFREY@ARCHITECTSNW.COM

STRUCTURAL ENGINEER
MEYERS ENGINEERING LLC / MARK MEYERS
PH: 253-858-3248
EM: MYENGINEER@CENTURYTEL.NET

CIVIL ENGINEER
DR STRONG / YOSHIO PIEDISCALZI, PE
PH: 425-827-3063
EM: YOSHIO.PIEDISCALZI@DRSTRONG.COM

GEOTECH ENGINEER
COBALT GEOSCIENCES / PHIL HABERMAN, PE
PH: 206-331-1097 / EM: PHIL@COBALTGEO.COM

ARBORIST
GREENFOREST, INC / FAVERO GREENFOREST
PH: 206-723-0656 /
EM: GREENFORESTINC@MINDSPRING.COM

ZONE
R-9.6

LEGAL DESCRIPTION
PARCEL# 545030-0155
L7 BK B MERCER CREST; KING CO, WA

LOT AREA
13,499 SF (0.30 AC) PER SURVEY

LOT COV'G

LOT AREA:	13499.00 SF
ROOF AREA:	3560.00 SF
PATIOS AND WALKS:	124.00 SF
VEHICUILAR USE AREA:	518.00 SF
TOTAL LOT COV'G AREA:	4202.00 SF
% OF LOT AREA:	31.13%
MAX % OF LOT AREA	40.00%

GROSS FLOOR AREA

UPPER FLOOR AREA:	2647.00 SF
MAIN FLOOR AREA:	2129.00 SF
GARAGE FLOOR AREA:	668.00 SF
BELOW GRADE GAR AREA EXEMPT:	-72.70 SF
TOTAL GROSS FLOOR AREA:	5371.3 SF
% OF LOT AREA:	34.79%
ALLOWED % OF LOT AREA:	40.00%

LOT SLOPE

HIGHEST ELEV POINT OF LOT:	334.20
LOWEST ELEV POINT OF LOT:	319.50
ELEVATION DIFFERENCE:	14.70'
HORIZ DIST BTWN HI & LOW PTS:	140.83'
LOT SLOPE:	10.44%
LOT COV'G MAX=	40.00%

PAYMENT OF USE FEE IS DUE TO ARCHITECTS NORTHWEST, INC. PRIOR TO CONSTRUCTION FOR EACH PUBLISHED SET OF PLANS. IN ACCORDANCE THESE PLANS ARE COPYRIGHTED IN ACCORDANCE WITH FEDERAL COPYRIGHT LAW. ANY USE OR METHOD OF ALL OR PORTIONS OF THESE PLANS OR REPRODUCTION OF THESE DRAWINGS IS STRICTLY PROHIBITED. "THESE DRAWINGS AND PLANS SET FORTH BY ARCHITECTS NORTHWEST, INC. ARE, AND SHALL REMAIN, THE PROPERTY OF ARCHITECTS NORTHWEST, INC.

REGISTERED ARCHITECT 6046 JEFFREY J. DEROULET STATE OF WASHINGTON 3/6/25

ARCHITECTS NORTHWEST
18915-142ND AVENUE NE SUITE 100
WOODINVILLE, WA 98072
FAX: (425) 487-6586
TOLL FREE: 1-888-272-4100
WWW.ARCHITECTSNW.COM

NW EASTSIDE BUILDERS LLC
4024 - 85TH AVE SE, MERCER ISLAND
PLAN M4551A3F-O

DESIGNED BY: DWB DATE: 1/25
DRAWN BY: DWB DATE: 3/6/25
PROJECT MANAGER: JdeR
REVISED BY: DATE:
WHB 7/24/25
DAK 8/12/25
LATERAL BY: ME DATE: 4/22/25
LATERAL JOB NUMBER: 2608

A0
A10

ANW WOODINVILLE OFFICE JOB NUMBER: 250013

TOPOGRAPHIC & BOUNDARY SURVEY

LEGAL DESCRIPTION

LOT 7, BLOCK B, MERCER CREST, ACCORDING TO THE PLAT THEREOF RECORDED IN VOLUME 42 OF PLATS, AT PAGE 26, RECORDS OF KING COUNTY, WASHINGTON.

SITUATE IN THE COUNTY OF KING, STATE OF WASHINGTON.

BASIS OF BEARINGS

NAD 83(2011) WASHINGTON NORTH STATE PLANE COORDINATES PER CITY OF MERCER ISLAND SURVEY CONTROL POINTS NO. 1076 AND 1075, BEARS N 01°02'33" E BETWEEN FOUND MONUMENTS.

REFERENCES

R1. MERCER ISLAND LOT LINE ADJUSTMENT, BK 266 OF SURVEYS, PG 71, RECORDS OF KING COUNTY, WASHINGTON.

VERTICAL DATUM

NAVD 88 PER CITY OF MERCER ISLAND CONTROL POINT NO. 1076
DESCRIPTION: CONC MON W/ BRASS PIN, IN CASE, DOWN 1.1'
LOCATION: INTX. OF 84TH AVE SE & SE 40TH ST
ELEVATION: 293.09'

SURVEYOR'S NOTES

1. THE TOPOGRAPHIC SURVEY SHOWN HEREON WAS PERFORMED IN JANUARY OF 2025. THE FIELD DATA WAS COLLECTED AND RECORDED ON MAGNETIC MEDIA THROUGH AN ELECTRONIC THEODOLITE. THE DATA FILE IS ARCHIVED ON DISC OR CD. WRITTEN FIELD NOTES MAY NOT EXIST. CONTOURS ARE SHOWN FOR CONVENIENCE ONLY. DESIGN SHOULD RELY ON SPOT ELEVATIONS.
2. ALL MONUMENTS SHOWN HEREON WERE LOCATED DURING THE COURSE OF THIS SURVEY UNLESS OTHERWISE NOTED.
3. THE TYPES AND LOCATIONS OF ANY UTILITIES SHOWN ON THIS DRAWING ARE BASED ON INFORMATION PROVIDED TO US, BY OTHERS OR GENERAL INFORMATION READILY AVAILABLE IN THE PUBLIC DOMAIN INCLUDING, AS APPLICABLE, IDENTIFYING MARKINGS PLACED BY UTILITY LOCATE SERVICES AND OBSERVED BY TERRANE IN THE FIELD. AS SUCH, THE UTILITY INFORMATION SHOWN ON THESE DRAWINGS ARE FOR INFORMATIONAL PURPOSES ONLY AND SHOULD NOT BE RELIED ON FOR DESIGN OR CONSTRUCTION PURPOSES; TERRANE IS NOT RESPONSIBLE OR LIABLE FOR THE ACCURACY OR COMPLETENESS OF THIS UTILITY INFORMATION. FOR THE ACCURATE LOCATION AND TYPE OF UTILITIES NECESSARY FOR DESIGN AND CONSTRUCTION, PLEASE CONTACT THE SITE OWNER AND THE LOCAL UTILITY LOCATE SERVICE (800-424-5555).
4. SUBJECT PROPERTY TAX PARCEL NO. 5450300155
5. SUBJECT PROPERTY AREA PER THIS SURVEY IS 13,499 S.F. (0.31 ACRES)
6. ALL TITLE INFORMATION SHOWN ON THIS MAP HAS BEEN EXTRACTED FROM CHICAGO TITLE INSURANCE COMPANY'S "COMMITMENT FOR TITLE INSURANCE", ORDER NO. 0284259-ETU, DATED DECEMBER 13, 2024. IN PREPARING THIS MAP, TERRANE, INC. HAS CONDUCTED NO INDEPENDENT TITLE SEARCH NOR IS TERRANE, INC. AWARE OF ANY TITLE ISSUES AFFECTING THE SURVEYED PROPERTY OTHER THAN THOSE SHOWN ON THE MAP AND DISCLOSED BY THE REFERENCED "COMMITMENT FOR TITLE INSURANCE". TERRANE, INC. HAS RELIED WHOLLY ON CHICAGO TITLE INSURANCE COMPANY'S REPRESENTATIONS OF THE TITLE'S CONDITION TO PREPARE THIS SURVEY AND TERRANE, INC. QUALIFIES THE MAP'S ACCURACY AND COMPLETENESS TO THAT EXTENT.
7. EXISTING STRUCTURE(S) LOCATION AND DIMENSIONS ARE MEASURED FROM THE FACE OF THE SIDING UNLESS OTHERWISE NOTED.
8. FIELD DATA FOR THIS SURVEY WAS OBTAINED BY DIRECT FIELD MEASUREMENTS WITH A CALIBRATED ELECTRONIC 3-SECOND TOTAL STATION AND/OR SURVEY GRADE GPS OBSERVATIONS. ALL ANGULAR AND LINEAR RELATIONSHIPS ARE ACCURATE AND MEET THE STANDARDS SET BY WAC 332-130-090.

LEGEND

	ASPHALT SURFACE		REBAR & CAP (SET)
	BUILDING		REBAR AS NOTED (FOUND)
℄	CENTERLINE ROW		RETAINING WALL
	CONCRETE SURFACE		RIGHT-OF-WAY LINES
	FENCE LINE (WOOD)		ROCKERY
	FIRE HYDRANT	SS	SEWER LINE
G	GAS LINE		SEWER MANHOLE
	HEDGE FOLIAGE LINE	SD	STORM DRAIN LINE
	INLET (TYPE 1)	SIZE TYPE	TREE (AS NOTED)
MB	MAILBOX (RESIDENTIAL)	W	WATER LINE
	MONUMENT (IN CASE, FOUND)	WM	WATER METER
P	POWER METER	COR	CORNER
P	POWER (OVERHEAD)	DEC	DECIDUOUS
PP	POWER POLE	MON	MONUMENT
	PROPERTY LINE (SUBJECT)	PROP	PROPERTY

VICINITY MAP

N.T.S.

SCHEDULE B ITEMS

1. COVENANTS, CONDITIONS, RESTRICTIONS, RECITALS, RESERVATIONS, EASEMENTS, EASEMENT PROVISIONS, ENCROACHMENTS DEDICATIONS, BUILDING SETBACK LINES, NOTES, STATEMENTS, AND OTHER MATTERS, IF ANY, BUT OMITTING ANY COVENANTS OR RESTRICTIONS, IF ANY, INCLUDING BUT NOT LIMITED TO THOSE BASED UPON RACE, COLOR, RELIGION, SEX, SEXUAL ORIENTATION, FAMILIAL STATUS, MARITAL STATUS, DISABILITY, HANDICAP, NATIONAL ORIGIN, ANCESTRY, OR SOURCE OF INCOME, AS SET FORTH IN APPLICABLE STATE OR FEDERAL LAWS, EXCEPT TO THE EXTENT THAT SAID COVENANT OR RESTRICTION IS PERMITTED BY APPLICABLE LAW, AS SET FORTH ON THE PLAT OF MERCER CREST:
   RECORDING NO: 3611406
   "CURRENT CONDITIONS SHOWN"
2. RIGHTS OF THE PUBLIC TO MAKE NECESSARY SLOPES FOR CUTS OR FILLS UPON THE LAND IN THE REASONABLE ORIGINAL GRADING OF STREETS, AVENUES, ALLEYS AND ROADS, AS DISCLOSED IN THE PLAT.
   "CURRENT CONDITIONS SHOWN"
3. ENCROACHMENT LICENSE AGREEMENT, AND THE TERMS AND CONDITIONS THEREOF:
   RECORDING DATE: DECEMBER 2, 2010
   RECORDING NO.: 20101202001197
   "DOES NOT AFFECT SUBJECT PARCEL"

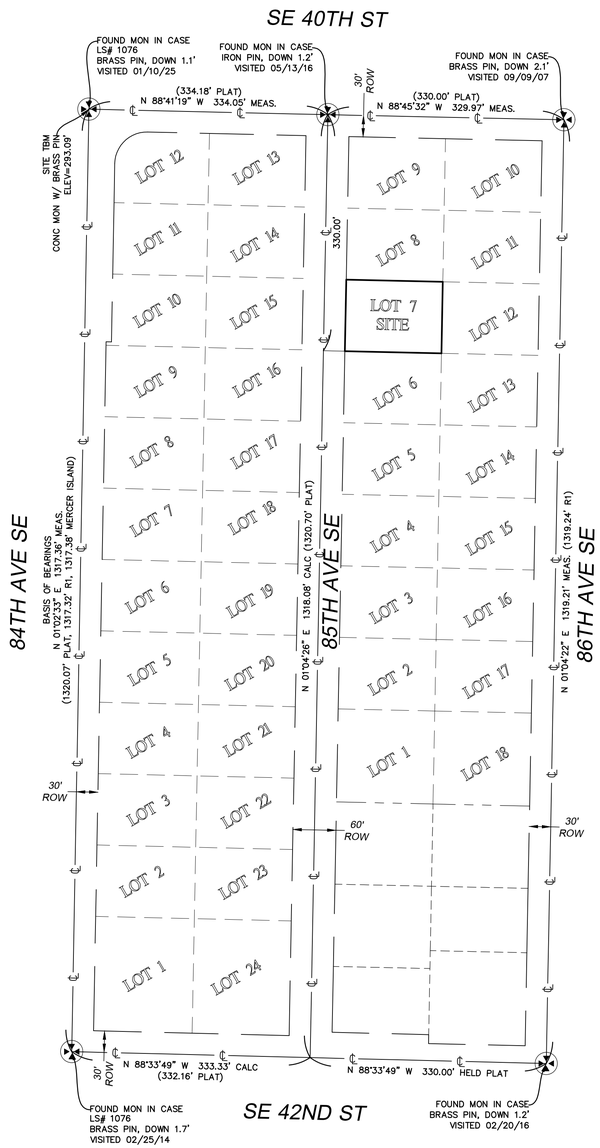

CONTROL MAP
N.T.S.

STEEP SLOPE/BUFFER DISCLAIMER:

THE LOCATION AND EXTENT OF STEEP SLOPES SHOWN ON THIS DRAWING ARE FOR INFORMATIONAL PURPOSES ONLY AND CANNOT BE RELIED ON FOR DESIGN AND/OR CONSTRUCTION. THE PITCH, LOCATION, AND EXTENT ARE BASED SOLELY ON OUR GENERAL OBSERVATIONS ON SITE AND OUR CURSORY REVIEW OF READILY AVAILABLE PUBLIC DOCUMENTS. AS SUCH, TERRANE CANNOT BE LIABLE OR RESPONSIBLE FOR THE ACCURACY OR COMPLETENESS OF ANY STEEP SLOPE INFORMATION. ULTIMATELY, THE LIMITS AND EXTENT OF ANY STEEP SLOPES ASSOCIATED WITH ANY SETBACKS OR OTHER DESIGN OR CONSTRUCTION PARAMETERS MUST BE DISCUSSED AND APPROVED BY THE REVIEWING AGENCY BEFORE ANY CONSTRUCTION CAN OCCUR.

INDEXING INFORMATION

NW 1/4 NW 1/4
SECTION: 18
TOWNSHIP: 24N
RANGE: 05E, W.M.
COUNTY: KING

We are the measure | terrane.net

TOPOGRAPHIC & BOUNDARY SURVEY
PARCEL NO. 5450300155

4024 85TH AVE SE
4024 85TH AVENUE SOUTHEAST
MERCER ISLAND, WA 98040

PAYSON SHANOR REGISTERED PROFESSIONAL LAND SURVEYOR STATE OF WASHINGTON 22008 — 1/22/25

TERRANE
11235 SE 6th St, Suite 130
Bellevue, WA 98004
p: 425-458-4488 | e: info@terrane.net

JOB NUMBER:	250010
DATE:	01/22/25
DRAFTED BY:	AJU
CHECKED BY:	JPS
SCALE:	1" = 10'

REVISION HISTORY

SHEET NUMBER
1 OF 2

TOPOGRAPHIC & BOUNDARY SURVEY

LEGEND

ASPHALT SURFACE		REBAR & CAP (SET)	
BUILDING		REBAR AS NOTED (FOUND)	
CENTERLINE ROW		RETAINING WALL	
CONCRETE SURFACE		RIGHT-OF-WAY LINES	
FENCE LINE (WOOD)		ROCKERY	
FIRE HYDRANT	SS	SEWER LINE	
GAS LINE		SEWER MANHOLE	
HEDGE FOLIAGE LINE	SD	STORM DRAIN LINE	
INLET (TYPE 1)	SIZE TYPE	TREE (AS NOTED)	
MAILBOX (RESIDENTIAL)	W	WATER LINE	
MONUMENT (IN CASE, FOUND)	WM	WATER METER	
POWER METER	COR	CORNER	
POWER (OVERHEAD)	DEC	DECIDUOUS	
POWER POLE	MON	MONUMENT	
PROPERTY LINE (SUBJECT)	PROP	PROPERTY	

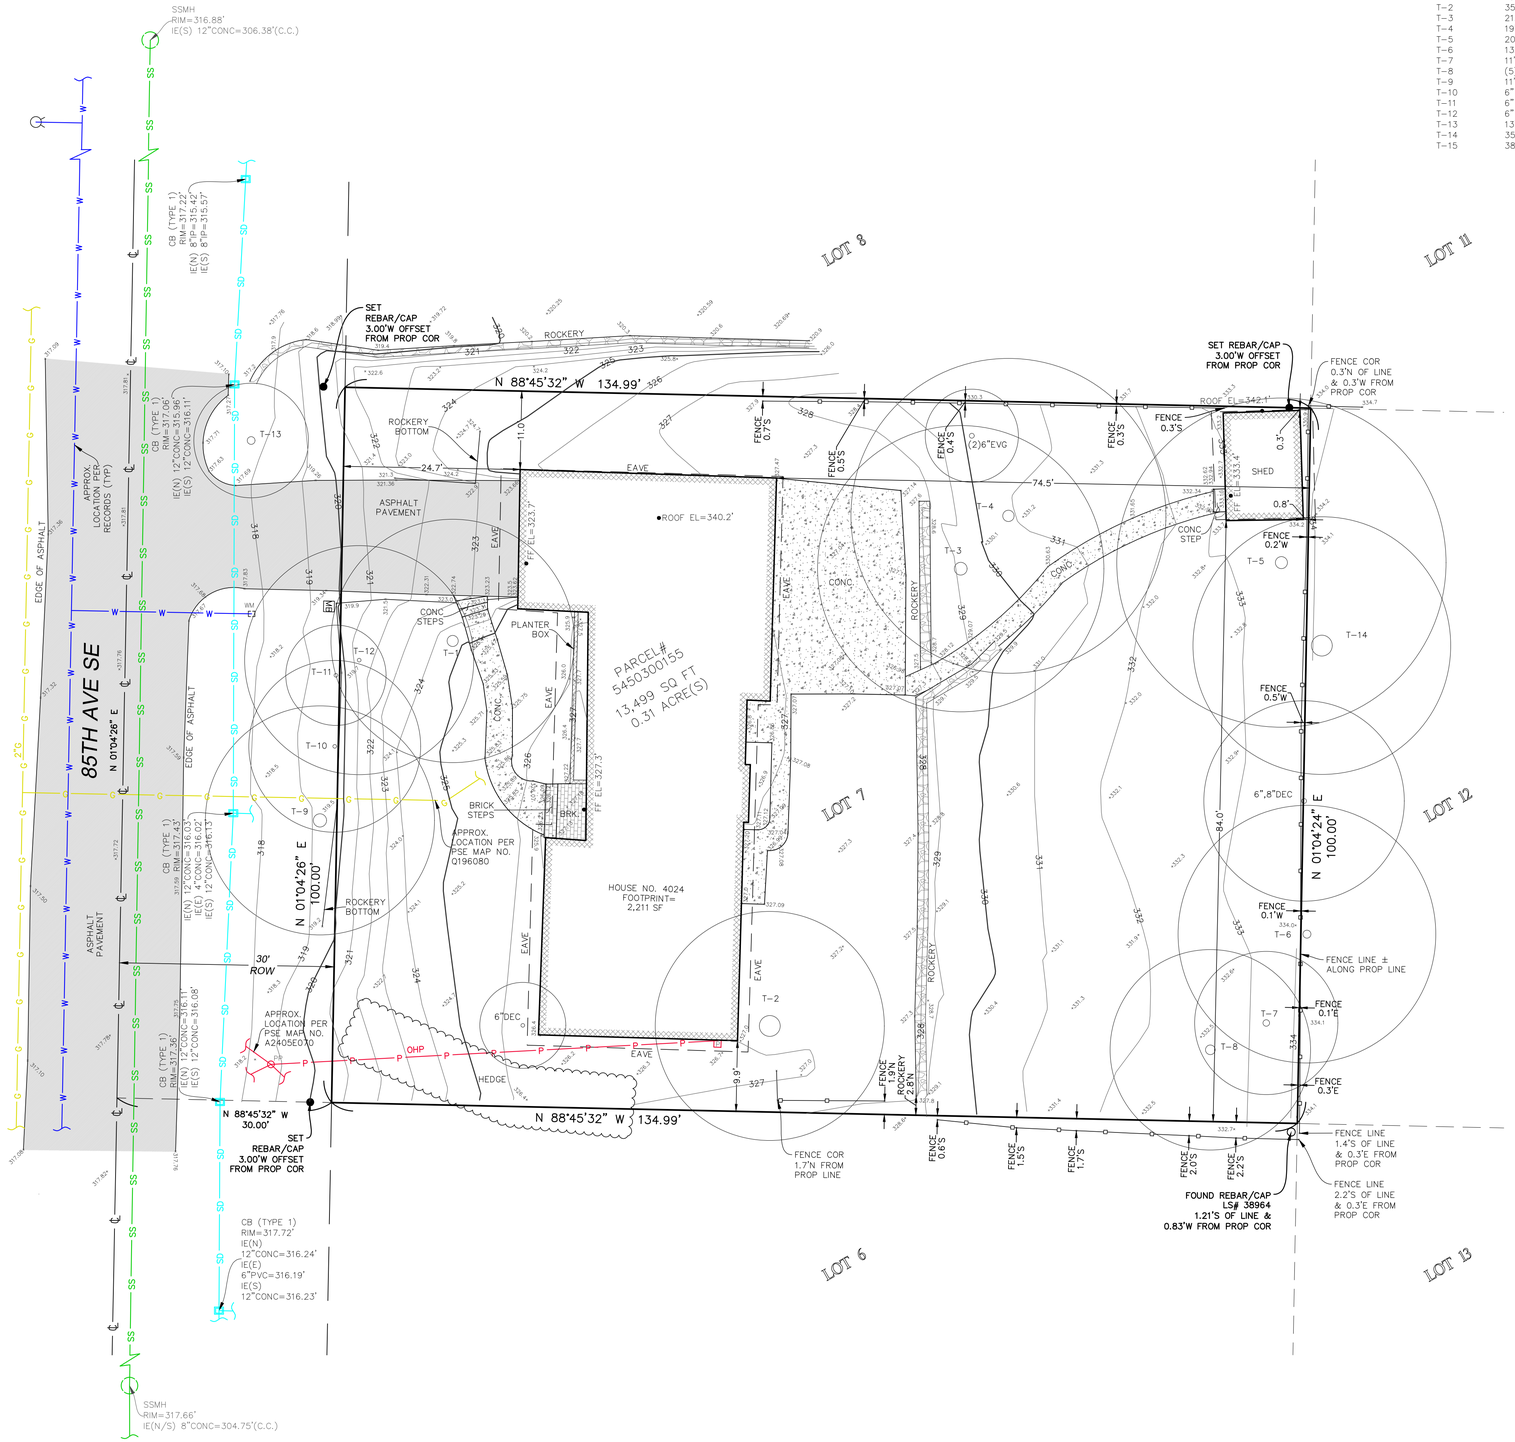

PER ARBOR REPORT
TREE INVENTORY

BY: FAVERO GREENFOREST
GREENFOREST, INC. CONSULTING ARBORIST
DATED: 01/09/25

NUMBER	DIAMETER	TYPE/NAME
T-1	18.5" DBH	FLOWERING CHERRY
T-2	35" DBH	WESTERN RED-CEDAR
T-3	21.5" DBH	GRAND FIR
T-4	19" DBH	DOUGLAS-FIR
T-5	20" DBH	DEODAR CEDAR
T-6	13.5" DBH	SCOTS PINE
T-7	11" DBH	FLOWERING CHERRY
T-8	(5)7-8" DBH	MAGNOLIA, TULIP
T-9	11" DBH	FLOWERING CHERRY
T-10	6" DBH	JAPANESE MAPLE
T-11	6" DBH	HOLLY
T-12	6" DBH	PURPLELEAF PLUM
T-13	13" DBH	BLUE SPRUCE
T-14	35" DBH	GRAND FIR
T-15	38" DBH	DEODAR CEDAR

STEEP SLOPE/BUFFER DISCLAIMER:

THE LOCATION AND EXTENT OF STEEP SLOPES SHOWN ON THIS DRAWING ARE FOR INFORMATIONAL PURPOSES ONLY AND CANNOT BE RELIED ON FOR DESIGN AND/OR CONSTRUCTION. THE PITCH, LOCATION, AND EXTENT ARE BASED SOLELY ON OUR GENERAL OBSERVATIONS ON SITE AND OUR CURSORY REVIEW OF READILY AVAILABLE PUBLIC DOCUMENTS; AS SUCH, TERRANE CANNOT BE LIABLE OR RESPONSIBLE FOR THE ACCURACY OR COMPLETENESS OF ANY STEEP SLOPE INFORMATION. ULTIMATELY, THE LIMITS AND EXTENT OF ANY STEEP SLOPES ASSOCIATED WITH ANY SETBACKS OR OTHER DESIGN OR CONSTRUCTION PARAMETERS MUST BE DISCUSSED AND APPROVED BY THE REVIEWING AGENCY BEFORE ANY CONSTRUCTION CAN OCCUR.

10 0 5 10
(IN FEET)
1 INCH = 10 FT.

INDEXING INFORMATION

NW 1/4 NW 1/4
SECTION: 18
TOWNSHIP: 24N
RANGE: 05E, W.M.
COUNTY: KING

We are the measure | terrane.net

TOPOGRAPHIC & BOUNDARY SURVEY
PARCEL NO. 5450300155

4024 85TH AVE SE
4024 85TH AVENUE SOUTHEAST
MERCER ISLAND, WA 98040

TERRANE
11235 SE 6th St, Suite 130
Bellevue, WA 98004
p: 425-458-4488 | e: info@terrane.net

JOB NUMBER:	250010
DATE:	01/22/25
DRAFTED BY:	AJU
CHECKED BY:	JPS
SCALE:	1"= 10'

REVISION HISTORY

SHEET NUMBER
2 OF 2

NW 1/4 NW 1/4 SECTION 18, TOWNSHIP 24 N, RANGE 5 E, W.M.

4024 85TH AVE SE RESIDENCE

TESC LEGEND:

FOR ADDITIONAL TESC DETAILS REFER TO DOE 2012 SWMMWW

- CL — CONSTRUCTION LIMITS, TO BE FLAGGED OR FENCED WHEN NO SILT FENCE IS PROPOSED (BMP C103)
- SF — SILT FENCE IS PROPOSED (BMP C233)
- STRAW WATTLES (BMP C235)
- CE — STABILIZED CONSTRUCTION ENTRANCE (BMP C105)
- IP — INLET PROTECTION (BMP C220)
- DC — DUST CONTROL (BMP C140)
- MU — MULCHING, MATTING, & COMPOST BLANKETS (BMP C121, BMP C125)
- PS — PERMANENT SEEDING AND PLANTING (BMP C120)
- SA — POST-CONSTRUCTION SOIL AMENDMENT QUALITY & DEPTH (BMP C120)
- CH — CONCRETE HANDLING (BMP C151)
- PC — PLASTIC COVERING (BMP C123)
- TREE TO BE REMOVED
- TREE TO BE SAVED. PROVIDE TREE PROTECTION FENCING PER ARBORIST RECOMMENDATIONS

SURVEY NOTES:

1. THE TOPOGRAPHIC SURVEY SHOWN HEREON WAS PERFORMED IN JANUARY OF 2025. THE FIELD DATA WAS COLLECTED AND RECORDED ON MAGNETIC MEDIA THROUGH AN ELECTRONIC THEODOLITE. THE DATA FILE IS ARCHIVED ON DISC OR CD. WRITTEN FIELD NOTES MAY NOT EXIST. CONTOURS ARE SHOWN FOR CONVENIENCE ONLY. DESIGN SHOULD RELY ON SPOT ELEVATIONS.

2. ALL MONUMENTS SHOWN HEREON WERE LOCATED DURING THE COURSE OF THIS SURVEY UNLESS OTHERWISE NOTED.

3. THE TYPES AND LOCATIONS OF ANY UTILITIES SHOWN ON THIS DRAWING ARE BASED ON INFORMATION PROVIDED TO US, BY OTHERS OR GENERAL INFORMATION READILY AVAILABLE IN THE PUBLIC DOMAIN INCLUDING, AS APPLICABLE, IDENTIFYING MARKINGS PLACED BY UTILITY LOCATE SERVICES AND OBSERVED BY TERRANE IN THE FIELD. AS SUCH, THE UTILITY INFORMATION SHOWN ON THESE DRAWINGS ARE FOR INFORMATIONAL PURPOSES ONLY AND SHALL NOT BE RELIED ON FOR DESIGN OR CONSTRUCTION PURPOSES; TERRANE IS NOT RESPONSIBLE OR LIABLE FOR THE ACCURACY OR COMPLETENESS OF THIS UTILITY INFORMATION. FOR THE ACCURATE LOCATION AND TYPE OF UTILITIES NECESSARY FOR DESIGN AND CONSTRUCTION, PLEASE CONTACT THE SITE OWNER AND THE LOCAL UTILITY LOCATE SERVICE (800-424-5555).

4. SUBJECT PROPERTY TAX PARCEL NO. 5450300155

5. SUBJECT PROPERTY AREA PER THIS SURVEY IS 13,499 S.F. (0.31 ACRES)

6. ALL TITLE INFORMATION SHOWN ON THIS MAP HAS BEEN EXTRACTED FROM CHICAGO TITLE INSURANCE COMPANY'S "COMMITMENT FOR TITLE INSURANCE", ORDER NO. 0284259-ETU, DATED DECEMBER 13, 2024. IN PREPARING THIS MAP, TERRANE, INC. HAS CONDUCTED NO INDEPENDENT TITLE SEARCH NOR IS TERRANE, INC. AWARE OF ANY TITLE ISSUES AFFECTING THE SURVEYED PROPERTY OTHER THAN THOSE SHOWN ON THE MAP AND DISCLOSED BY THE REFERENCED "COMMITMENT FOR TITLE INSURANCE". TERRANE, INC. HAS RELIED WHOLLY ON CHICAGO TITLE INSURANCE COMPANY'S REPRESENTATIONS OF THE TITLE'S CONDITION TO PREPARE THIS SURVEY AND TERRANE, INC. QUALIFIES THE MAP'S ACCURACY AND COMPLETENESS TO THAT EXTENT.

7. EXISTING STRUCTURE(S) LOCATION AND DIMENSIONS ARE MEASURED FROM THE FACE OF THE SIDING UNLESS OTHERWISE NOTED.

8. FIELD DATA FOR THIS SURVEY WAS OBTAINED BY DIRECT FIELD MEASUREMENTS WITH A CALIBRATED ELECTRONIC 3-SECOND TOTAL STATION AND/OR SURVEY GRADE GPS OBSERVATIONS. ALL ANGULAR AND LINEAR RELATIONSHIPS ARE ACCURATE AND MEET THE STANDARDS SET BY WAC 332-130-090.

CONSTRUCTION SEQUENCE

1. ARRANGE AND ATTEND A PRE-CONSTRUCTION MEETING WITH THE CITY INSPECTOR.
2. FLAG OR FENCE CLEARING LIMITS.
3. CALL ONE-CALL UTILITY LOCATE SERVICE PRIOR TO ANY EXCAVATION WORK.
4. GRADE ACCESS ROAD & CONSTRUCT/INSTALL ROCK CONSTRUCTION ENTRANCE IF NECESSARY.
5. INSTALL PERIMETER PROTECTION (SILT FENCE, BRUSH BARRIER, ETC.).
6. INSTALL SHORING WALL.
7. CONSTRUCT RESIDENCE AND OTHER SITE IMPROVEMENTS.
8. MAINTAIN EROSION CONTROL MEASURES IN ACCORDANCE WITH CITY OR COUNTY STANDARDS AND MANUFACTURER'S RECOMMENDATIONS.
9. MAINTAIN ACCESS TO OFF-SITE ROADS AND DRIVEWAYS AT ALL TIMES DURING THE DURATION OF THE PROJECT.
10. RELOCATE EROSION CONTROL MEASURES OR INSTALL NEW MEASURES SO THAT AS SITE CONDITIONS CHANGE THE EROSION AND SEDIMENT CONTROL IS ALWAYS IN ACCORDANCE WITH THE CITY TESC MINIMUM REQUIREMENTS.
11. COVER ALL AREAS THAT WILL BE UNWORKED FOR MORE THAN SEVEN DAYS DURING THE DRY SEASON OR TWO DAYS DURING THE WET SEASON WITH STRAW, WOOD FIBER MULCH, COMPOST, PLASTIC SHEETING OR EQUIVALENT.
12. STABILIZE ALL AREAS THAT REACH FINAL GRADE WITHIN SEVEN DAYS.
13. SEED OR SOD ANY AREAS TO REMAIN UNWORKED FOR MORE THAN 30 DAYS.
14. UPON COMPLETION OF THE PROJECT, ALL DISTURBED AREAS MUST BE STABILIZED AND BMPS REMOVED IF APPROPRIATE AFTER ACCEPTANCE BY INSPECTOR.

BASIS OF BEARINGS: (BY SURVEYOR)

NAD 83(2011) WASHINGTON NORTH STATE PLANE COORDINATES PER CITY OF MERCER ISLAND SURVEY CONTROL POINTS NO. 1076 AND 1075, BEARS N 01°02'33" E BETWEEN FOUND MONUMENTS.

REFERENCES: (BY SURVEYOR)

1. R1. MERCER ISLAND LOT LINE ADJUSTMENT, BK 266 OF SURVEYS, PG 71, RECORDS OF KING COUNTY, WASHINGTON.

VERTICAL DATUM: (BY SURVEYOR)

1. NAVD 88 PER CITY OF MERCER ISLAND CONTROL POINT NO. 1076
DESCRIPTION: CONC MON W/ BRASS PIN, IN CASE, DOWN 1.1'
LOCATION: INTX. OF 84TH AVE SE & SE 40TH ST
ELEVATION: 293.09'

LEGAL DESCRIPTION: (BY SURVEYOR)

LOT 7, BLOCK B, MERCER CREST, ACCORDING TO THE PLAT THEREOF RECORDED IN VOLUME 42 OF PLATS, AT PAGE 26, RECORDS OF KING COUNTY, WASHINGTON.

SITUATE IN THE COUNTY OF KING, STATE OF WASHINGTON.

GENERAL EROSION CONTROL NOTES:

ALL DISTURBED AREAS SHALL BE STABILIZED USING TYPICAL TESC BMP'S. THE LIMITS OF DISTURBANCE WILL BE DELINEATED WITH HIGH VISIBILITY CONSTRUCTION FENCING. DURING CONSTRUCTION SILT FENCES WILL BE PLACED DOWN SLOPE OF DISTURBED AREAS ALONG WITH STRAW MATTING, NETS, OR PLASTIC COVERING OVER EXPOSED SOIL OR STOCKPILES. TREES TO BE RETAINED WILL BE PROTECTED WITH HIGH VISIBILITY CONSTRUCTION FENCING.

AT THE COMPLETION OF THE PROJECT ALL DISTURBED AREAS WILL BE STABILIZED WITH COMPOST AMENDED SOILS AND HYDROSEEDING OR SOD.

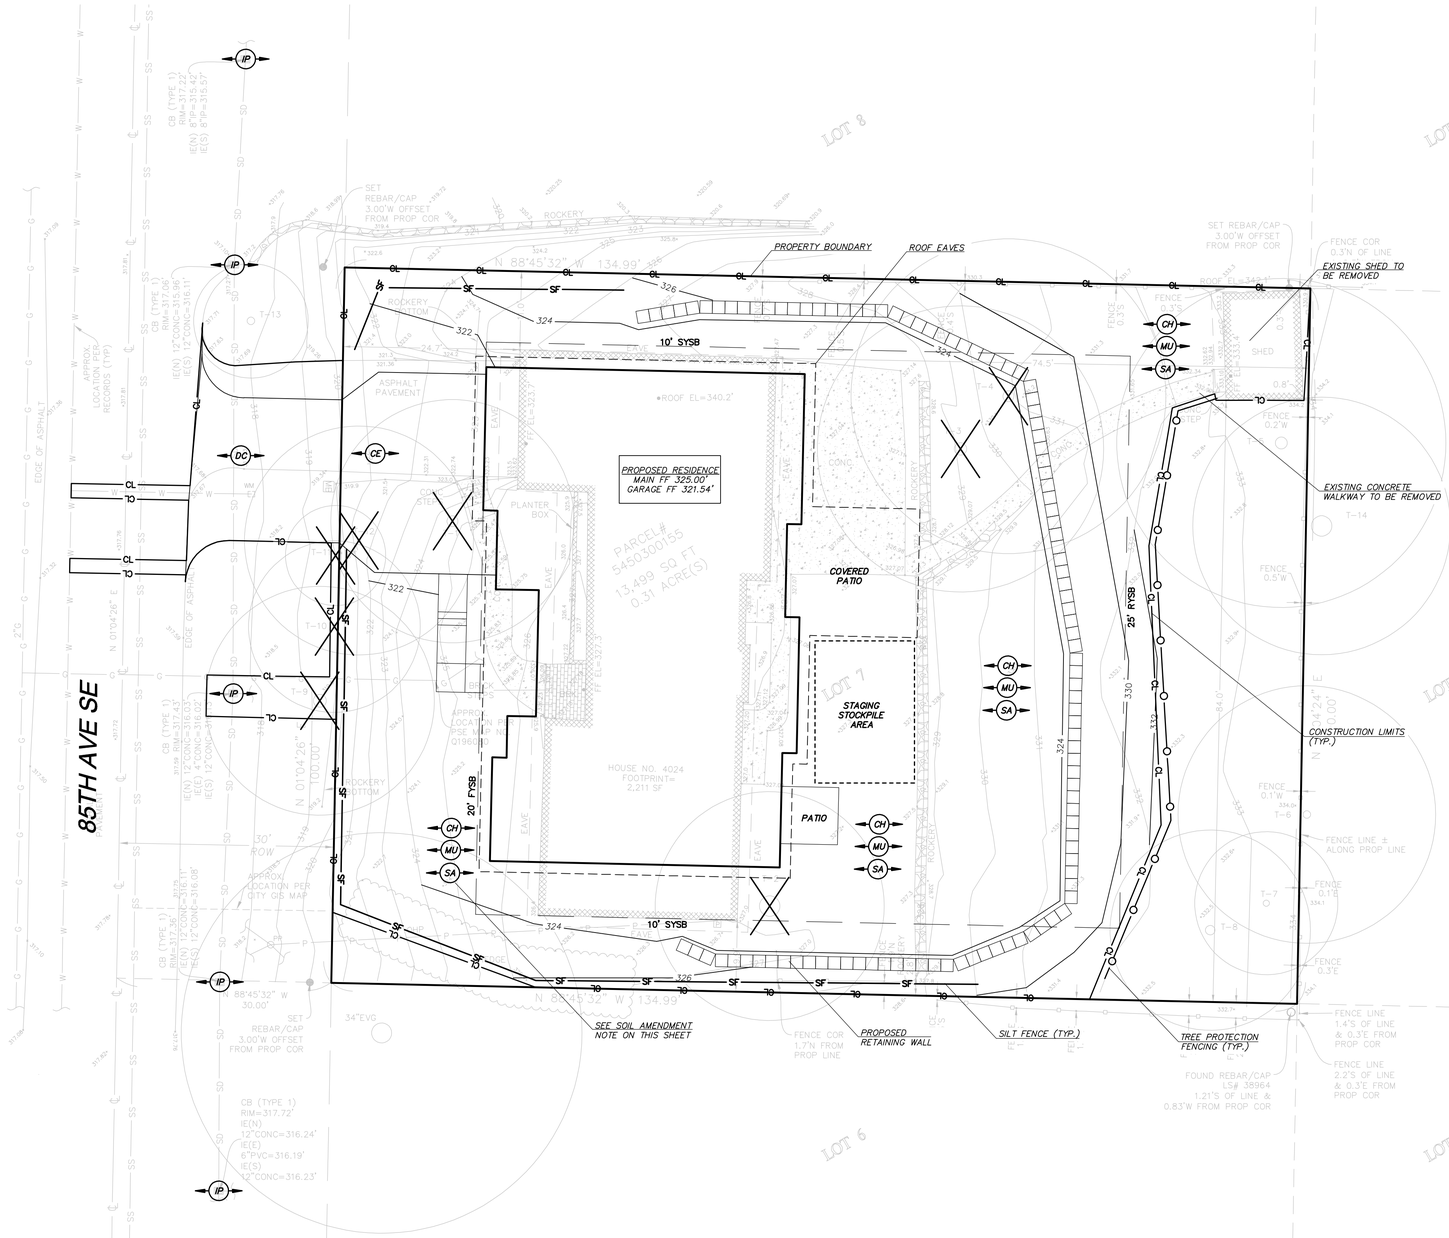

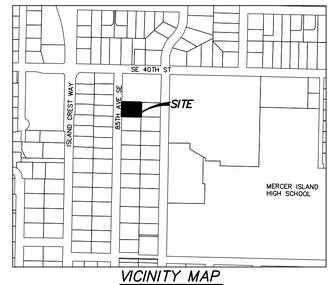

VICINITY MAP
1"=500'

PROJECT CONTACTS:

OWNER/APPLICANT	NW EASTSIDE BUILDERS, LLC 9675 SE 36TH ST, SUITE 105 MERCER ISLAND, WASHINGTON 98040 CONTACT: JUSTIN LAGERS JUSTIN@AMERICANCLASSICHOMES.COM (253) 405-5587
ARCHITECT	ARCHITECTS NW, INC 18915 142ND AVE NE, SUITE 100 WOODINVILLE, WASHINGTON 98072 (425) 485-4900 CONTACT: JEFFREY DEROULET JEFFREY@ARCHITECTSNW.COM
CIVIL ENGINEER	D.R. STRONG CONSULTING ENGINEERS, INC. 620 7TH AVENUE KIRKLAND, WASHINGTON 98033 (425) 827-3063 CONTACT: YOSHIO L. PIEDISCALZI, P.E. YOSHIO.PIEDISCALZI@DRSTRONG.COM
SURVEYOR	TERRANE 10801 MAIN STREET, SUITE 102 BELLEVUE, WASHINGTON 98004 (425) 458-4488 CONTACT: JACOB GOODMAN MILLER INFO@TERRANE.NET
GEOTECHNICAL ENGINEER	COBALT GEOSCIENCES, LLC P.O. BOX 1792 NORTH BEND, WA 98045 (206) 331-1097 CONTACT: PHIL HABERMAN, P.E.

SHEET INDEX:

C1 OF 5 COVER SHEET & T.E.S.C. PLAN
C2 OF 5 T.E.S.C. NOTES & DETAILS
C3 OF 5 STORM DRAINAGE PLAN
C4 OF 5 NOTES & DETAILS
C5 OF 5 TREE RETENTION PLAN

HARDSCAPE AREA CALCULATIONS:

GROSS LOT AREA:	13,499 S.F. (±0.310 ACRES)	
NET LOT AREA:	13,499 S.F. (±0.310 ACRES)	
ALLOWED HARDSCAPE AREA (9%):	1,215 S.F. (±0.028 ACRES)	
TOTAL EX. HARDSCAPE AREAS ON LOT:		
UNCOVERED PATIOS	650	S.F.
WALKWAYS	148	S.F.
STAIRS	170	S.F.
RETAINING WALLS	12	S.F.
TOTAL EX.	980	S.F.
TOTAL EX. HARDSCAPE AREAS TO REMAIN:		
UNCOVERED PATIOS	0	S.F.
WALKWAYS	0	S.F.
STAIRS	0	S.F.
RETAINING WALLS	0	S.F.
TOTAL EX.	0	S.F.
TOTAL NEW HARDSCAPE AREAS ON LOT:		
UNCOVERED PATIOS	32	S.F.
WALKWAYS	0	S.F.
STAIRS	76	S.F.
RETAINING WALLS	325	S.F.
TOTAL NEW	433	S.F.

TOTAL PROJECT HARDSCAPE AREA: 433 S.F. (3.21%)

SOIL AMENDMENT NOTE:

AREA (A): STOCKPILE SITE DUFF AND TOPSOIL FOR ALL DISTURBED PERVIOUS AREAS AND REAPPLY WITH SOIL AMENDMENT AFTER GRADING AND CONSTRUCTION. MINIMUM SCARIFICATION DEPTH 8-INCHES. PROVIDE A TOTAL OF 15 C.Y. OF AMENDMENT OVER AN AREA OF 600 S.F.

P.E. CERTIFICATION FOR SECTION B:

I HEREBY STATE THAT THIS CONSTRUCTION STORMWATER POLLUTION PREVENTION PLAN FOR 4024 85TH AVE SE HAS BEEN PREPARED BY ME OR UNDER MY SUPERVISION AND MEETS THE STANDARD OF CARE AND EXPERTISE WHICH IS USUAL AND CUSTOMARY IN THIS COMMUNITY FOR PROFESSIONAL ENGINEERS. I UNDERSTAND THAT THE CITY OF MERCER ISLAND DOES NOT AND WILL NOT ASSUME LIABILITY FOR THE SUFFICIENCY, SUITABILITY, OR PERFORMANCE OF CONSTRUCTION SWPPP BMPS PREPARED BY ME.

ON-SITE SOILS:

THE ENTIRE SITE CONTAINS ARENTS, ALDERWOOD MATERIAL (AmC) SOILS PER THE NRCS SOIL MAP

GRADING NOTE:

TOTAL AREA TO BE DISTURBED ON-SITE.....10,465 S.F.
TOTAL AREA TO BE DISTURBED OFF-SITE.....493 S.F.
TOTAL AREA TO BE DISTURBED FOR PROJECT.. 10,958 S.F.
FILL SHALL CONSIST OF SUITABLE MATERIAL ORIGINATING FROM THE SITE OR FROM AN APPROVED SUPPLIER.

SITE VOLUME CALCULATIONS

CUT VOLUME (CU. YDS.)	FILL VOLUME (CU. YDS.)	NET VOLUME (CU. YDS.)
1,202	118	1,084 CUT

ALL VOLUMES ARE APPROXIMATE AND ARE PROVIDED FOR PERMITTING PURPOSES AND REPRESENT FINISH GRADE TO EXISTING GRADE AS SHOWN. CONTRACTOR SHALL RELY ON HIS/HER OWN ESTIMATES FOR DETERMINING ACTUAL EARTHWORK QUANTITIES.
THE VOLUMES DO NOT INCLUDE STRIPPING, STRUCTURAL OR VAULT EXCAVATION, EXPANSION/COMPACTION FACTOR OR ANY SOIL TYPE RESTRICTIONS.

NORTH
GRAPHIC SCALE
0 5 10 20
1 INCH = 10 FT.

Call 2 Working Days Before You Dig
811
Utilities Underground Location Center
(ID,MT,ND,OR,WA)

D.R. STRONG CONSULTING ENGINEERS
ENGINEERS PLANNERS SURVEYORS
620 - 7th AVENUE KIRKLAND, WA 98033
O 425.827.3063 F 425.827.2423

4024 85TH AVE SE
MERCER ISLAND RESIDENCE

TESC PLAN
4024 85TH AVE SE
MERCER ISLAND, WA 98040
PARCEL NO. 5450300155

NW EASTSIDE BUILDERS, LLC
9675 SE 36TH STREET, SUITE 105
MERCER ISLAND WA 98040
253-405-5587

JOSEPH L. PIEDISCALZI — STATE OF WASHINGTON — 52232 — REGISTERED PROFESSIONAL ENGINEER
8-12-2025

DATE	REVISION	APR
7.11.25	CITY COMMENTS	YLP
8.12.25	CITY COMMENTS	YLP

DRAFTED BY: ECM
DESIGNED BY: ECM
PROJECT ENGINEER: YLP
DATE: 02.24.2025
PROJECT NO.: 25001

DRAWING: C1
SHEET: 1 OF 5

COPYRIGHT © 2025, D.R. STRONG CONSULTING ENGINEERS INC.

NW 1/4 NW 1/4 SECTION 18, TOWNSHIP 24 N, RANGE 5 E, W.M.

4024 85TH AVE SE RESIDENCE

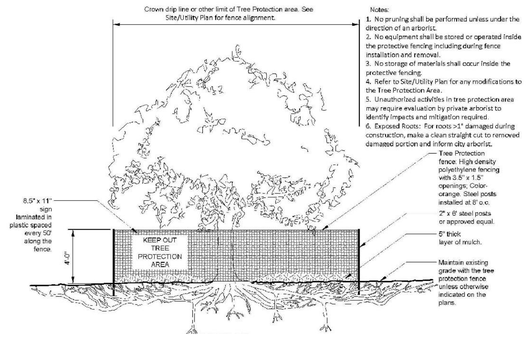

Notes:
1. No pruning shall be performed unless under the direction of an arborist.
2. No equipment shall be stored or operated inside the protective fencing including during fence installation and removal.
3. No storage of materials shall occur inside the protective fencing.
4. Refer to Site/Utility Plan for any modifications to the Tree Protection Area.
5. Unauthorized activities in tree protection area may require evaluation by private arborist to identify impacts and mitigation required.
6. Exposed Roots: For roots >1" damaged during construction, make a clean straight cut to removed damaged portion and inform city arborist.

TREE PROTECTION FENCING

NTS

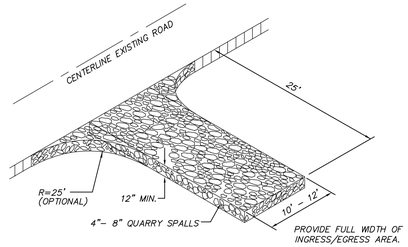

DRIVEWAYS SHALL BE PAVED TO THE EDGE OF R–O–W PRIOR TO INSTALLATION OF THE CONSTRUCTION ENTRANCE TO AVOID DAMAGING OF THE ROADWAY

IT IS RECOMMENDED THAT THE ENTRANCE BE CROWNED SO THAT RUNOFF DRAINS OFF THE PAD

GRAVEL CONSTRUCTION ENTRANCE

NTS

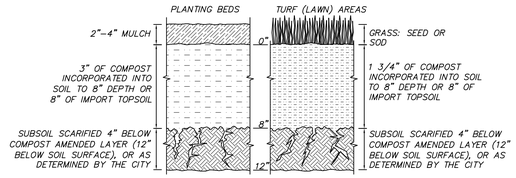

SOIL AMENDMENT

PER BMP T5.13

NTS

EROSION AND SEDIMENT CONTROL NOTES:

1. APPROVAL OF THIS EROSION AND SEDIMENT CONTROL (ESC) PLAN DOES NOT CONSTITUTE AN APPROVAL OF PERMANENT ROAD OR DRAINAGE DESIGN (E.G. SIZE AND LOCATION OF ROADS, PIPES, RESTRICTORS, CHANNELS, RETENTION FACILITIES, UTILITIES, ETC.).
2. THE IMPLEMENTATION OF THESE ESC PLANS AND THE CONSTRUCTION, MAINTENANCE, REPLACEMENT, AND UPGRADING OF THESE ESC FACILITIES IS THE RESPONSIBILITY OF THE APPLICANT/ESC SUPERVISOR UNTIL ALL CONSTRUCTION IS APPROVED.
3. THE BOUNDARIES OF THE CLEARING LIMITS SHOWN ON THIS PLAN SHALL BE CLEARLY FLAGGED BY A CONTINUOUS LENGTH OF SURVEY TAPE (OR FENCING, IF REQUIRED) PRIOR TO CONSTRUCTION. DURING THE CONSTRUCTION PERIOD, NO DISTURBANCE BEYOND THE CLEARING LIMITS SHALL BE PERMITTED. THE CLEARING LIMITS SHALL BE MAINTAINED BY THE APPLICANT/ESC SUPERVISOR FOR THE DURATION OF CONSTRUCTION.
4. THE ESC FACILITIES SHOWN ON THIS PLAN MUST BE CONSTRUCTED PRIOR TO OR IN CONJUNCTION WITH ALL CLEARING AND GRADING SO AS TO ENSURE THAT THE TRANSPORT OF SEDIMENT TO SURFACE WATERS, DRAINAGE SYSTEMS, AND ADJACENT PROPERTIES IS MINIMIZED.
5. THE ESC FACILITIES SHOWN ON THIS PLAN ARE THE MINIMUM REQUIREMENTS FOR ANTICIPATED SITE CONDITIONS. DURING THE CONSTRUCTION PERIOD, THESE ESC FACILITIES SHALL BE UPGRADED AS NEEDED FOR UNEXPECTED STORM EVENTS AND MODIFIED TO ACCOUNT FOR CHANGING SITE CONDITIONS (E.G. ADDITIONAL SUMP PUMPS, RELOCATION OF DITCHES AND SILT FENCES, ETC.).
6. THE ESC FACILITIES SHALL BE INSPECTED DAILY BY THE APPLICANT/ESC SUPERVISOR AND MAINTAINED TO ENSURE CONTINUED PROPER FUNCTIONING. WRITTEN RECORDS SHALL BE KEPT OF WEEKLY REVIEWS OF THE TESC FACILITIES DURING THE WET SEASON (OCT. 1 TO APRIL 30) AND OF MONTHLY REVIEWS DURING THE DRY SEASON (MAY 1 TO SEPT. 30).
7. ANY AREAS OF EXPOSED SOILS, INCLUDING ROADWAY EMBANKMENTS, THAT WILL NOT BE DISTURBED FOR TWO DAYS DURING THE WET SEASON OR SEVEN DAYS DURING THE DRY SEASON SHALL BE IMMEDIATELY STABILIZED WITH THE APPROVED ESC METHODS (E.G., SEEDING, MULCHING, PLASTIC COVERING, ETC.).
8. AT NO TIME SHALL MORE THAN ONE FOOT OF SEDIMENT BE ALLOWED TO ACCUMULATE WITHIN A TRAPPED CATCH BASIN. ALL CATCH BASINS AND CONVEYANCE LINES SHALL BE CLEANED PRIOR TO PAVING. THE CLEANING OPERATION SHALL NOT FLUSH SEDIMENT LADEN WATER INTO THE DOWNSTREAM SYSTEM. STABILIZED CONSTRUCTION ENTRANCES SHALL BE INSTALLED AT THE BEGINNING OF CONSTRUCTION AND MAINTAINED FOR THE DURATION OF THE PROJECT. ADDITIONAL MEASURES MAY BE REQUIRED TO INSURE THAT ALL PAVED AREAS ARE KEPT CLEAN FOR THE DURATION OF THE PROJECT.
9. ALL DISTURBED AREAS SHALL BE STABILIZED USING TYPICAL TESC BMP'S. THE LIMITS OF DISTURBANCE WILL BE DELINEATED WITH HIGH VISIBILITY CONSTRUCTION FENCING. DURING CONSTRUCTION SILT FENCES WILL BE PLACED DOWN SLOPE OF DISTURBED AREAS ALONG WITH STRAW MATTING, NETS, OR PLASTIC COVERING OVER EXPOSED SOIL OR STOCKPILES. TREES TO BE RETAINED WILL BE PROTECTED WITH HIGH VISIBILITY CONSTRUCTION FENCING.
10. ALL SOIL STOCKPILES TO BE COVERED WITH PLASTIC SHEETING UNTIL SUCH TIME THAT THE SOIL IS EITHER USED OR REMOVED. PILES SHOULD BE SITUATED AND LOCATED SUCH THAT SEDIMENT DOES NOT RUN INTO THE STREET OR ONTO ADJOINING PROPERTIES.
11. ALL EXPOSED SOIL AREAS SHALL BE COVERED OR PROTECTED USING AN APPROPRIATE BMP. STABILIZE DENUDED AREAS OF THE SITE BY MULCHING, SEEDING, PLANTING, OR SODDING.
12. ALL ADJACENT PROPERTIES SHALL BE PROTECTED FROM SEDIMENT DEPOSITION BY APPROPRIATE USE OF VEGETATION BUFFER STRIPS, SEDIMENT BARRIERS, OR FILTERS, DIKES, MULCHING, OR BY A COMBINATION OF THESE MEASURES AND OTHER APPROPRIATE BMP'S.
13. PROVIDE FOR PERIODIC STREET CLEANING TO REMOVE ANY SEDIMENT THAT MAY HAVE BEEN TRACKED OFF–SITE. SEDIMENT SHOULD BE REMOVED BY SHOVELING OR SWEEPING AND CAREFULLY REMOVED TO A SUITABLE DISPOSAL AREA WHERE IT WILL NOT BE RE–ERODED.
14. ALL INSTALLED EROSION AND SEDIMENT CONTROL BMP'S SHALL BE INSPECTED REGULARLY BY THE GENERAL CONTRACTOR ESPECIALLY AFTER ANY LARGE STORM. MAINTENANCE, INCLUDING REMOVAL AND PROPER DISPOSAL OF SEDIMENT SHOULD BE A NECESSARY TO INSURE THAT SEDIMENT AND EROSION IS CONTROLLED ON SITE.

SOIL AMENDMENT NOTES

•SOIL RETENTION: RETAIN, IN AN UNDISTURBED STATE, THE DUFF LAYER AND NATIVE TOPSOIL TO THE MAXIMUM EXTENT PRACTICABLE, IN ANY AREAS REQUIRING GRADING REMOVE AND STOCKPILE THE DUFF LAYER AND TOPSOIL ON SITE IN A DESIGNATED, CONTROLLED AREA, NOT ADJACENT TO PUBLIC RESOURCES AND CRITICAL AREAS, TO BE REAPPLIED TO OTHER PORTIONS OF THE SITE WHERE FEASIBLE.

•SOIL QUALITY: ALL AREAS SUBJECT TO CLEARING AND GRADING THAT HAVE NOT BEEN COVERED BY IMPERVIOUS SURFACE, INCORPORATED INTO A DRAINAGE FACILITY OR ENGINEERED AS STRUCTURAL FILL OR SLOPE SHALL, AT PROJECT COMPLETION, DEMONSTRATE THE FOLLOWING:

1. A TOPSOIL LAYER WITH A MINIMUM ORGANIC MATTER CONTENT OF 10% DRY WEIGHT IN PLANTING BEDS, AND 5% ORGANIC MATTER CONTENT IN TURF AREAS, AND A PH FROM 6.0 TO 8.0 OR MATCHING THE PH OF THE UNDISTURBED SOIL. THE TOPSOIL LAYER SHALL HAVE A MINIMUM DEPTH OF EIGHT INCHES EXCEPT WHERE TREE ROOTS LIMIT THE DEPTH OF INCORPORATION OF AMENDMENTS NEEDED TO MEET THE CRITERIA. SUBSOILS BELOW THE TOPSOIL LAYER SHOULD BE SCARIFIED AT LEAST 4 INCHES WITH SOME INCORPORATION OF THE UPPER MATERIAL TO AVOID STRATIFIED LAYERS, WHERE FEASIBLE.
2. MULCH PLANTING BEDS WITH 2–4 INCHES OF ORGANIC MATERIAL.
3. USE COMPOST AND OTHER MATERIALS THAT MEET THESE ORGANIC CONTENT REQUIREMENTS:
   A. THE ORGANIC CONTENT FOR "PRE–APPROVED" AMENDMENT RATES CAN BE MET ONLY USING COMPOST MEETING THE COMPOST SPECIFICATION FOR BIORETENTION (BMP T7.30), WITH THE EXCEPTION THAT THE COMPOST MAY HAVE UP TO 35% BIOSOLIDS OR MANURE. THE COMPOST MUST ALSO HAVE AN ORGANIC MATTER CONTENT OF 40% TO 65% AND A CARBON TO NITROGEN RATIO BELOW 25:1. THE CARBON TO NITROGEN RATIO MAY BE AS HIGH AS 35:1 FOR PLANTINGS COMPOSED ENTIRELY OF PLANTS NATIVE TO THE PUGET SOUND LOWLANDS REGION.
   B. CALCULATED AMENDMENT RATES MAY BE MET THROUGH USE OF COMPOSTED MATERIAL MEETING (A.) ABOVE; OR OTHER ORGANIC MATERIALS AMENDED TO MEET THE CARBON TO NITROGEN RATIO REQUIREMENTS, AND NOT EXCEEDING THE CONTAMINANT LIMITS IDENTIFIED IN TABLE 220–B, TESTING PARAMETERS, IN WAC 173–350–220.

THE RESULTING SOIL SHOULD BE CONDUCIVE TO THE TYPE OF VEGETATION TO BE ESTABLISHED.

•IMPLEMENTATION OPTIONS: THE SOIL QUALITY DESIGN GUIDELINES LISTED ABOVE CAN BE MET BY USING ONE OF THE METHODS LISTED BELOW:

1. LEAVE UNDISTURBED NATIVE VEGETATION AND SOIL, AND PROTECT FROM COMPACTION DURING CONSTRUCTION.
2. AMEND EXISTING SITE TOPSOIL OR SUBSOIL EITHER AT DEFAULT "PRE–APPROVED" RATES, OR AT CUSTOM CALCULATED RATES BASED ON TESTS OF THE SOIL AND AMENDMENT.
3. STOCKPILE EXISTING TOPSOIL DURING GRADING, AND REPLACE IT PRIOR TO PLANTING. STOCKPILED TOPSOIL MUST ALSO BE AMENDED IF NEEDED TO MEET THE ORGANIC MATTER OR DEPTH REQUIREMENTS, EITHER AT A DEFAULT "PRE–APPROVED" RATE OR AT A CUSTOM CALCULATED RATE.
4. IMPORT TOPSOIL MIX OF SUFFICIENT ORGANIC CONTENT AND DEPTH TO MEET THE REQUIREMENTS.

MORE THAN ONE METHOD MAY BE USED ON DIFFERENT PORTIONS OF THE SAME SITE. SOIL THAT ALREADY MEETS THE DEPTH AND ORGANIC MATTER QUALITY STANDARDS, AND IS NOT COMPACTED, DOES NOT NEED TO BE AMENDED.

MAINTENANCE:
•ESTABLISH SOIL QUALITY AND DEPTH TOWARD THE END OF CONSTRUCTION AND ONCE ESTABLISHED, PROTECT FROM COMPACTION, SUCH AS FROM LARGE MACHINERY USE, AND FROM EROSION.
•PLANT VEGETATION AND MULCH THE AMENDED SOIL AREA AFTER INSTALLATION.
•LEAVE PLANT DEBRIS OR ITS EQUIVALENT ON THE SOIL SURFACE TO REPLENISH ORGANIC MATTER.
•REDUCE AND ADJUST, WHERE POSSIBLE, THE USE OF IRRIGATION, FERTILIZERS, HERBICIDES AND PESTICIDES, RATHER THAN CONTINUING TO IMPLEMENT FORMERLY ESTABLISHED PRACTICES.

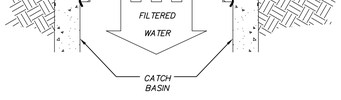

CATCH BASIN INSERT MAINTENANCE STANDARDS

1. ANY ACCUMULATED SEDIMENT ON OR AROUND THE FILTER FABRIC PROTECTION SHALL BE REMOVED IMMEDIATELY. SEDIMENT SHALL NOT BE REMOVED WITH WATER, AND ALL SEDIMENT MUST BE DISPOSED OF AS FILL ON SITE OR HAULED OFF SITE.
2. ANY SEDIMENT IN THE CATCH BASIN INSERT SHALL BE REMOVED WHEN THE SEDIMENT HAS FILLED ONE–THIRD OF THE AVAILABLE STORAGE. THE FILTER MEDIA FOR THE INSERT SHALL BE CLEANED OR REPLACED AT LEAST MONTHLY.
3. REGULAR MAINTENANCE IS CRITICAL FOR BOTH FORMS OF CATCH BASINS PROTECTION. UNLIKE MANY FORMS OF PROTECTION THAT FAIL GRADUALLY, CATCH BASIN PROTECTION WILL FAIL SUDDENLY AND COMPLETELY IF NOT MAINTAINED PROPERLY.

NOTE: ONLY TO BE USED WHERE PONDING OF WATER ABOVE THE CATCH BASIN WILL NOT CAUSE TRAFFIC PROBLEMS AND WHERE OVERFLOW WILL NOR RESULT IN EROSION OF SLOPES.

CATCH BASIN INLET FILTER

NTS

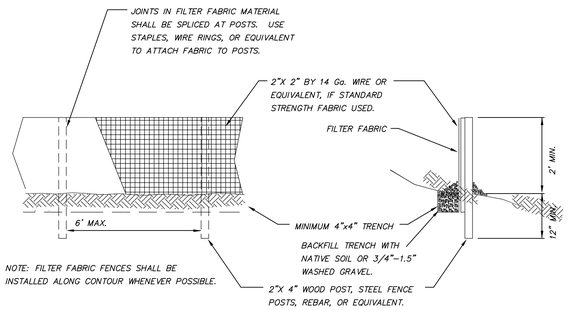

NOTE: FILTER FABRIC FENCES SHALL BE INSTALLED ALONG CONTOUR WHENEVER POSSIBLE.

1. ANY DAMAGE SHALL BE REPAIRED IMMEDIATELY.
2. IF CONCENTRATED FLOWS ARE EVIDENT UPHILL OF THE FENCE, THEY MUST BE INTERCEPTED AND CONVEYED TO A SEDIMENT TRAP OR POND.
3. IT IS IMPORTANT TO CHECK THE UPHILL SIDE OF THE FENCE FOR SIGNS OF THE FENCE CLOGGING AND ACTING AS A BARRIER TO FLOW AND THEN CAUSING CHANNELIZATION OF FLOWS PARALLEL TO THE FENCE. IF THIS OCCURS, REPLACE THE FENCE OR REMOVE THE TRAPPED SEDIMENT.
4. SEDIMENT MUST BE REMOVED WHEN THE SEDIMENT IS 6 INCHES HIGH.
5. IF THE FILTER FABRIC (GEOTEXTILE) HAS DETERIORATED DUE TO ULTRAVIOLET BREAKDOWN, IT SHALL BE REPLACED.

SILT FENCE DETAIL

NTS

D.R. STRONG CONSULTING ENGINEERS
ENGINEERS PLANNERS SURVEYORS
620 - 7th AVENUE KIRKLAND, WA 98033
O 425.827.3063 F 425.827.2423

4024 85TH AVE SE MERCER ISLAND RESIDENCE

TESC DETAILS
4024 85TH AVE SE
MERCER ISLAND, WA 98040
PARCEL NO. 5450300155

NW EASTSIDE BUILDERS, LLC

9675 SE 36TH STREET, SUITE 105
MERCER ISLAND WA 98040
253-405-5587

DATE	REVISION	APR
7.11.25	CITY COMMENTS	YLP
8.12.25	CITY COMMENTS	YLP

DRAFTED BY: ECM
DESIGNED BY: ECM
PROJECT ENGINEER: YLP
DATE: 02.24.2025
PROJECT NO.: 25001

DRAWING: C2
SHEET: 2 OF 5

Call 2 Working Days Before You Dig
811
Utilities Underground Location Center
(ID,MT,ND,OR,WA)

COPYRIGHT © 2025, D.R. STRONG CONSULTING ENGINEERS INC.

NW 1/4 NW 1/4 SECTION 18, TOWNSHIP 24 N, RANGE 5 E, W.M.

4024 85TH AVE SE RESIDENCE

STANDARD DETENTION SYSTEM NOTES:

1. CALL DEVELOPMENT SERVICES (206-275-7605) 24 HOURS IN ADVANCE FOR A DETENTION SYSTEM INSPECTION BEFORE BACKFILLING AND FOR FINAL INSPECTIONS.
2. RESPONSIBILITY FOR OPERATION AND MAINTENANCE OF DRAINAGE SYSTEMS ON PRIVATE PROPERTY IS RESPONSIBILITY OF THE PROPERTY OWNER. MATERIAL ACCUMULATED IN THE STORAGE PIPE MUST BE REMOVED FROM CATCH BASINS TO ALLOW PROPER OPERATION. THE OUTLET CONTROL ORIFICE MUST BE KEPT OPEN AT ALL TIMES.
3. PIPE MATERIAL, JOINT, AND PROTECTIVE TREATMENT SHALL BE IN ACCORDANCE WITH SECTION 7.04 AND 9.05 OF THE WSDOT STANDARD SPECIFICATIONS FOR ROAD, BRIDGE, AND MUNICIPAL CONSTRUCTION, LATEST VERSION. SUCH MATERIALS INCLUDE THE FOLLOWING, LINED CORRUGATED POLYETHYLENE PIPE (LCPE), ALUMINIZED TYPE 2 CORRUGATED STEEL PIPE AND PIPE ARCH (MEETS AASHTO DESIGNATIONS M274 AND M36). CORRUGATED OR SPIRAL RIB ALUMINUM PIPE, OR REINFORCED CONCRETE PIPE, CORRUGATED STEEL PIPE IS NOT ALLOWED.
4. FOOTING DRAINS SHALL NOT BE CONNECTED TO THE DETENTION SYSTEM.

STANDARD DETENTION SYSTEM NOTES:

1. CALL DEVELOPMENT SERVICES (206-275-7605) 24 HOURS IN ADVANCE FOR A DETENTION SYSTEM INSPECTION BEFORE BACKFILLING AND FOR FINAL INSPECTIONS.
2. RESPONSIBILITY FOR OPERATION AND MAINTENANCE OF DRAINAGE SYSTEMS ON PRIVATE PROPERTY IS RESPONSIBILITY OF THE PROPERTY OWNER. MATERIAL ACCUMULATED IN THE STORAGE PIPE MUST BE REMOVED FROM CATCH BASINS TO ALLOW PROPER OPERATION. THE OUTLET CONTROL ORIFICE MUST BE KEPT OPEN AT ALL TIMES.
3. PIPE MATERIAL, JOINT, AND PROTECTIVE TREATMENT SHALL BE IN ACCORDANCE WITH SECTION 7.04 AND 9.05 OF THE WSDOT STANDARD SPECIFICATIONS FOR ROAD, BRIDGE, AND MUNICIPAL CONSTRUCTION, LATEST VERSION. SUCH MATERIALS INCLUDE THE FOLLOWING, LINED CORRUGATED POLYETHYLENE PIPE (LCPE), ALUMINIZED TYPE 2 CORRUGATED STEEL PIPE AND PIPE ARCH (MEETS AASHTO DESIGNATIONS M274 AND M36). CORRUGATED OR SPIRAL RIB ALUMINUM PIPE, OR REINFORCED CONCRETE PIPE, CORRUGATED STEEL PIPE IS NOT ALLOWED.
4. FOOTING DRAINS SHALL NOT BE CONNECTED TO THE DETENTION SYSTEM.

RESTRICTOR CATCH BASIN NOTES:

1. USE A MINIMUM OF A 72 IN. DIAM. TYPE 2 CATCH BASIN WHEN CONNECTING PIPE MATERIAL IS CONCRETE OR LCPE. A 54 IN. DIAM. TYPE 2 CATCH BASIN MAY BE USED FOR OTHER CIRCULAR SINGLE WALL PIPE (SUCH AS CORRUGATED ALUMINUM PIPE).
2. OUTLET PIPE: MIN. 6 INCH.
3. METAL PARTS: CORROSION RESISTANT NON-GALVANIZED PARTS PREFERRED. GALVANIZED PIPE PARTS TO HAVE ASPHALT TREATMENT 1.
4. FRAME AND LADDER OR STEPS OFFSET SO:
   (A) CLEANOUT GATE IS VISIBLE FROM TOP;
   (B) CLIMB-DOWN SPACE IS CLEAR OF RISER AND CLEANOUT GATE;
   (C) FRAME IS CLEAR OF CURB.
5. IF METAL OUTLET PIPE CONNECTS TO CEMENT CONCRETE PIPE, OUTLET PIPE TO HAVE SMOOTH O.D. EQUAL TO CONCRETE PIPE I.D. LESS 1/4 IN. PROVIDE AT LEAST ONE 3 X 0.090 GAUGE SUPPORT BRACKET ANCHORED TO CONCRETE WALL WITH 5/8 IN. STAINLESS STEEL EXPANSION BOLTS OR EMBEDDED SUPPORTS 2 IN. INTO CATCH BASIN WALL (MAXIMUM 3"-0" VERTICAL SPACING).
6. THE SHEAR GATE SHALL BE MADE OF ALUMINUM ALLOY IN ACCORDANCE WITH ASTM B 26M AND ASTM B 275, DESIGNATION ZG32A; OR CAST IRON IN ACCORDANCE WITH ASTM A 48, CLASS 30B. THE LIFT HANDLE SHALL BE MADE OF SIMILAR METAL TO THE GATE (TO PREVENT GALVANIC CORROSION). IT MAY BE SOLID ROD OR HOLLOW TUBING, WITH ADJUSTABLE HOOK AS REQUIRED. A NEOPRENE RUBBER GASKET IS REQUIRED BETWEEN THE RISER MOUNTING FLANGE AND THE GATE FLANGE. INSTALL THE GATE SO THAT THE LEVEL-LINE MARK IS LEVEL WHEN THE GATE IS CLOSED. THE MATING SURFACES OF THE LID AND THE BODY SHALL BE MACHINED FOR PROPER FIT. ALL SHEAR GATE BOLTS SHALL BE STAINLESS STEEL.
7. THE UPPER CATCH BASIN IS REQUIRED IF THE LENGTH OF THE DETENTION PIPE IS GREATER THAN 50 FEET.

GENERAL NOTES:

1. SITE PLAN AS PROVIDED BY ARCHITECT ON FEBRUARY 22, 2025.
2. GRADING PLAN AS PROVIDED BY ARCHITECT AND SHOWN HERE FOR REFERENCE.
3. CONTRACTOR SHALL POT-HOLE LOCATION OF EXISTING UTILITIES TO BE RECONNECTED PRIOR TO BEGINNING OF CONSTRUCTION. NOTIFY ENGINEER OF ANY CONFLICTS.
4. EXISTING UTILITY LOCATIONS SHOWN HEREON ARE APPROXIMATE ONLY. IT SHALL BE THE CONTRACTOR'S RESPONSIBILITY TO DETERMINE THE EXACT VERTICAL AND HORIZONTAL LOCATION OF ALL EXISTING UNDERGROUND UTILITIES PRIOR TO COMMENCING CONSTRUCTION. NO REPRESENTATION IS MADE THAT ALL EXISTING UTILITIES ARE SHOWN HEREON. THE ENGINEER ASSUMES NO RESPONSIBILITY FOR UTILITIES SHOWN, OR NOT SHOWN IN THEIR PROPER LOCATION.
5. ALWAYS CALL 811 BEFORE YOU DIG.

STORM DRAINAGE NOTES:

1. ROOF DRAINS SHALL BE 6" PVC SDR 35 TIGHTLINE WITH A MINIMUM SLOPE OF 2.00%
2. FOOTING/WALL DRAINS SHALL BE 4" PERFORATED PVC WRAPPED IN FILTER FABRIC PER CITY STANDARDS.
3. FOOTING/WALL DRAINAGE SYSTEMS AND ROOF DOWNSPOUT SYSTEM SHALL NOT BE INTERCONNECTED UNLESS SUCH CONNECTION IS MADE AT LEAST ONE FOOT BELOW THE FOOTING/WALL DRAINAGE SYSTEM AND DOWN SLOPE OF THE BUILDING FOUNDATION.
4. USE SAND COLLARS AT CB CONNECTIONS TO PVC PIPE.
5. PROVIDE TRAFFIC RATED GRATES IN ALL PARKING AREAS.
6. PROVIDE SLEEVES THROUGH ALL WALLS/ ROCKERIES
7. SEE ARCHITECTURAL PLAN SET FOR VEGETATED ROOF SPECIFICATIONS.
8. ALL DRAIN LIDS SHALL HAVE DECORATIVE GRATE COVERS. IRON AGE OR EQUAL PER ARCHITECTURAL SPECIFICATION.

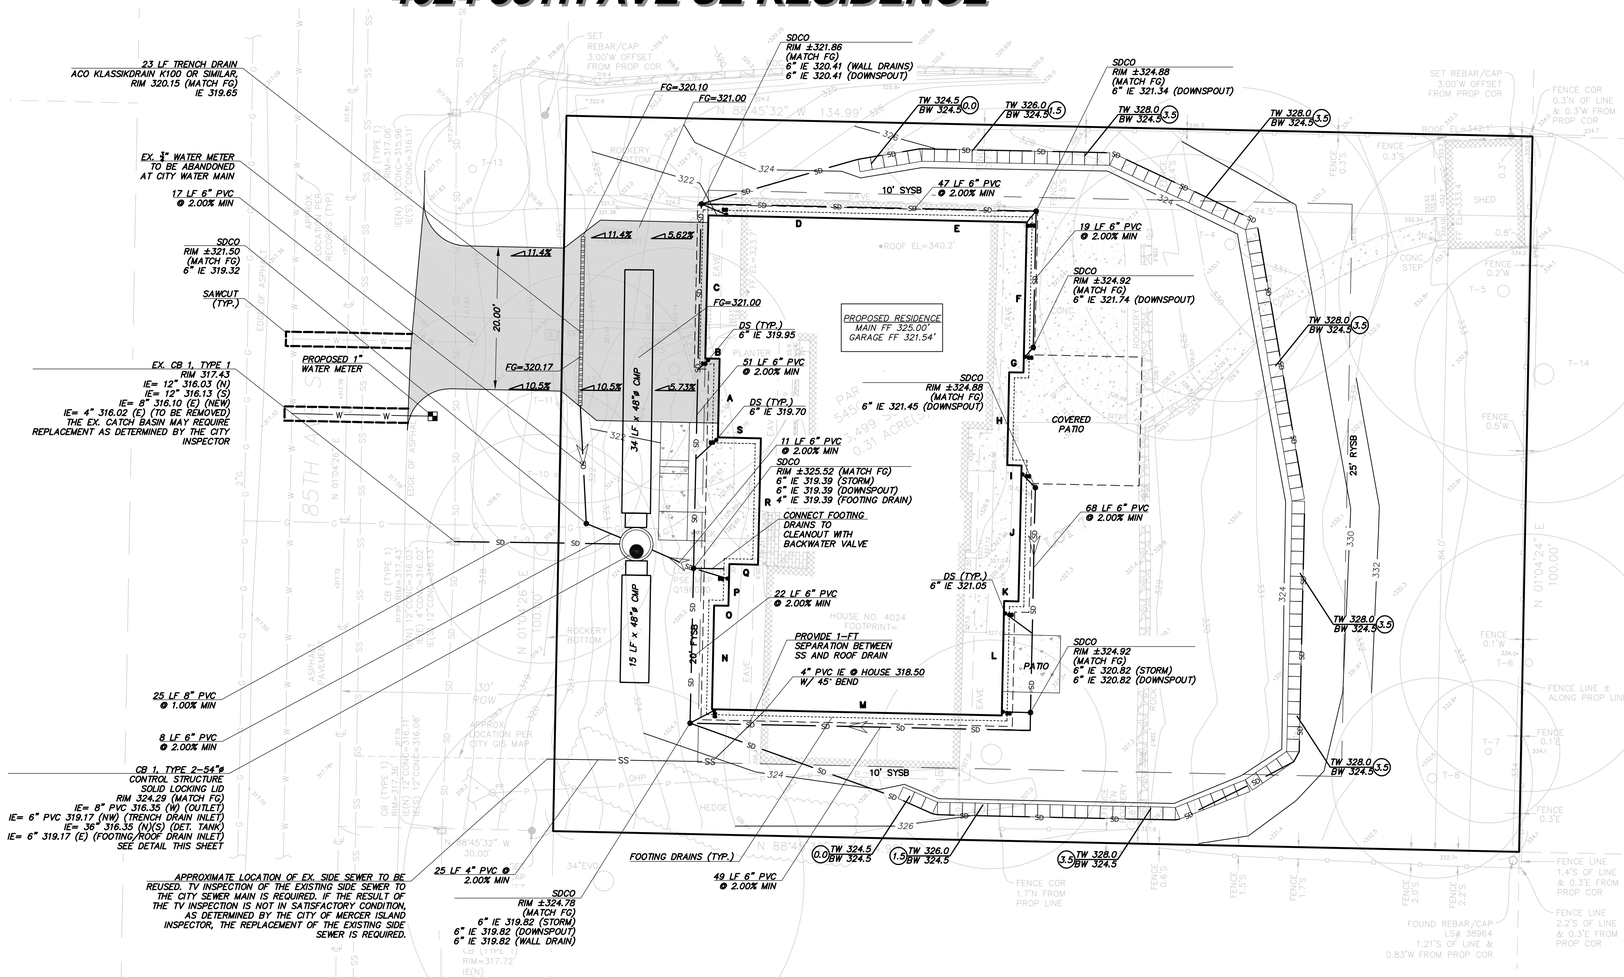

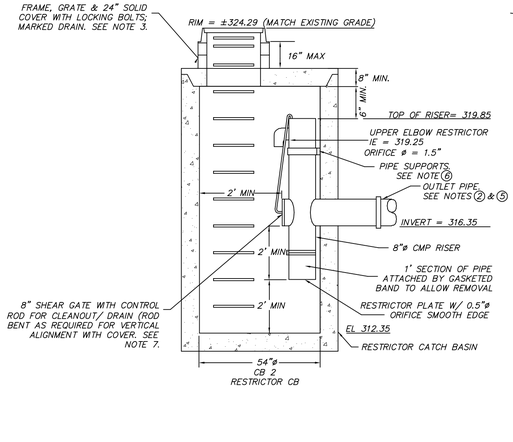

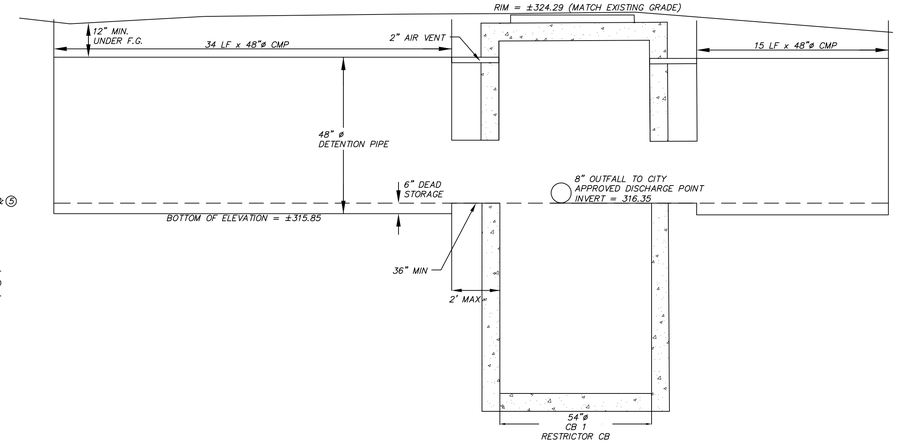

ON-SITE DETENTION DESIGN FOR PROJECTS BETWEEN 500 SF AND 9,500 SF NEW PLUS REPLACED IMPERVIOUS SURFACE AREA

New and Replaced Impervious Surface Area (sf)	Detention Pipe Diameter (in)	Detention Pipe Length (ft)		Lowest Orifice Diameter (in)[3]		Distance from Outlet Invert to Second Orifice (ft)		Second Orifice Diameter (in)	
		B soils	C soils	B soils	C soils	B soils	C soils	B soils	C soils
500 to 1,000 sf	36"	30	22	0.5	0.5	2.2	2.0	0.5	0.8
	48"	18	11	0.5	0.5	3.3	3.2	0.9	0.8
	60"	11	7	0.5	0.5	4.2	3.4	0.5	0.6
1,001 to 2,000 sf	36"	66	43	0.5	0.5	2.2	2.3	0.9	1.4
	48"	34	23	0.5	0.5	3.2	3.3	0.9	1.2
	60"	22	14	0.5	0.5	4.3	3.6	0.9	0.9
2,001 to 3,000 sf	36"	90	66	0.5	0.5	2.2	2.4	0.9	1.9
	48"	48	36	0.5	0.5	3.1	2.8	0.9	1.5
	60"	30	20	0.5	0.5	4.2	3.7	0.9	1.1
3,001 to 4,000 sf	36"	120	78	0.5	0.5	2.4	2.2	1.4	1.6
	48"	62	42	0.5	0.5	2.8	2.9	0.8	1.3
	60"	42	26	0.5	0.5	3.8	3.9	0.9	1.3
4,001 to 5,000 sf	36"	134	91	0.5	0.5	2.8	2.2	1.7	1.5
	48"	73	49	0.5	0.5	3.6	2.9	1.6	1.5
	60"	46	31	0.5	0.5	4.6	3.5	1.6	1.3

LAWN AND LANDSCAPE AREA NOTE:

THE LAWN AND LANDSCAPE AREAS ARE REQUIRED TO PROVIDE POST-CONSTRUCTION SOIL QUALITY AND DEPTH IN ACCORDANCE WITH BMP T5.13. THE PROJECT CIVIL ENGINEER MUST PROVIDE A LETTER OF CERTIFICATION TO ENSURE THAT THE LAWN AND LANDSCAPE AREAS ARE MEETING THE POST-CONSTRUCTION SOIL QUALITY AND DEPTH REQUIREMENTS SPECIFIED ON THE APPROVED PLAN SET PRIOR TO FINAL INSPECTION OF THE PROJECT.

BUILDING HEIGHT CALCS:

A. AVERAGE BUILDING ELEVATION (ABE)	
CALCULATIONS LOCATED ON SHEET:	#0000
B. ALLOWABLE BUILDING HEIGHT (ABE+30)	356.33 FT
C. PROPOSED BUILDING HEIGHT	355.20 FT
D. BENCHMARK ELEVATION	293.09 FT
E. DESCRIBE BENCHMARK LOCATION	TBM 'A'
F. SLOPING LOT-MAX HEIGHT OF TOP EXTERIOR WALL FACADE ABOVE LOWEST EXISTING GRADE (30-FT MAX):	35'-8.4"

STORMWATER CALCULATION AREAS NOTE:

LOT AREA: 13,500 S.F. (+0.310 ACRES)
PROJECT AREA: 10,958 S.F. (0.252 ACRES)

EX. IMPERVIOUS AREAS ON LOT:		
DRIVEWAY	394	S.F.
ROOF AREA	2,374	S.F.
SIDEWALKS/PATIOS	980	S.F.
TOTAL EX.	3,748	S.F.

NEW & REPLACED IMPERVIOUS AREAS ON LOT:		
DRIVEWAY	518	S.F.
SIDEWALKS/PATIO	124	S.F.
ROOF AREA	3,560	S.F.
TOTAL PROP.	4,202	S.F.
OFFSITE P.G.I.S	493	S.F.
NEW/REPLACED P.G.I.S.	1,016	S.F.

NORTH
GRAPHIC SCALE
0 5 10 20
1 INCH = 10 FT.

Call 2 Working Days Before You Dig
811
Utilities Underground Location Center
(ID,MT,ND,OR,WA)

R: \2025\0\25001\3\Drawings\Plots\Engineering\03_04-3UTL25001.dwg 8/12/2025 1:58:04 PM COPYRIGHT © 2025, D.R. STRONG CONSULTING ENGINEERS INC.

D.R. STRONG CONSULTING ENGINEERS
ENGINEERS PLANNERS SURVEYORS
620 - 7th AVENUE KIRKLAND, WA 98033
O 425.827.3063 F 425.827.2423

4024 85TH AVE SE
MERCER ISLAND RESIDENCE

STORM DRAINAGE PLAN
4024 85TH AVE SE
MERCER ISLAND, WA 98040
PARCEL NO. 5450300155

NW EASTSIDE BUILDERS, LLC
9675 SE 36TH STREET, SUITE 105
MERCER ISLAND WA 98040
253-405-5587

REGISTERED PROFESSIONAL ENGINEER
STATE OF WASHINGTON
53232
8-12-2025

DATE	REVISION	APR
7.11.25	CITY COMMENTS	YLP
8.12.25	CITY COMMENTS	YLP

DRAFTED BY: ECM
DESIGNED BY: ECM
PROJECT ENGINEER: YLP
DATE: 02.24.2025
PROJECT NO.: 25001

DRAWING: C3
SHEET: 3 OF 5

NW 1/4 NW 1/4 SECTION 18, TOWNSHIP 24 N, RANGE 5 E, W.M.

4024 85TH AVE SE RESIDENCE

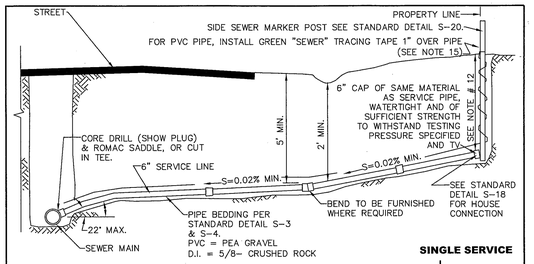

SINGLE SERVICE

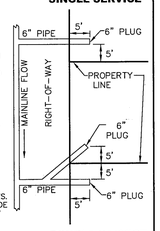

DOUBLE SERVICE

NOTES

1. ELBOWS SHALL NOT BE GREATER THAN 45 DEGREES.
2. CLEAN OUT IS REQUIRED FOR EACH PIPE LENGTH GREATER THAN 100' AND FOR EACH 90° ACCUMULATED ELBOW/100'.
3. RIGHT-OF-WAY RESTORATION SHALL MATCH OR EXCEED THE ORIGINAL CONDITION AND BE IN ACCORDANCE WITH CITY STANDARDS.
4. ALL TRENCH BACKFILL IN PUBLIC RIGHT-OF-WAY OR ROADWAY AREAS SHALL BE CRUSHED SURFACING PER WSDOT 9-09.9(3) OR BANK RUN GRAVEL PER WSDOT 9-03.19, COMPACTED IN 6" LIFTS OR MAY BE CDF WHEN DIRECTED BY THE CITY ENGINEER (SEE DETAIL S-3).
5. LAY PIPE IN STRAIGHT LINE BETWEEN BENDS. MAKE ALL CHANGES IN GRADE OR LINE WITH 1/8 BEND OR WYE. 90° CHANGE WITH 1/8 BEND AND WYE.
6. 6" SEWER PIPE MINIMUM SIZE IN RIGHT-OF-WAY, AND ELSEWHERE AS DIRECTED BY ENGINEER. 2% MIN. GRADE (UNLESS DIRECTED BY ENGINEER), 50% MAXIMUM.
7. ALL A.C. MAINS TO BE TAPPED IN ACCORDANCE WITH WAC 296-62-00775 STATE/FEDERAL GUIDELINES AND CERTIFICATION.
8. CONSTRUCTION IN RIGHT-OF-WAY MUST BE DONE BY A REGISTERED AND LICENSED CONTRACTOR.
9. ALL CONSTRUCTION SHALL BE IN ACCORDANCE WITH CURRENT CITY SEWER ORDINANCES.
10. WHERE CITY ENGINEER ALLOWS SIDE SEWER CONNECTIONS TO MANHOLE, INVERT OF SIDE SEWER SHALL BE EQUAL TO OR ABOVE MAIN SEWER CROWN, BUT NOT TO EXCEED 18" ABOVE INVERT OF MAIN SEWER.
11. UNLESS OTHERWISE INDICATED ON PLAN, SIDE SEWER SHALL BE MIN. OF 6' DEEP AT PROPERTY LINE, OR 5' LOWER THAN THE LOWEST ELEVATION, WHICH EVER IS LOWER.
12. ALL PIPE MATERIALS NOT TO STANDARDS WILL BE ABANDONED AND REPLACED WITH DUCTILE IRON OR PVC PIPE OF THE SAME SIZE.
13. IF A BUILDING SEWER IS TO SERVE MORE THAN ONE PROPERTY, BY JOINT AGREEMENT OF THE OWNERS, AN APPROVED EASEMENT INSURING THAT ALL PROPERTIES INVOLVED SHALL HAVE PERPETUAL USE OF THE SIDE SEWER, HAVING PROVISIONS FOR OPERATION, MAINTENANCE, RECONSTRUCTION AND FOR ACCESS FOR REPAIR PURPOSES, SHALL BE SIGNED BY THE OWNERS. THIS EASEMENT SHALL BE RECORDED WITH THE COUNTY AUDITOR. A SIX INCH (MINIMUM) DIAMETER PIPE SHALL BE USED FOR THE COMMON LINE AND A SIX INCH CLEANOUT EXTENDING TO WITHIN 12 INCHES OF THE GROUND SURFACE SHALL BE PROVIDED AT THE WYE WHERE THE UPPER GRADE CONNECTIONS ARE MADE. BACKWATER VALVES SHALL BE INSTALLED ON SERVICE LINES UPSTREAM OF THE CONNECTION TO THE SHARED SIDE SEWER.
14. THE CITY ENGINEER MAY REQUIRE BACKWATER VALVES ON SIDE SEWERS WHEN DEEMED NECESSARY. THE EFFECTIVE OPERATION AND MAINTENANCE OF ANY BACKWATER VALVE SHALL BE THE RESPONSIBILITY OF THE OWNER OF THE SIDE SEWER.
15. UTILITY PIPE TRACER TAPE SHALL BE DETECTABLE BELOW GROUND SURFACE, COLOR CODED, WITH UTILITY NAME PRINTED ON TAPE. CONDUCTIVE WARNING TAPE REQUIRED OVER ALL WATER PIPE. TAPE SHALL BE MANUFACTURER'S STANDARD PERMANENT, BRIGHT-COLORED, CONTINUOUS PRINTED PLASTIC TAPE, ALUMINUM BACKED, INTENDED FOR DIRECT-BURIAL SERVICE. TAPE SHALL BE NOT LESS THAN 6" WIDE X 4 MILS THICK.

CITY OF MERCER ISLAND
STANDARD DETAILS
SEWER
SIDE SEWER CONNECTION AND STUB

6-5-2009	NO SCALE	**S-17**

REV DATE | APPROVED

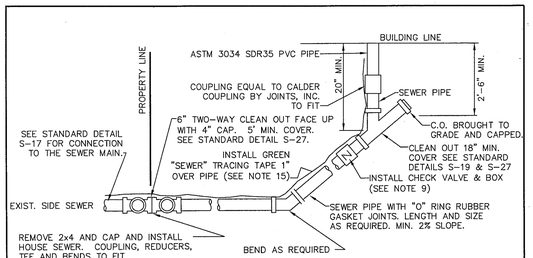

BUILDING CONNECTION

NOTES

1. ELBOWS SHALL NOT BE GREATER THAN 45 DEGREES.
2. CLEAN OUT IS REQUIRED FOR EACH PIPE LENGTH GREATER THAN 100' AND FOR EACH 90° ACCUMULATED ELBOW/100'.
3. ALL HOUSE PLUMBING OUTLETS MUST BE CONNECTED TO THE SEWER. NO DOWN SPOUTS OR STORM DRAINAGE MAY BE CONNECTED TO THE SEWER SYSTEM.
4. 18" MINIMUM COVERAGE OVER PIPE.
5. LAY PIPE IN STRAIGHT LINE BETWEEN BENDS. MAKE ALL CHANGES IN GRADE OR LINE WITH ⅛ BEND OR WYE. 90° CHANGE WITH 1/8 BEND AND WYE.
6. 4" SEWER PIPE MINIMUM SIZE ON PROPERTY. 2% MINIMUM GRADE.
7. ALL CONSTRUCTION SHALL BE IN ACCORDANCE WITH CURRENT SEWER ORDINANCES.
8. ALL CONSTRUCTION REQUIRES A PLAN SHOWING PROPERTY AND DIMENSIONS AND COMPLETION OF SIDE SEWER APPLICATION AND MAINTENANCE AGREEMENT, AS NEEDED.
9. BACK WATER VALVE (CHECK VALVE) IS REQUIRED:
   A. IF CONNECTED TO A SHARED SIDE SEWER.
   B. IF CONNECTION AT HOUSE IS LOWER THAN BOTH UPSTREAM AND DOWNSTREAM MANHOLE.
   C. SEE S-23 & S-24 FOR LAKE LINE REQUIREMENTS.
10. AS-BUILT DRAWING SHOWING LOCATION OF SIDE SEWER & ALL BENDS, C.O. ETC., IN RELATION TO THE HOUSE IS REQUIRED AFTER INSPECTION & INSTALLATION. SEE STANDARD DETAIL S-38 FOR A TYPICAL "AS BUILT".
11. THE MINIMUM PIPE SIZE FOR SIDE SEWERS SHALL BE:
    6" – WITHIN THE PUBLIC RIGHT-OF-WAY.
    4" – SINGLE FAMILY RESIDENCES.
    6" – 2 TO 6 SINGLE FAMILY RESIDENCES.
    6" – BUILDINGS OTHER THAN SINGLE FAMILY RESIDENCES.
12. UTILITY PIPE TRACER TAPE SHALL BE DETECTABLE BELOW GROUND SURFACE, COLOR CODED, WITH UTILITY NAME PRINTED ON TAPE. CONDUCTIVE WARNING TAPE REQUIRED OVER ALL WATER PIPE. TAPE SHALL BE MANUFACTURER'S STANDARD PERMANENT, BRIGHT-COLORED, CONTINUOUS PRINTED PLASTIC TAPE, ALUMINUM BACKED, INTENDED FOR DIRECT-BURIAL SERVICE. TAPE SHALL BE NOT LESS THAN 6" WIDE X 4 MILS THICK.

CITY OF MERCER ISLAND
STANDARD DETAILS
SEWER
HOUSE SEWER CONNECTION

6-5-2009	NO SCALE	**S-18**

REV DATE | APPROVED

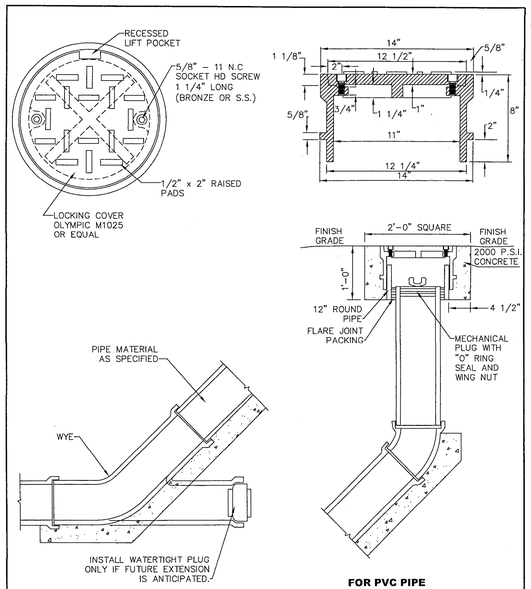

FOR PVC PIPE

NOTES

1. SEE S-27 FOR INSTALLATION DETAILS.

CITY OF MERCER ISLAND
STANDARD DETAILS
SEWER
CLEAN OUT DETAIL

6-5-2009	NO SCALE	**S-19**

REV DATE | APPROVED

DRAWN BY: FERN LIDDELL

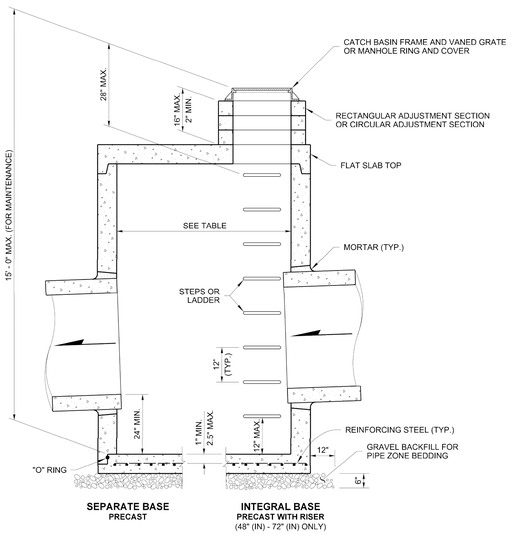

SEPARATE BASE
PRECAST

INTEGRAL BASE
PRECAST WITH RISER
(48" (IN) - 72" (IN) ONLY)

NOTES

1. No steps are required when height is 4' or less.
2. The bottom of the precast catch basin may be sloped to facilitate cleaning.
3. The rectangular frame and grate may be installed with the flange up or down. The frame may be cast into the adjustment section.
4. Knockouts shall have a wall thickness of 2" (in) minimum to 2.5" (in) maximum. Provide a 1.5" (in) minimum gap between the knockout wall and the outside of the pipe. After the pipe is installed, fill the gap with joint mortar in accordance with **Standard Specification Section 9-04.3**.

CATCH BASIN DIMENSIONS

CATCH BASIN DIAMETER	MIN. WALL THICKNESS	MIN. BASE THICKNESS	MAXIMUM KNOCKOUT SIZE	MINIMUM DISTANCE BETWEEN KNOCKOUTS
48"	4"	6"	36"	8"
54"	4.5"	8"	42"	8"
60"	5"	8"	48"	8"
72"	6"	8"	60"	12"
84"	8"	12"	72"	12"
96"	8"	12"	84"	12"
120"	10"	12"	96"	12"
144"	12"	12"	108"	12"

PIPE ALLOWANCES

CATCH BASIN DIAMETER	PIPE MATERIAL WITH MAXIMUM INSIDE DIAMETER				
	CONCRETE	ALL METAL	CPSSP ① PP ④	SOLID WALL PVC ②	PROFILE WALL PVC ③
48"	24"	30"	24"	30"	30"
54"	30"	36"	30"	36"	36"
60"	36"	42"	36"	42"	42"
72"	42"	54"	42"	48"	48"
84"	54"	60"	54"	48"	48"
96"	60"	72"	60"	48"	48"
120"	66"	84"	60"	48"	48"
144"	78"	96"	60"	48"	48"

① Corrugated Polyethylene Storm Sewer Pipe (See **Standard Specification Section 9-05.20**)
② (See **Standard Specification Section 9-05.12(1)**)
③ (See **Standard Specification Section 9-05.12(2)**)
④ Polypropylene Pipe (See **Standard Specification Section 9-05.24**)

JULIE HEILMAN STATE OF WASHINGTON 43810 REGISTERED PROFESSIONAL ENGINEER
Julie Heilman
Heilman, Julie
Feb 20 2018 12:49 PM
cosign

CATCH BASIN TYPE 2

STANDARD PLAN B-10.20-02

SHEET 1 OF 1 SHEET

APPROVED FOR PUBLICATION
Carpenter, Jeff
Mar 2 2018 10:01 AM
cosign
STATE DESIGN ENGINEER
Washington State Department of Transportation

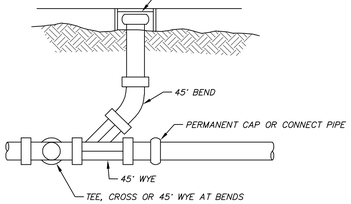

STORM DRAIN CLEAN-OUT

NTS

SIDE SEWER NOTES:

1. FOUR-INCH (4") PIPE MUST BE LAID AT A MINIMUM 2% GRADE. SIX-INCH (6") PIPE MUST BE LAID AT A MINIMUM 1.2% GRADE.
2. SIDE SEWERS MUST NOT BE CLOSER THAN 30" TO ANY FOUNDATION WALL OR OUTER LINE OF ANY FOOTINGS, PILINGS, OR BUILDING SUPPORTS. A CLEAN-OUT MUST BE INSTALLED AT THE CONNECTION, AND MUST BE 36" FROM THE FOUNDATION.
3. MINIMUM COVER MUST BE 42"IN THE PUBLIC RIGHT-OF-WAY, 30" IN PRIVATE ROADWAYS AND UNDER DITCHES, AND 18" ON PRIVATE PROPERTY.
4. SEWER MAINS MAY BE CORED OR A "T" INSTALLED IN THE MAIN LINE WHERE NO SEWER STUB EXISTS.
5. SIDE SEWERS WHEN USING OPEN CUT CONSTRUCTION METHODS MUST BE BEDDED WITH IMPORTED MATERIAL TO 4" BELOW AND 6" ABOVE THE INSTALLED PIPE. THE BROAD, "BELL" ENDS OF PIPE MUST BE LAID UPHILL.
6. IMPORTED BACKFILL MATERIAL WILL BE REQUIRED IN ALL PAVED AREAS AND MUST BE COMPACTED TO 95% OF MAXIMUM DENSITY IN 1 FT. LIFTS. IN PUBLIC RIGHT OF WAY, ONLY SELECT MATERIAL (5/8" MINUS C.R.) WILL BE ALLOWED FOR BEDDING AND BACKFILL.
7. PARALLEL SEWER AND WATER SERVICE LINES MUST BE AT LEAST 4 FEET APART WHEN LAID HORIZONTALLY, AND AT LEAST 2 FEET APART WHEN LAID VERTICALLY, WITH THE SEWER THE DEEPER OF THE TWO LINES. IF THE LINES MUST CROSS, THEY MUST CROSS AT 90 DEGREES TO ONE ANOTHER AND HAVE AT LEAST 2 FEET OF VERTICAL CLEARANCE.
8. ALL CHANGES IN DIRECTION MUST BE MADE WITH 1/8 BENDS (45 DEGREES), 1/16 BENDS (22 ½ DEGREES), OR "Y" BRANCHES WITH THE STRAIGHT-THROUGH OPENING PLUGGED FOR CLEAN-OUT. NO MORE THAN TWO BENDS ARE PERMITTED BETWEEN CLEAN-OUTS, WHICH MUST BE PLACED AT LEAST EVERY 100 FEET. CLEAN-OUTS MUST EXTEND TO WITHIN 12" OF THE FINISHED GRADE AND CAPPED WITH A WATER-TIGHT PLUG. CLEAN-OUTS IN PAVED AREAS, PATIOS, OR SIDEWALKS MUST HAVE CAST IRON FRAMES AND COVERS WITH LOCKING LIDS SET TO FINISHED PAVED GRADE.
9. PIPE MATERIALS: ASTM 3034 SDR 35 PVC PIPE, FUSED SOLID WALL HDPE, SCHEDULE 40 ABS, DIP OR CIP (UP TO 8 FT. DEPTH). OVER 8 FT. DEPTH AND SLOPES MORE THAN 20% DIP, CIP, OR FUSED SOLID WALL HDPE ARE REQUIRED.
10. BEDDING MATERIAL FOR OPEN CUT CONSTRUCTION MUST BE PEA GRAVEL, SAND, CONTROL DENSITY FILL (CDF), OR 5/8" MINUS C.R.
11. SELECT BACKFILL MATERIAL SHALL BE 5/8" MINUS C.R. OR CONTROL DENSITY FILL (CDF).
12. IMPORTED BACKFILL MATERIAL SHALL BE BANK RUN GRAVEL OR PIT RUN GRAVEL FROM AN APPROVED SUPPLIER MEETING APWA/WSDOT GRADATION SPECIFICATIONS. NOT ALLOWED IN RIGHT-OF-WAY.
13. RUBBER GASKETS MUST BE USED WHEN APPROPRIATE.
14. RIGID COUPLINGS MUST BE USED FOR CONNECTIONS TO EXISTING STUBS IN RIGHT-OF-WAY.
15. A STAINLESS STEEL STRAP AND SADDLE (ROMAC) MUST BE USED FOR CORING.
16. TESTING: THE RATE OF LEAKAGE MUST NOT EXCEED THE FOLLOWING AMOUNTS PER 100 FT. OF PIPE:
    4" PIPE 1.6 GAL/HR 6" PIPE 2.4 GAL/HR
17. INSPECTION IS REQUIRED PRIOR TO BACKFILLING. THE CITY REQUIRES AT LEAST 24 HOURS NOTICE PRIOR TO INSPECTIONS.

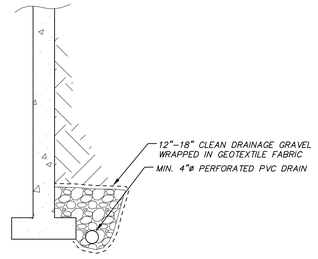

WALL DRAINS

NTS

WALL DRAIN NOTES:

1. GRADE DRAIN PIPE TO DIRECT WATER TO PROPOSED COLLECTION SYSTEM AS SHOWN ON PLAN SHEETS.
2. FOOTING/WALL DRAINAGE SYSTEMS AND ROOF DOWNSPOUT SYSTEM SHALL NOT BE INTERCONNECTED UNLESS SUCH CONNECTION IS MADE AT LEAST ONE FOOT BELOW THE FOOTING/WALL DRAINAGE SYSTEM AND DOWN SLOPE OF THE FOOTING/WALL.

Call 2 Working Days Before You Dig
811
Utilities Underground Location Center
(ID,MT,ND,OR,WA)

DRS
D.R. STRONG CONSULTING ENGINEERS
ENGINEERS PLANNERS SURVEYORS
620 - 7th AVENUE KIRKLAND, WA 98033
O 425.827.3063 F 425.827.2423

4024 85TH AVE SE MERCER ISLAND RESIDENCE

NOTES AND DETAILS
4024 85TH AVE SE
MERCER ISLAND, WA 98040
PARCEL NO. 5450300155

NW EASTSIDE BUILDERS, LLC
9675 SE 36TH STREET, SUITE 105
MERCER ISLAND WA 98040
253-405-5587

JOSEPH PIEDRAHITA STATE OF WASHINGTON 53230 REGISTERED PROFESSIONAL ENGINEER 8-12-2025

DATE	REVISION	APR
7.11.25	CITY COMMENTS	YLP
8.12.25	CITY COMMENTS	YLP

DRAFTED BY: ECM
DESIGNED BY: ECM
PROJECT ENGINEER: YLP
DATE: 02.24.2025
PROJECT NO.: 25001

DRAWING: C4
SHEET: 4 OF 5

COPYRIGHT © 2025, D.R. STRONG CONSULTING ENGINEERS INC.

NW 1/4 NW 1/4 SECTION 18, TOWNSHIP 24 N, RANGE 5 E, W.M.

4024 85TH AVE SE RESIDENCE

LEGEND:

- VIABLE TREE
- TREE TO BE REMOVED
- DRIPLINE OF VIABLE TREE TO BE RETAINED
- DRIPLINE OF VIABLE TREE TO BE REMOVED
- TREE PROTECTION FENCING (SEE SHEET C2 FOR DETAIL)

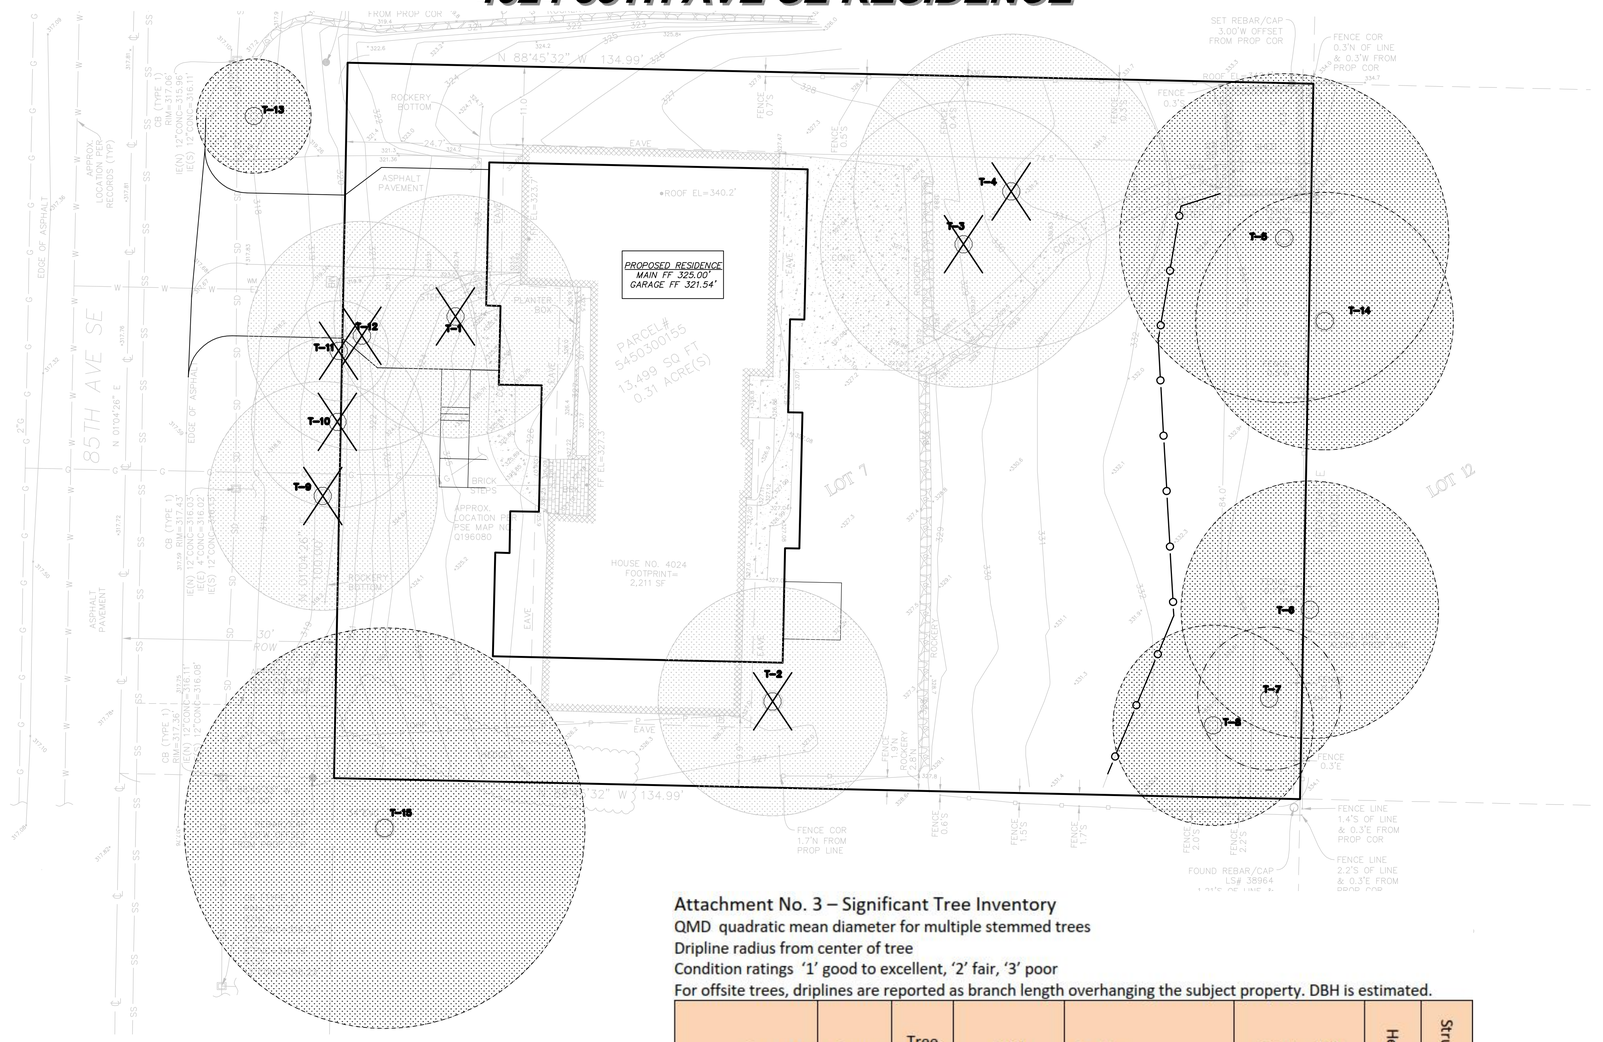

TREE RETENTION CALCULATION

TOTAL NUMBER OF EXCEPTIONAL TREES:	1
TOTAL LARGE TREES:	6
TOTAL SMALL TREES:	1
TOTAL VIABLE ONSITE TREES:	7
REQUIRED: 30% VIABLE TREES:	2.1
PROPOSED VIABLE TREES RETAINED:	3

TREE PROTECTION NOTES

PRIOR TO CONSTRUCTION, THE FOLLOWING MEASURES SHOULD BE TAKEN TO ENSURE THAT TREES ARE NOT DAMAGED.

1) PROJECT MANAGERS SHOULD REVIEW THE CONTENTS OF THIS REPORT, INCLUDING THE INTERNATIONAL SOCIETY OF ARBORICULTURE'S RECOMMENDED TREE PROTECTION MEASURES FOUND BELOW UNDER SECTIONS 7 AND 8 OF THIS REPORT. INFORMATION CONTAINED HEREIN SHOULD BE RELAYED TO WORKERS AND SUBCONTRACTORS.

2) ONCE THE MULCH HAS BEEN APPLIED, TREE PROTECTION FENCING SHOULD BE INSTALLED PER THE ISA RECOMMENDED TREE PROTECTION FENCING DETAIL BELOW.

Attachment No. 3 – Significant Tree Inventory

QMD quadratic mean diameter for multiple stemmed trees
Dripline radius from center of tree
Condition ratings '1' good to excellent, '2' fair, '3' poor
For offsite trees, driplines are reported as branch length overhanging the subject property. DBH is estimated.

Category	Grove	Tree No.	DBH	Species	Dripline (R')	Health	Structure
Large	No	1	18.5"	Flowering cherry	17'	2	2
Exceptional	No	2	35"	Western red-cedar	16'	1	2
Large	No	3	21.5"	Grand fir	20'	1	1
Large	No	4	19"	Douglas-fir	22'	1	1
Large	No	5	20"	Deodar cedar	23'	1	2
Large	No	6	13.5"	Scots pine	18'	1	2
Large	No	7	11"	Flowering cherry	10'	3	3
Large	No	8	(5) 7-8"	Magnolia, Tulip	14'	1	2
Large	No	9	11"	Flowering cherry	16'	2	2
Small	No	10	6"	Japanese maple	12'	1	2
Small	No	11	6"	Holly	7'	1	1
Small	No	12	6"	Purpleleaf plum	16'	2	2
Large	No	13	13"	Blue spruce	8'	1	1
Exceptional	No	14	35"	Grand fir	18'	1	1
Exceptional	No	15	38"	Deodar cedar	18'	1	1

NORTH
GRAPHIC SCALE
0 5 10 20
1 INCH = 10 FT.

Call 2 Working Days Before You Dig
811
Utilities Underground Location Center
(ID,MT,ND,OR,WA)

D.R. STRONG CONSULTING ENGINEERS
ENGINEERS PLANNERS SURVEYORS
620 - 7th AVENUE KIRKLAND, WA 98033
O 425.827.3063 F 425.827.2423

4024 85TH AVE SE
MERCER ISLAND RESIDENCE

TREE RETENTION AND PLANTING PLAN

4024 85TH AVE SE
MERCER ISLAND, WA 98040
PARCEL NO. 5450300155

NW EASTSIDE BUILDERS, LLC

9675 SE 36TH STREET, SUITE 105
MERCER ISLAND WA 98040
253-405-5587

LOUIS P. PIEDISCALZO — STATE OF WASHINGTON — 53232 — REGISTERED PROFESSIONAL ENGINEER — 8-12-2025

DATE	REVISION	APR
7.11.25	CITY COMMENTS	YLP
8.12.25	CITY COMMENTS	YLP

DRAFTED BY: ECM
DESIGNED BY: ECM
PROJECT ENGINEER: YLP
DATE: 02.24.2025
PROJECT NO.: 25001

DRAWING: C5
SHEET: 5 OF 5

COPYRIGHT © 2025, D.R. STRONG CONSULTING ENGINEERS INC.

ENERGY CODE

2021 WASHINGTON STATE ENERGY CODE/ IECC (WSEC)

ALL CLIMATE ZONES - TABLE R402.1.3

INSULATION AND FENESTRATION REQUIREMENTS BY COMPONENT[A]

	PRESCRIPTIVE	EFFICIENT BUILDING ENVELOPE OPTION 1.2
FENESTRATION U-FACTOR [B]	0.30	0.25
SKYLIGHT [B] U-FACTOR	0.50	0.50
CEILING R-VALUE [E]	60	60
WOOD FRAME WALL [G] R-VALUE	20+5 OR 13+10	20+5 OR 13+10
FLOOR R-VALUE	30	38
BELOW GRADE WALL [C,H] R-VALUE	10/15/21 INT + 5TB	10/15/21 INT + 10TB
SLAB [D,F] R-VALUE & DEPTH	10, 4 FT.	10, ENTIRE SLAB

TABLE R402.1.1 FOOTNOTES

FOR SI: 1 FOOT = 304.8 MM, CI = CONTINUOUS INSULATION, INT. = INTERMEDIATE FRAMING.

[A] R-VALUES ARE MINIMUMS. U-FACTORS AND SHGC ARE MAXIMUMS. WHEN INSULATION IS INSTALLED IN A CAVITY WHICH IS LESS THAN THE LABEL OR DESIGN THICKNESS OF THE INSULATION, THE COMPRESSED R-VALUE OF THE INSULATION FROM APPENDIX TABLE A101.4 SHALL NOT BE LESS THAN THE R-VALUE SPECIFIED IN THE TABLE.

[B] THE FENESTRATION U-FACTOR COLUMN EXCLUDES SKYLIGHTS.

[C] "10/15/21 +5TB" MEANS R-10 CONTINUOUS INSULATION ON THE EXTERIOR OF THE WALL, OR R-15 CONTINUOUS INSULATION ON THE INTERIOR OF THE WALL, OR R-21 CAVITY INSULATION PLUS A THERMAL BREAK BETWEEN THE SLAB AND THE BASEMENT WALL AT THE INTERIOR OF THE BASEMENT WALL. "10/15/21 +5TB" SHALL BE PERMITTED TO BE MET WITH R-13 CAVITY INSULATION ON THE INTERIOR OF THE BASEMENT WALL PLUS R-5 CONTINUOUS INSULATION ON THE INTERIOR OR EXTERIOR OF THE WALL. "5TB" MEANS R-5 THERMAL BREAK BETWEEN FLOOR SLAB AND BASEMENT WALL.

[D] R-10 CONTINUOUS INSULATION IS REQUIRED UNDER HEATED SLAB ON GRADE FLOORS. SEE R402.2.9.1.

[E] FOR SINGLE RAFTER- OR JOIST- VAULTED CEILINGS, THE INSULATION MAY BE REDUCED TO R-38 IF THE FULL INSULATION DEPTH EXTENDS OVER THE TOP PLATE OF THE EXTERIOR WALL.

[F] R-5 CONTINUOUS INSULATION INSTALLED OVER AN EXISTING SLAB IS DEEMED TO BE EQUIVALENT TO THE REQUIRED PERIMETER SLAB INSULATION WHEN APPLIED TO EXISTING SLABS COMPLYING WITH SECTION R503.1.1. IF FOAM PLASTIC IS USED, IT SHALL MEET THE REQUIREMENTS FOR THE THERMAL BARRIERS PROTECTING FOAM PLASTICS.

[G] FOR LOG STRUCTURES DEVELOPED IN COMPLIANCE WITH STANDARD ICC 400, LOG WALLS SHALL MEET THE REQUIREMENTS FOR CLIMATE ZONE 5 OF ICC 400.

[H] INT. (INTERMEDIATE FRAMING) DENOTES FRAMING AND INSULATION AS DESCRIBED IN SECTION A103.2.2 INCLUDING STANDARD FRAMING 16 INCHES ON CENTER, 78 PERCENT OF THE WALL CAVITY INSULATED AND HEADERS INSULATED WITH A MINIMUM OF R-10 INSULATION.

[I] THE FIRST VALUE IS CAVITY INSULATION, THE SECOND VALUE IS CONTINUOUS INSULATION. THEREFORE, AS AN EXAMPLE, "R13+10" MEANS R-13 CAVITY INSLATION PLUS R-10 CONTINUOUS INSULATION.

[J] A MAXIMUM U-FACTOR OF 0.82 SHALL APPLY TO VERTICAL FENESTRATION PRODUCTS INSTALLED IN BUILDINGS LOCATED ABOVE 4000 FEET IN ELEVATION ABOVE SEA LEVEL, OR IN WINDBORNE DEBRIS REGIONS WHERE PROTECTION OF OPENINGS IS REQUIRED UNDER SECTION R301.2.1.2 OF THE INTERNATIONAL RESIDENTIAL CODE.

1. A CERTIFICATE COMPLYING WITH 2021 WSEC R401.3 IS REQUIRED TO BE COMPLETED BY THE BUILDER OR APPROVED PARTY AND PERMANENTLY POSTED.
2. AT LEAST ONE THERMOSTAT SHALL BE PROVIDED FOR EACH SEPARATE HEATING AND COOLING SYSTEM.
3. ALL PERMANENTLY INSTALLED LIGHTING FIXTURES, EXCLUDING KITCHEN APPLIANCES, SHALL CONTAIN ONLY HIGH-EFFICACY LIGHTING SOURCES.

WHOLE HOUSE VENTILATION

WHOLE HOUSE VENTILATION SYSTEM TO BE DESIGNED PER WSBC AMENDMENTS TO 2021 IRC SECTION M1505.4.4.

SEE "WHOLE HOUSE VENTILATION" ON THE SCHEDULE SHEET FOR SELECTED OPTION.

WHOLE-HOUSE MECHANICAL VENTILATION AIRFLOW RATE PER EQUATION 15-1 (M1505.4.3)

VENTILATION QUALITY ADJUSTMENT PER EQUATION 15-2 (M1505.4.3.1)

IRC TABLE M1505.4.3(2)

INTERMITTENT WHOLE-HOUSE MECHANICAL VENTILATION RATE FACTORS [A,B]

RUN TIME PERCENTAGE IN EACH 4-HOUR SEGMENT	50%	66%	75%	100%
FACTOR	2	1.5	1.3	1.0

A. FOR VENTILATION SYSTEM RUN TIME VALUES BETWEEN THOSE GIVEN, THE FACTORS ARE PERMITTED TO BE DETERMINED BY INTERPOLATION.
B. EXTRAPOLATION BEYOND THE TABLE IS PROHIBITED.

MECHANICAL

GENERAL

SOLID FUEL BURNING APPLIANCES INCLUDE AIRTIGHT STOVES, FIREPLACE STOVES, ROOM HEATERS, FACTORY BUILT FIREPLACES AND FIREPLACE INSERTS. ALL SOLID FUEL BURNING APPLIANCES SHALL COMPLY WITH THE PROVISIONS OF I.R.C. R1006.6

HEATING

EACH DWELLING UNIT SHALL BE PROVIDED WITH HEATING FACILITIES CAPABLE OF MAINTAINING A TEMPERATURE OF 68 DEGREES FAHRENHEIT AT A HEIGHT OF 3'-0" ABOVE THE FLOOR AND TWO FEET FROM EXTERIOR WALLS IN ALL HABITABLE ROOMS WHEN THE OUTSIDE TEMPERATURE IS AS SET FORTH IN THE 2021 W.S.E.C.

DEFINITION OF BUILDING THERMAL ENVELOPE FROM THE 2021 WASHINGTON STATE ENERGY CODE:

THE BELOW-GRADE WALLS, ABOVE-GRADE WALLS, FLOORS, CEILINGS, ROOF, AND ANY OTHER BUILDING ELEMENT ASSEMBLIES THAT ENCLOSE CONDITIONED SPACE OR PROVIDES A BOUNDARY BETWEEN CONDITIONED SPACE AND EXEMPT OR UNCONDITIONED SPACE.

1. FUEL BURNING APPLIANCES LOCATED WITHIN THE BUILDING ENVELOPE SHALL OBTAIN AIR FROM OUTDOORS, MEETING THE PROVISIONS OF IRC G2407
2. FUEL BURNING APPLIANCES LOCATED OUTSIDE THE BUILDING ENVELOPE SHALL MEET THE PROVISIONS OF CHAPTER 24 OF THE 2021 IRC.
3. DUCTWORK LOCATION SHALL MEET THE PROVISIONS OF CHAPTER 24 OF THE 2021 IRC.
4. COMBUSTION AIR TO MEET THE REQUIREMENTS OF I.R.C. M1701.1

ALL WARM AIR FURNACES SHALL BE LISTED AND LABELED BY AN APPROVED AGENCY PER CHAPTER M1802 OF THE 2021 IRC.

NO WARM AIR FURNACE SHALL BE INSTALLED IN A ROOM USED OR DESIGNED TO BE USED AS A BEDROOM, BATHROOM, CLOSET OR IN ANY ENCLOSED SPACE WITH ACCESS ONLY THROUGH SUCH ROOM OR SPACE, EXCEPT PER EXCEPTIONS IN IRC G2406.2

LIQUEFIED PETROLEUM GAS BURNING APPLIANCES SHALL NOT BE INSTALLED IN A PIT, BASEMENT OR SIMILAR LOCATION WHERE HEAVIER THAN AIR GASES MIGHT COLLECT. APPLIANCES SO FUELED SHALL NOT BE INSTALLED IN AN ABOVE GRADE UNDER FLOOR SPACE OR BASEMENT UNLESS SUCH LOCATION IS PROVIDED WITH AN APPROVED MEANS FOR REMOVAL OF UNBURNED GAS.

HEATING AND COOLING APPLIANCES LOCATED IN A GARAGE AND WHICH GENERATE A GLOW, SPARK OR FLAME CAPABLE OF IGNITING FLAMMABLE VAPORS SHALL BE INSTALLED WITH THE PILOTS AND BURNERS OR HEATING ELEMENTS AND SWITCHES AT LEAST 18" ABOVE THE FLOOR SURFACE.

FIRE DAMPERS NEED NOT BE INSTALLED IN AIR DUCTS PASSING THROUGH THE WALL, FLOOR OR CEILING SEPARATING A RESIDENCE (R-3 OCCUPANCY) FROM A GARAGE, PROVIDED SUCH DUCTS WITHIN THE GARAGE ARE CONSTRUCTED OF STEEL HAVING A THICKNESS NOT LESS THAN 0.019" (NO. 26 GALVANIZED SHEET GAUGE) AND HAVE NO OPENINGS INTO THE GARAGE

EVERY APPLIANCE DESIGNED TO BE VENTED SHALL BE CONNECTED TO A VENTING SYSTEM COMPLYING WITH CHAPTER 18 OF THE 2021 IRC.

EVERY FACTORY BUILT CHIMNEY, TYPE L VENT, TYPE B GAS VENT OR TYPE BW GAS VENT SHALL BE INSTALLED IN ACCORDANCE WITH THE TERMS OF ITS LISTING, MANUFACTURERS INSTALLATION INSTRUCTIONS AND THE REQUIREMENTS PER CHAPTER 24 OF THE 2021 IRC.

A TYPE B OR BW GAS VENT SHALL TERMINATE PER CHAPTER 24 OF THE 2021 IRC.

VENT CONNECTORS SHALL BE INSTALLED WITHIN THE SPACE OR AREA IN WHICH THE APPLIANCE IS LOCATED AND SHALL BE CONNECTED TO A CHIMNEY OR VENT IN SUCH A MANNER AS TO MAINTAIN THE CLEARANCE TO COMBUSTIBLES PER SECTION M1803 OF THE 2021 IRC.

HEATING EQUIPMENT

ALL HEATING EQUIPMENT SHALL MEET THE REQUIREMENTS OF THE NATIONAL APPLIANCE ENERGY CONSERVATION ACT (NAECA) AND BE SO LABELED. EQUIPMENT SHALL ALSO COMPLY WITH SECTION M1411 OF THE 2021 IRC

DUCTWORK

1. DUCT SYSTEMS OR FACTORY BUILT AIR DUCTS SHALL BE OF METAL AS SET FORTH BY TABLE 1601.1.1 OF THE 2021 IRC.
2. RECTANGULAR, FLAT, OVAL AND ROUND DUCT JOINTS AND SEAMS SHALL BE AIRTIGHT PER SECTION M1601.4.1 OF THE 2021 IRC.
3. INSTALLATION OF DUCTS SHALL COMPLY WITH SECTION M1601.4 OF THE 2021 IRC.
4. DUCT INSULATION SHALL BE INSTALLED IN ACCORDANCE WITH SECTION M1601.3 OF THE 2021 IRC.
5. FINAL DUCT LEAKAGE AFFIDAVIT IS TO BE PROVIDED TO THE BUILDING INSPECTOR PRIOR TO FINAL INSPECTION. DUCT LEAKAGE AND SEALING REQUIREMENTS IN 2021 W.S.E.C. SECTION R403.3.4 THRU R403.3.6 TO BE MET.
6. DUCTS INSULATED TO A MINIMUM R-8 INSULATION IN UNCONDITIONED SPACES PER W.S.E.C. SECTION R403.3.1

CARPENTRY

GENERAL

ALL FRAMING SHALL COMPLY WITH THE APPLICABLE SECTION(S) OF THE 2021 IBC/IRC.
PRESSURE TREATED WOOD REQUIRED IN LOCATIONS LISTED IN IRC R317.1

2" MINIMUM VERTICAL CLEARANCE BETWEEN WOOD & CONCRETE STEPS, PORCH SLABS, PATIO SLABS & OTHER SIMILAR HORIZONTAL SURFACES EXPOSED TO THE WEATHER.
6" MINIMUM CLEARANCE BETWEEN WOOD AND EARTH.
8" MINIMUM CLEARANCE BETWEEN UNTREATED MUDSILLS AND EARTH.
12" MINIMUM CLEARANCE BETWEEN FLOOR BEAMS AND EARTH.
18" MINIMUM CLEARANCE BETWEEN FLOOR JOISTS AND EARTH.

LOADING

ROOF	15 PSF DEAD LOAD	+	25 PSF LIVE LOAD	=	40 PSF
ROOF W/ SOLAR PANELS	20 PSF DEAD LOAD	+	25 PSF LIVE LOAD	=	45 PSF
FLOOR TRUSSES	15 PSF DEAD LOAD	+	40 PSF LIVE LOAD	=	55 PSF
FLOOR	10 PSF DEAD LOAD	+	40 PSF LIVE LOAD	=	50 PSF
CEILING	5 PSF DEAD LOAD	+	10 PSF LIVE LOAD	=	15 PSF
DECK	10 PSF DEAD LOAD	+	60 PSF LIVE LOAD	=	70 PSF
INTERIOR PARTITION				=	7 PSF
EXTERIOR PARTITION				=	10 PSF

WOOD BEARING ON OR INSTALLED WITHIN ½" OF MASONRY OR CONCRETE TO BE TREATED WITH AN APPROVED PRESERVATIVE. SOLID BLOCKING OF NOT LESS THAN 2x THICKNESS SHALL BE PROVIDED AT ENDS AND AT ALL SUPPORT OF JOISTS AND RAFTERS. ANCHOR BOLTS TO BE PER SHEAR WALL SCHEDULE AND FOUNDATION PLAN. 7" MINIMUM EMBEDMENT. ALL METAL FRAMING ANCHORS AND HANGERS SHOWN ON DRAWINGS SHALL BE STRONG TIE CONNECTORS AS MANUFACTURED BY SIMPSON COMPANY.

PROVIDE FIREBLOCKING IN CONCEALED SPACES OF STUD WALLS & PARTITIONS, INCLUDING FURRED SPACES & PARALLEL ROWS OF STUDS OR STAGGERED STUDS AS FOLLOWS:

1. VERTICALLY AT THE CEILING & FLOOR LEVELS.
2. HORIZONTALLY AT INTERVALS NOT EXCEEDING 10 FEET.

PROVIDE FIREBLOCKING AT OTHER LOCATIONS PER 2021 IRC R302.11.

INSULATION & MOISTURE PROTECTION

GENERAL

UNLESS NOTED OTHERWISE, INSULATION SHALL CONFORM TO THE WASHINGTON STATE ENERGY CODES. INSULATION BAFFLES TO MAINTAIN 1" CLEAR SPACE ABOVE INSULATION. BAFFLES TO EXTEND 6" ABOVE BATT INSULATION & 12" ABOVE LOOSE FILL INSULATION. INSULATE BEHIND BATHTUBS, SHOWERS, PARTITIONS AND CORNERS. PROVIDE FACE STAPLED BATTS OR FRICTION FIT FACED BATTS. PROVIDE 4 MIL (0.004") POLYETHYLENE VAPOR BARRIER AT WALLS OR USE CLASS II PRIMER. PROVIDE R-10 INSULATION UNDER ELECTRIC WATER HEATERS.

INFILTRATION CONTROL

1. EXTERIOR JOINTS AROUND WINDOWS AND DOOR FRAMES, OPENINGS BETWEEN WALLS AND FOUNDATIONS, BETWEEN WALLS AND ROOF AND BETWEEN WALL PANELS, OPENINGS AT PENETRATIONS OF UTILITY SERVICES THROUGH WALLS, FLOORS, AND ROOF, AND ALL OTHERS SUCH OPENINGS IN THE BUILDING ENVELOPE, INCLUDING ACCESS PANELS INTO UNHEATED SPACES, SHALL BE SEALED, CAULKED, GASKETED OR WEATHER-STRIPPED TO LIMIT AIR INFILTRATION.
2. ALL EXTERIOR DOORS, OTHER THAN FIRE-RATED DOORS, SHALL BE DESIGNED TO LIMIT AIR INFILTRATION AROUND THEIR PERIMETER WHEN IN A CLOSED POSITION. DOORS BETWEEN RESIDENCE AND GARAGE ARE NOT CONSIDERED "FIRE-RATED" AND MUST MEET THE ABOVE REQUIREMENT.
3. ALL EXTERIOR WINDOWS SHALL BE DESIGNED TO ADMIT AIR INFILTRATION INTO OR FROM THE BUILDING ENVELOPE WHICH SHALL BE SUBSTANTIATED BY TESTING TO STANDARD ASTM E 283.73. SITE BUILT AND MILLWORK SHOP MADE WOODEN SASH ARE EXEMPT FROM TESTING BUT SHALL BE WEATHER-STRIPPED, CAULKED AND MORE TIGHTLY FITTING.
4. RECESSED LIGHT FIXTURES TO LIMIT AIR LEAKAGE PER W.S.E.C.

PIPING FOR HOT WATER / STEAM SYSTEMS OF PIPING FOR CONTINUOUSLY CIRCULATING HOT WATER SERVICE IS REQUIRED TO BE INSULATED PER THE W.S.E.C. HOT WATER PIPING SHALL BE INSULATED TO A MINIMUM OF R-3 PER W.S.E.C. R403.5.3. MECHANICAL SYSTEM PIPING SHALL BE INSULATED TO A MINIMUM R-6 PER W.S.E.C. R403.4

VAPOR BARRIERS / GROUND COVERS

AN APPROVED VAPOR BARRIER SHALL BE PROPERLY INSTALLED IN ROOF DECKS, IN ENCLOSED RAFTER SPACES FORMED WHERE CEILINGS ARE APPLIED DIRECTLY TO THE UNDERSIDE OF ROOF RAFTERS, AND AT EXTERIOR WALLS. INSET STAPLED BATTS WITH A PERM RATING LESS THAN ONE MAY BE INSTALLED IF THE VAPOR BARRIER IS TO THE WARM SIDE, STAPLES SHALL BE PLACED NOT MORE THAN 8" O.C. AND GAPS BETWEEN THE FACING AND THE FRAMING SHALL NOT EXCEED 1/16"

VAPOR RETARDERS AT WALLS PER IRC R702.7

A GROUND COVER OF 6 MIL (0.006") BLACK POLYETHYLENE OR EQUIVALENT SHALL BE LAID OVER THE GROUND IN ALL CRAWL SPACES. THE GROUND COVER SHALL BE OVERLAPPED ONE FOOT AT EACH JOINT AND SHALL EXTEND TO THE FOUNDATION WALL.

DOORS, WINDOWS AND SKYLIGHTS

GENERAL

THE REQUIRED EGRESS DOOR MAY HAVE A MAXIMUM 7 ¾" STEP ON THE EXTERIOR SIDE FROM TOP OF THE THRESHOLD TO A MINIMUM 36" DEEP LANDING ON THE EXTERIOR SIDE OF THE DOOR. PROVIDED THE DOOR DOES NOT SWING OVER THE LANDING, PER R311.3.1 OTHER EXTERIOR DOORS MAY HAVE A MAXIMUM (2) 7 ¾" STEPS TO A MIN. 36" DEEP LANDING. ALL GLAZING SHALL MEET THE REQUIREMENTS OF THE 2021 W.S.E.C. TABLE R402.1.3 UNLESS NOTED OTHERWISE. ALL SKYLIGHTS AND SKYWALLS SHALL HAVE LAMINATED GLASS UNLESS NOTED OTHERWISE. ALL BEDROOM EMERGENCY EGRESS WINDOWS SHALL HAVE A MINIMUM NET CLEAR OPENING OF 5.7 SQUARE FEET. MINIMUM NET CLEAR OPERABLE WIDTH OF 20" AND A MINIMUM NET CLEAR OPENING HEIGHT OF 24", MAXIMUM HEIGHT FROM FLOOR OF 44" MEASURED FROM THE FINISHED FLOOR TO THE BOTTOM OF THE CLEAR OPENING. OPERABLE WINDOWS WITH A SILL OF MORE THAN 72" ABOVE FINISHED THE GRADE OR SURFACE BELOW, TO BE A MINIMUM OF 24" ABOVE ADJACENT FINISHED FLOOR.

SAFETY GLAZING LOCATIONS PER 2021 IRC SECTION R308.4

R308.4.1 GLAZING IN ALL FIXED AND OPERABLE PANELS OF SWINGING, SLIDING AND BI-FOLD DOORS.

R308.4.2 GLAZING IN AN INDIVIDUAL FIXED OR OPERABLE PANEL ADJACENT TO A DOOR WHERE THE BOTTOM EDGE IS LESS THAN 60 INCHES ABOVE THE FLOOR & THE GLAZING IS EITHER WITHIN 24 INCHES OF EITHER SIDE OF THE DOOR IN THE PLANE OF THE DOOR IN A CLOSED POSITION OR ON A WALL LESS THAN 180 DEGREES FROM THE PLANE OF THE DOOR IN A CLOSED POSITION & WITHIN 24 INCHES OF THE HINGE SIDE OF AN IN-SWINGING DOOR.

R308.4.3 GLAZING IN AN INDIVIDUAL FIXED OR OPERABLE PANEL THAT MEETS ALL OF THE FOLLOWING CONDITIONS:
1. THE EXPOSED AREA OF AN INDIVIDUAL PANEL IS LARGER THAN 9 SQUARE FEET;
2. THE BOTTOM EDGE OF THE GLAZING IS LESS THAN 18" ABOVE THE FLOOR;
3. THE TOP EDGE OF THE GLAZING IS MORE THAN 36" ABOVE THE FLOOR; AND
4. ONE OR MORE WALKING SURFACES ARE WITHIN 36" MEASURED HORIZONTALLY AND IN A STRAIGHT LINE, OF THE GLAZING.

R308.4.4 GLAZING IN GUARDS AND RAILINGS, INCLUDING STRUCTURAL BALUSTER PANELS AND NONSTRUCTURAL IN-FILL PANELS, REGARDLESS OF AREA OR HEIGHT ABOVE A WALKING SURFACE.

R308.4.5 GLAZING IN WALLS, ENCLOSURES OR FENCES CONTAINING OR ADJACENT TO HOT TUBS, SPAS, WHIRLPOOLS, SAUNAS, STEAM ROOMS, BATHTUBS, SHOWERS AND INDOOR OR OUTDOOR SWIMMING POOLS WHERE THE BOTTOM EXPOSED EDGE OF THE GLAZING IS LESS THAN 60 INCHES MEASURED VERTICALLY ABOVE ANY STANDING OR WALKING SURFACE.

R308.4.6 GLAZING WHERE THE BOTTOM EXPOSED EDGE OF THE GLAZING IS LESS THAN 36 INCHES (914 MM) ABOVE THE PLANE OF THE ADJACENT WALKING SURFACE OF STAIRWAYS, LANDINGS BETWEEN FLIGHTS OF STAIRS AND RAMPS.

R08.4.7 GLAZING ADJACENT TO THE LANDING AT THE BOTTOM OF A STAIRWAY WHERE THE GLAZING IS LESS THAN 36 INCHES ABOVE THE LANDING AND WITHIN A 60" HORIZONTAL ARC LESS THAN 180 DEGREES FROM THE BOTTOM TREAD NOSING.

FOR EXCEPTIONS SEE IRC SECTION R308.4

GENERAL

PLANS COMPLY WITH THE 2021 INTERNATIONAL RESIDENTIAL CODE.

CONTRACTOR SHALL VERIFY ALL NOTES, DIMENSIONS AND CONDITIONS PRIOR TO CONSTRUCTION. CONTRACTOR SHALL PROVIDE TEMPORARY BRACING AS REQUIRED UNTIL ALL PERMANENT CONNECTIONS HAVE BEEN MADE. IT IS THE CONTRACTORS RESPONSIBILITY TO IDENTIFY ALL DISCREPANCIES TO THE ARCHITECT AT THE TIME THEY ARE NOTED. DIMENSIONS TAKE PRECEDENCE OVER SCALED DRAWINGS.

CODES:

ALL APPLICABLE CODES AND AUTHORITIES HAVING JURISDICTION SHALL BE FOLLOWED

1. 2021 INTERNATIONAL RESIDENTIAL CODE (IRC) WITH WASHINGTON STATE AMENDMENTS (WSA) EXCEPT CHAPTERS 11 AND 25 THROUGH 42 ARE NOT ADOPTED. APPENDICES F,Q, & U ARE ADOPTED.
2. 2021 INTERNATIONAL BUILDING CODE (IBC) WITH WASHINGTON STATE AMENDMENTS (WSA)
3. 2021 INTERNATIONAL MECHANICAL CODE (IMC) WITH WASHINGTON STATE AMENDMENTS (WSA)
4. 2021 UNIFORM PLUMBING CODE (UPC) WITH WASHINGTON STATE AMENDMENTS.
5. 2021 INTERNATIONAL FIRE CODE WITH WASHINGTON STATE AMENDMENTS.
6. 2021 WASHINGTON STATE ENERGY CODE, RESIDENTIAL PROVISIONS (WSEC).

LOCAL JURISDICTION REQUIRES DWELLING UNIT FIRE SPRINKLER SYSTEM PER IRC APPENDIX U

☒ YES
☐ NO

NFPA 13D FIRE SPRINKLER SYSTEM IN COMPLIANCE WITH NFPA 13D & COMI STANDARDS SHALL BE INSTALLED THROUGHOUT THE RESIDENCE. A SEPERATE FIRE PERMIT IS REQUIRED

SITE WORK

GENERAL

ALL FOOTINGS TO BEAR ON FIRM, UNDISTURBED EARTH BELOW ORGANIC SURFACE SOILS. ALL BACK FILL MATERIAL SHALL BE THOROUGHLY COMPACTED. FOUNDATION VENTS SHALL NOT INTERFERE WITH THE DIRECT LOAD PATH OF COLUMNS.

CLIMATIC AND GEOGRAPHIC DESIGN CRITERIA

WIND DESIGN					SEISMIC DESIGN CATEGORY	SUBJECT TO DAMAGE FROM			WINTER DESIGN TEMP	ICE BARRIER UNDER-LAYMENT REQUIRED	FLOOD HAZARDS	AIR FREEZING INDEX	SUMMER DESIGN TEMP
GROUND SNOW LOAD	SPEED (MPH)	TOPO-GRAPHIC EFFECTS	SPECIAL WIND REGION	WIND-BORNE DEBRIS ZONE		WEATHERING	FROST LINE DEPTH	TERMITE					
25	110	NO	NO	NO	D2	MODERATE	12"	SLIGHT TO MODERATE	24	NO	NA	113	53
EQUIVALENT FLUID PRESSURE = 35 P.C.F. (UNRESTRAINED WALLS) 50 P.C.F. (RESTRAINED WALLS)													

SHEET INDEX

SHEET #	DESCRIPTION
	ARCHITECTURAL
A0	SITE PLAN
A1	COVERSHEET
A2	SCHEDULE SHEET
A3	DETAIL SHEET
A4	FOUNDATION VENTING & CSA PLAN
A5	MAIN FLOOR PLAN
A6	UPPER FLOOR PLAN
A7	ROOF GEOMETRY & VENTING PLAN
A8	EXTERIOR ELEVATIONS
A9	EXTERIOR ELEVATIONS
A10	BUILDING SECTIONS
	STRUCTURAL
S1	SHEARWALL KEY PLANS & STRUCTURAL NOTES
S2	FOUNDATION / FLOOR FRAMING PLAN
S3	UPPER FLOOR FRAMING PLAN
S4	ROOF FRAMING PLAN
S5	STRUCTURAL DETAILS
S6	STRUCTURAL DETAILS

REGISTERED ARCHITECT
5046
JEFFREY P. HARVEY
STATE OF WASHINGTON
3/6/25

PAYMENT OF USE FEE IS DUE TO ARCHITECTS NORTHWEST, INC. PRIOR TO CONSTRUCTION FOR EACH STRUCTURE BUILT FROM THESE PLANS. THESE PLANS ARE PROTECTED BY COPYRIGHT LAWS WITH FEDERAL STATUTES. REPRODUCTION BY ANY METHOD OF THESE PLANS, IN WHOLE OR IN PART, OR VARIATIONS THEREOF WITHOUT WRITTEN PERMISSION FROM ARCHITECTS NORTHWEST, INC. IS STRICTLY PROHIBITED. THESE DRAWINGS AND PLANS SET ARE, AND SHALL REMAIN, THE PROPERTY OF ARCHITECTS NORTHWEST, INC.

ARCHITECTS NORTHWEST
18915-142ND AVENUE NE SUITE 100
WOODINVILLE, WA 98072
OFFICE: (425) 485-6900
FAX: (425) 487-6585
TOLL FREE: 1-888-272-4100
WWW.ARCHITECTSNW.COM

NW EASTSIDE BUILDERS LLC
4024 - 85TH AVE SE, MERCER ISLAND
PLAN M455IA3F-0

DESIGNED BY: DWB DATE: 1/25
DRAWN BY: DWB DATE: 3/6/25
PROJECT MANAGER: JdeR
REVISED BY: DATE:
1 WHB 7/24/25
2 DAK 8/12/25
LATERAL BY: ME DATE: 4/22/25
LATERAL JOB NUMBER: 2608

A1
A10

ANW WOODINVILLE OFFICE JOB NUMBER: 250013

Your Family Architect

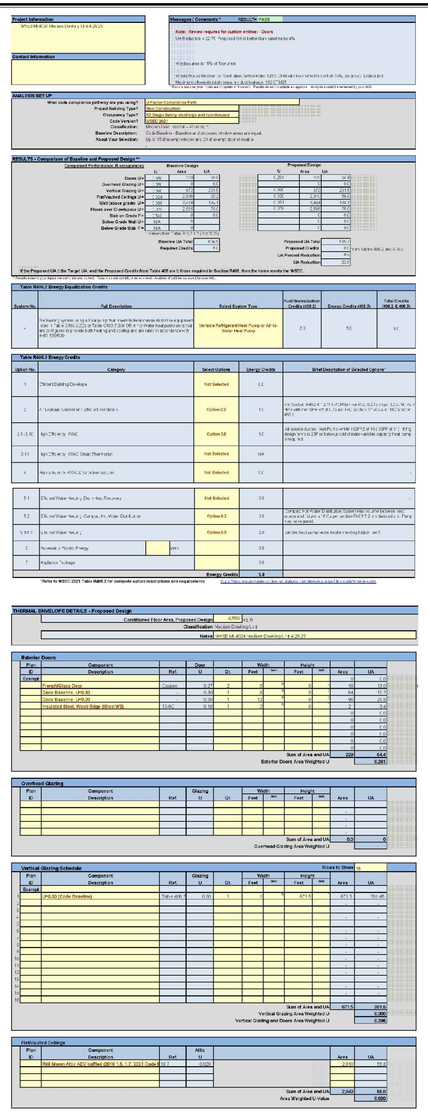

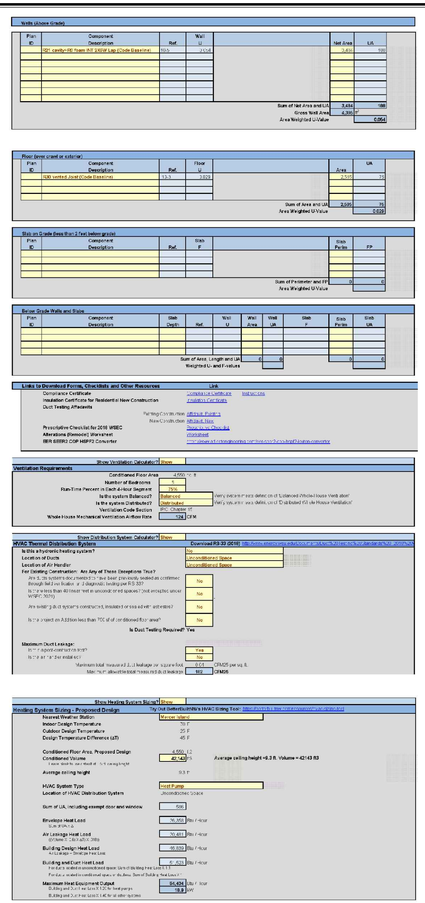

EXHAUST RATES

WSBC AMENDMENTS TO 2021 IRC SECTION M1505

SYMBOL	LOCATION	MINIMUM FAN REQUIREMENTS
A	Bath, Powder	Minimum 50 cfm Intermittent, 20 cfm Continuous (IRC TABLE M1505.4.4(1))
B	Kitchen	INTERMITTENT-OPEN OR ENCLOSED KITCHEN Hood over electric range 65% CE or 160 CFM. Hood over combustion range 80% CE or 250 CFM. CONTINUOUS-ENCLOSED KITCHENS 5 ACH based on kitchen volume.
C	Whole House Fan	Flow rate per WHOLE-HOUSE MECHANICAL VENTILATION schedule

All fans to vent to outside. All other requirements of the 2021 WSEC and the WSBC amendments to the 2021 IRC section M1505 must be met.

ALARM SCHEDULE

2021 IRC SECTIONS R314 & R315

SYMBOL	DESCRIPTION	REQUIREMENTS
SA	Smoke Alarm	*110 V interconnected w/ battery backup. *Installed on each floor, in each sleeping room, and outside each separate sleeping area. Installed not less than 3 ft from the door of a bath which contains a tub or shower unless this prevents placement in a required location. *Listed in accordance with UL 217 and to comply with NFPA 72.
SA/CM	Combination Smoke Alarm & Carbon Monoxide Alarm	*Installed on each floor, outside of each separate sleeping area in the immediate vicinity of the bedrooms, and in a bedroom that contains a gas fireplace in the bedroom or adjacent bathroom. *Smoke alarm requirements per above. *Combination smoke & carbon monoxide alarms listed in accordance with UL 217 & UL 2034.
HD	Heat Detector	*A heat detector or heat alarm to be installed in a central location in the garage and per the manufacturer's instructions. * Heat detector shall be interconnected to an alarm installed in the dwelling unit.

PRESCRIPTIVE ENERGY CODE COMPLIANCE

This project will use the requirements of the Prescriptive Path below and incorporate the minimum values listed. In addition, based on the size of the structure, the appropriate number of additional credits are checked.

ALL CLIMATE ZONES - TABLE R402.1.3

	Prescriptive	U-Factor Path	E.B.E. Option 1.2
Fenestration U-Factor[b]	0.30	0.30	0.25
Skylight U-Factor[b]	0.50	0.50	0.50
Ceiling R-Value[e]	60	0.024	60
Wood Frame Wall R-Value[g,i]	20+5 or 13+10	0.056	20+5 or 13+10
Floor R-Value	30	0.029	38
Below Grade Wall R-Value[c,h]	10/15/21 int + 5TB	0.035	10/15/21 int + 5TB
Slab[d] R-Value & Depth	10, 4 ft	0.540	10, entire slab

See Table R402.1.2 for U-Factor path footnotes.

See Table R402.1.3 footnotes included on Sheet A1.

Each dwelling unit in a residential building shall comply with sufficient options from Table R406.2 & R406.3 so as to achieve the following minimum number of credits:

☐ **1. Small Dwelling Unit: 5.0 credits**
Dwelling units less than 1500 square feet in conditioned floor area with less than 300 square feet of fenestration area. Additions to existing building that are greater than 500 square feet of heated floor area but less than 1500 square feet.

☑ **2. Medium Dwelling Unit: 8.0 credits**
All dwelling units that are not included in #1 or #3.

☐ **3. Large Dwelling Unit: 9.0 credits**
Dwelling units exceeding 5000 square feet of conditioned floor area.

☐ **4. Additions 150 square feet to 500 square feet: 2.0 credits**

ENERGY CREDIT SUMMARY TABLES

Heating Options	Fuel Normalization Descriptions	Credits	
1	Combustion heating, equipment per Table C403.3.2(5) or (6)	0.0	☐
2	Heat pump with supplemental heating	1.5	☐
3	Electric resistance heat only - forced air or zonal	0.5	☐
4	Heat pump without supplemental heating	3.0	☑
5	Electric resistance w/ mini-split heat pump or 2kw max capacity	2.0	☐
Energy Options	**Energy Credit Option Descriptions**	**Credits**	
1.1	Efficient Building Envelope	0.5	☐
1.2	Efficient Building Envelope	1.0	☐
1.3	Efficient Building Envelope	1.5	☐
1.4	Efficient Building Envelope	2.5	☐
2.1	Air Leakage Control and Efficient Ventilation	1.0	☐
2.2	Air Leakage Control and Efficient Ventilation	1.5	☑
2.3	Air Leakage Control and Efficient Ventilation	2.0	☐
3.1	High Efficiency HVAC	1.0	☐
3.2	High Efficiency HVAC	0.5	☐
3.3	High Efficiency HVAC	0.5	☐
3.4	High Efficiency HVAC	1.5	☐
3.5	High Efficiency HVAC	1.5	☐
3.6	High Efficiency HVAC	1.0	☑
3.7	High Efficiency HVAC	2.0	☐
3.8	High Efficiency HVAC	1.0	☐
3.9	High Efficiency HVAC	1.5	☐
3.10	High Efficiency HVAC	2.5	☐
3.11	High Efficiency HVAC	0.5	☐
4.1	High Efficiency HVAC Distribution System	0.5	☐
5.1	Efficient Water Heating	0.5	☐
5.2	Efficient Water Heating	0.5	☑
5.3	Efficient Water Heating	0.5	☐
5.4	Efficient Water Heating	1.0	☐
5.5	Efficient Water Heating	1.5	☐
5.6	Efficient Water Heating	2.0	☑
5.7	Efficient Water Heating	2.5	☐
5.8	Efficient Water Heating	2.5	☐
6.1	Renewable Electric Energy (0.5 credits per 600kwh, 4.5 max)	0.0	☐
7.1	Appliance Package	0.5	☐
Total Credits		**8.0**	

WINDOW, SKYLIGHT & DOOR SCHEDULE

CONDITIONED FLOOR AREA: 4550 — SUM OF ALL GLAZING AREAS FROM BELOW: 901 — SUM OF UA FOR HEATING SYSTEM SIZING: 233.6

EXEMPT DOOR AND WINDOW

ROOM		U-VAL	QTY	WIDTH	HEIGHT	AREA	UA
	EXEMPT SWING DR (24 S.F. MAX.)					0.00	0.00
	EXEMPT WINDOW (15 S.F. MAX.)					0.00	0.00
	SUM OF AREA AND UA FOR HEATING SYSTEM SIZE ONLY:					**0.0**	**0.0**

EXTERIOR DOORS (OPAQUE)

ROOM	TYPE	DESCRIPTION	U-VAL	QTY	WIDTH	HEIGHT	AREA	UA
FOYER	FR DOOR	SG	0.27	2	3.00	8.00	48.00	12.96
BR5/GUEST	SGD	SG	0.30	1	8.00	8.00	64.00	19.20
DINING	SGD	SG	0.30	1	12.00	8.00	96.00	
GARAGE	DOOR		0.16	1	2.66	8.00	21.28	
		SUM OF AREA AND UA:					**229.3**	**32.2**
		AREA WEIGHTED U = UA/AREA:						**0.14**

VERTICAL GLAZING

ROOM	TYPE	DESCRIPTION	U-VAL	QTY	WIDTH	HEIGHT	AREA	UA
PDR	S HUNG	SG	0.30	1	2.00	3.00	6.00	1.80
DEN	SLIDER		0.30	2	4.00	6.00	48.00	14.40
DEN	SLIDER		0.30	2	3.00	5.00	30.00	9.00
BA4	S HUNG	SG	0.30	1	2.00	3.00	6.00	1.80
GREAT	SLIDER		0.30	2	6.00	6.00	72.00	21.60
KITCHEN	SLIDER	SG	0.30	1	5.00	4.50	22.50	6.75
PREP	SLIDER	SG	0.30	1	3.00	4.50	13.50	4.05
MUD	S HUNG		0.30	1	2.00	3.00	6.00	1.80
							0.00	0.00
STAIR	PICTURE	SG	0.30	2	4.00	5.00	40.00	12.00
MBA	S HUNG	SG	0.30	2	3.00	5.00	30.00	9.00
MBR	S HUNG	EGRESS	0.30	2	2.50	5.00	25.00	7.50
MBR	PICTURE		0.30	1	5.00	5.00	25.00	7.50
MBR	PICTURE	TRANSOM	0.30	1	5.00	2.00	10.00	3.00
MBR	S HUNG	SG	0.30	2	2.00	4.50	18.00	5.40
WIC	PICTURE	TRANSOM	0.30	1	8.00	1.00	8.00	2.40
LDY	SLIDER	SG	0.30	1	3.00	4.50	13.50	4.05
OPEN	PICTURE		0.30	4	3.00	5.00	60.00	18.00
OPEN	PICTURE		0.30	2	5.50	5.00	55.00	16.50
BR3	S HUNG	EGRESS	0.30	2	3.00	5.00	30.00	9.00
BR2	S HUNG	EGRESS	0.30	2	3.00	5.00	30.00	9.00
BA2	S HUNG	SG	0.30	1	2.00	3.00	6.00	1.80
BONUS	S HUNG		0.30	2	2.00	5.00	20.00	6.00
BONUS	S HUNG		0.30	2	3.00	5.00	25.00	7.50
BONUS	PICTURE		0.30	1	6.00	5.00	30.00	9.00
BONUS	PICTURE	TRANSOM	0.30	1	6.00	2.00	12.00	3.60
BR4	S HUNG	EGRESS	0.30	2	3.00	5.00	30.00	9.00
		SUM OF AREA AND UA:					**671.50**	**201.45**
		AREA WEIGHTED U = UA/AREA:						**0.30**

OVERHEAD GLAZING

ROOM	TYPE	U-VAL	QTY	WIDTH	HEIGHT	AREA	UA
	SKYLIGHT	0.50				0.00	0.00
	SKYLIGHT	0.50				0.00	0.00
	SKYLIGHT	0.50				0.00	0.00
	SKYLIGHT	0.50				0.00	0.00
	SUM OF AREA AND UA:					**0.00**	**0.00**
	AREA WEIGHTED U = UA/AREA:						**0.00**

VERTICAL GLAZING IN UNHEATED SPACES

ROOM	TYPE	U-VAL	QTY	WIDTH	HEIGHT	AREA
GARAGE	S HUNG	0.30	3	2.00	3.00	18.00
						0.00
						0.00
	SUM OF VERTICAL GLAZING IN UNHEATED SPACES:					**18.00**
	(not included in sum of all glazing above)					

WHOLE-HOUSE MECHANICAL VENTILATION (PRESCRIPTIVE)

WHOLE-HOUSE MECHANICAL VENTILATION SYSTEMS SHALL BE DESIGNED IN ACCORDANCE WITH SECTIONS M 1505.4.1 THROUGH M1505.4.4 (WASHINGTON STATE AMENDMENTS)

- ☐ WHOLE-HOUSE VENTILATION USING EXHAUST FANS (M1505.4.1.2)
- ☐ WHOLE-HOUSE VENTILATION USING SUPPLY FANS (M1505.4.1.3)
- ☐ WHOLE-HOUSE VENTILATION SYSTEM, BALANCED (M1505.4.1.4)
- ☑ WHOLE-HOUSE VENTILATION USING AIR HANDLER INTEGRATED SUPPLY (M1505.4.1.5)

MECHANICAL VENTILATION AIRFLOW RATE PER EQUATION 15-1 (M1505.4.3): 98 CFM (CONTINUOUS)

VENTILATION QUALITY ADJUSTMENT PER EQUATION 15-2 (M1505.4.3.1)

- ☑ BALANCED & DISTRIBUTED (1.0 COEFFICIENT)
- ☐ BALANCED & NOT DISTRIBUTED (1.25 COEFFICIENT)
- ☐ NOT BALANCED & DISTRIBUTED (1.25 COEFFICIENT
- ☐ NOT BALANCED & NOT DISTRIBUTED (1.5 COEFFICIENT)

ADJUSTED MECHANICAL VENTILATION AIRFLOW RATE: 98 CFM (CONTINUOUS)

INTERMITTENT OFF OPERATION (M1505.4.3.2)

RUN-TIME % IN EACH 4-HOUR SEGMENT

- ☐ 50 PERCENT
- ☐ 66 PERCEINT
- ☑ 75 PERCENT
- ☐ 100 PERCENT

INTERMITTENT FLOW RATE: 127.4 CFM

AIR LEAKAGE

Components of the building thermal envelope as listed in TABLE R402.4.1.1 shall be installed per manufacturer's specifications to limit air leakage rate to not exceed 1.5 air changes per hour (ACH)

AIR LEAKAGE CALCULATION (maximum blower test CFM)		CFM 50 cals	ACTUAL Blower test result
maximum ACH	$CFM_{50\,cals}$ = BLDG VOL (ft^3) X1.5 ACH / 60 min =	1054 cfm	cfm

ROOF VENTILATION

Standard Truss / Scissor Truss Roof Framing Assembly:

Roof Area :	**2840** s.f.	
Ventilation Required:	2840 s.f. x 144 / 300 =	1363.2 s.i. Req'd
Provide between 40% & 50% of the total required ventilation no more than 3 ft below the ridge or the highest point of the space. Remainder to be installed at eave vents.		
Upper Roof Ventilation:		
AF50 Roof Jack (10" x 7") =		50.00 s.i. each.
Upper Ventilation MINIMUM =	1363.2 s.i. x 0.4 / s.i. of each vent =	11 vents
Upper Ventilation MAXIMUM =	1363.2 s.i. x 0.5 / s.i. of each vent =	13 vents
Provide:	**11** -10"x7" roof jacks. Ventilation =	550.00 s.i.
Ventilation area remainder for eave vents =	813.20 s.i.	(Req'd vent.-Upper vent.)
Eave Ventilation:		
Birdblocking: (3)2.25" dia holes per bay =	5.96 s.i. per l.f. - 25% reduction =	4.47 s.i. per l.f.
Eave Ventilation Required =	813.20 s.i. / 4.47 s.i. per l.f. =	181.92 l.f.
Provide Minimum :	182 l.f. birdblocking. Ventilation =	813.54 s.i.
Minimum Ventilation Provided =	**1363.54 s.i. IS GREATER THAN :**	**1363.2 s.i. Req'd**

AREA SUMMARY

Conditioned Area:	4550	s.f.
Number of Bedrooms:	6	

SIMPLE HEATING SYSTEM SIZE

This heating system sizing is based on the Prescriptive Requirements of the 2021 Washington State Energy Code. This is for heating only. ACCA procedures for sizing cooling systems should be used to determing cooling.

Indoor Design Temperature			70		
Outdoor Design Temperature			24		
Design Temperature Difference					
Indoor - Outdoor Design Temp			46		
Conditioned Floor Area			4550		
Conditioned Volume			42143		
Glazing					
Sum of UA from Glazing Schedule					233.6
Attic	**U-Factor**	**X**	**Area**	**=**	**UA**
R-60 STD	0.025				
Other: R-49 ADV	0.020		2840		56.80
Single Rafter or Joist Vaulted Ceilings	**U-Factor**	**X**	**Area**	**=**	**UA**
R-38	0.026				
Other:					
Above Grade Walls	**U-Factor**	**X**	**Area**	**=**	**UA**
R-21 INT + R-10 hdrs	0.056		3484		195.10
Other:	0.043				
Floors	**U-Factor**	**X**	**Area**	**=**	**UA**
R-30	0.029		2585		74.97
Other:	0.025				
Below Grade Walls	**U-Factor**	**X**	**Area**	**=**	**UA**
R-21 Interior	0.035				
R-10 Continuous exterior	0.064				
Other:					
Slab Below Grade	**F-factor**	**X**	**Length**	**=**	**UA**
R-10 Thermal break	0.5				
Other:					
Slab on Grade	**F-factor**	**X**	**Length**	**=**	**UA**
R-10 2' perimeter	0.54				
R-10 Fully insulated	0.36				
Other:					
Sum of UA					560.48
Envelope Heat Load					25782 Btu / Hour
Sum of UA X Design Temperature Difference					
Air Leakage Heat Load					20937 Btu / Hour
((Volume X .0.6) X Design Outdoor Temp) X .018))					
Building Design Heat Load					46719 Btu / Hour
Air Leakage + Envelope Heat Loss					
Building and Duct Heat Load			1.1		51391 Btu / Hour
Use 1.1 if ducts are located in unconditioned space: Sum of Building Heat Loss X 1.1					
Use 1 if ducts are located in conditioned space: Sum of Building Heat Loss X 1					
Maximum Heat Equipment Output			1.25		64238 Btu / Hour
Use 1.4 for forced air furnace: Building & Duct Heat Loss x 1.4					
Use 1.25 for heat pump: Building & Duct Heat Loss x 1.25					

FOUNDATION VENTILATION

Crawlspace Area:	1981 s.f.		
Ventilation Required:	1981 s.f. / 300 =	950.88 s.i. Req'd	
Use:	14" x 7" Foundation Vents		
Vent Area =	98 s.i. - 25% reduct.,1/4"mesh =	73.5 s.i.	
Vents Required =	950.88 s.i. / Vent Area =	12.94 s.i.	
Provide : 13	14" x 7" Vents, Area =	955.5 s.i.	
Ventilation Provided =	955.50 s.i. is Greater than	950.88 s.i. Req'd	

Use: 13 14" x 7" Foundation Vents

* FOUNDATION VENTS SHALL NOT INTERFERE WITH DIRECT LOAD PATH OF COLUMNS
* INSTALL 6 MIL BLACK POLYETHYLENE VAPOR RETARDER GROUND COVER
* REQUIRED OPENINGS SHALL BE EVENLY PLACED TO PROVIDE CROSS VENTILATION, EXCEPT ONE SIDE OF THE BUILDING SHALL BE PERMITTED TO HAVE NO VENTS.

VAPOR RETARDER

FLOOR	☐ 4 MIL POLY	☐	FACE STAPLED BACKED BATTS	X	PLYWOOD W/ EXT. GLUE	
WALL	☐ 4 MIL POLY	☐	FACE STAPLED BACKED BATTS	X	CLASS 2 PRIMER	
RIM JOIST	☐ 4 MIL POLY	X	FOIL-FACE STAPLED BACKED BATTS	☐	CLASS 2 PRIMER	
CEILING	☐ 4 MIL POLY	☐	FACE STAPLED BACKED BATTS	X	CLASS 2 PRIMER	

BASE LATEX PRIMER (CLASS II)

Plans to use Benjamin Moor Super latex vapor barrier primer sealer 260, class II, rated at .5 perms. This product is convenient, inexpensive and meets the code requirement for a class II vapor retarder.

ALTERNATE LATEX PRIMERS (to be chosesn by builder if necessary)

DIRECT PAINT SALES WASHINGTON PRO-GYP PERM PRIME	☐
SHERWIN WILLIAMS INTERIOR LATEX PRIMER/FINISH MOISTURE VAPOR BARRIER	☐
RODDA PAINT VAPOR SHIELD	☐
BENJAMIN MOORE SUPER SPEC LATEX VAPOR BARRIER PRIMER SEALER 260	X
PSI PRIME-PERM VAPOR BARRIER	☐

INTERMEDIATE WALL FRAMING

(WSEC A103.2.2)

STUDS SHALL BE FRAMED 16 INCHES ON CENTER WITH DOUBLE TOP PLATE AND SINGLE BOTTOM PLATE.

CORNERS USE TWO STUDS OR OTHER MEANS OF FULLY-INSULATED CORNERS. EACH OPENING IS FRAMED USING TWO STUDS.

HEADERS CONSIST OF DOUBLE 2x MATERIALS WITH R-10 INSULATION.

INTERIOR PARTITION WALL / EXTERIOR WALL INTERSECTIONS ARE FULLY INSULATED IN THE EXTERIOR WALL.

ADVANCED ROOF FRAMING

MFR TRUSSES @24"oc. W/ R-49 INSUL TO F.O. EXT WALL

1 W.S.E.C. SCHEDULES
SCALE: NOT TO SCALE

Your Property Project
ARCHITECTS NORTHWEST

ARCHITECTS NORTHWEST
18915-142ND AVENUE NE SUITE 100
WOODINVILLE, WA 98072
OFFICE: (425) 487-6585
FAX: (425) 487-6586
TOLL FREE: 1-888-272-4109
WWW.ARCHITECTSNW.COM

REGISTERED ARCHITECT
5046
JEFFREY P. ARNOLDT
STATE OF WASHINGTON
5/6/25

PAYMENT OF USE FEE IS DUE TO ARCHITECTS NORTHWEST, INC. PRIOR TO CONSTRUCTION FOR EACH STRUCTURE BUILT FROM THESE PLANS. THESE PLANS ARE COPYRIGHTED AND SUBJECT TO WITH FEDERAL STATUTES. REPRODUCTION BY ANY METHOD OR USE OF THESE PLANS WITHOUT THE WRITTEN PERMISSION VIOLATIONS THEREOF WITHOUT WRITTEN PERMISSION OF ARCHITECTS NORTHWEST, INC. ARE PROHIBITED. THESE DRAWINGS AND PLANS SET ARE, AND SHALL REMAIN, THE PROPERTY OF ARCHITECTS NORTHWEST, INC.

NW EASTSIDE BUILDERS LLC
4024 - 85TH AVE SE, MERCER ISLAND
PLAN M455IA3F-O

DESIGNED BY: DWB — DATE: 1/25
DRAWN BY: DWB — DATE: 3/6/25
PROJECT MANAGER: JdeR
REVISED BY: WHB 7/24/25; DAK 8/12/25 — DATE:
LATERAL BY: ME — DATE: 4/22/25
LATERAL JOB NUMBER: 2608

A2
A10

ANW WOODINVILLE OFFICE JOB NUMBER: 250013

Your Family Architect

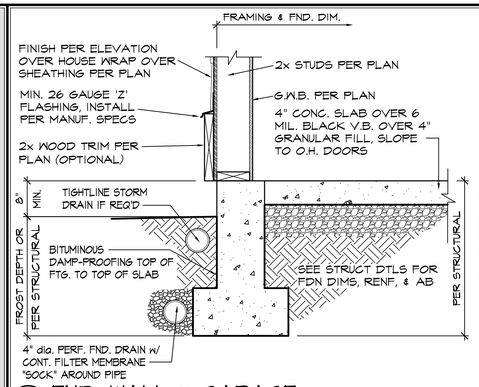

1 FND. WALL @ GARAGE
SCALE: 1" = 1'-0"

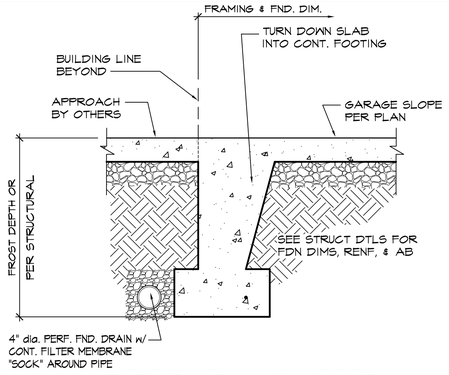

2 THICKENED SLAB @ O.H. DOOR
SCALE: 1" = 1'-0"

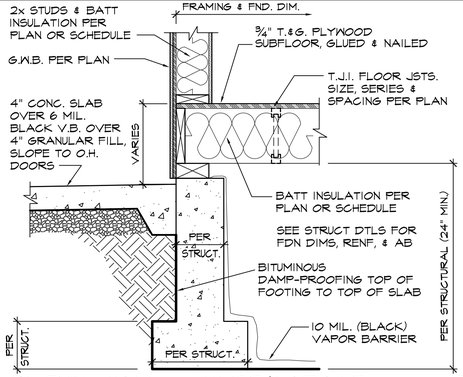

3 FND. WALL @ HOUSE/GARAGE
SCALE: 1" = 1'-0" T.J.I.

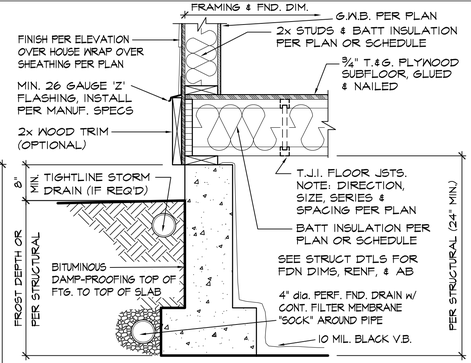

4 TYPICAL FND. WALL
SCALE: 1" = 1'-0" T.J.I.

NOTE: FOUNDATION/ROOF DETAILS SHOWN ON THIS SHEET ARE FOR ARCHITECTURAL PURPOSES ONLY. SEE STRUCTURAL SHEETS FOR:
-STEM WALL WIDTH
-FOOTINGS
-REBAR & REINFORCEMENT
-MUD-SILL & ANCHOR BOLTS
-SHEAR WALLS & SHEATHING
-NAILING & CONNECTIONS

5 E.O.R. NOTE
SCALE: 1" = 1'-0"

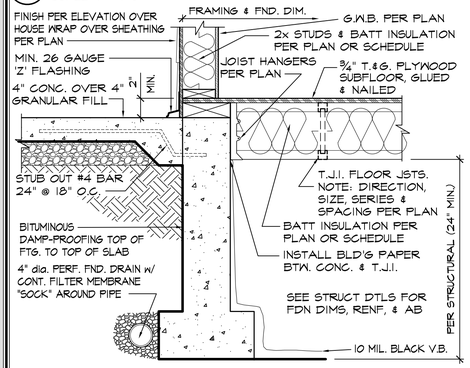

6 RAISED FND. WALL @ SLAB
SCALE: 1" = 1'-0" T.J.I.

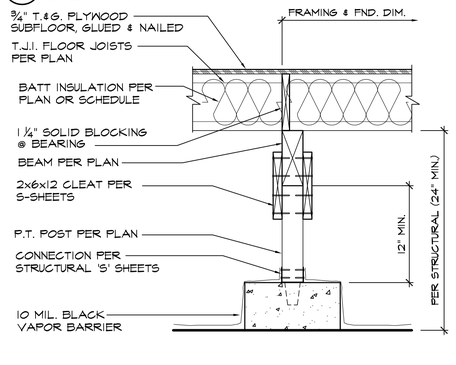

7 CONTINUOUS FOOTING
SCALE: 1" = 1'-0"

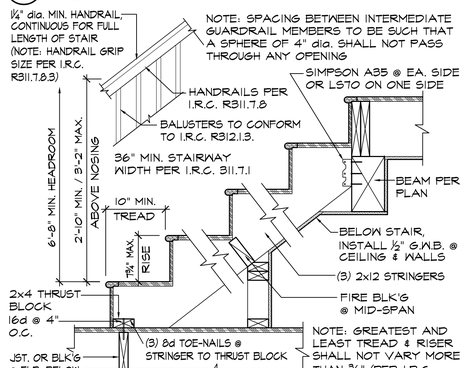

8 INTERIOR STAIR
SCALE: 1" = 1'-0" @ FLOOR/CRAWL SPACE BELOW

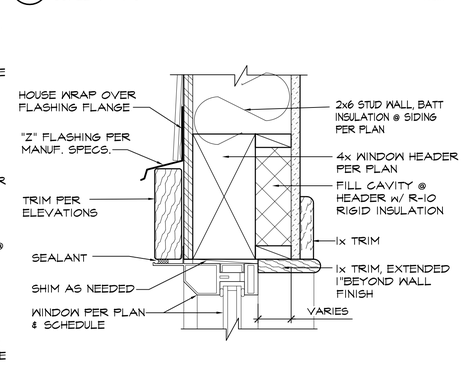

9 TYP. WINDOW HEADER & SILL
SCALE: NOT TO SCALE

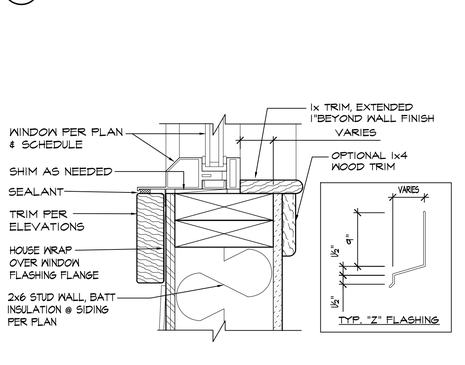

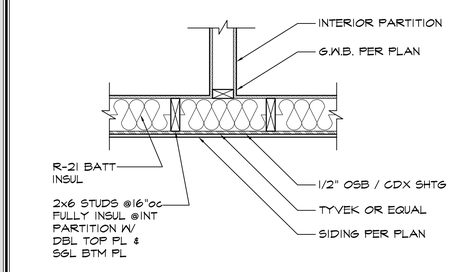

10 INTERMEDIATE WALL FRAMING
SCALE: 1" = 1'-0"

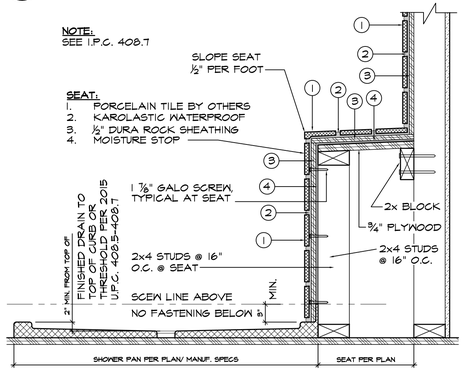

11 SHOWER SEAT
SCALE: 1" = 1'-0"

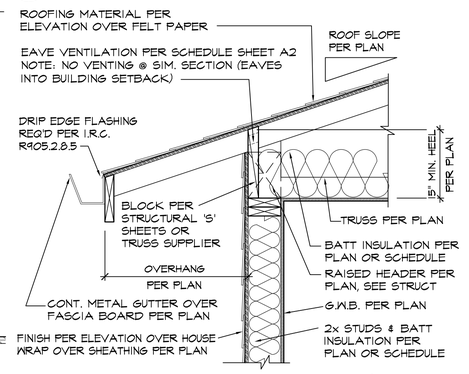

12 TRUSS HEEL @ FLAT CEILING/EAVE
SCALE: 1" = 1'-0"

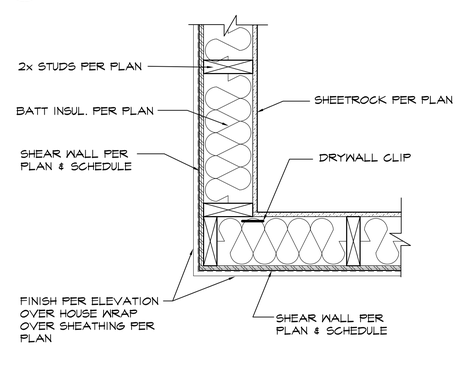

13 INSULATED CORNER FRAMING
SCALE: 1" = 1'-0"

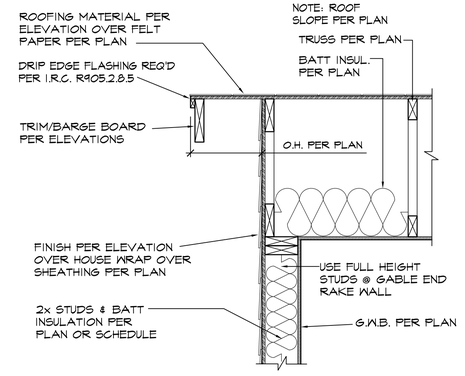

14 GABLE END DETAIL
SCALE: 1" = 1'-0"

15 NOT USED
SCALE: 1" = 1'-0"

16 NOT USED
SCALE: 1" = 1'-0"

17 NOT USED
SCALE: 1" = 1'-0"

18 NOT USED
SCALE: 1" = 1'-0"

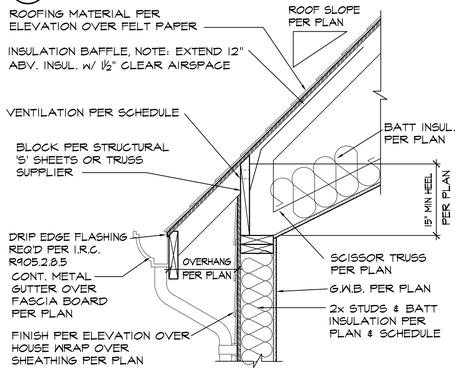

19 SLOPED CEILING @ EAVE
SCALE: 1" = 1'-0" w/ HEEL

REGISTERED ARCHITECT
5046
JEFFREY P. HERVOLET
STATE OF WASHINGTON
3/6/25

PAYMENT OF USE FEE IS DUE TO ARCHITECTS NORTHWEST, INC. PRIOR TO CONSTRUCTION FOR THESE PLANS AND SPECIFICATIONS IN ACCORDANCE WITH FEDERAL STATUTES. REPRODUCTION BY ANY METHOD OF ANY PORTION OF THESE PLANS AND VARIATIONS THEREOF WITHOUT WRITTEN PERMISSION IS A VIOLATION OF COPYRIGHT LAW AND IS STRICTLY PROHIBITED. THESE DRAWINGS AND PLANS SET FORTH HEREIN, THROUGHOUT THE PROGRESS SETS AREA, AND SHALL REMAIN, THE PROPERTY OF ARCHITECTS NORTHWEST, INC.

ARCHITECTS NORTHWEST
WOODINVILLE, WA 98072
FAX: (425) 487-6585
WWW.ARCHITECTSNW.COM
18915-142ND AVENUE NE SUITE 100
OFFICE: (425) 485-4900
TOLL FREE: 1-888-272-4100

NW EASTSIDE BUILDERS LLC

4024 - 85TH AVE SE, MERCER ISLAND

PLAN M4551A3F-0

DESIGNED BY:	DATE:
DWB	1/25
DRAWN BY:	DATE:
DWB	3/6/25
PROJECT MANAGER:	
JGR	
REVISED BY:	DATE:
1 WHB	7/24/25
2 DAK	8/12/25
LATERAL BY:	DATE:
ME	4/22/25
LATERAL JOB NUMBER:	
2608	

A3
A10

ANW WOODINVILLE OFFICE JOB NUMBER:
250013

ARCHITECTS NORTHWEST

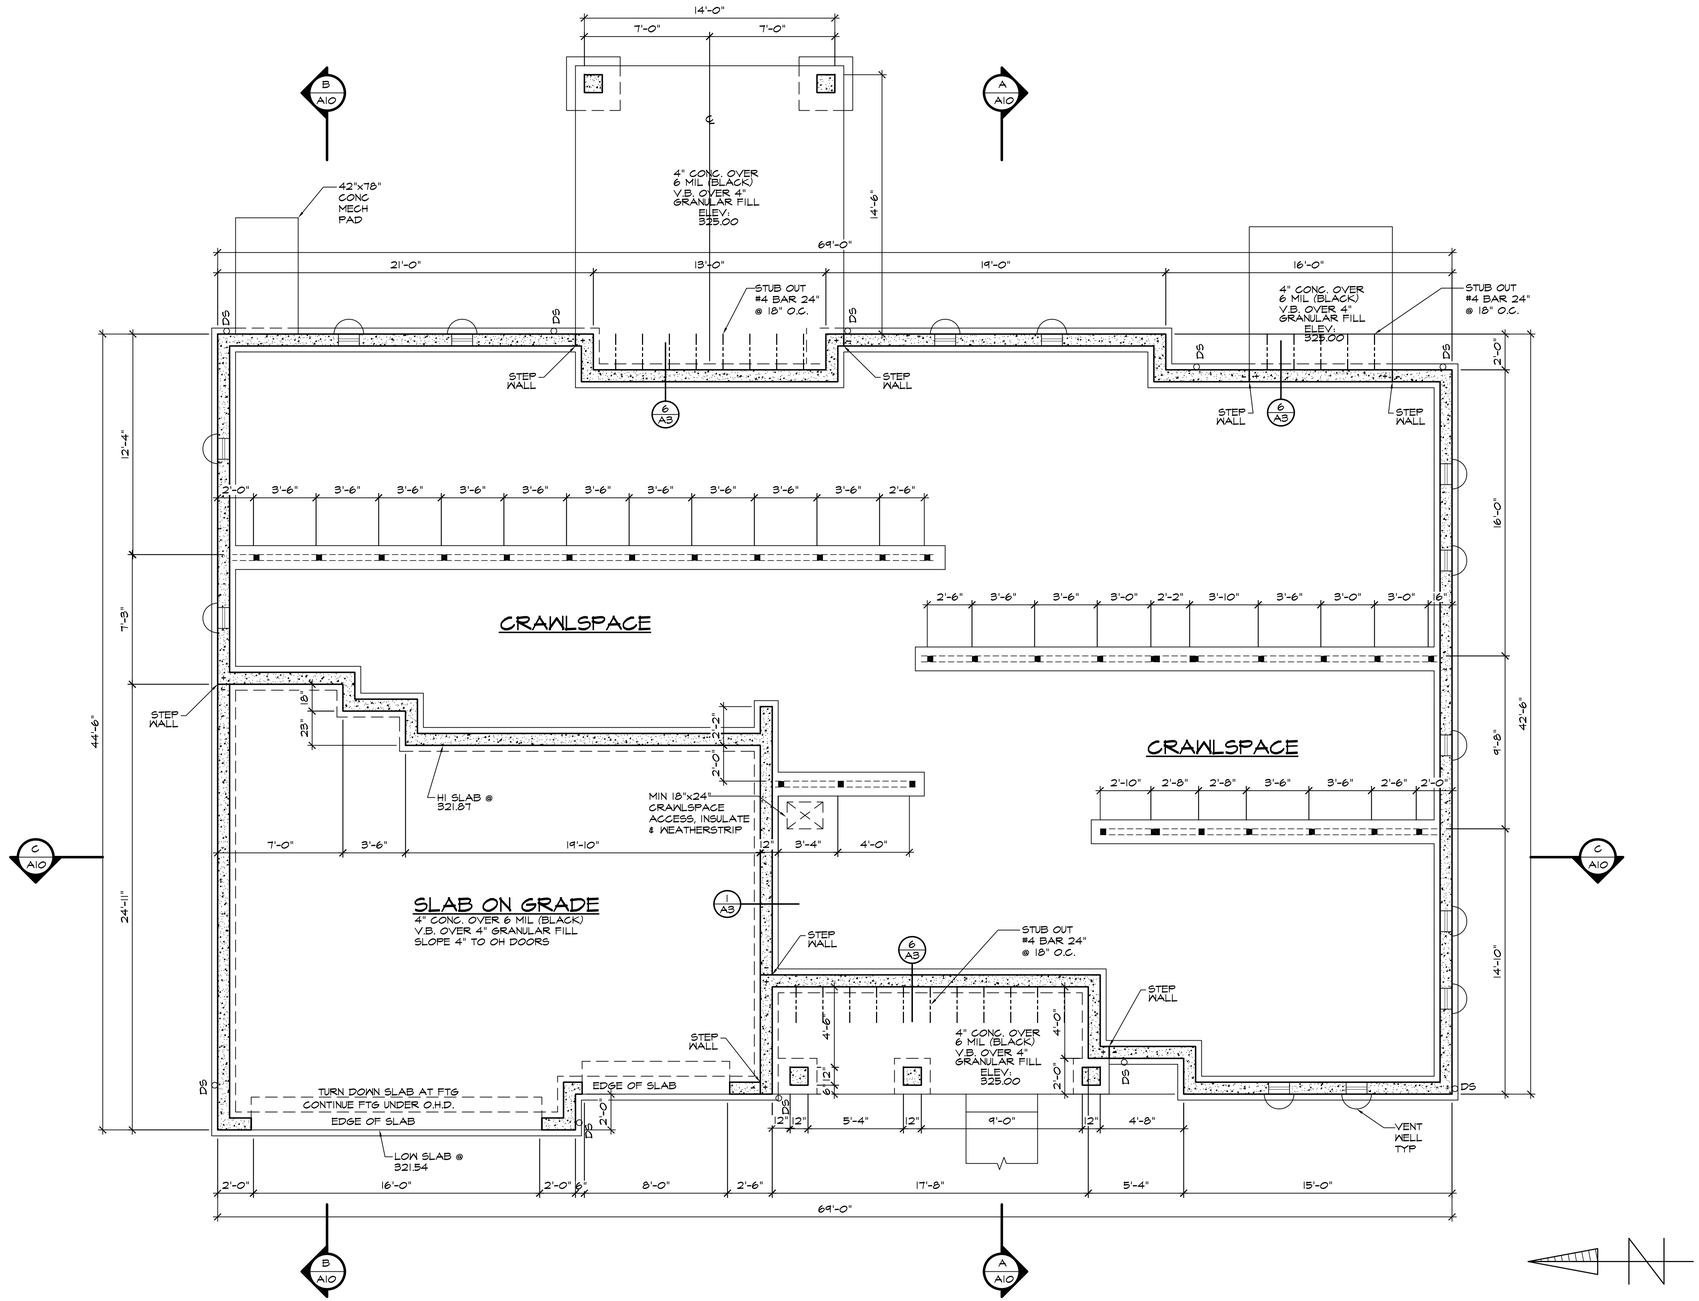

FOUNDATION VENTING & CSA PLAN

SCALE: 1/4" = 1'-0"

Your Family Architect

ARCHITECTS NORTHWEST

REGISTERED ARCHITECT
5046
JEFFREY P. ARNOLD
STATE OF WASHINGTON
3/6/25

PAYMENT OF USE FEE IS DUE TO ARCHITECTS NORTHWEST, INC. PRIOR TO CONSTRUCTION FOR EACH STRUCTURE BUILT FROM THESE PLANS. WITH FEDERAL STATUTES, REPRODUCTION BY ANY METHOD OF THESE PLANS AND SPECIFICATIONS OR VARIATIONS THEREOF WITHOUT WRITTEN PERMISSION FROM ARCHITECTS NORTHWEST, INC. IS STRICTLY PROHIBITED. THESE DRAWINGS AND PLANS SET FORTH ARE INSTRUMENTS OF SERVICE AND SHALL REMAIN THE PROPERTY OF ARCHITECTS NORTHWEST, INC.

ARCHITECTS NORTHWEST
18915-142ND AVENUE NE SUITE 100
OFFICE: (425) 485-4900
FAX: (425) 487-6585
TOLL FREE: 1-888-272-4100
WOODINVILLE, WA 98072
WWW.ARCHITECTSNW.COM

NW EASTSIDE BUILDERS LLC

4024 - 85TH AVE SE, MERCER ISLAND

PLAN M455|A3F-O

DESIGNED BY: DWB	DATE: 1/25
DRAWN BY: DWB	DATE: 3/6/25
PROJECT MANAGER: JdeR	
REVISED BY:	DATE:
1 WHB	7/24/25
2 DAK	8/12/25
LATERAL BY: ME	DATE: 4/22/25
LATERAL JOB NUMBER: 2608	

A4
A10

ANW WOODINVILLE OFFICE JOB NUMBER: 250013

GFA UPPER FLR DIAGRAM

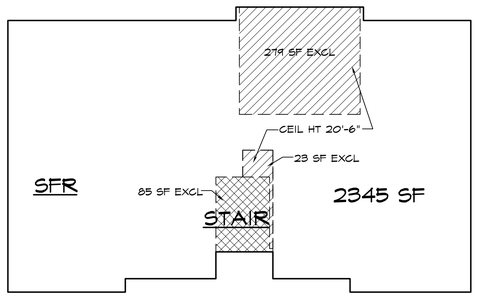

GFA = 2732- 279 - 85- 23 = 2345 SF

GFA MAIN FLR DIAGRAM

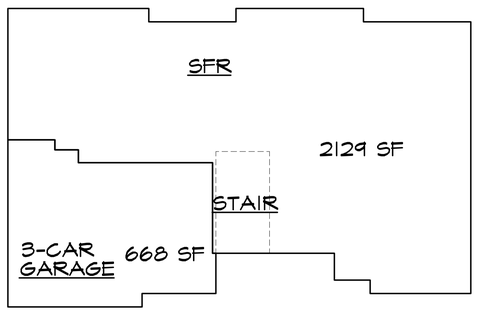

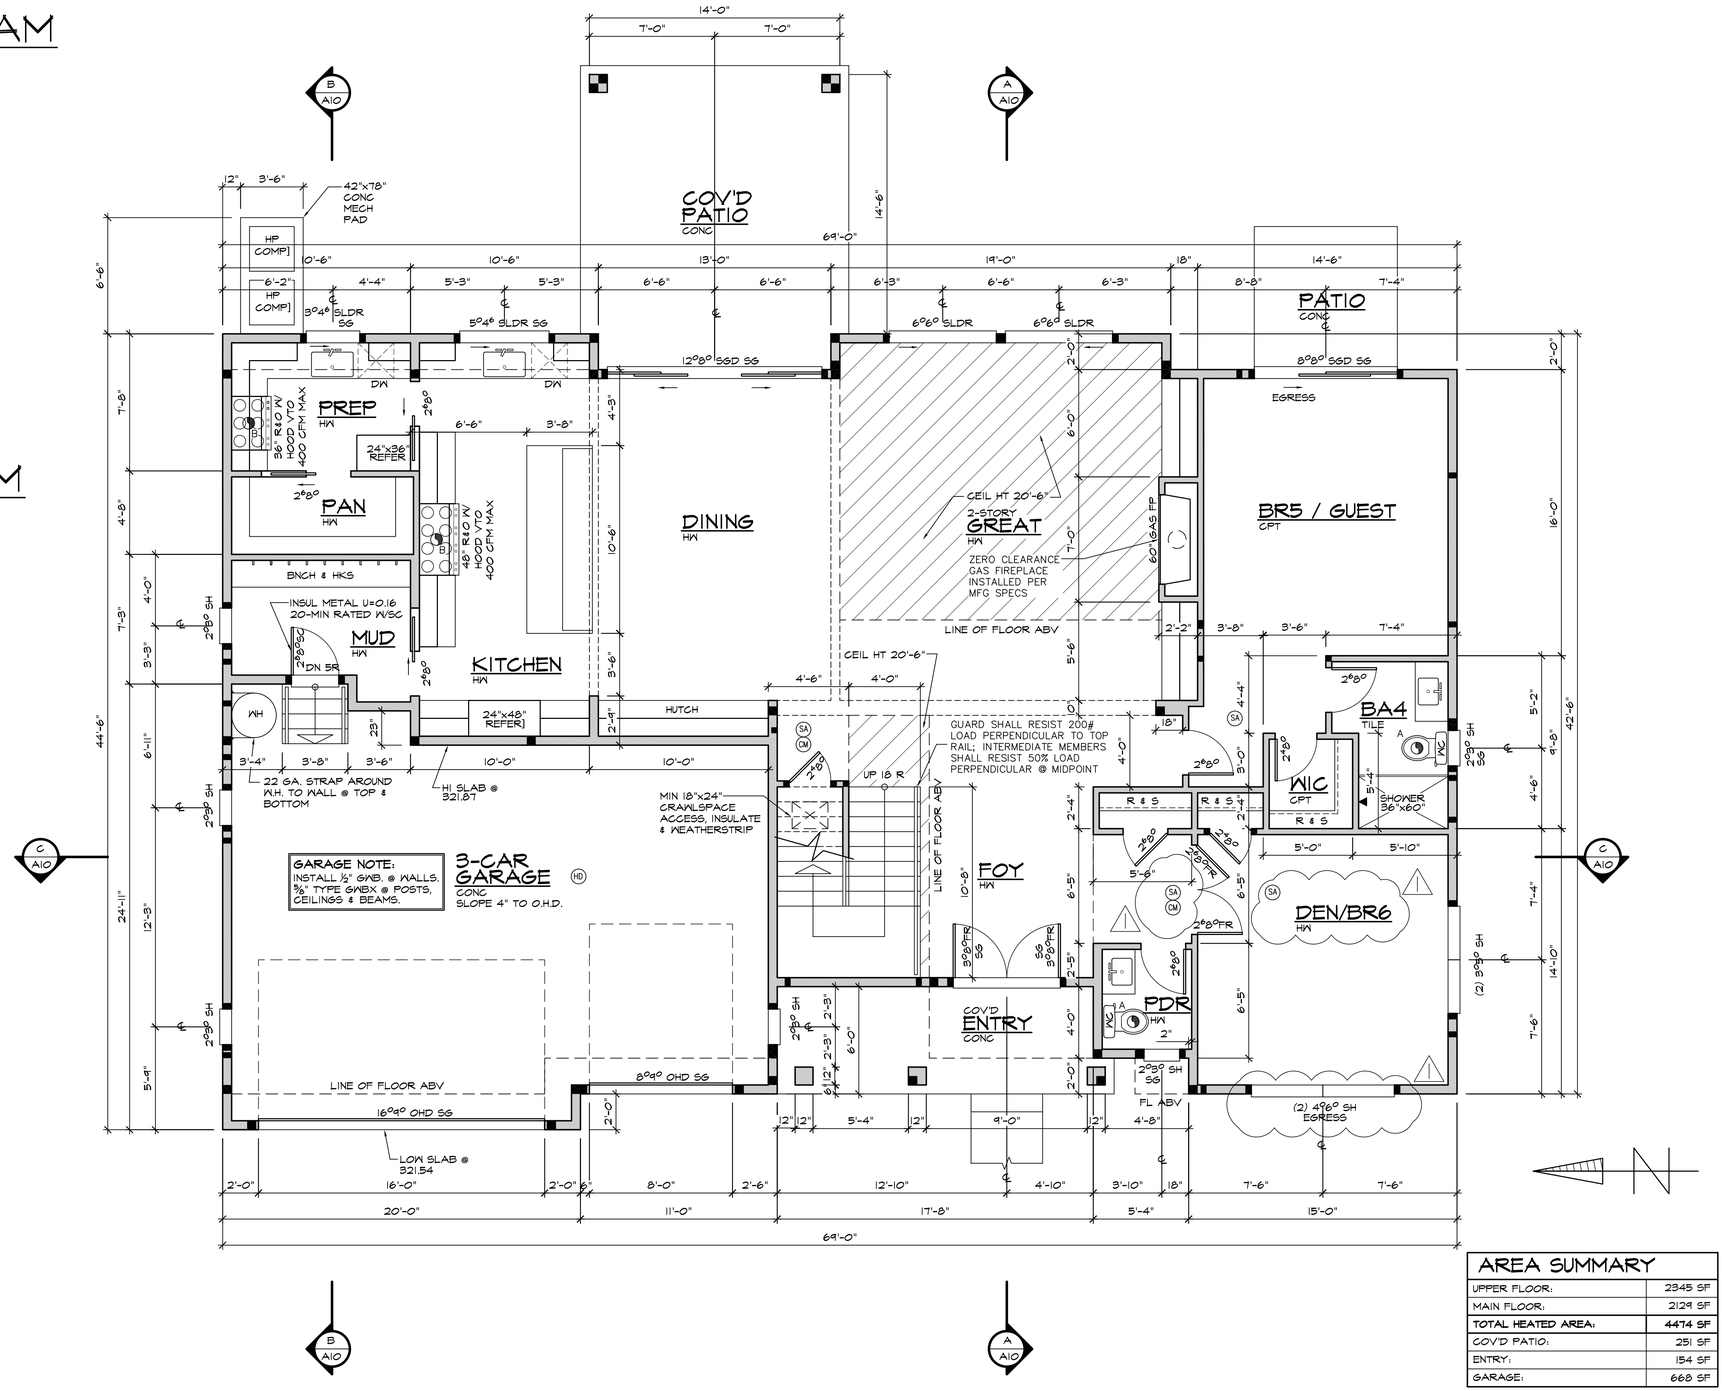

AREA SUMMARY

UPPER FLOOR:	2345 SF
MAIN FLOOR:	2129 SF
TOTAL HEATED AREA:	4474 SF
COV'D PATIO:	251 SF
ENTRY:	154 SF
GARAGE:	668 SF

GFA AREA SUMMARY

UPPER FLOOR:	2647 SF
MAIN FLOOR:	2129 SF
GARAGE:	546 SF
TOTAL FAR AREA:	5372 SF

MAIN FLOOR PLAN

SCALE: 1/4" = 1'-0"

Your Family Architect

ARCHITECTS NORTHWEST
18915-142ND AVENUE NE SUITE 100
WOODINVILLE, WA 98072
OFFICE: (425) 485-4900
FAX: (425) 487-6585
TOLL FREE: 1-888-272-4100
WWW.ARCHITECTSNW.COM

REGISTERED ARCHITECT
5046
JEFFREY P. ARNOLT
STATE OF WASHINGTON
3/6/25

PAYMENT OF USE FEE IS DUE TO ARCHITECTS NORTHWEST, INC. PRIOR TO CONSTRUCTION FOR EACH STRUCTURE BUILT FROM THESE PLANS. SUCH USE SHALL BE IN ACCORDANCE WITH FEDERAL STATUTES. REPRODUCTION BY ANY METHOD OF THESE DRAWINGS AND PLANS SET VARIATIONS THEREOF WITHOUT WRITTEN PERMISSION FROM ARCHITECTS NORTHWEST, INC. IS STRICTLY PROHIBITED. THESE DRAWINGS AND PLANS SET FORTH HEREIN, AND THE IDEAS AND DESIGNS THEREIN ARE, AND SHALL REMAIN, THE PROPERTY OF ARCHITECTS NORTHWEST, INC.

NW EASTSIDE BUILDERS LLC

4024 - 85TH AVE SE, MERCER ISLAND

PLAN M455|A3F-0

DESIGNED BY: DNB DATE: 1/25
DRAWN BY: DNB DATE: 3/6/25
PROJECT MANAGER: JdeR
REVISED BY: DATE:
WHB 7/24/25
DAK 8/12/25
LATERAL BY: ME DATE: 4/22/25
LATERAL JOB NUMBER: 2608

A5
A10

ANW WOODINVILLE OFFICE JOB NUMBER: 250013

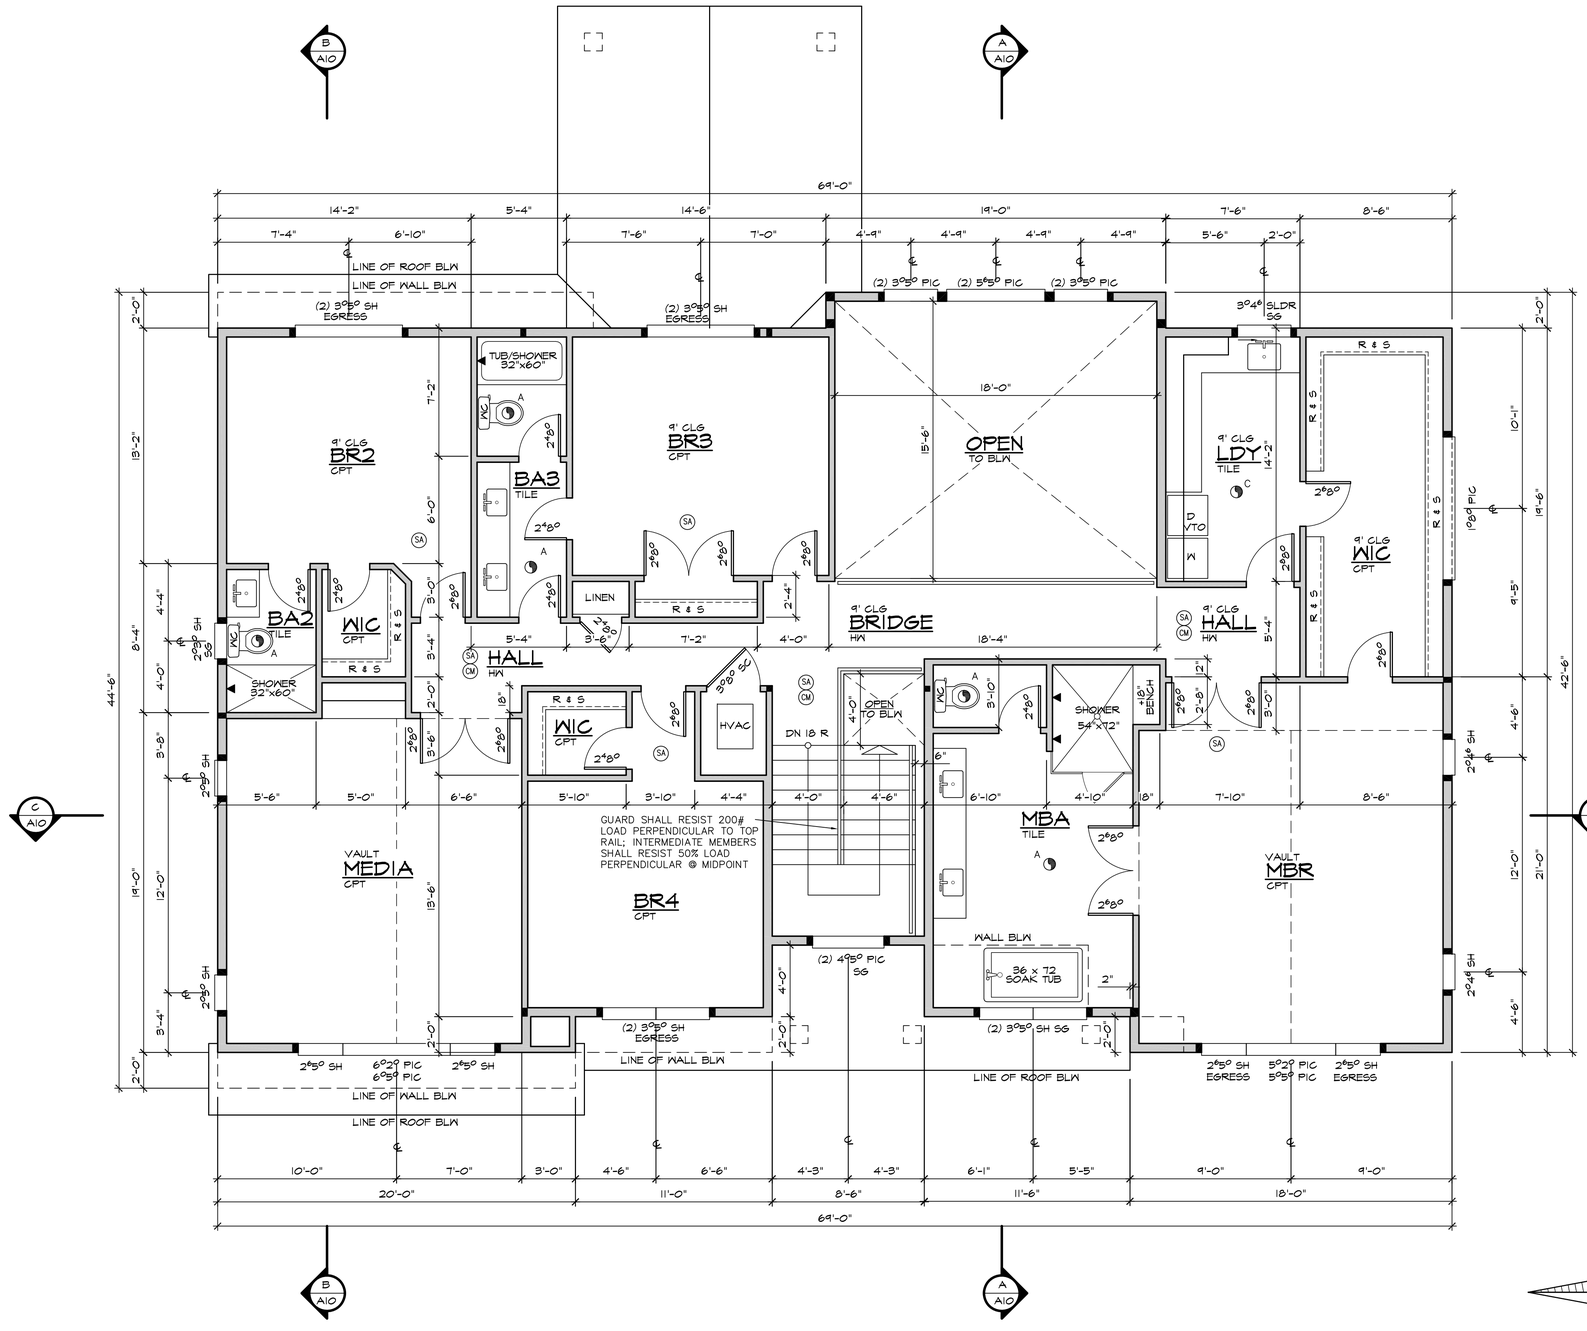

UPPER FLOOR PLAN

SCALE: 1/4" = 1'-0"

Your Family Architect

ARCHITECTS NORTHWEST
18915-142ND AVENUE NE SUITE 100
WOODINVILLE, WA 98072
OFFICE: (425) 485-4900
FAX: (425) 487-6585
TOLL FREE: 1-888-272-4100
WWW.ARCHITECTSNW.COM

REGISTERED ARCHITECT
5046
JEFFREY P. ARNOLT
STATE OF WASHINGTON
3/6/25

PAYMENT OF USE FEE IS DUE TO ARCHITECTS NORTHWEST, INC. PRIOR TO CONSTRUCTION FOR EACH STRUCTURE BUILT FROM THESE PLANS. USE OF THESE PLANS IS RESTRICTED IN ACCORDANCE WITH FEDERAL STATUTES. REPRODUCTION BY ANY METHOD, ALL OR IN PART, IS STRICTLY PROHIBITED. VARIATIONS THEREOF WITHOUT WRITTEN PERMISSION FROM ARCHITECTS NORTHWEST, INC. ARE STRICTLY PROHIBITED. THESE DRAWINGS AND PLANS SET FORTH ARE AND SHALL REMAIN, THE PROPERTY OF ARCHITECTS NORTHWEST, INC.

NW EASTSIDE BUILDERS LLC

4024 - 85TH AVE SE, MERCER ISLAND

PLAN M4551A3F-O

DESIGNED BY: DWB DATE: 1/25
DRAWN BY: DWB DATE: 3/6/25
PROJECT MANAGER: JGR
REVISED BY: DATE:
1 WHB 7/24/25
2 DAK 8/12/25
LATERAL BY: ME DATE: 4/22/25
LATERAL JOB NUMBER: 2608

A6
A10

ANW WOODINVILLE OFFICE JOB NUMBER: 250013

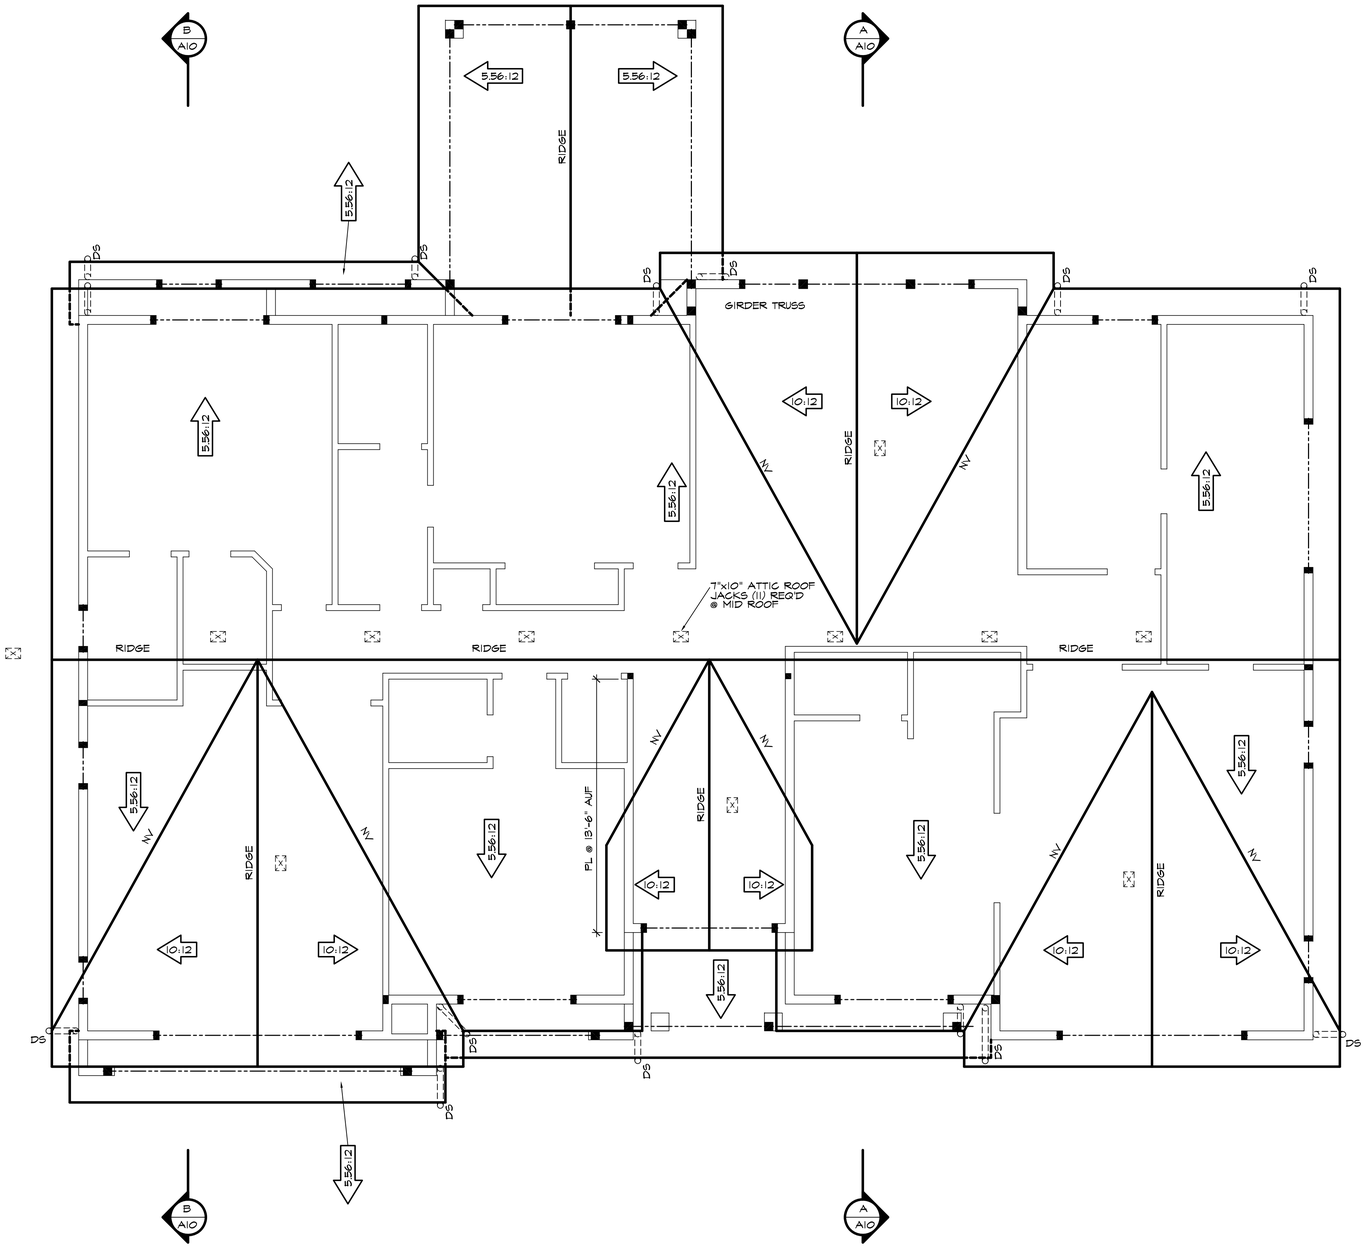

ROOF GEOMETRY & VENTING PLAN

SCALE: 1/4" = 1'-0"

Your Family Architect

ARCHITECTS NORTHWEST
18915-142ND AVENUE NE SUITE 100
OFFICE: (425) 485-4900
TOLL FREE: 1-888-272-4100
WOODINVILLE, WA 98072
FAX: (425) 487-6585
WWW.ARCHITECTSNW.COM

PAYMENT OF USE FEE IS DUE TO ARCHITECTS NORTHWEST, INC. PRIOR TO CONSTRUCTION FOR EACH STRUCTURE BUILT FROM THESE PLANS. ALL PLANS AND WORKS ARE COPYRIGHTED AND PROTECTED WITH FEDERAL STATUTES. REPRODUCTION BY ANY METHOD OR MEANS WHATSOEVER IS STRICTLY PROHIBITED. ANY VARIATIONS THEREOF WITHOUT WRITTEN PERMISSION FROM ARCHITECTS NORTHWEST, INC. IS STRICTLY PROHIBITED. THESE DRAWINGS AND PLANS SET FORTH HEREIN, THE IDEAS, AND DESIGNS INCORPORATED ARE, AND SHALL REMAIN, THE PROPERTY OF ARCHITECTS NORTHWEST, INC.

5046 REGISTERED ARCHITECT JEFFREY P. ARNOLT STATE OF WASHINGTON 3/6/25

NW EASTSIDE BUILDERS LLC

4024 - 85TH AVE SE, MERCER ISLAND

PLAN M455|A3F-0

DESIGNED BY: DWB DATE: 1/25
DRAWN BY: DWB DATE: 3/6/25
PROJECT MANAGER: JdeR
REVISED BY: DATE:
1 WHB 7/24/25
2 DAK 8/12/25
LATERAL BY: ME DATE: 4/22/25
LATERAL JOB NUMBER: 2608

A7
A10

ANW WOODINVILLE OFFICE JOB NUMBER: 250013

FRONT (W) ELEVATION

SCALE: 1/4" = 1'-0"

REAR (E) ELEVATION

SCALE: 1/4" = 1'-0"

Your Family Architect

ARCHITECTS NORTHWEST

REGISTERED ARCHITECT
5046
JEFFREY P. ARNOLD
STATE OF WASHINGTON
3/6/25

PAYMENT OF USE FEE IS DUE TO ARCHITECTS NORTHWEST, INC. PRIOR TO CONSTRUCTION FOR EACH STRUCTURE BUILT FROM THESE PLANS. USE OF THESE PLANS WITHOUT PAYMENT OF FEE IS WITH FEDERAL STATUTES. REPRODUCTION BY ANY METHOD, IN WHOLE OR IN PART, IS STRICTLY PROHIBITED. ANY VARIATIONS THEREOF WITHOUT WRITTEN PERMISSION FROM ARCHITECTS NORTHWEST, INC. ARE PROHIBITED. THESE DRAWINGS AND PLANS SET FORTH HEREIN, AND THE IDEAS AND DESIGNS THEREIN ARE, AND SHALL REMAIN, THE PROPERTY OF ARCHITECTS NORTHWEST, INC.

ARCHITECTS NORTHWEST
18915-142ND AVENUE NE SUITE 100
WOODINVILLE, WA 98072
OFFICE: (425) 485-4900
FAX: (425) 487-6585
TOLL FREE: 1-888-272-4100
WWW.ARCHITECTSNW.COM

NW EASTSIDE BUILDERS LLC

4024 - 85TH AVE SE, MERCER ISLAND

PLAN M455|A3F-O

DESIGNED BY: DWB	DATE: 1/25
DRAWN BY: DWB	DATE: 3/6/25
PROJECT MANAGER: JdeR	
REVISED BY: ⚠1 WHB 7/24/25 ⚠2 DAK 8/12/25	
LATERAL BY: ME	DATE: 4/22/25
LATERAL JOB NUMBER: 2608	

A8
A10

ANW WOODINVILLE OFFICE JOB NUMBER: 250013

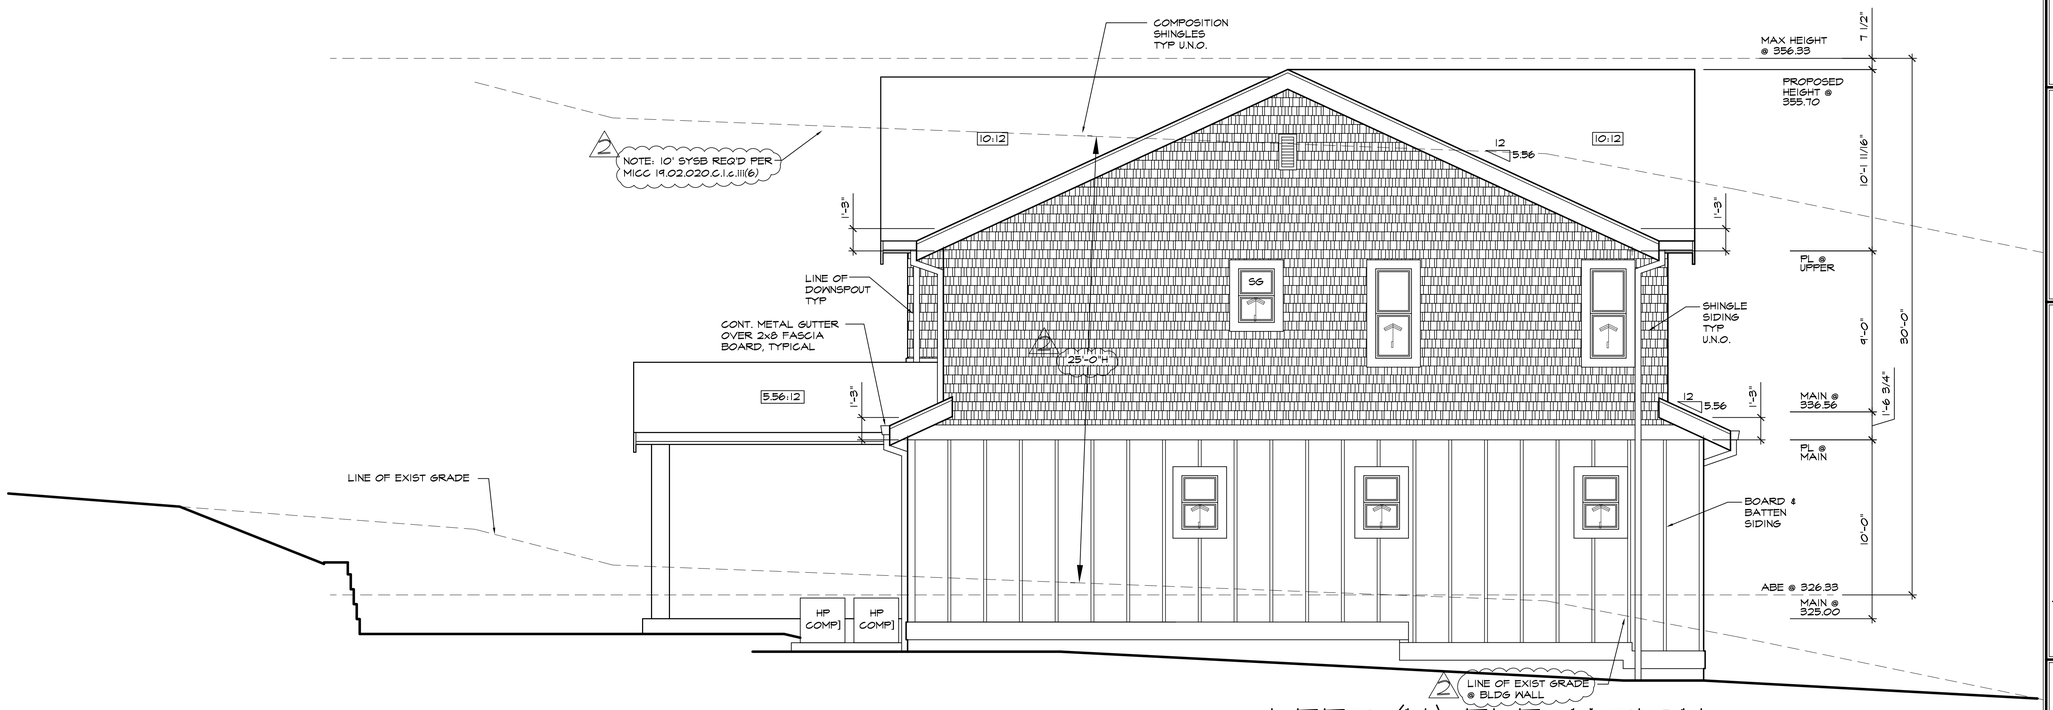

LEFT (N) ELEVATION

SCALE: 1/4" = 1'-0"

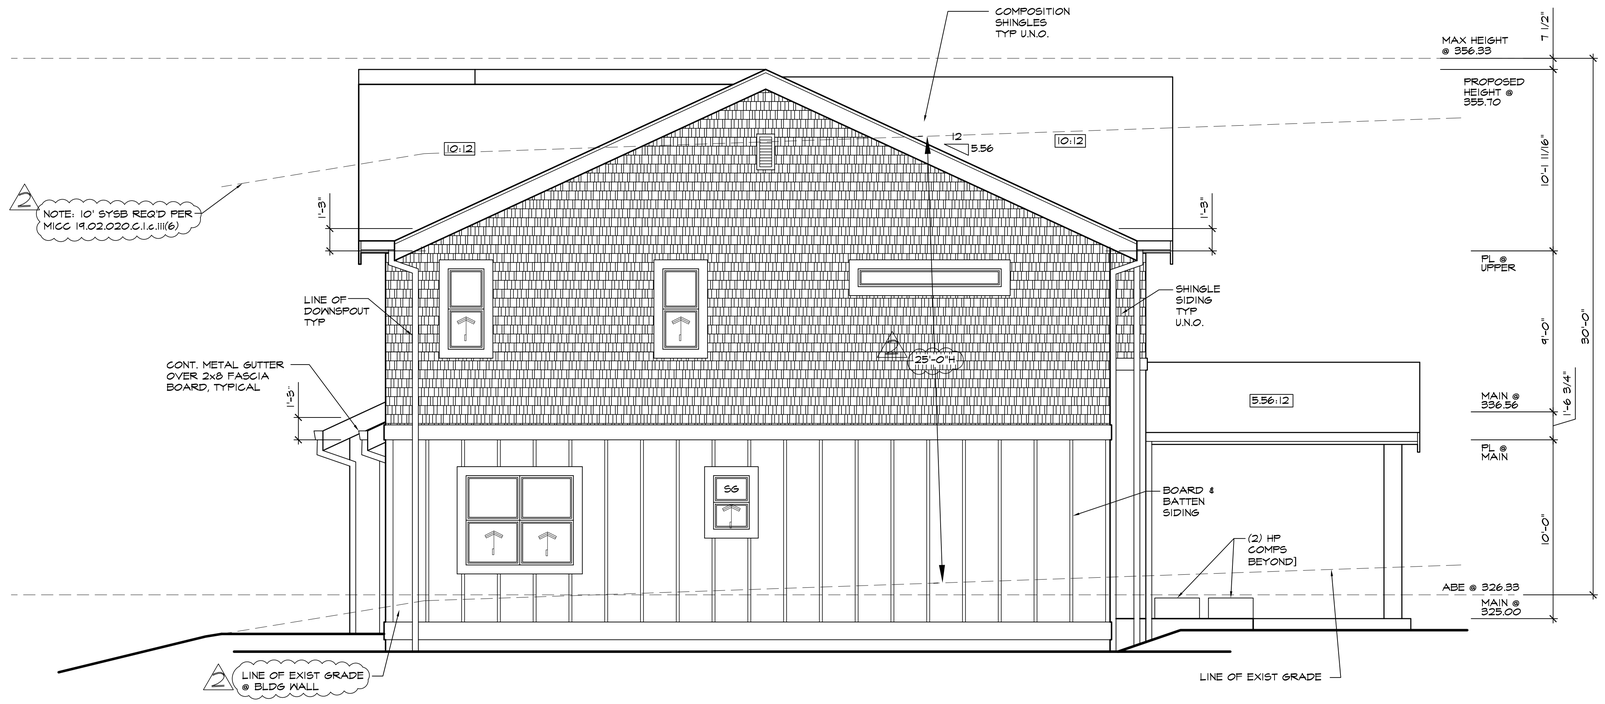

RIGHT (S) ELEVATION

SCALE: 1/4" = 1'-0"

Your Family Architect

ARCHITECTS NORTHWEST

REGISTERED ARCHITECT
5046
JEFFREY P. ARNOLD
STATE OF WASHINGTON
3/6/25

PAYMENT OF USE FEE IS DUE TO ARCHITECTS NORTHWEST, INC. PRIOR TO CONSTRUCTION FOR EACH STRUCTURE BUILT FROM THESE PLANS. ALL PLANS, DRAWINGS AND SPECIFICATIONS ARE WITH FEDERAL STATUTES. REPRODUCTION BY ANY METHOD, ALTERATION OR REUSE WITHOUT EXPRESSED WRITTEN PERMISSION OR AGREEMENT IS PROHIBITED. IN THE EVENT OF UNAUTHORIZED REUSE, THESE DRAWINGS AND PLANS SET FORTH AUTHORIZED USES WHICH WERE CONVEYED ARE, AND SHALL REMAIN, THE PROPERTY OF ARCHITECTS NORTHWEST, INC.

ARCHITECTS NORTHWEST
18915-142ND AVENUE NE SUITE 100
OFFICE: (425) 485-4900
TOLL FREE: 1-888-272-4100
WOODINVILLE, WA 98072
FAX: (425) 487-6585
WWW.ARCHITECTSNW.COM

NW EASTSIDE BUILDERS LLC

4024 - 85TH AVE SE, MERCER ISLAND

PLAN M455|A3F-O

DESIGNED BY: DWB	DATE: 1/25
DRAWN BY: DWB	DATE: 3/6/25
PROJECT MANAGER: JdeR	
REVISED BY: 1 WHB	DATE: 7/24/25
2 DAK	8/12/25
LATERAL BY: ME	DATE: 4/22/25
LATERAL JOB NUMBER: 2608	

A9
A10

ANW WOODINVILLE OFFICE JOB NUMBER: 250013

BUILDING SECTION C

SCALE: 1/4" = 1'-0"

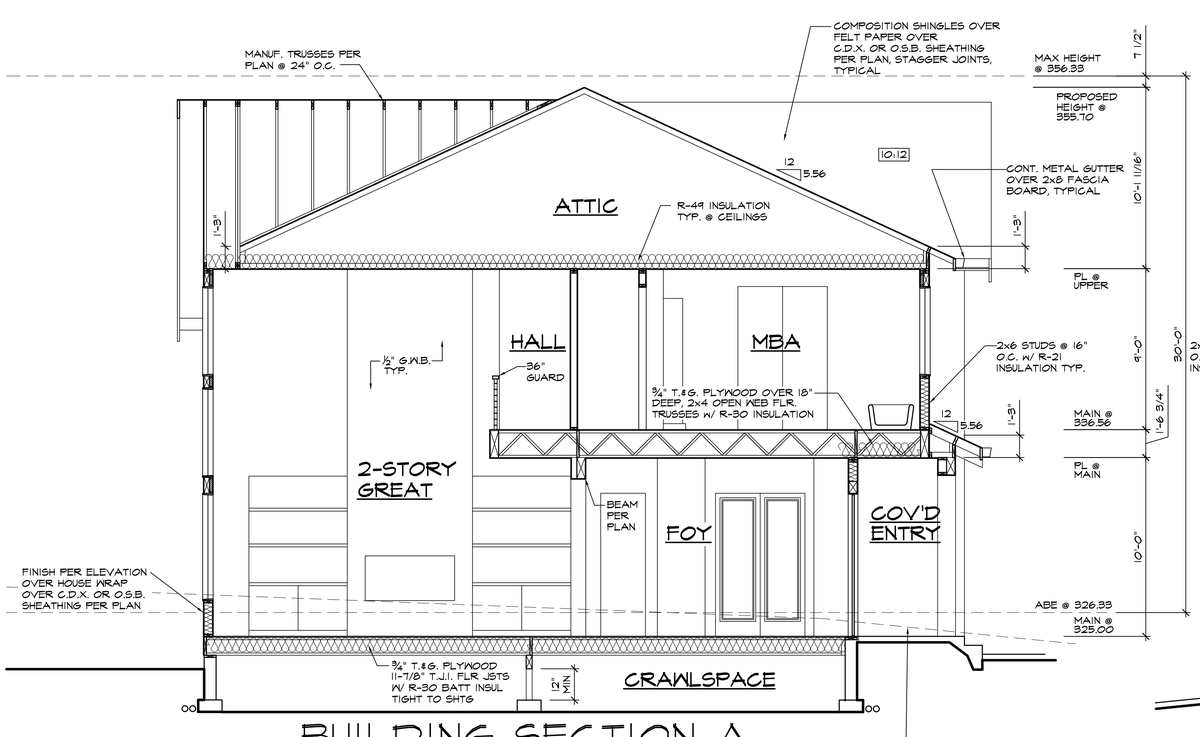

BUILDING SECTION A

SCALE: 1/4" = 1'-0"

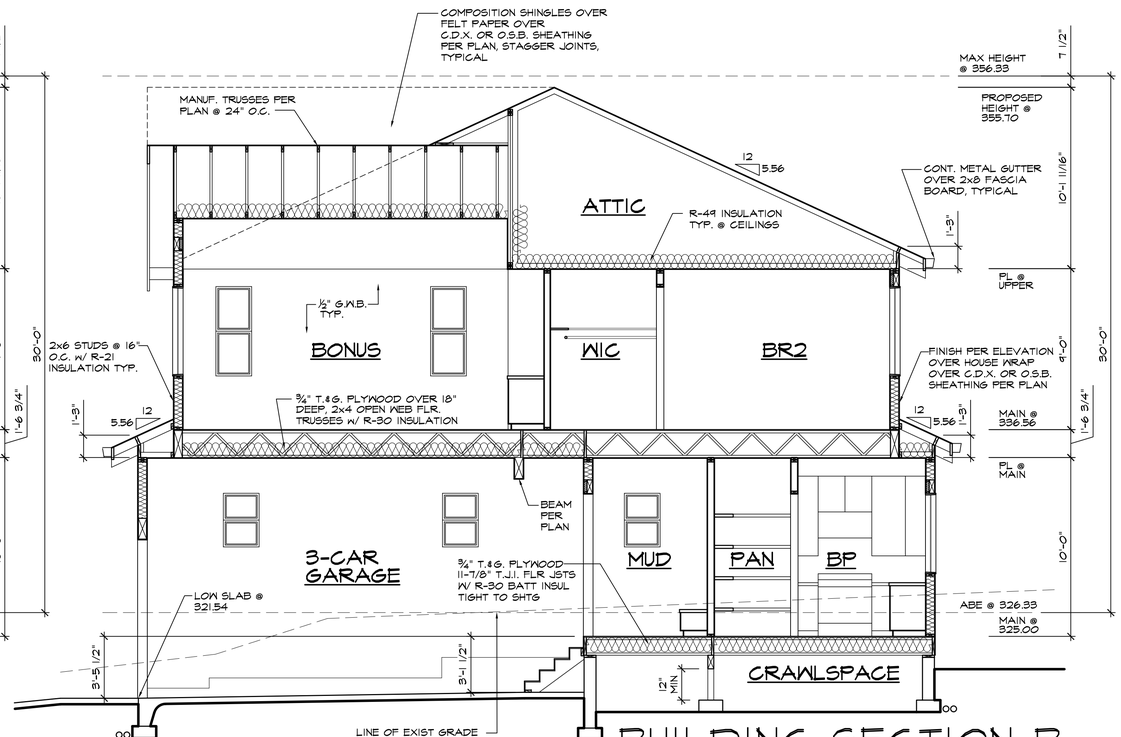

BUILDING SECTION B

SCALE: 1/4" = 1'-0"

Your Family Architect

REGISTERED ARCHITECT
3046
JEFFREY P. ARNOLT
STATE OF WASHINGTON
3/6/25

PAYMENT OF USE FEE IS DUE TO ARCHITECTS NORTHWEST, INC. PRIOR TO CONSTRUCTION FOR EACH STRUCTURE BUILT FROM THESE PLANS. ALL PLANS, DESIGNS, AND ARRANGEMENTS ARE PROTECTED BY COPYRIGHT LAW. REPRODUCTION BY ANY METHOD, ALL OR IN PART, IS STRICTLY PROHIBITED. ANY UNAUTHORIZED USE OF THESE DRAWINGS AND PLANS SET VIOLATES THE AMERICAN INSTITUTE OF ARCHITECTS CODE OF ETHICS AND PROFESSIONAL CONDUCT. THESE DRAWINGS AND PLANS SET ARE, AND SHALL REMAIN, THE PROPERTY OF ARCHITECTS NORTHWEST, INC.

ARCHITECTS NORTHWEST
18915-142ND AVENUE NE SUITE 100
OFFICE: (425) 485-4900
TOLL FREE: 1-888-272-4100
WOODINVILLE, WA 98072
FAX: (425) 487-6585
WWW.ARCHITECTSNW.COM

NW EASTSIDE BUILDERS LLC

4024 - 85TH AVE SE, MERCER ISLAND

PLAN M4551A3F-O

DESIGNED BY:	DATE:
DWB	1/25
DRAWN BY:	DATE:
DWB	3/6/25

PROJECT MANAGER: JdeR

REVISED BY:	DATE:
1 WHB	7/24/25
2 DAK	8/12/25

LATERAL BY:	DATE:
ME	4/22/25

LATERAL JOB NUMBER: 2608

A10 / A10

ANW WOODINVILLE OFFICE JOB NUMBER: 250013

BUILDING CODE: 2021 EDITION OF THE INTERNATIONAL BUILDING CODE (IBC), AND BY REFERENCE, THE 2021 INTERNATION RESIDENTIAL CODE (IRC) AS AMENDED BY LOCAL JURISDICTION.
ROOF LIVE LOAD = 25 PSF SNOW (GROUND SNOW = 30 PSF)
ROOF DEAD LOAD = 15 PSF
FLOOR LIVE LOAD = 40 PSF (30 PSF AT SLEEPING AREAS)
FLOOR DEAD LOAD = 15 PSF
BALCONIES & DECKS = 60 PSF (LIVE LOAD) + 10 PSF (DEAD LOAD)
WIND SPEED (NOMINAL 3 SEC GUST) = 100 MPH FOR RISK CATEGORY II, EXPOSURE "B", Kzt=1.00
SOIL SITE CLASS "C" , SEISMIC CATEGORY D1/D2, Ss=1.50, Sds=1.00
OCCUPANCY GROUP: R-3 CONSTRUCTION TYPE: V-B

CONTRACTOR TO VERIFY ALL DIMENSIONS AND CONDITIONS OF PROJECT AND REPORT ANY OMISSIONS / DISCREPANCIES TO ARCHITECT AND/OR ENGINEER OF RECORD FOR RESOLUTION PRIOR TO COMMENCING WORK. WRITTEN DIMENSIONS TAKE PRECEDENCE OVER SCALED DRAWINGS ARCHITECT AND/OR ENGINEER OF RECORD ARE NOT RESPONSIBLE FOR DISCREPANT CONDITIONS RESULTING FROM UNAUTHORIZED WORK PERFORMED BY THE CONTRACTOR

DEFERRED SUBMITTAL ITEMS

THE FOLLOWING IS A LIST OF ITEMS THAT ARE NOT INCLUDED IN THIS PLAN AND SHOULD BE PROVIDED BY THE BUILDER AT TIME OF APPLICATION FOR PERMIT OR AS A DEFERRED SUBMITTAL ITEM:
- ALTERNATIVE I-JOIST/BEAM MANUFACTURER PLANS.
- MANUFACTURED TRUSS DESIGNS AND LAYOUTS.

GENERAL

FOUNDATION DESIGN IS BASED ON AN ALLOWABLE SOIL BEARING OF 3,000 PSF. EXTERIOR FOOTINGS SHALL BEAR 18" (MINIMUM) BELOW FINISHED GRADE. ALL FOOTINGS TO BEAR ON FIRM UNDISTURBED EARTH BELOW ORGANIC SURFACE SOILS. BACKFILL TO BE THOROUGHLY COMPACTED.
BOLT HEADS AND NUTS BEARING AGAINST WOOD TO BE PROVIDED WITH Ø229"x3"x3" PLATE WASHERS. WOOD BEARING ON OR INSTALLED WITHIN 1" OF MASONRY OR CONCRETE TO BE PRESSURE TREATED WITH AN APPROVED PRESERVATIVE.
FOUNDATION SILL BOLTS (MIN. 1" EMBED.) TO BE 5/8" DIAMETER AT 6'-0" OC. (4'-0" AT BUILDINGS OVER 2 STORIES) U.N.O.
METAL FRAMING CONNECTORS TO BE MANUFACTURED BY SIMPSON STRONG-TIE OR USP STEEL CONNECTORS

CONCRETE

MINIMUM COMPRESSIVE STRENGTH OF CONCRETE:

TYPE OR LOCATIONS OF CONCRETE CONSTRUCTION	MINIMUM COMPRESSIVE STRENGTH (f'c) AT 28 DAYS
	MODERATE WEATHERING POTENTIAL
BASEMENT WALLS, FOUNDATION FOOTINGS, BASEMENT SLABS, & INTERIOR SLABS ON GRADE (EXCEPT GARAGE) NOT EXPOSED TO THE WEATHER	2,500 psi
BASEMENT WALLS, FOUNDATION WALLS, EXTERIOR WALLS, PORCHES, STEPS, GARAGE & CARPORT SLABS, & OTHER CONCRETE WORK EXPOSED TO THE WEATHER	3,000 psi (6% air entrained +/- 1%)

CONCRETE MIXTURE SHALL CONTAIN AT LEAST OF 5½ SACKS OF CEMENT PER CUBIC YARD CONCRETE "BATCH TICKET" SHALL BE AVAILABLE ON SITE FOR REVIEW BY BUILDING OFFICIAL VERTICAL REINFORCING STEEL TO COMPLY WITH A615M A615 GRADE 40 (GRADE 60 AT WALLS RETAINING MORE THAN 4FT OF SOIL)

CARPENTRY

GENERAL

ALL NAILING TO COMPLY WITH REQUIREMENTS OF IRC TABLE R602.3(1) AND/OR IBC TABLE 2304.10.1
ALL WOOD IN CONTACT WITH CONCRETE TO BE PRESSURE TREATED. FIELD CUT ENDS, NOTCHES, AND DRILLED HOLES OF PRESSURE TREATED LUMBER SHALL BE RETREATED IN THE FIELD IN ACCORDANCE WITH AWPA M4. PER IRC 319.3, FASTENERS FOR PRESSURE PRESERVATIVE AND FIRE RETARDANT TREATED WOOD SHALL BE OF HOT-DIPPED GALVANIZED STEEL, STAINLESS STEEL, SILICON BRONZE, OR COPPER.
6" MIN. CLEARANCE BETWEEN WOOD AND EARTH.
12" MIN. CLEARANCE BETWEEN FLOOR BEAMS AND EARTH.
18" MIN. CLEARANCE BETWEEN FLOOR JOIST AND EARTH.

FASTENER DIMENSIONS

ALL NAILS SPECIFIED ON THIS PLAN SHALL BE OF THE DIAMETER AND LENGTH LISTED BELOW OR AS PER APPENDIX L OF THE NATIONAL DESIGN SPECIFICATION FOR WOOD CONSTRUCTION (NDS)
8d COMMON (Ø.131" DIA., 2-1/2" LENGTH), 8d BOX (Ø.113" DIA, 2-1/2" LONG), 10d COMMON (Ø.148" DIA, 3" LONG)
10d BOX (Ø.128" DIA., 3" LENGTH), 16d COMMON (Ø.162" DIA, 3-1/2" LONG), 16d SINKER (Ø.148 DIA, 3-1/4" LONG)
5d COOLER (Ø.086" DIA, 1-5/8" LONG), 6d COOLER (Ø.092" DIA, 1-7/8" LONG)

LUMBER GRADES

FRAMING LUMBER SHALL COMPLY WITH THE LATEST EDITION OF THE GRADING RULES OF THE WESTERN PRODUCTS ASSOCIATION OR THE WEST COST LUMBER INSPECTION BUREAU. ALL SAWN LUMBER SHALL BE STAMPED WITH THE GRADE MARK OF AN APPROVED LUMBER GRADING AGENCY AND SHALL HAVE THE FOLLOWING UNADJUSTED MINIMUM DESIGN PROPERTIES, UNLESS NOTED OTHERWISE.

JOISTS:	WOOD TYPE:
2X4 to 2X8	DF-L #2 - Fb=900 psi, Fv=180 psi, Fc=1350 psi, E=1600000psi
2X10 OR LARGER	DF-L #2 - Fb=900 psi, Fv=180 psi, Fc=1350 psi, E=1600000psi
BEAM	
4X	DF-L #2 - Fb=900 psi, Fv=180 psi, Fc=1350 psi, E=1600000psi
6X OR LARGER	DF-L #1 - Fb=1350 psi, Fv=170 psi, Fc=925 psi, E=1600000psi
STUDS	
2X4 & 2X6	DF STUD - Fb=700 psi, Fv=180 psi, Fc=850 psi, E=1400000psi
2X8 OR LARGER	DF-L #2 - Fb=900 psi, Fv=180 psi, Fc=1350 psi, E=1600000psi
POSTS	
4X4	DF-L #2 - Fb=900 psi, Fv=180 psi, Fc=1350 psi, E=1600000psi
4X6	DF-L #2 - Fb=900 psi, Fv=180 psi, Fc=1350 psi, E=1600000psi
6X6 OR LARGER	DF-L #1 - Fb=1200 psi, Fv=170 psi, Fc=1000 psi, E=1600000psi

GLUED-LAMINATED BEAM (GLB)

SHALL BE 24F-V4 FOR SINGLE SPANS & 24F-V8 FOR CONTINUOUS OR CANTILEVER SPANS WITH THE FOLLOWING MINIMUM PROPERTIES:
Fb = 2,400 PSI, Fv = 165 PSI, Fc = 650 PSI (PERPENDICULAR), E = 1,800,000 PSI.

ENGINEERED WOOD BEAMS AND I-JOIST

CONTRACTOR SHALL SUBMIT SHOP DRAWINGS AND SPECIFICATIONS FOR APPROVAL BY BUILDING OFFICIAL. DESIGN, FABRICATION AND ERECTION IN ACCORDANCE WITH THE LATEST ICC EVALUATION REPORT.

BEAMS DESIGNATED AS "LSL" SHALL HAVE THE MINIMUM PROPERTIES:
Fb = 2,325 PSI, Fv = 310 PSI, Fc = 800 PSI (PERPENDICULAR), E = 1,550,000 PSI.

BEAMS DESIGNATED AS "LVL" SHALL HAVE THE MINIMUM PROPERTIES:
Fb = 2,600 PSI, Fv = 285 PSI, Fc = 750 PSI (PERPENDICULAR), E = 1,900,000 PSI.

BEAMS DESIGNATED AS "PSL" SHALL HAVE THE MINIMUM PROPERTIES:
Fb = 2,900 PSI, Fv = 290 PSI, Fc = 750 PSI (PERPENDICULAR), E = 2,000,000 PSI.

CALCULATIONS SHALL INCLUDE DEFLECTION AND CAMBER REQUIREMENTS.
DEFLECTION SHALL BE LIMITED AS FOLLOWS:
FLOOR LIVE LOAD MAXIMUM = L/480, FLOOR TOTAL LOAD MAXIMUM = L/240.

PREFABRICATED WOOD TRUSSES:

PRE-FABRICATED WOOD TRUSSES SHALL BE DESIGNED TO SUPPORT SELF WEIGHT PLUS LIVE LOADS & IMPOSED DEAD LOADS AS STATED IN THE GENERAL NOTES. TRUSSES SHALL BE DESIGNED & STAMPED BY A REGISTERED DESIGN PROFESSIONAL AND FABRICATED ONLY FROM THOSE DESIGNS. NON-BEARING WALLS SHALL BE HELD AWAY FROM THE TRUSS BOTTOM CHORD W/ AN APPROVED FASTENER (SUCH AS SIMPSON ST22) TO ENSURE THAT THE TRUSS BOTTOM CHORD DOES NOT BEAR ON THE WALL. ALL PERMANENT TRUSS MEMBER BRACING SHALL BE INSTALLED PER THE TRUSS DESIGN DRAWINGS.

ROOF/WALL/FLOOR SHEATHING

ROOF SHEATHING SHALL BE MINIMUM 7/16 APA RATED SHEATHING W/ 24/16 SPAN INDEX W/ 6" O.C. NAILING AT EDGES & FIELD OF PANEL. WALL SHEATHING, INCLUDING GABLES, SHALL BE 7/16 APA RATED SHEATHING W/ 24/16 SPAN INDEX MINIMUM. FLOOR SHEATHING SHALL BE MINIMUM 23/32 APA RATED STURD-I-FLOOR T&G SHEATHING W/ 48/24 SPAN INDEX MINIMUM U.N.O.. MINIMUM NAILING FOR WALL & FLOOR SHALL BE 8d COMMON NAILS @ 6" O.C. @ PANEL EDGES & 12" O.C. IN PANEL FIELD U.N.O. ON SHEAR WALL SCHEDULE. ROOF AND FLOOR SHEATHING SHALL BE LAID OUT W/ LONG DIMENSION PERPENDICULAR TO FRAMING MEMBERS W/ END LAPS STAGGERED. WALL SHEATHING, INCLUDING GABLES, SHALL BE FULLY BLOCKED & EDGE NAILED AT ALL UNSUPPORTED SHEATHING PANEL EDGES.

STAIR FRAMING

UNLESS NOTED OTHERWISE SPECIFIED, TYPICAL STAIR FRAMING SHALL CONSIST OF 2X12 STAIR STRINGERS SPACED AT NO MORE THAN 18" O.C. AND REINFORCED W/ 2X6 SCABS ATTACHED W/ 10d COMMON NAILS STAGGERED AT 8" O.C.. STRINGERS SHALL BE SUPPORTED AT UPPER END BY BEARING ON TOP PLATE OF WALL OR APPROVED CONNECTOR TO FLOOR BEAM SUCH AS SIMPSON LRU OR LSC. LANDINGS SHALL CONSIST OF CONVENTIONAL PLATFORM FRAMING W/ MINIMUM 2X6 JOISTS @ 16" O.C.

SHEAR WALL SCHEDULE

WALL MARK	SHEATHING (MINIMUM)	EDGE NAILING	FIELD NAILING	FRAMING @ ADJOINING PANEL EDGES	SOLE PLATE NAILING (STAGGER)	MINIMUM RIM BOARD OR BLOCKING WIDTH BELOW WALL	SILL PLATE	ANCHOR BOLT DIA. & SPACING
P1-6	7/16 SHEATHING ONE SIDE	8d (Ø.131"x2.5") AT 6" O.C.	12" O.C.	2X	(1) ROW 16d SINKER (Ø.148"x3½") @ 8" O.C.	1.25" LSL (1.3E) UNLESS NOTED OTHERWISE	2X	5/8" DIA. @ 64" O.C.
P1-4	7/16 SHEATHING ONE SIDE	8d (Ø.131"x2.5") AT 4" O.C.	12" O.C.	2X	(1) ROW 16d SINKER (Ø.148"x3½") @ 6" O.C.	1.25" LSL (1.3E) UNLESS NOTED OTHERWISE	2X	5/8" DIA. @ 48" O.C.
P1-3	7/16 SHEATHING ONE SIDE	8d (Ø.131"x2.5") AT 3" O.C.	12" O.C.	2X	(1) ROW 16d SINKER (Ø.148"x3½") @ 4" O.C.	1.75" LSL (1.55E) UNLESS NOTED OTHERWISE	2X	5/8" DIA. @ 32" O.C.
H3	7/16 SHEATHING ONE SIDE	SEE DETAIL H3 ON SHEET S1 FOR FRAMING CONFIGURATION & SPECIFICATION OF NAILING, STRAPS, & HOLDOWNS (REFER TO APA TECHNICAL TOPIC TT-100, "A PORTAL FRAME W/ HOLDOWNS FOR ENGINEERED APPLICATIONS")						

1. FRAMING SHALL BE 2X DOUG-FIR @ 16" O.C. MAX UNLESS NOTED OTHERWISE IN SCHEDULE.
2. SHEATHING PANELS MAY BE LAYED VERTICAL OR HORIZONTAL. BLOCK ALL ADJOINING HORIZONTAL EDGES W/ 2x OR 3x BLOCKING PER SCHEDULE
3. ALL EXTERIOR WALLS NOT DESIGNATED AS SHEARWALLS SHALL RECEIVE APA RATED SHEATHING OR ALL VENEER PLYWOOD SIDING OF EQUIVALENT THICKNESS AT POINT OF FASTENING ON PANEL EDGES, FULLY BLOCKED WITH MINIMUM NAILING OF 8d (Ø.131"x2.5") @ 6" O.C. EDGE & 12" O.C. FIELD.
4. NAILING APPLIES TO ALL STUDS, TOP PLATES, SOLE PLATES, SILL PLATES, & BLOCKING. PANEL EDGE AND SILL/SOLE PLATE NAILING SHALL BE STAGGERED
5. ANCHOR BOLT SPACING IS 6'-0" O.C. (4'-0" AT BUILDINGS OVER 2 STORIES) UNLESS NOTED OTHERWISE IN SCHEDULE. MINIMUM OF 2 ANCHOR BOLTS PER PIECE OF FOUNDATION PLATE. ANCHOR BOLTS SPACED NO GREATER THAN 12" AND NO LESS THAN 7 TIMES THE ANCHOR BOLT DIAMETER AT ENDS AND SPLICES. PROVIDE Ø229"x3"x3" WASHERS AT ANCHOR BOLTS. PLATE WASHERS SHALL EXTEND TO WITHIN ½" OF THE SHEATHED EDGE OF THE SILL PLATE ON WALLS W/ EDGE NAILING AT 4" O.C. OR TIGHTER. DIAGONALLY SLOTTED WASHERS MAY BE USED W/ A STANDARD CUT WASHER PROVIDED BETWEEN PLATE WASHER & NUT. DO NOT RECESS BOLTS.
6. ALL NAILS FOR SHEAR WALLS SHALL BE COMMON OR GALVANIZED BOX NAILS (U.N.O.) ALL SPECIFIED NAILS SHALL HAVE THE FOLLOWING DIMENSIONS: 8d (Ø.131" DIA x 2.5" LONG), 10d (Ø.148" DIA x 3" LONG), 16d COMMON (Ø.162" DIA x 3.5" LONG), 16d SINKER (Ø.148" DIA x 3.25" LONG)
7. IN LIEU OF 3X STUDS OR BLOCKING AT ADJOINING PANEL EDGES, 2-2X'S FACE NAILED W/ 10d COMMON NAILS (Ø.148" DIA x 3" LONG) STAGGERED AT THE SAME SPACING AS PANEL EDGE NAILING MAY BE SUBSTITUTED. SHEATHING EDGES SHALL BE CENTERED BETWEEN THE 2-2X MEMBERS (SHALL NOT APPLY TO WALLS SHEATHED ON BOTH SIDES UNLESS ADJOINING PANEL EDGES ARE STAGGERED ON OPPOSITE FACES)
8. HOLDDOWNS AND STRAPS OF EQUIVALENT CAPACITY (W/ CURRENT ICC EVALUATION REPORT OR SIMILAR) MAY ONLY BE SUBSTITUTED FOR THOSE SPECIFIED ON PLAN WITH PRIOR APPROVAL OF BUILDING OFFICIAL OR ENGINEER OF RECORD.
9. BLOCKING IN FLOOR JOIST CAVITY IS REQUIRED AT ENDS OF SHEAR WALLS WHERE FULL BEARING IS NOT PROVIDED BY THE FRAMING BELOW. BLOCKING SHALL HAVE WOOD GRAIN ORIENTED VERTICALLY UNLESS NOTED OTHERWISE.
10. SIMPSON MASAP MUDSILL ANCHORS, MAY BE SUBSTITUTED (1) FOR (1) AT 2X SILL PLATES FOR THE 5/8" DIA. SILL PLATE ANCHOR BOLTS SPECIFIED.

PERFORATED SHEAR WALLS: CONTINUE SHEAR WALL SHEATHING ABOVE AND BELOW ALL OPENINGS BETWEEN FULL HEIGHT WALL SEGMENTS WITH NAILING AS SHOWN IN SHEAR WALL SCHEDULE. ANY INCREASE TO HEIGHT OR WIDTH OF WINDOW OPENING MUST BE APPROVED BY ENGINEER OF RECORD.

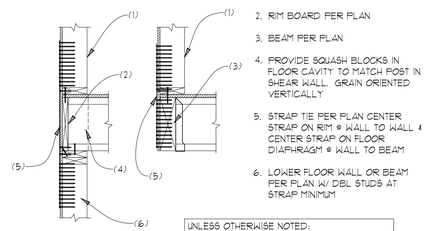

H1 TYPICAL STRAP TIE @ UPPER FLOORS
SCALE: 3/4"=1'

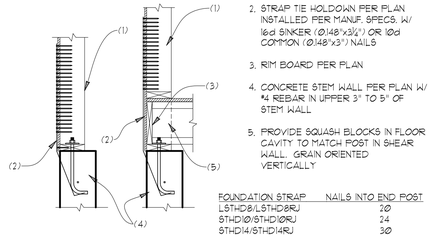

FOUNDATION STRAP	NAILS INTO END POST
LSTHD8/LSTHD8RJ	20
STHD10/STHD10RJ	24
STHD14/STHD14RJ	30

H2 TYPICAL STRAP TIE HOLDOWN
SCALE: 3/4"=1'

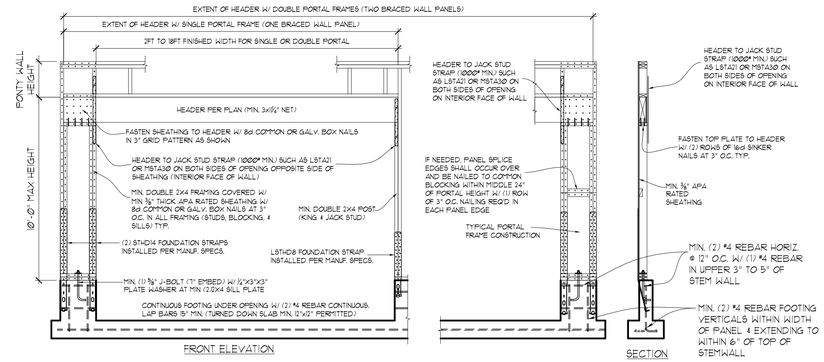

H3 PORTAL FRAME CONSTRUCTION (FIELD BUILT)
SCALE: NTS

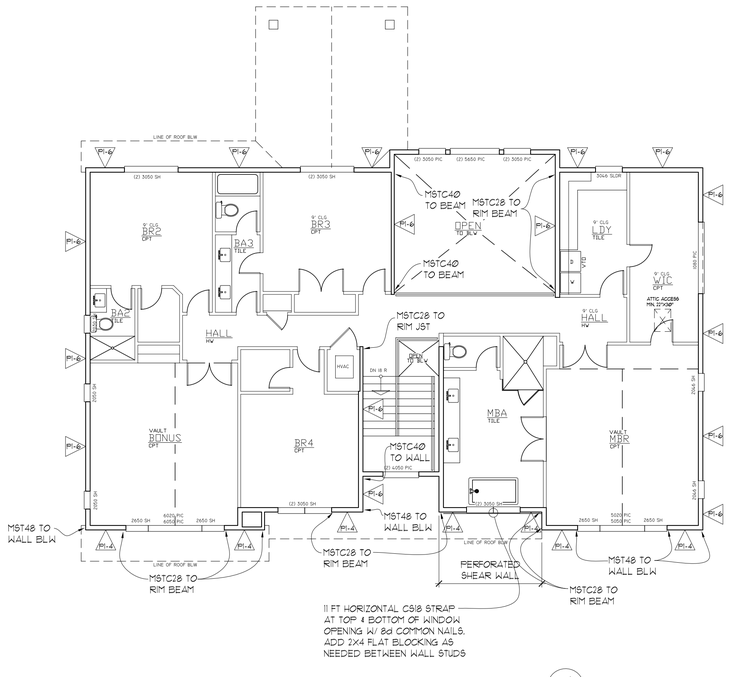

UPPER FLOOR SHEAR WALL KEY PLAN
SCALE: 1/8"=1'-0"

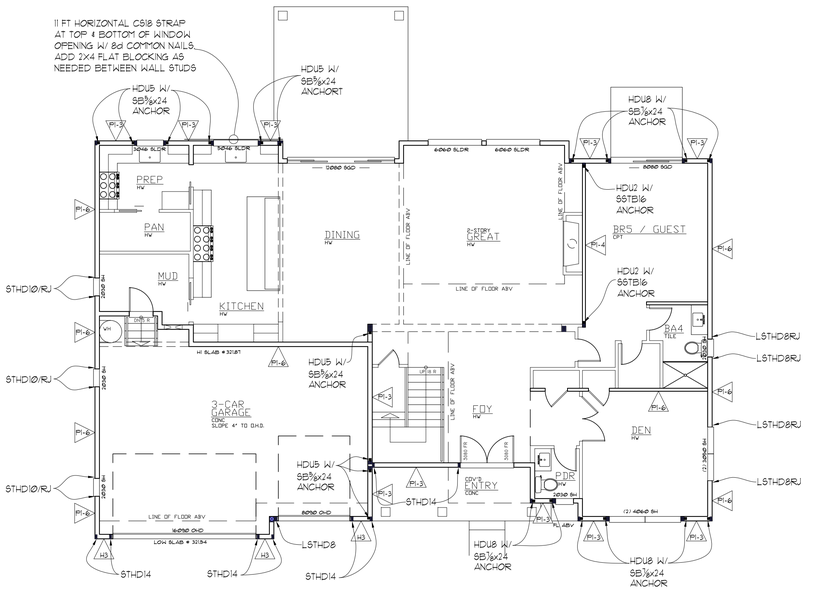

MAIN FLOOR SHEAR WALL KEY PLAN
SCALE: 1/8"=1'-0"

STRUCTURAL PLANS

PLAN M4551A3F-0
4025 85th AVE SE
MERCER ISLAND, WA

Myers Engineering, LLC
3206 50th Street Court, Ste. 210-B
Gig Harbor, WA 98335
Ph: 253-858-3248
Email: myengineer@centurytel.net

MARK R. MYERS STATE OF WASHINGTON 22615 REGISTERED PROFESSIONAL ENGINEER

Digitally signed by Mark Myers
Date: 2025.04.22 14:03:13 -07'00'

BUILDING DEPT. APPROVAL STAMPS:

REVISION:	INIT:	DATE:

S1

DATE: 4-22-2025
INIT: MM
PROJECT #: 2608

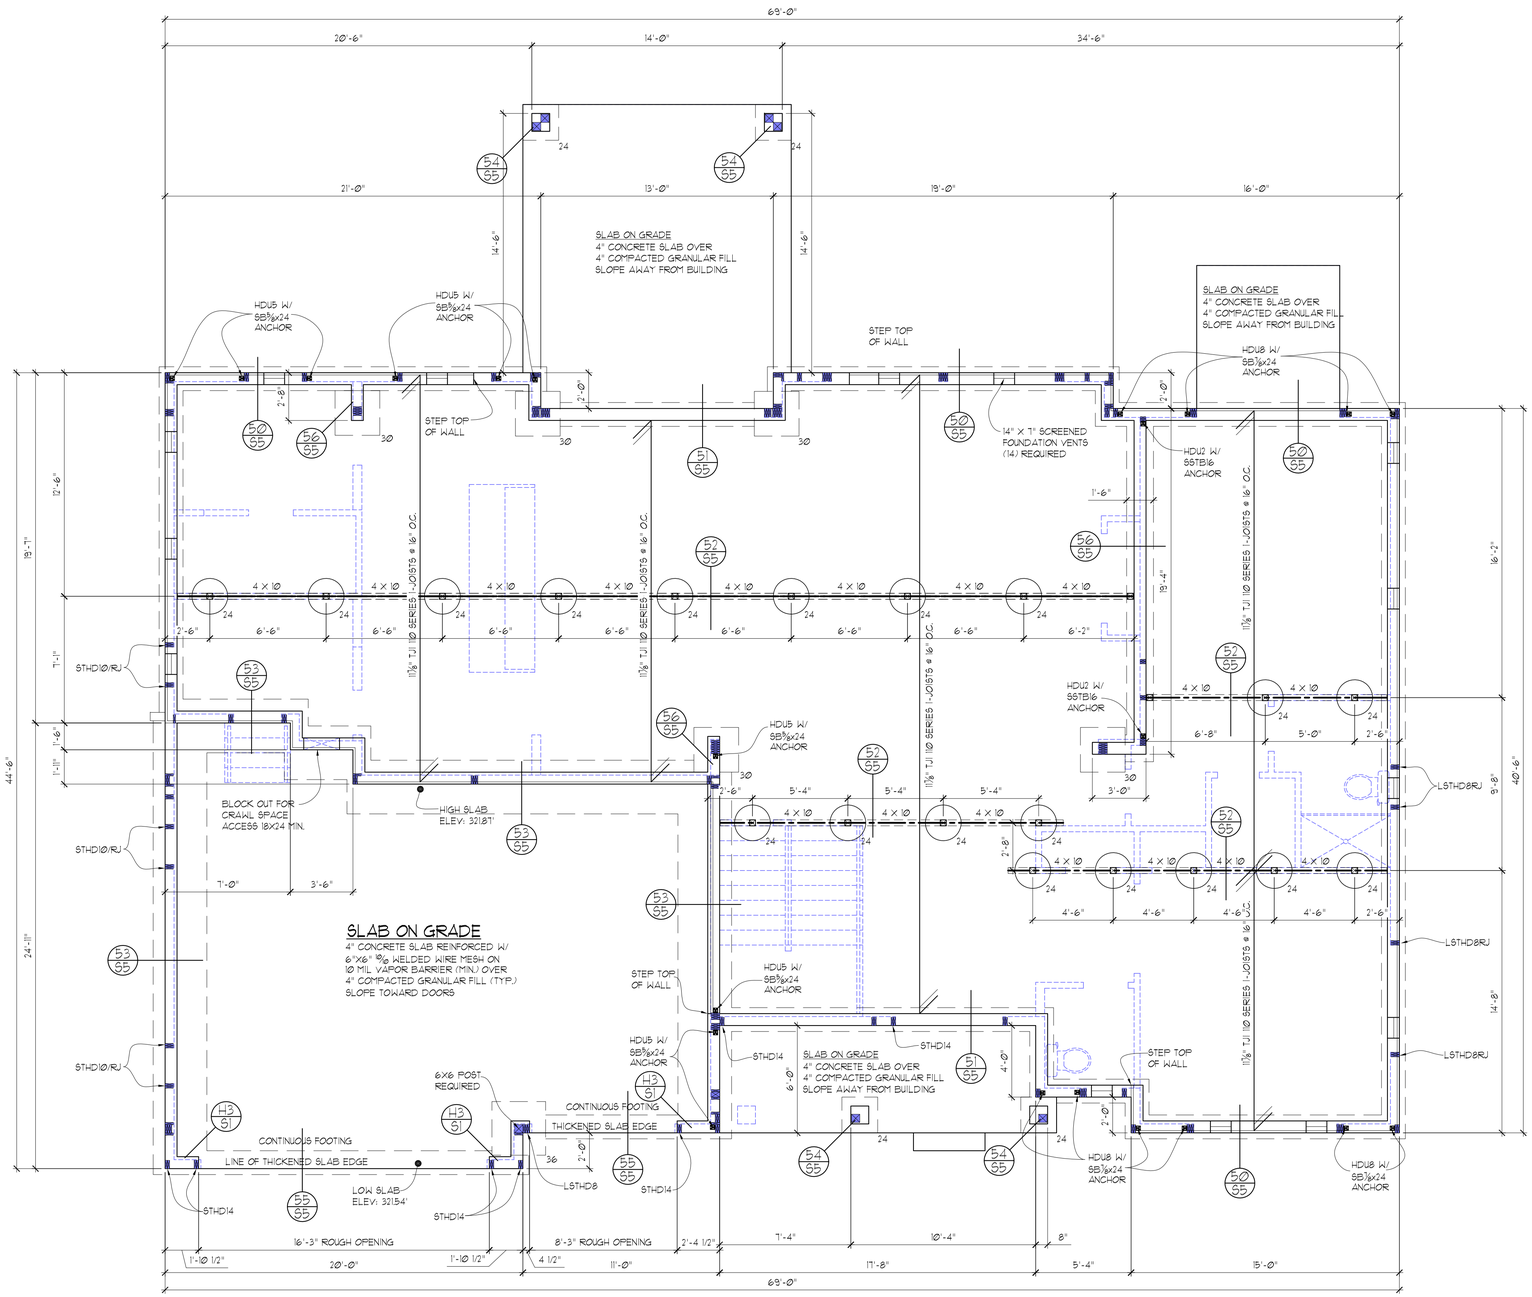

FOOTING SCHEDULE

NOTE: USE MIN. 6" WIDE POST BELOW BEAM SPLICES
USE P.T. 4 X 4 POSTS BELOW 4 X BEAMS U.N.O.
USE P.T. 6 X 6 POST BELOW 6 X BEAMS U.N.O.

24	P.T. POST ON 24" DIA. X 10" THICK PLAIN CONC. FOOTING
24	P.T. POST ON 24" X 24" X 10" THICK CONC. FOOTING W/ 2- # 4 BARS EACH WAY
30	P.T. POST ON 30" X 30" X 12" THICK CONC. FOOTING W/ 3- # 5 BARS EACH WAY
36	P.T. POST ON 36" X 36" X 12" THICK CONC. FOOTING W/ 3- # 5 BARS EACH WAY
42	P.T. POST ON 42" X 42" X 12" THICK CONC. FOOTING W/ 4- # 5 BARS EACH WAY

FOOTING SIZES BASED ON 3000 PSF SOIL BEARING CAPACITY

FOUNDATION/FLOOR FRAMING PLAN

SCALE : 1/4"= 1'-0"

- ALL WOOD IN CONTACT WITH CONCRETE TO BE PRESSURE TREATED
- SOFFIT, VENT, AND INSULATE ALL CANTILEVERED AREAS
- PROVIDE SOLID BLOCKING OVER SUPPORTS
- ALL FOOTINGS TO REST ON UNDISTURBED SOIL
- PROVIDE COPY OF CONCRETE "BATCH TICKET" ON SITE FOR REVIEW BY BUILDING OFFICIAL
- PROVIDE SOLID FRAMING EQUAL TO THE WIDTH OF THE MEMBER BEING SUPPORTED (U.N.O.)
- PROVIDE SUPPLEMENTAL BLOCKING IN FLOOR CAVITY BELOW SUPPORT POSTS FOR GIRDERS, BEAMS, AND END POSTS FOR SHEAR WALLS TO MATCH FULL WIDTH OF POSTS IN WALL ABV. W/ GRAIN ORIENTED VERTICALLY

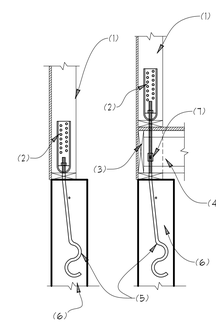

1. DBL 2X STUDS MINIMUM AT HOLDOWN UNLES NOTED OTHERWISE
2. ANCHOR BOLT STYLE HOLDOWN PER PLAN INSTALLED PER MANUF. SPECS.
3. RIM BOARD PER PLAN
4. PROVIDE SQUASH BLOCKS IN FLOOR CAVITY TO MATCH POST IN SHEAR WALL. GRAIN ORIENTED VERTICALLY
5. ANCHOR BOLT INSTALLED PER MANUF. SPECS. (SEE BELOW FOR SIZE PER HOLDOWN) MAINTAIN 5" CLEARANCE FROM ENDTN VENTS.
6. CONCRETE STEM WALL PER PLAN
7. EXTEND ANCHOR BOLT W/ COUPLER NUT & ALL THREAD ROD

ANCHOR	EMBED.
SSTB16 (DIA. = 5/8")	12 5/8"
SSTB20 (DIA. = 5/8")	16 5/8"
SSTB24 (DIA. = 5/8")	20 5/8"
SSTB28 (DIA. = 7/8")	24 1/8"
SSTB34, SSTB36 (DIA. = 7/8")	28 1/8"
SB7/8x24, SB7/8x24	18"
SBI/x30	24"

H4 TYPICAL ANCHOR BOLT HOLDOWN
SCALE: 3/4"=1'

STRUCTURAL PLANS

PLAN M4551A3F-0
4025 85th AVE SE
MERCER ISLAND, WA

Myers Engineering, LLC
3206 50th Street Court, Ste. 210-B
Gig Harbor, WA 98335
Ph: 253-858-3248
Email: myengineer@centurytel.net

MARK R. MYERS — STATE OF WASHINGTON — 19178 — REGISTERED PROFESSIONAL ENGINEER

Digitally signed by Mark Myers
Date: 2025.04.22 14:01:56 -07'00'

BUILDING DEPT. APPROVAL STAMPS:

REVISION:	INIT:	DATE:

S2

DATE: 4-22-2025
INIT: MM
PROJECT #: 2608

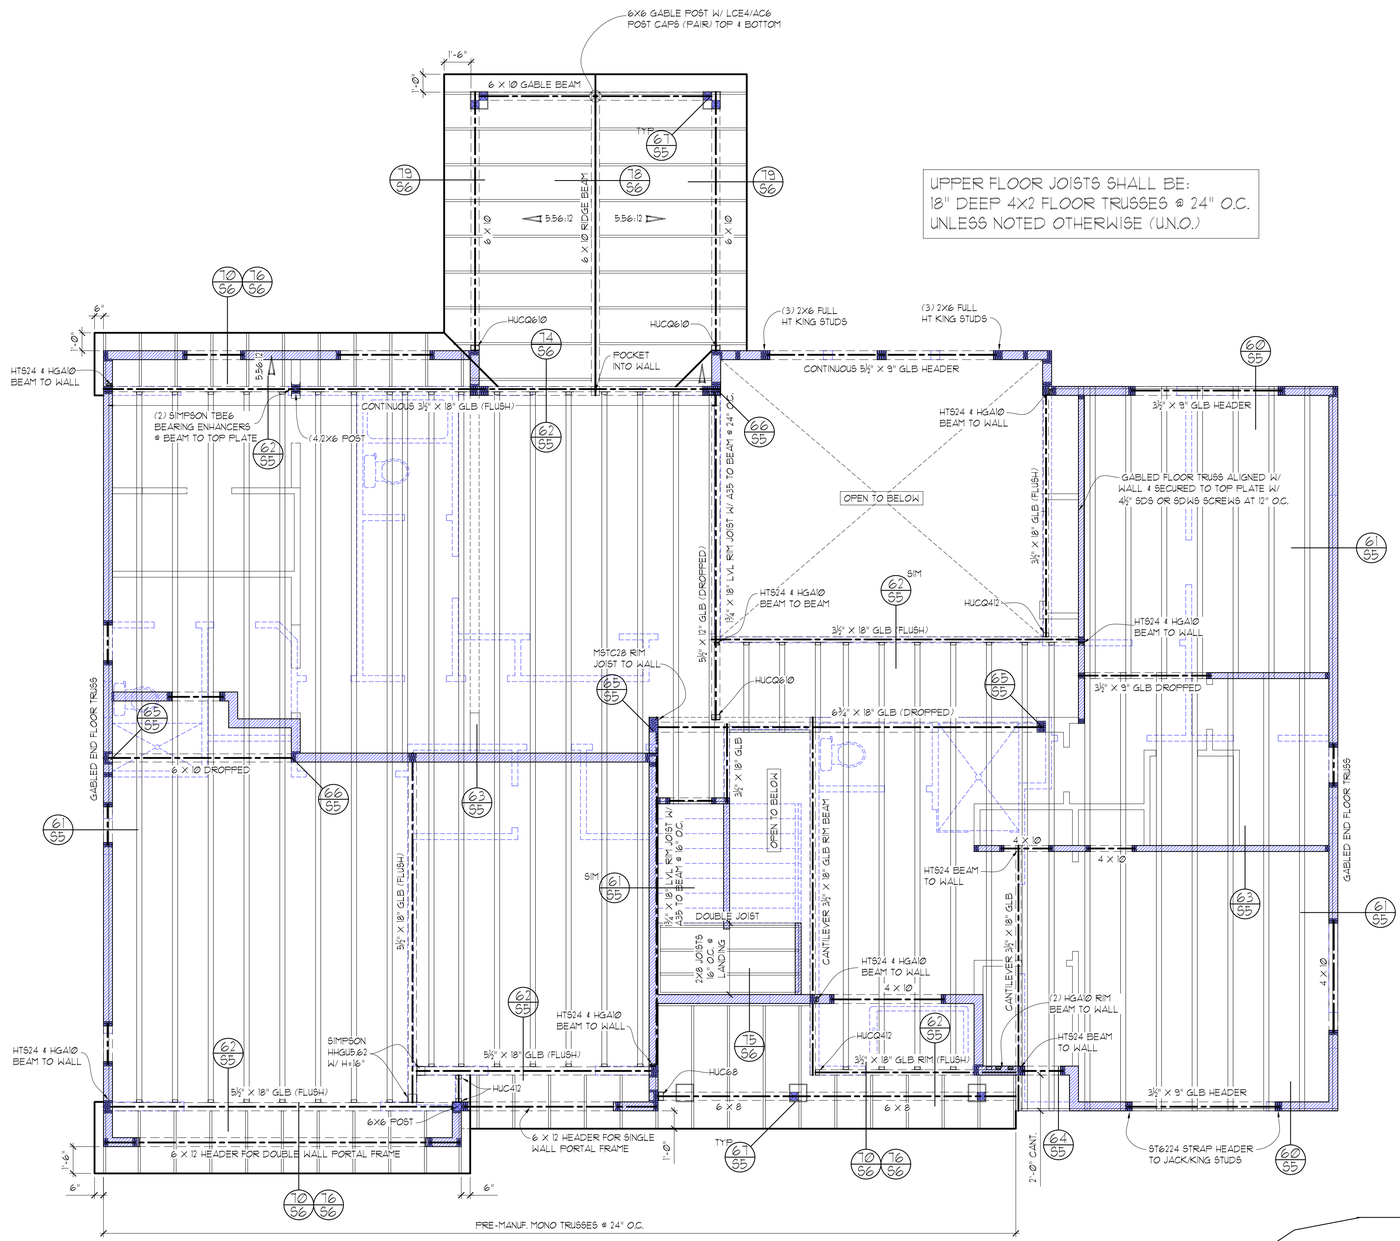

UPPER FLOOR FRAMING PLAN

SCALE : ¼"= 1'-0"

- SOFFIT, VENT, AND INSULATE ALL CANTILEVERED AREAS
- EXTERIOR WALLS TO BE 2X6 AT 16" O.C., U.N.O.
- ALL DOOR/WINDOW HEADERS AT THIS LEVEL TO BE 4X10 DF #2 AT BEARING WALLS , U.N.O., 6'-0" MAX. SPAN
- INTERIOR PARTITIONS TO BE 2X4 AT 16" O.C. (2X6 @ PLUMBING WALLS) U.N.O.
- HEADERS 8FT OR LONGER SHALL BE PROVIDED W/ (2) TRIMMER (JACK) STUDS AT EACH END U.N.O.
- ☒ PROVIDE SOLID FRAMING EQUAL TO THE WIDTH OF THE MEMBER BEING SUPPORTED (U.N.O.)
- PROVIDE SUPPLEMENTAL BLOCKING IN FLOOR CAVITY BELOW SUPPORT POSTS FOR GIRDERS, BEAMS, AND END POSTS FOR SHEAR WALLS TO MATCH FULL WIDTH OF POSTS IN WALL ABV. W/ GRAIN ORIENTED VERTICALLY AND PROVIDE MATCHING POSTS IN WALL BELOW UNLESS LARGER POSTS ARE SPECIFIED ON PLAN
- RAILINGS AND POSTS FOR GUARDS AT STAIR OPENINGS SHALL RESIST 200 LB LOAD IN ANY DIRECTION APPLIED AT TOP. INFILL PICKETS SHALL RESIST 50 LB LOAD OVER 1 SQ FT AT ANY LOCATION. MANUFACTURER SPECIFICATIONS FOR PROPRIETARY GUARD/RAILING SYSTEMS SHALL BE ON SITE FOR INSPECTION.

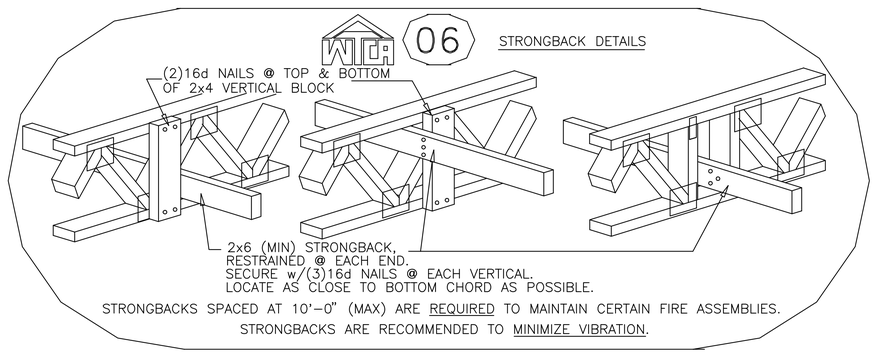

STRUCTURAL PLANS

PLAN M4551A3F-0
4025 85th AVE SE
MERCER ISLAND, WA

Myers Engineering, LLC
3206 50th Street Court, Ste. 210-B
Gig Harbor, WA 98335
Ph: 253-858-3248
Email: myengineer@centurytel.net

MARK R MYERS
STATE OF WASHINGTON
STATE REGISTERED PROFESSIONAL ENGINEER

Digitally signed by Mark Myers
Date: 2025.04.22 14:00:43 -07'00'

BUILDING DEPT. APPROVAL STAMPS:

REVISION:	INIT:	DATE:

S3

DATE: 4-22-2025
INIT: MM
PROJECT #: 2608

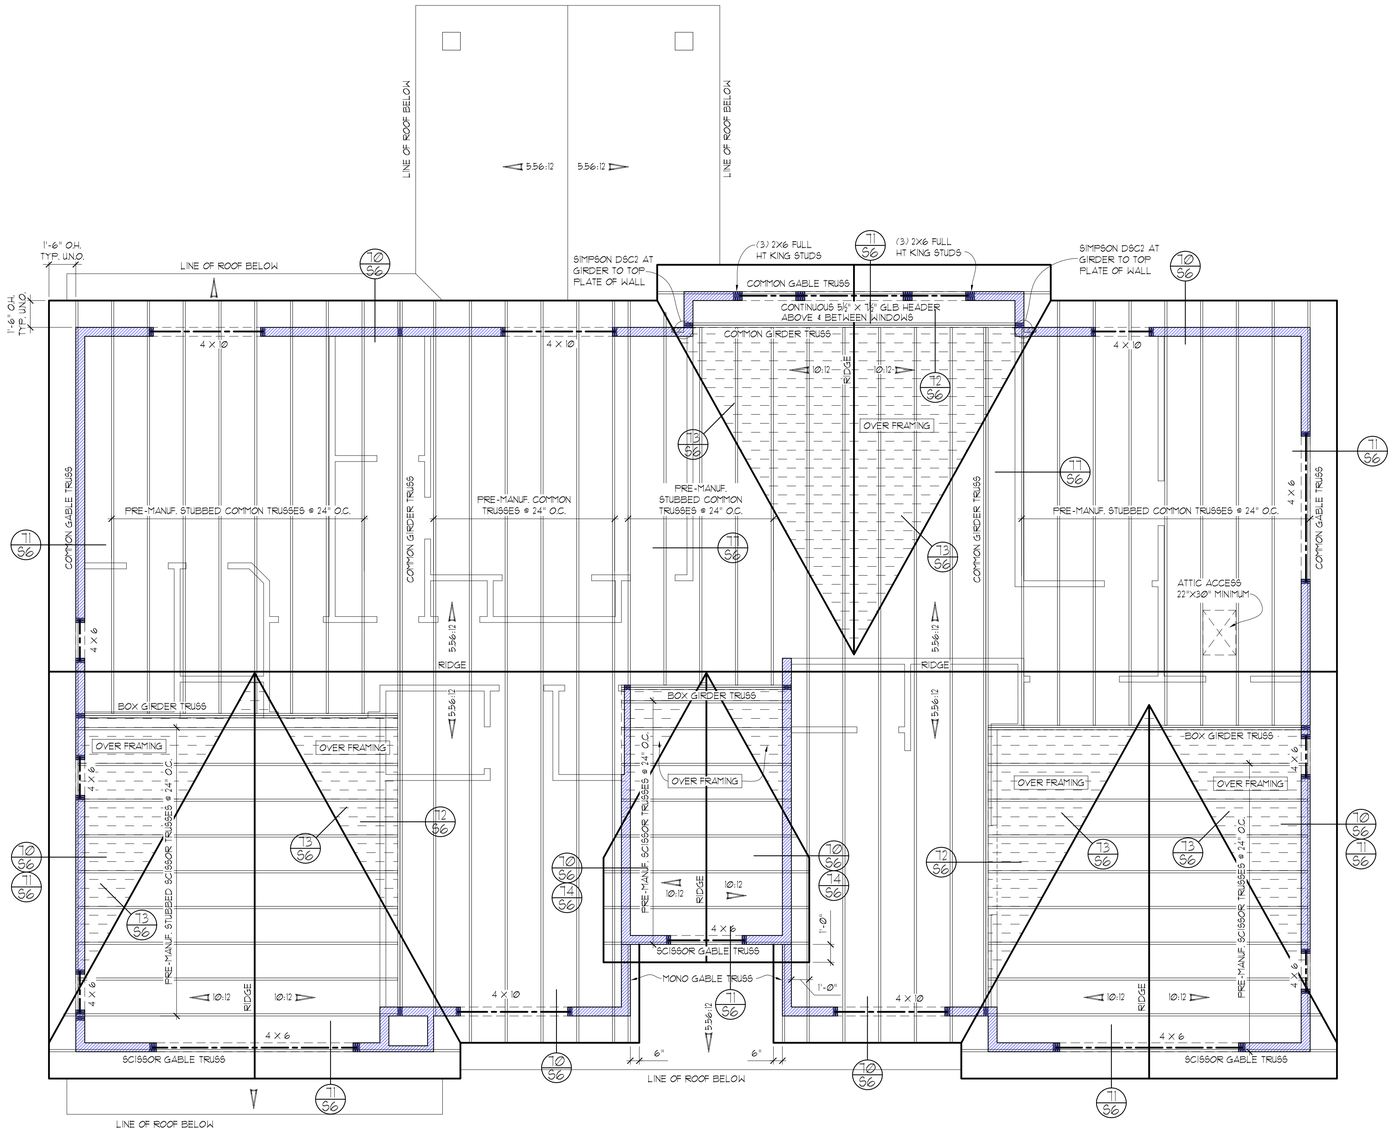

ROOF FRAMING PLAN

SCALE : ¼"= 1'-0"

- PROVIDE VENTED BLOCKING AT REQUIRED TRUSS/RAFTER BAYS
- ALL MANUFACTURED TRUSSES:
  - * SHALL HAVE DESIGN DETAILS AND DRAWINGS ON SITE FOR FRAMING INSPECTION
  - * SHALL NOT BE FIELD ALTERED WITHOUT ENGINEER'S APPROVAL
  - * SHALL BE INSTALLED AND BRACED TO MANUFACTURER'S SPECIFICATION
  - * SHALL CARRY MANUFACTURER'S STAMP ON EACH TRUSS
- ALL BEAMS AND HEADERS AT THIS LEVEL TO BE 4X10 DF #2 AT BEARING WALLS, U.N.O., 6'-0" MAX. SPAN
- HEADERS 8FT OR LONGER SHALL BE PROVIDED W/ (2) TRIMMER (JACK) STUDS AT EACH END U.N.O.
- ☒ PROVIDE SOLID FRAMING EQUAL TO THE WIDTH OF THE MEMBER BEING SUPPORTED (U.N.O.)
- PROVIDE SUPPLEMENTAL BLOCKING IN FLOOR CAVITY BELOW SUPPORT POSTS FOR GIRDERS, BEAMS, AND END POSTS FOR SHEAR WALLS TO MATCH FULL WIDTH OF POSTS IN WALL ABV. W/ GRAIN ORIENTED VERTICALLY AND PROVIDE MATCHING POSTS IN WALL BELOW UNLESS LARGER POSTS ARE SPECIFIED ON PLAN

STRUCTURAL PLANS

PLAN M4551A3F-0
4025 85th AVE SE
MERCER ISLAND, WA

Myers Engineering, LLC
3206 50th Street Court, Ste. 210-B
Gig Harbor, WA 98335
Ph: 253-858-3248
Email: myengineer@centurytel.net

MARK R. MYERS STATE OF WASHINGTON 19774 REGISTERED PROFESSIONAL ENGINEER

Digitally signed by Mark Myers
Date: 2025.04.22 13:46:03 -07'00'

BUILDING DEPT. APPROVAL STAMPS:

REVISION:	INIT:	DATE:

S4

DATE: 4-22-2025
INIT: MM
PROJECT #: 2608

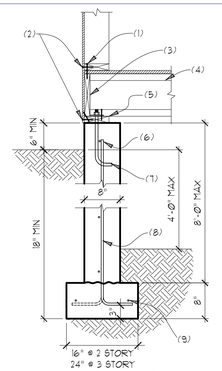

1. BASE PLATE NAILING PER SHEAR WALL SCHEDULE
2. SHEAR WALL EDGE NAILING PER SHEAR WALL SCHEDULE
3. SOLID CONTINUOUS RIM BOARD TOE NAILED TO SILL W/ 8d NAILS @ 6" O.C. SECURE RIM TO EACH JOIST W/ (3) 8d NAILS
4. FLOOR JOIST PER PLAN SECURED TO SILL PLATE W/ (2) 8d NAILS
5. 2X PRESSURE TREATED SILL PLATE U.N.O. IN SHEAR WALL SCHEDULE
6. #4 REBAR HORIZ. @ 12" O.C. W/ (1) #4 REBAR IN UPPER 3" TO 5"
7. 5/8" DIA. ANCHOR BOLT @ 72" O.C. U.N.O. IN SHEAR WALL SCHEDULE W/ 7" MIN. EMBEDMENT
8. #4 VERTICALS @ 48" O.C. W/ STANDARD HOOK REQUIRED, ALTERNATE BENDS, NO WET SETTING PERMITTED
9. (2) #4 REBAR CONTINUOUS IN FOOTING

50 8" FOUNDATION STEM WALL
SCALE: 3/4"=1'

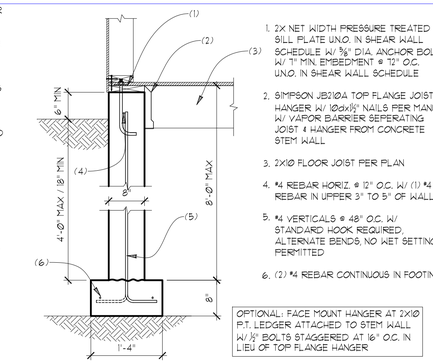

1. 2X NET WIDTH PRESSURE TREATED SILL PLATE U.N.O. IN SHEAR WALL SCHEDULE W/ 5/8" DIA. ANCHOR BOLT W/ 7" MIN. EMBEDMENT @ 72" O.C. U.N.O. IN SHEAR WALL SCHEDULE
2. SIMPSON JB2I0A TOP FLANGE JOIST HANGER W/ I0dx1½" NAILS PER MANUF. W/ VAPOR BARRIER SEPERATING JOIST & HANGER FROM CONCRETE STEM WALL
3. 2X10 FLOOR JOIST PER PLAN
4. #4 REBAR HORIZ. @ 12" O.C. W/ (1) #4 REBAR IN UPPER 3" TO 5" OF WALL
5. #4 VERTICALS @ 48" O.C. W/ STANDARD HOOK REQUIRED, ALTERNATE BENDS, NO WET SETTING PERMITTED
6. (2) #4 REBAR CONTINUOUS IN FOOTING

OPTIONAL: FACE MOUNT HANGER AT 2X10 P.T. LEDGER ATTACHED TO STEM WALL W/ ½" BOLTS STAGGERED AT 16" O.C. IN LIEU OF TOP FLANGE HANGER

51 8" STEM WALL AT DROPPED JOISTS
SCALE: 3/4"=1'

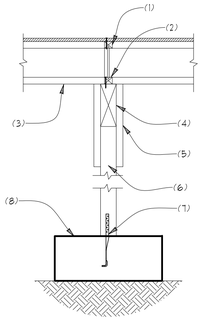

1. I-JOIST BLOCKING REQUIRED AT BEARING OR SHEAR WALLS ABOVE OR WHEN JOISTS ARE NOT CONTINUOUS AT BEAM
2. SECURE BLOCKING TO BEAM W/ 8d NAILS @ 6" O.C.
3. I-JOIST PER PLAN
4. BEAM PER PLAN
5. 2X OR SHEATHING CLEATS BOTH SIDES TO SECURE BEAM TO POST (3) I0d NAILS PER CLEAT PER MEMBER
6. 4X OR 6X TREATED POST (4X6 MIN AT BEAM SPLICE)
7. SIMPSON MABI5 ANCHOR W/ I0dx1½" COMMON NAILS (0.148"x1.5") TO POST
8. ISOLATED OR CONTINUOUS SPREAD FOOTING PER PLAN

52 INTERIOR FOOTING @ BEAM LINE
SCALE: 3/4"=1'

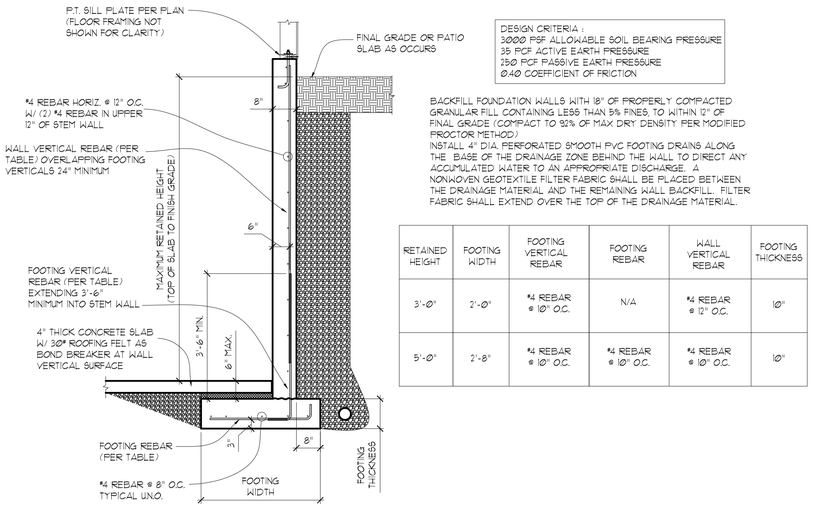

DESIGN CRITERIA :
3000 PSF ALLOWABLE SOIL BEARING PRESSURE
35 PCF ACTIVE EARTH PRESSURE
250 PCF PASSIVE EARTH PRESSURE
0.40 COEFFICIENT OF FRICTION

BACKFILL FOUNDATION WALLS WITH 18" OF PROPERLY COMPACTED GRANULAR FILL CONTAINING LESS THAN 5% FINES, TO WITHIN 12" OF FINAL GRADE (COMPACT TO 92% OF MAX DRY DENSITY PER MODIFIED PROCTOR METHOD)
INSTALL 4" DIA. PERFORATED SMOOTH PVC FOOTING DRAINS ALONG THE BASE OF THE DRAINAGE ZONE BEHIND THE WALL TO DIRECT ANY ACCUMULATED WATER TO AN APPROPRIATE DISCHARGE. A NONWOVEN GEOTEXTILE FILTER FABRIC SHALL BE PLACED BETWEEN THE DRAINAGE MATERIAL AND THE REMAINING WALL BACKFILL. FILTER FABRIC SHALL EXTEND OVER THE TOP OF THE DRAINAGE MATERIAL.

RETAINED HEIGHT	FOOTING WIDTH	FOOTING VERTICAL REBAR	FOOTING REBAR	WALL VERTICAL REBAR	FOOTING THICKNESS
3'-0"	2'-0"	#4 REBAR @ 10" O.C.	N/A	#4 REBAR @ 12" O.C.	10"
5'-0"	2'-8"	#4 REBAR @ 10" O.C.	#4 REBAR @ 10" O.C.	#4 REBAR @ 10" O.C.	10"

53 CANTILEVER RETAINING WALL
SCALE: 1/2"=1'

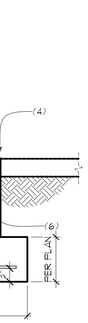

1. WOOD POST W/ ARCHITECTURAL COVER PER PLAN
2. SIMPSON ABUZ OR CPTZ POST BASE WITH CAST IN PLACE OR EPOXIED ANCHOR PER MANUF. SPECS.
3. FINISHED GRADE OR SLAB AS OCCURS
4. OPTIONAL 12" DIA OR SQUARE CONCRETE PEDESTAL
5. (4) #4 VERTICALS W/ STANDARD HOOK AT CONCRETE PEDESTAL
6. #3 TIES AT 8" O.C.
7. ISOLATED OR CONTINUOUS FOOTING PER PLAN

54 FOOTING AT WOOD COLUMN
SCALE: 3/4"=1'

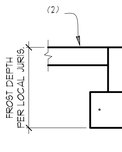

1. 4" CONCRETE SLAB PER PLAN W/ THICKENED EDGE AT DOOR OPENING
2. FINISH GRADE OR SLAB AS OCCURS
3. (2) #4 REBAR IN CONTINUOUS FOOTING
4. 4" COMPACTED GRANULAR FILL

55 THICKENED SLAB EDGE AT GARAGE
SCALE: 3/4"=1'

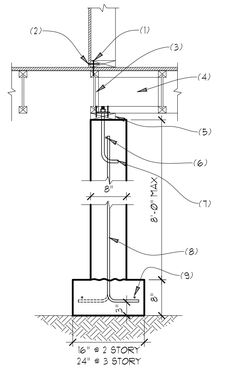

1. BASE PLATE NAILING PER SHEAR WALL SCHEDULE
2. SHEAR WALL EDGE NAILING PER SHEAR WALL SCHEDULE
3. I-JOIST NAILED TO SILL W/ 8d NAILS @ 6" O.C.
4. FLOOR JOIST BLOCKING AT FLOOR SHEATHING PANEL EDGES (48" O.C.) SECURED TO SILL PLATE W/ (2) 8d NAILS
5. 2X PRESSURE TREATED SILL PLATE U.N.O. IN SHEAR WALL SCHEDULE
6. #4 REBAR HORIZ. @ 12" O.C. W/ (1) #4 REBAR IN UPPER 3" TO 5"
7. 5/8" DIA. ANCHOR BOLT @ 72" O.C. U.N.O. IN SHEAR WALL SCHEDULE W/ 7" MIN. EMBEDMENT
8. #4 VERTICALS @ 48" O.C. W/ STANDARD HOOK REQUIRED, ALTERNATE BENDS, NO WET SETTING PERMITTED
9. (2) #4 REBAR CONTINUOUS IN FOOTING

56 8" FOUNDATION STEM WALL
SCALE: 3/4"=1'

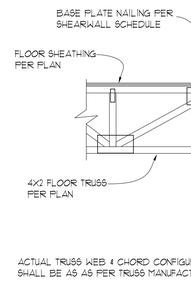

ACTUAL TRUSS WEB & CHORD CONFIGURATION SHALL BE AS AS PER TRUSS MANUFACTURER

60 4X2 TRUSS AT EXTERIOR WALL
SCALE: 3/4"=1'

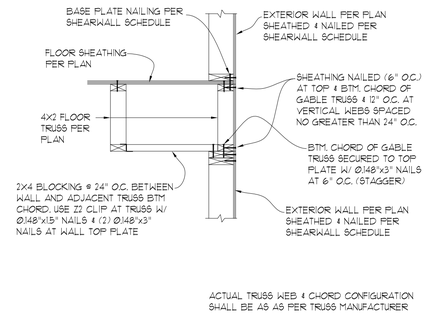

ACTUAL TRUSS WEB & CHORD CONFIGURATION SHALL BE AS AS PER TRUSS MANUFACTURER

61 4X2 GABLED TRUSS
SCALE: 3/4"=1'

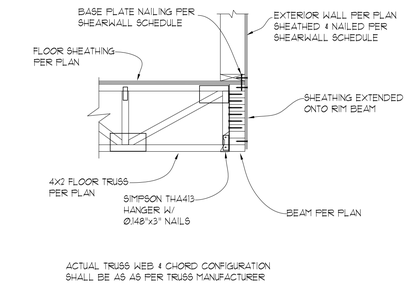

ACTUAL TRUSS WEB & CHORD CONFIGURATION SHALL BE AS AS PER TRUSS MANUFACTURER

62 4X2 TRUSS W/ HANGER AT RIM BEAM
SCALE: 3/4"=1'

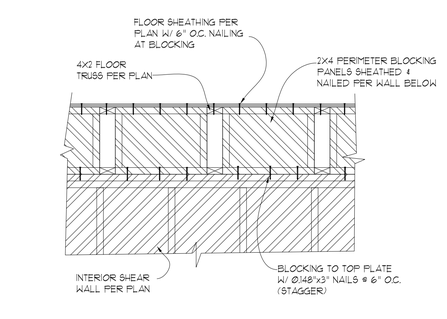

63 TRUSS BLOCKING @ INT. WALL
SCALE: 3/4"=1'

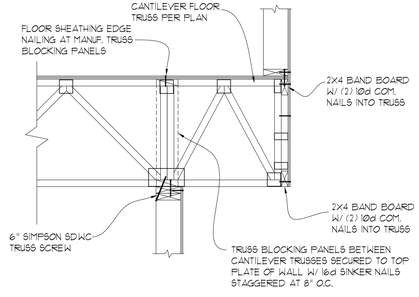

64 CANTILEVER FLOOR TRUSS BEARING
SCALE: 3/4"=1'

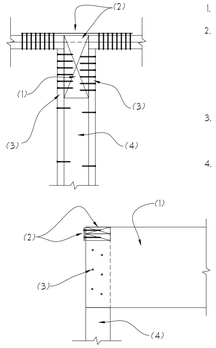

1. BEAM PER PLAN
2. NOTCH BEAM FOR CONTINUOUS TOP 2X PLATE OF DOUBLE 2X PLATE OR INSTALL SIMPSON CMSTC16 OR MSTC28 STRAP ON TOP FACE OR EXTERIOR FACE OF DISCONTINUOUS PLATES W/ MINIMUM (8) 16d SINKER NAILS EACH SIDE OF BREAK IN TOP PLATE.
3. KING STUD W/ (6)-16d SINKER NAILS TO BEAM (STAGGERED) EACH SIDE AT BEAM & 8" O.C. STAGGERED TO POST
4. SOLID POST TO MATCH WIDTH OF BEAM OR BUILT UP 2X STUDS W/ PLYWOOD OR OSB FILLER AS NEEDED. (NAIL PLIES OF BUILT UP 2X POST WITH I0d COMMON NAILS @ 12" O.C. (STAGGERED)

65 BEAM POCKET AT WALL
SCALE: 3/4"=1'

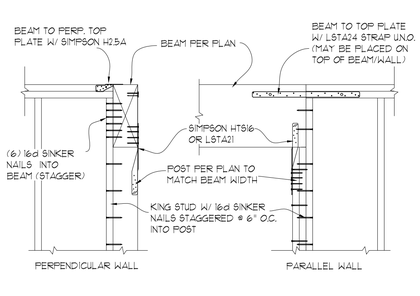

66 BEAM POCKET AT CORNER
SCALE: 3/4"=1'

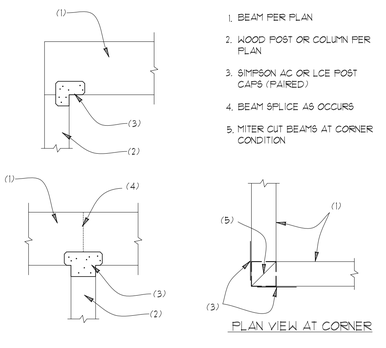

1. BEAM PER PLAN
2. WOOD POST OR COLUMN PER PLAN
3. SIMPSON AC OR LCE POST CAPS (PAIRED)
4. BEAM SPLICE AS OCCURS
5. MITER CUT BEAMS AT CORNER CONDITION

67 WOOD BEAM AT WOOD POST
SCALE: 3/4"=1'

STRUCTURAL PLANS

PLAN M4551A3F-0
4025 85th AVE SE
MERCER ISLAND, WA

Myers Engineering, LLC
3206 50th Street Court, Ste. 210-B
Gig Harbor, WA 98335
Ph: 253-858-3248
Email: myengineer@centurytel.net

MARK R. MYERS — STATE OF WASHINGTON — 19792 — REGISTERED PROFESSIONAL ENGINEER

Digitally signed by Mark Myers
Date: 2025.04.22 13:44:51 -07'00'

BUILDING DEPT. APPROVAL STAMPS:

REVISION:	INIT:	DATE:

S5

DATE: 4-22-2025
INIT: MM
PROJECT #: 2608

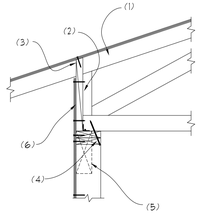

1. RAISED HEEL TRUSS W/ ROOF SHEATHING PER PLAN
2. 2X12 OR 1¾" LSL OR PRE-MANUF TRUSS BLOCKING W/ SIMPSON A35 FRAMING ANGLE TO TOP PLATE
3. ROOF DIAPHRAGM EDGE NAILING
4. 6" SIMPSON SDWC TRUSS SCREW AT EACH TRUSS INSTALLED PER MANUFACTURER'S SPECS.
5. STUD WALL OR BEAM PER PLAN
6. WALL SHEATHING CONTINUOUS TO UNDERSIDE OF TRUSS CHORD

70 RAISED HEEL ROOF TRUSS AT BEARING
SCALE: ¾"=1'

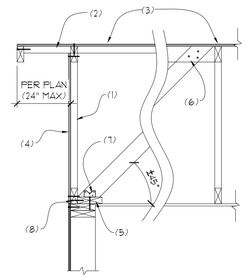

1. GABLE END TRUSS W/ VERTICALS @ 24" O.C. & TOP CHORD DESIGNED TO BE NOTCHED FOR OUTRIGGERS.
2. 2x4 FLAT OUTRIGGER @ 48" O.C. W/ FASCIA BOARD (1X MIN.) SECURED TO ENDS W/ (2) 10d NAILS
3. ROOF SHEATHING AT 24" O.C. ROOF TRUSSES W/ DIAPHRAGM EDGE NAILING TO GABLE TRUSS
4. FULLY SHEATH GABLE END TRUSS W/ EXTERIOR WALL SHEATHING PER PLAN W/ EDGE NAILING AT TOP & BOTTOM CHORD
5. 2x6 CONTINUOUS BACKER BOARD SECURED TO TOP PLATE W/ 10d NAILS @ 6" O.C.
6. 2X6 DIAGONAL BRACE @ 8FT O.C. SECURED AT UPPER END TO 2X4 BLOCKING W/ (3) 10d NAILS
7. SIMPSON A34 AT 2X6 DIAGONAL BRACE TO 2X6 BACKER BOARD
8. ATTACH GABLE TRUSS TO BACKER BOARD W/ 10d NAILS @ 6" O.C.

71 GABLE END TRUSS
SCALE: ¾"=1'

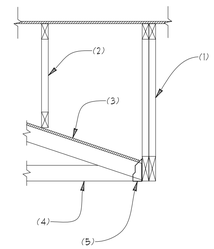

1. GIRDER TRUSS PER PLAN
2. VALLEY TRUSSES OR CONVENTIONAL OVER FRAMING. WHERE VALLEY TRUSSES ARE USED SECURE VALLEY TRUSS TO SUPPORTING ROOF FRAMING W/ SIMPSON VTCR CLIPS @ 48" O.C.
3. ROOF SHEATHING CONTINUOUS BELOW OVERFRAMING. TRUSS TOP CHORDS W/O SHEATHING SHALL BE BRACED W/ 2x4 @ 24" O.C. ATTACHED W/ (2) 10d NAILS PER TRUSS
4. ROOF TRUSS PER PLAN
5. SIMPSON HUS26 OR USP THD26 FACE MOUNT HANGER U.N.O. PER TRUSS MANUF.

72 GIRDER TRUSS AT OVERFRAMING
SCALE: ¾"=1'

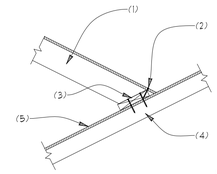

1. CONVENTIONAL 2x OVER FRAMING @ 24" O.C. W/ (4) 16d TOE NAILS TO VALLEY PLATE (SEE BELOW FOR RECOMMENDED SIZES BASED ON SPAN)
2. EDGE NAILING
3. 2x VALLEY BOARD TO MATCH RAFTER W/ (2) 16d NAILS PER TRUSS
4. ROOF TRUSS TOP CHORD OR RAFTER PER PLAN
5. CONTINUOUS SHEATHING BENEATH OVERFRAMING OR 2x4 BRACING @ 24" O.C. W/ 2-16d NAILS PER TRUSS.

FOR RAFTER SPANS BELOW USE THE FOLLOWING SIZES:

0'-0" TO 6'-7"	2x4
6'-8" TO 9'-7"	2x6
9'-8" TO 12'-2"	2x8
12'-3" TO 14'-10"	2x10
14'-11" TO 17'-3"	2x12

(ASSUMES RAFTERS @ 24" O.C. LL=30PSF & DL=10PSF PER TABLE R802.5.1(3) FOR HF #2)

73 VALLEY FRAMING
SCALE: ¾"=1'

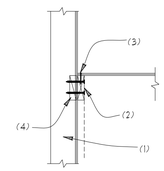

1. EXTERIOR STUD WALL PER PLAN
2. RAFTER, TRUSS TOP CHORD, OR 2X6 LEDGER SECURED TO WALL W/ (2) 4" SIMPSON SDWS SCREWS PER WALL STUD (16" O.C.)
3. ROOF DIAPHRAGM EDGE NAILING PER PLAN
4. 2X6 BLOCKING BETWEEN STUDS

74 ROOF DIAPHRAGM TO WALL
SCALE: ¾"=1'

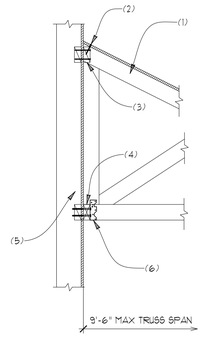

1. TRUSS W/ ROOF SHEATHING PER PLAN TO BEAR ON LEDGER
2. EDGE NAILING
3. 2x BLOCKING ATTACHED W/ (2) 16d NAILS PER STUD
4. CONTINUOUS 2x LEDGER W/ (2) ½"x4" LAG SCREWS PER STUD
5. 2x STUD WALL PER PLAN (STUDS @ 16" O.C.)
6. SIMPSON A35 FRAMING ANGLE AT EACH TRUSS

75 MONO TRUSS TO WALL
SCALE: ¾"=1'

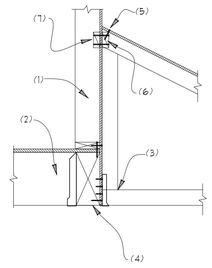

1. 2x STUD WALL W/ EXTERIO WALL SHEATHING PER PLAN
2. FLOOR FRAMIN G POER PLAN
3. JACK/MONO TRUSS PER PLAN W/ LUS HANGER TO RIM
4. BEAM PER PLAN
5. ROOF DIAPHRAGM EDGE NAILING PER PLAN
6. 2X BLOCKING BETWEEN TRUSSES ATTACHED TO WALL W/ 10d NAILS STAGGERED AT 6" O.C.
7. 2X BLOCKING BETWEEN STUDS

76 MONO TRUSS TO WALL AT BEAM
SCALE: ¾"=1'

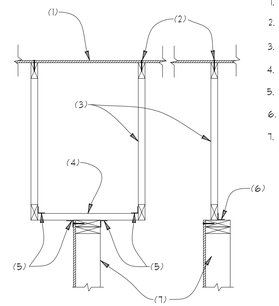

1. ROOF SHEATHING PER PLAN
2. EDGE NAILING WHERE APPLIES
3. ROOF TRUSSES PER PLAN
4. 2x6 FLAT BLOCKING @ 12" O.C.
5. SIMPSON A35 AT EACH BLOCK
6. SIMPSON A35 @ 12" O.C.
7. INTERIOR SHEAR WALL PER PLAN

77 ROOF SHEAR TRANSFER @ INT. WALL
SCALE: ¾"=1'

1. EDGE NAILING
2. 2x RAFTER W/ ROOF SHEATHING PER PLAN
3. BEAM PER PLAN
4. SIMPSON LRU RAFTER HANGER

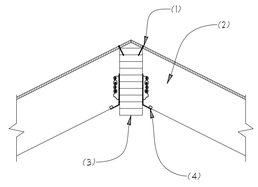

78 RAFTERS AT RIDGE BEAM
SCALE: ¾"=1'

1. 2x RAFTER W/ ROOF SHEATHING PER PLAN
2. EDGE NAILING
3. 2x BLOCKING TOE NAILED TO TOP PLATE W/ (3) 8d NAILS
4. SIMPSON H2.5A CLIP AT EACH RAFTER
5. 2x STUD WALL OR BEAM PER PLAN

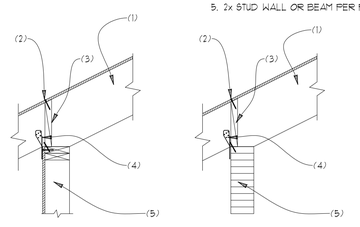

79 RAFTER AT WALL
SCALE: ¾"=1'

STRUCTURAL PLANS

PLAN M4551A3F-0
4025 85th AVE SE
MERCER ISLAND, WA

Myers Engineering, LLC
3206 50th Street Court, Ste. 210-B
Gig Harbor, WA 98335
Ph: 253-858-3248
Email: myengineer@centurytel.net

MARK R. MYERS
STATE OF WASHINGTON
21772
REGISTERED
PROFESSIONAL ENGINEER

Digitally signed by Mark Myers
Date: 2025.04.22 13:43:38 -07'00'

BUILDING DEPT. APPROVAL STAMPS:

REVISION:	INIT:	DATE:

S6

DATE: 4-22-2025
INIT: MM
PROJECT #: 2608